

HVAC GENERAL NOTES

- ALL WORK SHALL COMPLY WITH ALL APPLICABLE STATE AND LOCAL CODES. INSTALLING CONTRACTOR SHALL COMPLY THE IMC, SMACNA, ASHRAE 62.1, ASHRAE 90.1, AND NFPA 90A.
- CONTRACT DOCUMENT DRAWINGS FOR MECHANICAL WORK ARE DIAGRAMMATIC AND ARE INTENDED TO CONVEY SCOPE AND GENERAL ARRANGEMENT ONLY.
- INSTALL ALL MECHANICAL EQUIPMENT IN ACCORDANCE WITH MANUFACTURERS' RECOMMENDATIONS, CONTRACT DOCUMENTS, AND APPLICABLE CODES AND REGULATIONS.
- THE CONTRACTOR SHALL DETERMINE THE EXACT LOCATION OF ALL EXISTING UTILITIES BEFORE COMMENCING WORK.
- COORDINATE EQUIPMENT CLEARANCES (AS RECOMMENDED BY MANUFACTURER) WITH ALL DISCIPLINES BEFORE INSTALLATION.
- COORDINATE AND PROVIDE ALL DUCTS AND PIPING TRANSITION REQUIRED FOR FINAL EQUIPMENT CONNECTIONS TO FURNISHED EQUIPMENT, VERIFY AND COORDINATE ALL DUCT AND PIPING DIMENSIONS BEFORE FABRICATION.
- ALL EQUIPMENT, PIPING, DUCTWORK, ETC., SHALL BE SUPPORTED AS REQUIRED TO PROVIDE A VIBRATION-FREE INSTALLATION.
- ALL DUCTWORK DIMENSIONS, AS SHOWN ON THE DRAWINGS, ARE INTERNAL CLEAR DIMENSIONS AND DUCT SIZE SHALL BE INCREASED TO COMPENSATE FOR DUCT LINING THICKNESS.
- AVOID ROUTING DUCTWORK AND MECHANICAL EQUIPMENT OVER LIGHTS WHEREVER POSSIBLE. MAINTAIN MINIMUM 6" CLEARANCE BETWEEN MECHANICAL EQUIPMENT AND DUCT INSULATION TO TOP OF LIGHTS. PROVIDE CLEARANCE AND ACCESS ALL AROUND AND BELOW MECHANICAL EQUIPMENT AS REQUIRED FOR ROUTINE MAINTENANCE.
- SEAL ALL DUCT PENETRATIONS OF WALLS AIRTIGHT, REGARDLESS OF WHETHER WALLS ARE FIRE RATED OR NOT.
- ALL NEW SUPPLY AIR DUCTWORK SHALL BE LOW PRESSURE RECTANGULAR, SMACNA STATIC PRESSURE CLASS 2" W.G., SEAL CLASS A, EXTERNALLY INSULATED.
- ALL NEW RETURN AIR DUCTWORK SHALL BE LOW PRESSURE RECTANGULAR, SMACNA STATIC PRESSURE CLASS 1" W.G., SEAL CLASS A, EXTERNALLY INSULATED.
- ALL HVAC BUILDING PENETRATIONS SHALL BE LOCATED AT LEAST 10'-0" ABOVE FINISHED GRADE PER ATFP STANDARDS.

ABBREVIATIONS

AFF	ABOVE FINISHED FLOOR	IN	INCH
CFM	CUBIC FEET PER MINUTE	LPR	LOW-PRESSURE CONDENSATE
CD	CONDENSATE DRAIN PIPING		RETRUN
CP	CONTROL PANEL	MAX	MAXIMUM
DEMO	DEMOLISH	MPS	MEDIUM PRESSURE STEAM
DIA	DIAMETER	MIN	MINIMUM
DN	DOWN	MISC	MISCELLANEOUS
DWG	DRAWING	MVD	MANUAL VOLUME DAMPER
EA	EACH	N/A	NOT APPLICABLE
ENT	ENTERING	NTS	NOT TO SCALE
EF	EXHAUST FAN	OA	OUTDOOR AIR
EX	EXISTING	RM	ROOM
FLR	FLOOR	SQ.FT.	SQUARE FEET
FLRDR	FLOOR DRAIN	T'STAT	THERMOSTAT
FPM	FEET PER MINUTE	TYP	TYPICAL
FT	FEET		

HVAC LEGEND

-----	HIDDEN		RECTANGULAR DUCTWORK TURNING 90° UP.
-----	ITEMS TO BE DEMOLISHED		RECTANGULAR DUCTWORK TURNING 90° DOWN.
	MANUAL VOLUME DAMPER PROVIDE WITH LOCKING QUADRANT		DUCT SECTION, POSITIVE PRESSURE, FIRST FIGURE IS TOP
	TRANSITION		DUCT SECTION, NEGATIVE PRESSURE
	SQUARE THROAT ELBOW IN RECTANGULAR DUCT WITH DOUBLE WALL TURNING VANES.		RECTANGULAR DUCTWORK, SIZES SHOWN ARE INTERNAL CLEAR DIMENSIONS. (WIDTH x HEIGHT) FIRST FIGURE IS SIDE SHOWN.
	POINT OF CONNECTION		
	POINT OF DEMOLITION		


35% SUBMITTAL – NOT FOR CONSTRUCTION

REVISION	DATE	DESCRIPTION	BY	APPR'D
BASE CIVIL ENGINEER EGLIN AIR FORCE BASE, FLORIDA				
SABER PROJECT MANAGER		TITLE		
DATE _____	REPLACE BUR, PAINT INT-EXT, REPAIR-UPGRADE HVAC B6300			
SIGNATURE _____				
APPROVED _____				
CENM _____				
PROJ. ENGR. _____				
SABER AS-BUILT DRAWING BASED ON 35% DESIGN		CONTENTS		
		GENERAL MECHANICAL NOTES, LEGEND AND ABBREVIATIONS		
		APPROVED _____		DATE MAY 2024
		APPROVED _____		SCALE AS SHOWN
		BASE CIVIL ENGINEER		
SPEC. NO.	PROJ. NO. FTFA 23JC45	DRAWING NO.	FILE NO.	SHEET OF .

PETERSON ENGINEERING INC.

(PROF. ENG. # 3600)
75 SOUTH "F" STREET
PENSACOLA, FLORIDA 32502
(850) 434-0513
PEI 24057


INDEX NO.
M-001

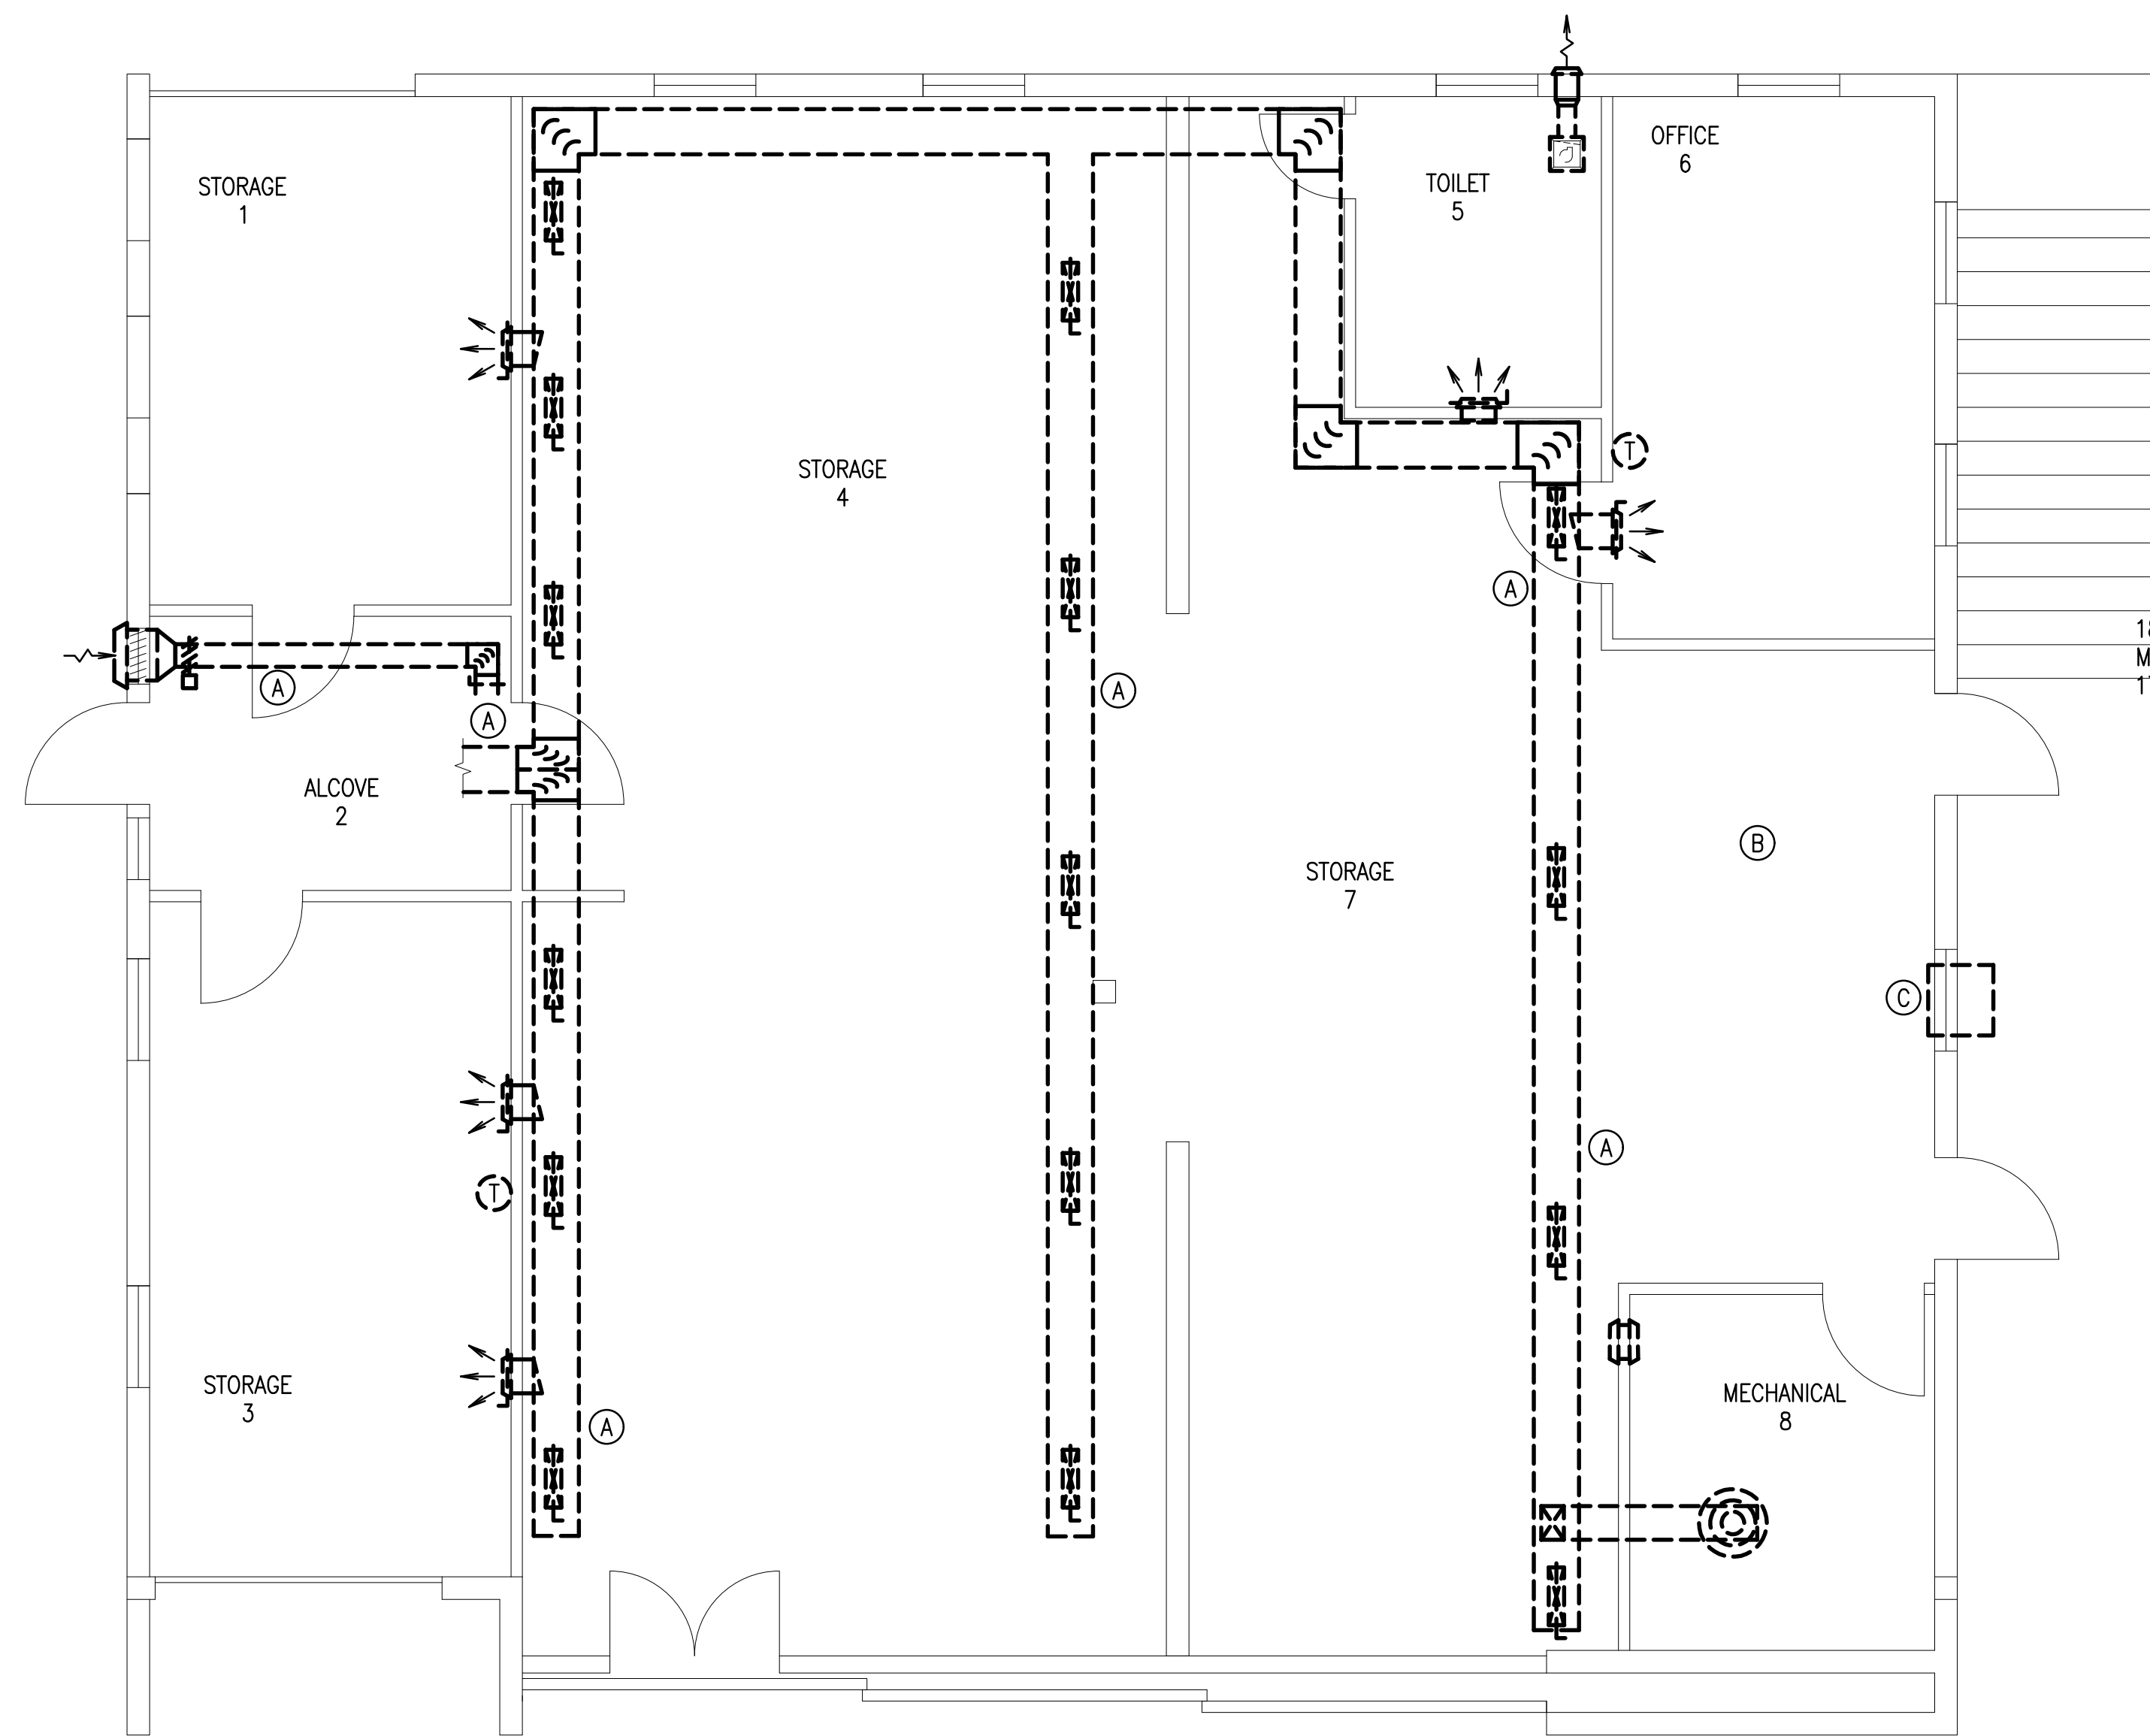

DEMOLITION NOTES

- (A) DEMOLISH ALL EXISTING DUCTWORK, TAPS AND SUPPLY REGISTERS AS SHOWN.
- (B) DEMOLISH AHU, CU, PIPING AND CONTROLS.
- (C) DEMOLISH PACKAGE UNIT IN WINDOW. PATCH AND PAINT EXISTING PENETRATION.

B6300 MECHANICAL DEMOLITION PLAN
SCALE: 1/4" = 1'-0"

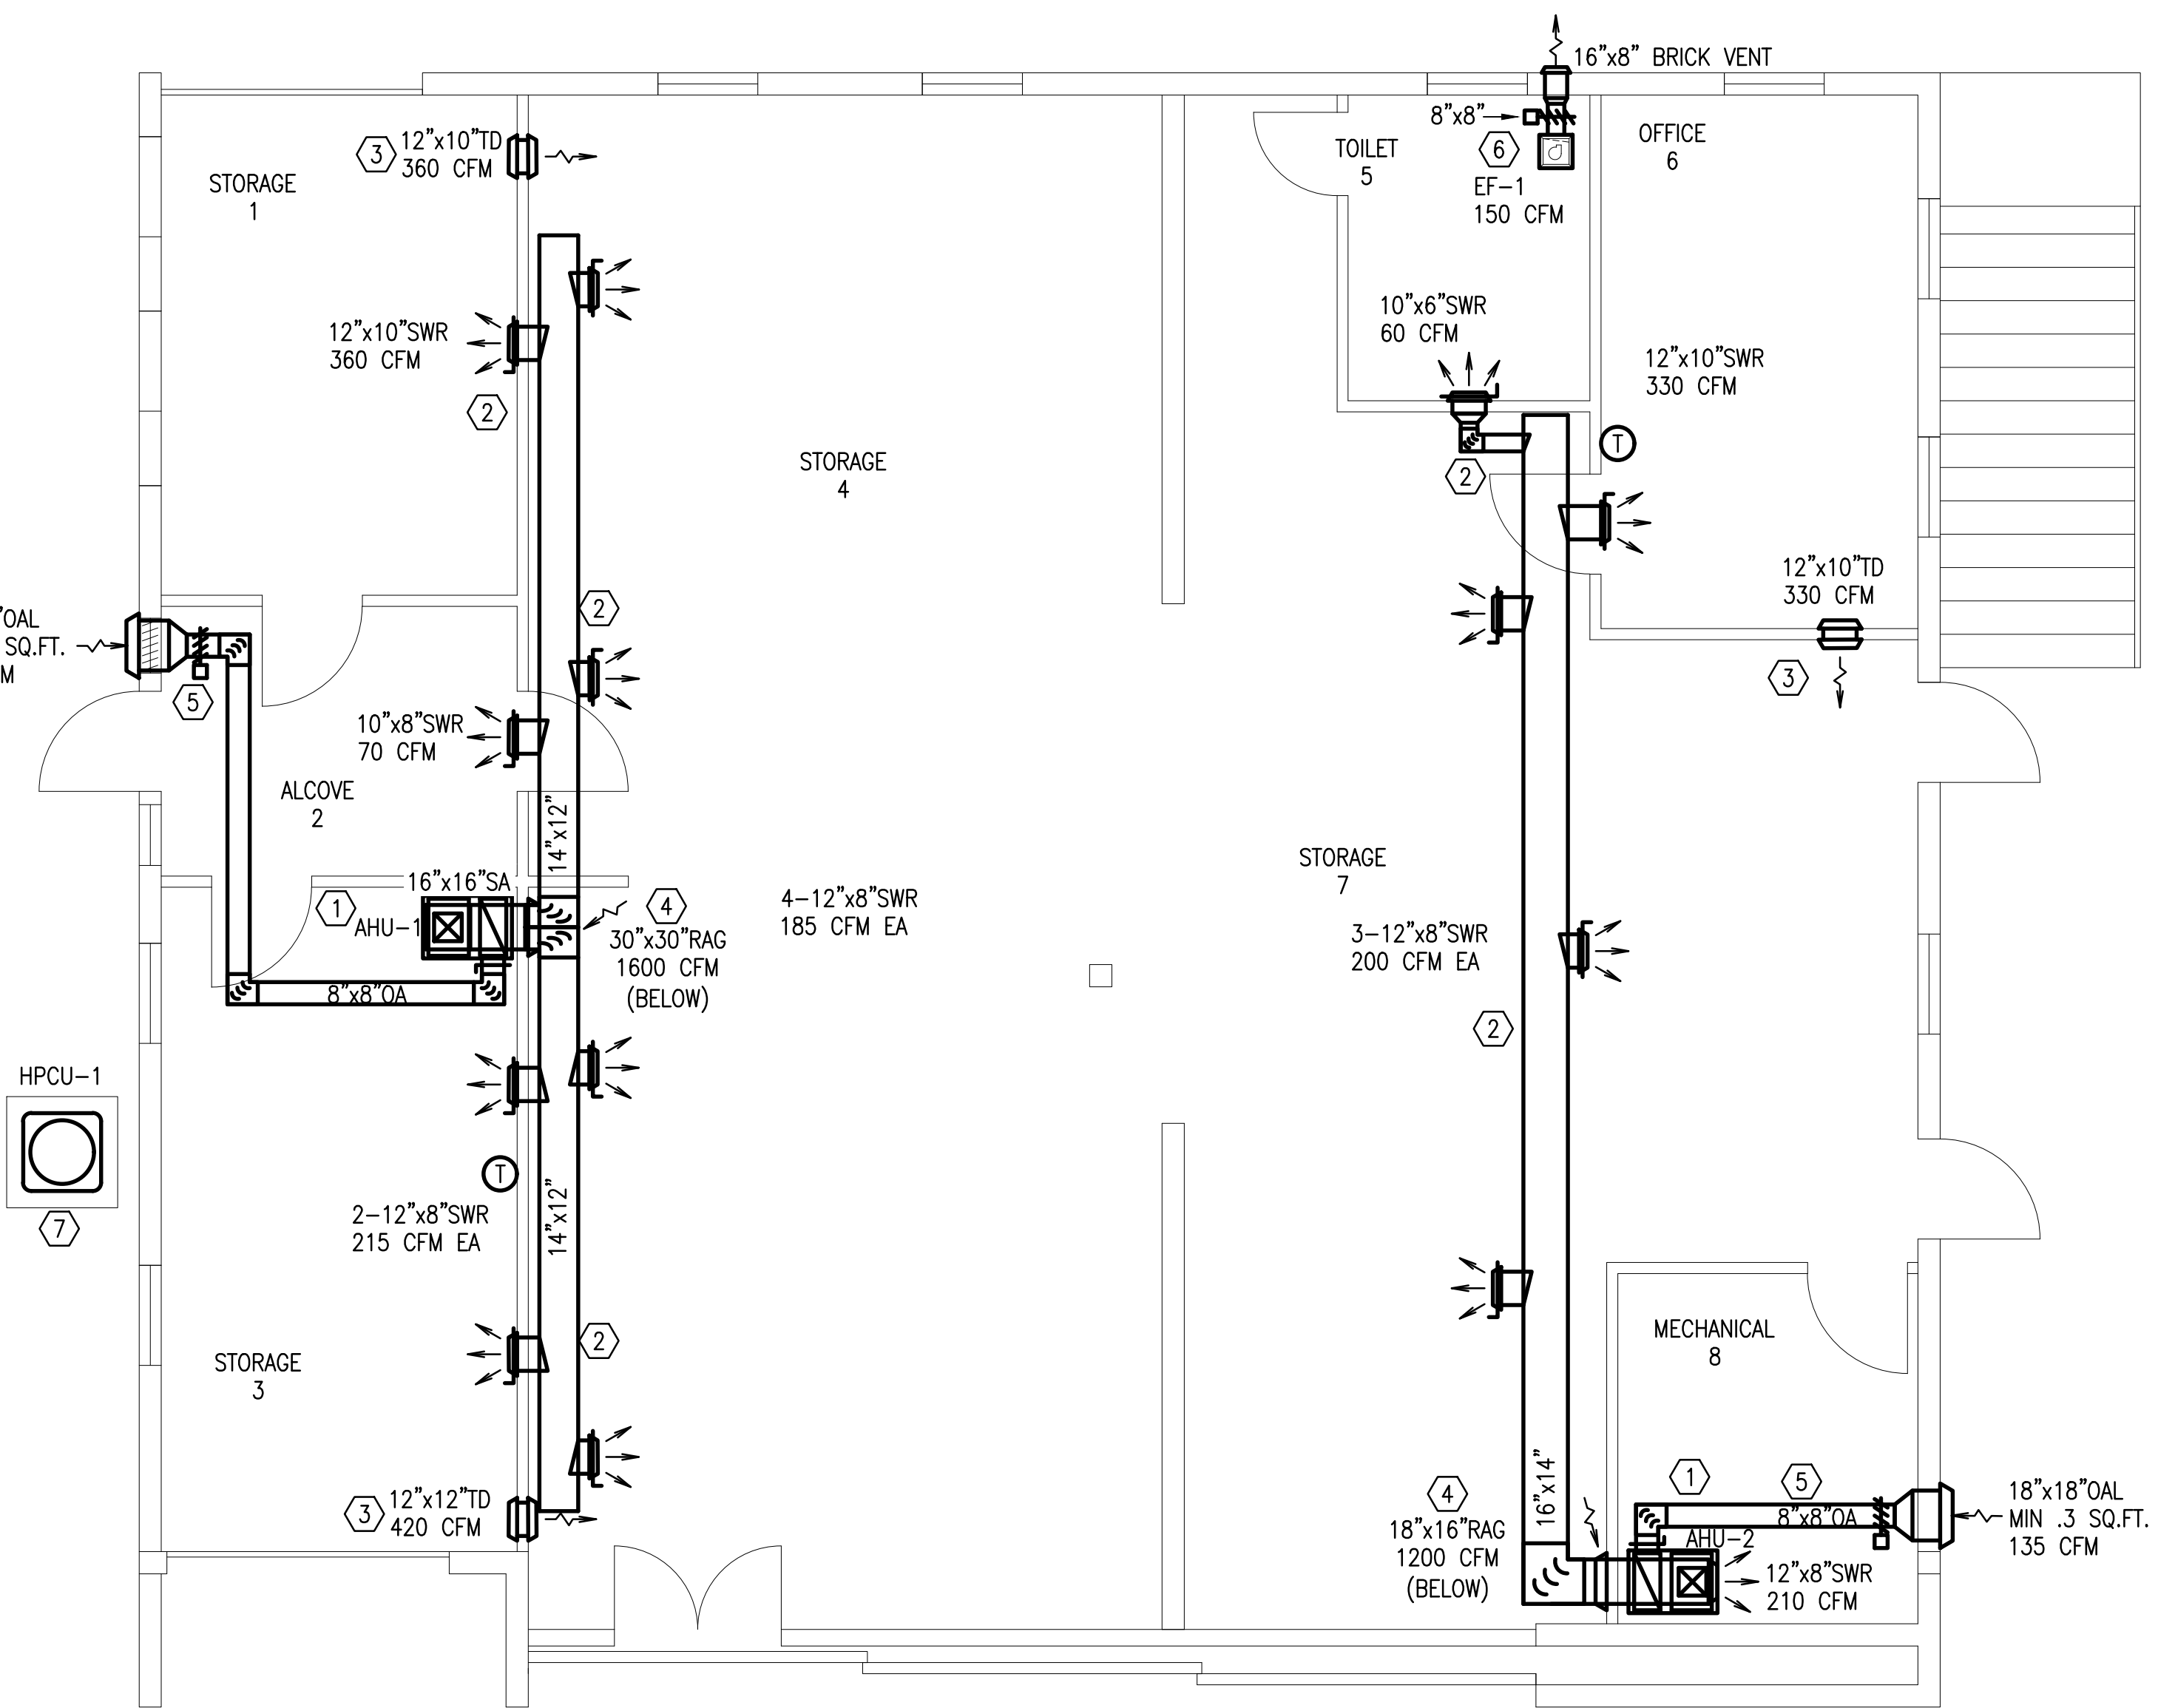

NEW WORK NOTES

- (1) PROVIDE AND PLACE NEW SPLIT SYSTEM AHU ON FACTORY PLENUM AS SHOWN.
- (2) PROVIDE AND PLACE NEW SUPPLY AIR DUCT, SIDE WALL REGISTERS WITH MANUAL DAMPERS.
- (3) PROVIDE AND PLACE NEW RETURN AIR TRANSFER DUCTS, SIZE AS SHOWN.
- (4) PROVIDE AND PLACE NEW RETURN AIR GRILLES IN WALL AS SHOWN.
- (5) PROVIDE AND PLACE NEW OUTSIDE AIR DUCT WITH AUTOMATIC AND MANUAL DAMPERS. RUN TO OUTSIDE AIR LOUVERS AS SHOWN.
- (6) PROVIDE AND PLACE NEW CABINET EXHAUST FAN IN TOILET AS SHOWN.
- (7) PROVIDE AND PLACE NEW OUTDOOR UNIT. HPCU-1 ON NEW CONCRETE PAD. HPCU-2 CAN BE PLACED ON EXISTING CONCRETE PAD.

B6300 MECHANICAL NEW WORK PLAN
SCALE: 1/4" = 1'-0"


1/4" = 1'-0"

PETERSON ENGINEERING INC.
 (PROF. ENG. # 3600)
 75 SOUTH "F" STREET
 PENSACOLA, FLORIDA 32502
 (850) 434-0513
 PEI 24057

INDEX NO.
M-101


35% SUBMITTAL - NOT FOR CONSTRUCTION

REVISION	DATE	DESCRIPTION	BY	APPR'D
BASE CIVIL ENGINEER EGLIN AIR FORCE BASE, FLORIDA				
DATE _____		REPLACE BUR, PAINT INT-EXT, REPAIR-UPGRADE HVAC B6300		
SIGNATURE _____				
APPROVED _____				
CENM _____				
PROJ. ENGR. _____				
SABER AS-BUILT DRAWING BASED ON 35% DESIGN		CONTENTS MECHANICAL DEMOLITION AND NEW WORK PLANS		
APPROVED _____		DATE MAY 2024		
APPROVED _____		SCALE AS SHOWN		
SPEC. NO. _____		PROJ. NO. FTFA 23JC45	DRAWING NO. _____	FILE NO. _____
				SHEET OF .

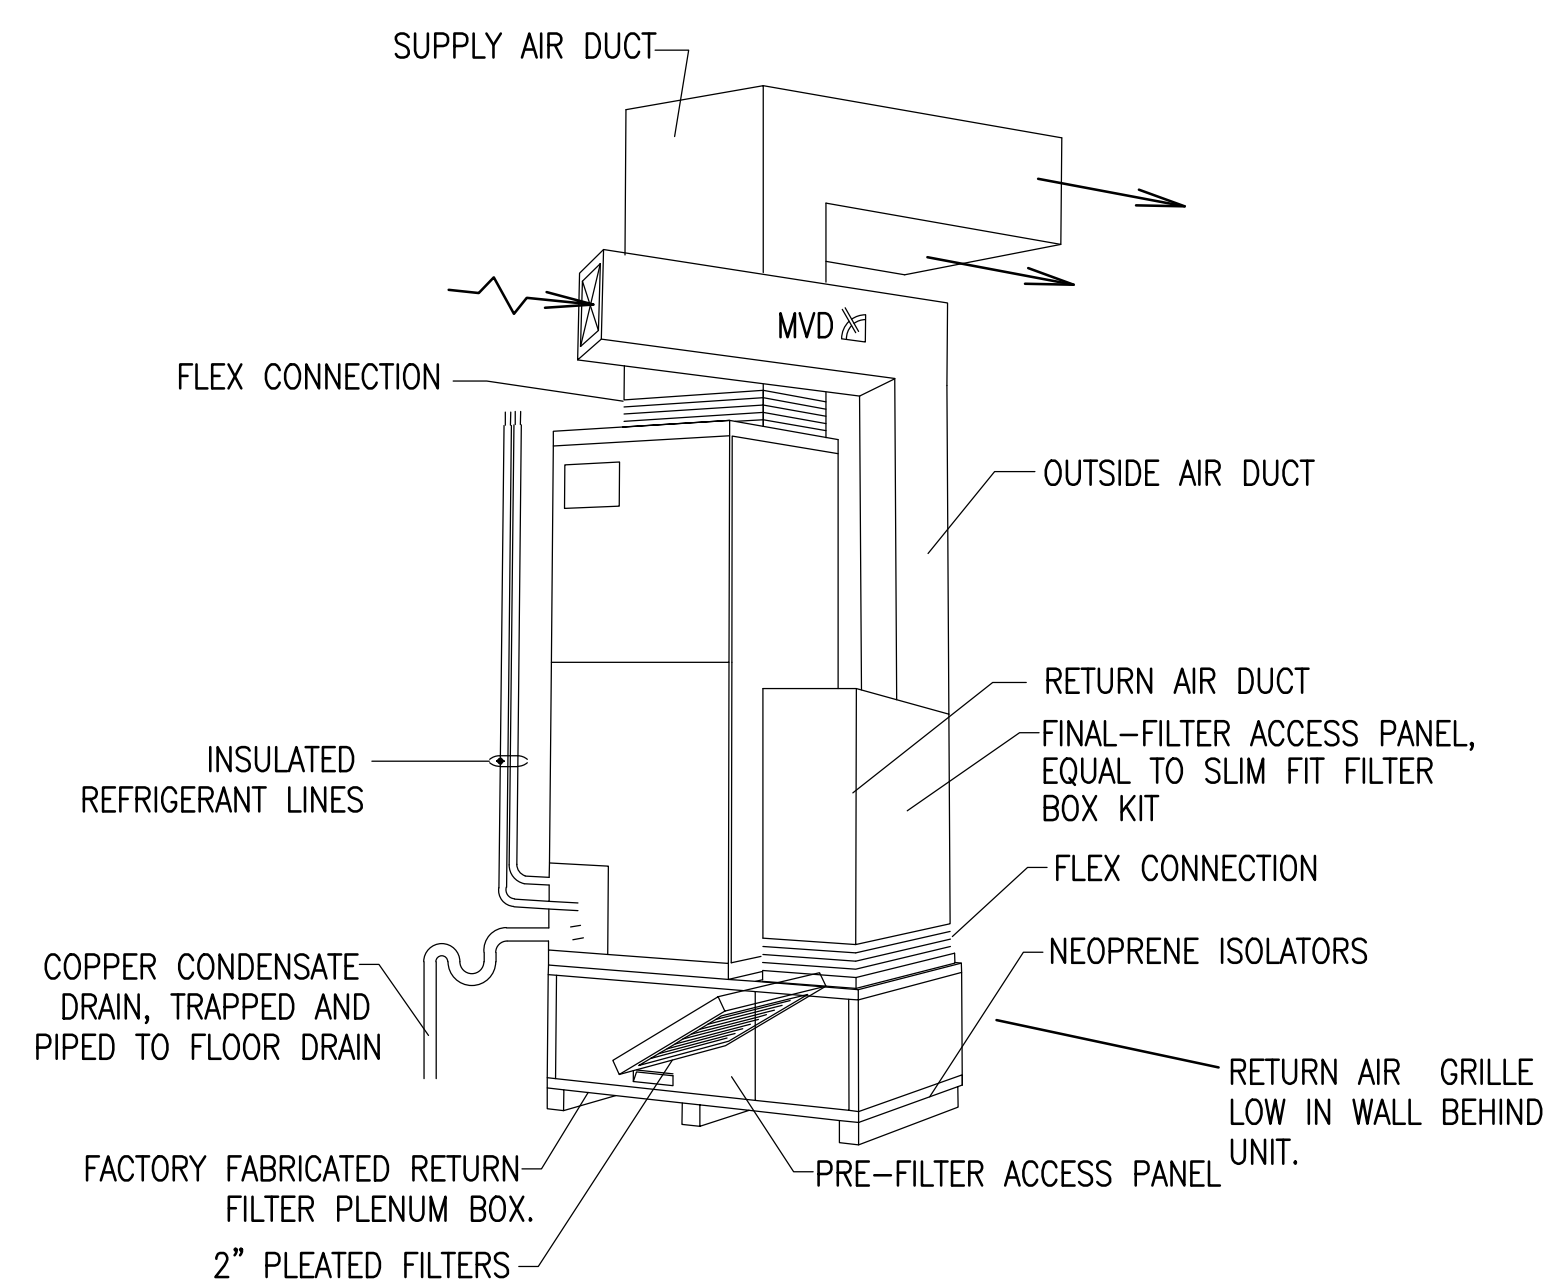


NOTES:
 SECURE REFRIGERANT LINES AND CONDENSATE PIPING WITH UNISTRUT.
 SIZE COPPER CONDENSATE LINE AT FULL SIZE OF UNIT CONNECTION, BUT IN NO CASE SMALLER THAN 3/4". INSULATE CONDENSATE WITH 1/2" FLEXIBLE UNICELLULAR INSULATION.


TYPICAL VERTICAL UPFLOW AHU DETAIL
 NOT TO SCALE

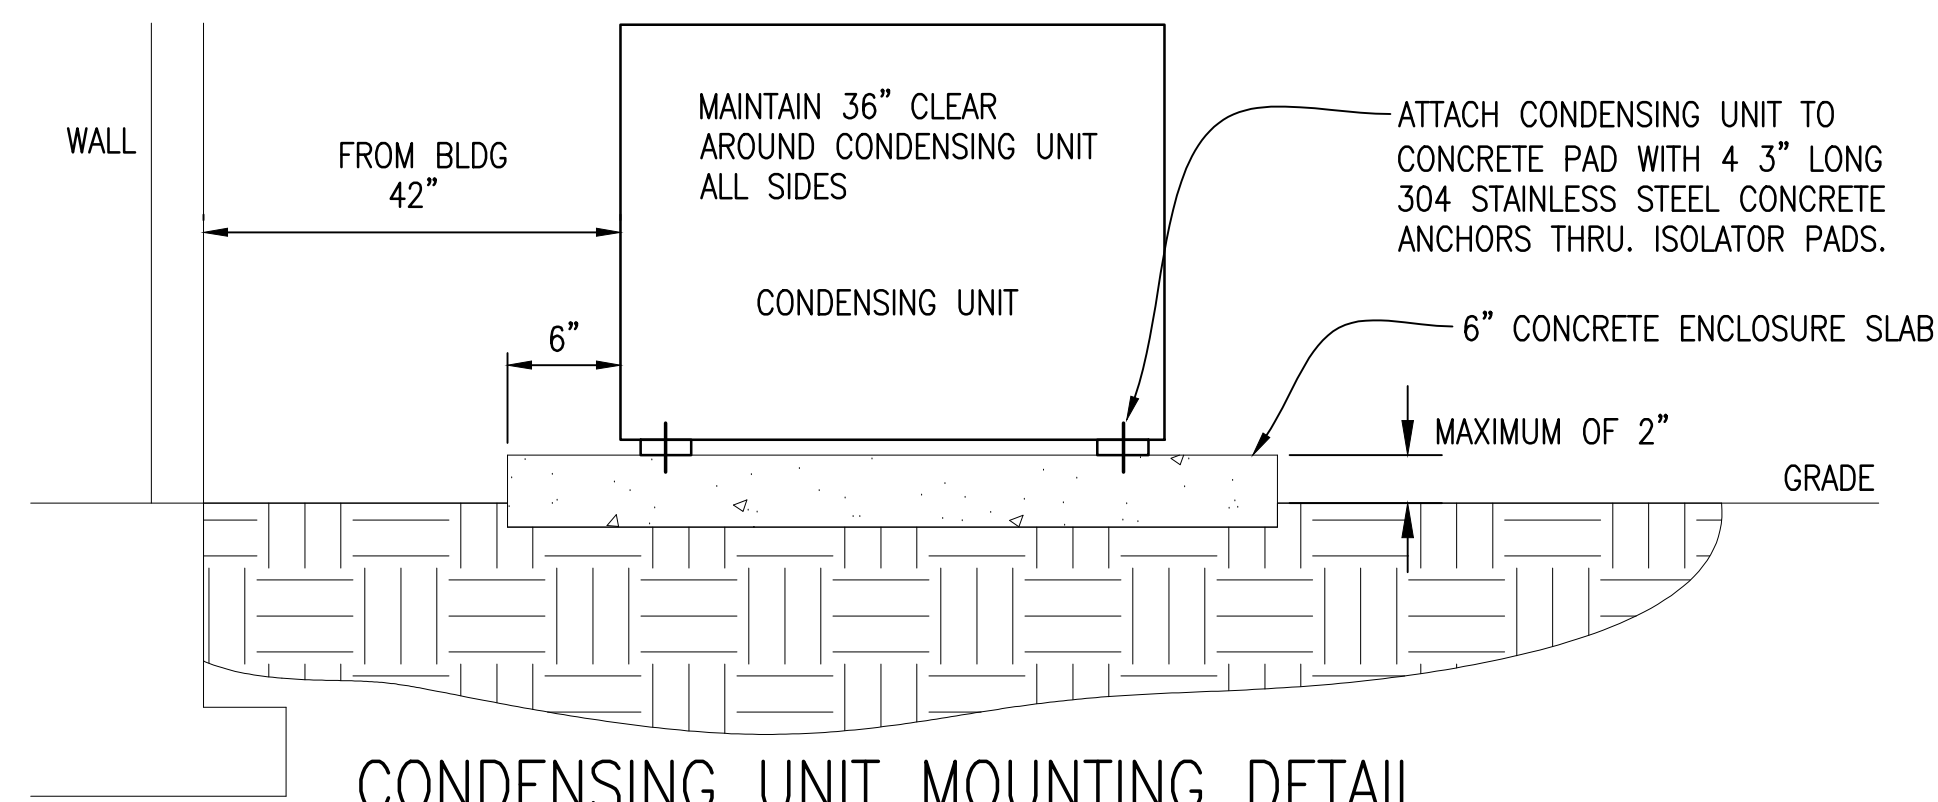

CONDENSING UNIT MOUNTING DETAIL
 NOT TO SCALE

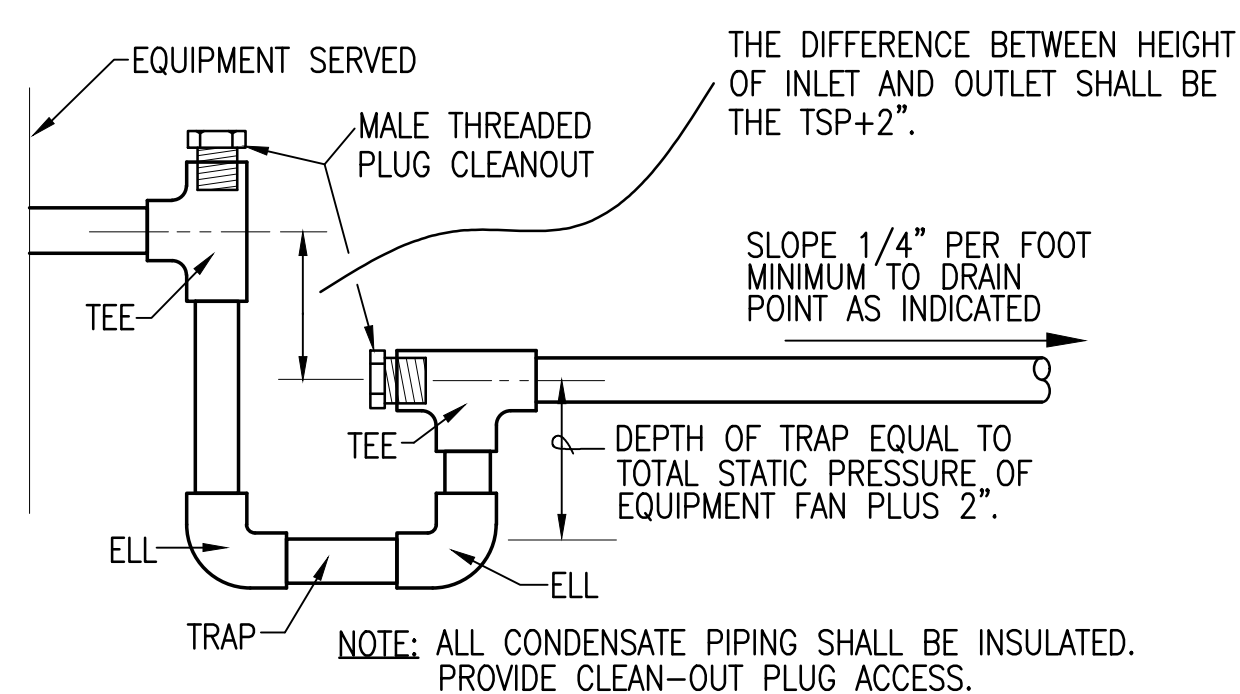

TYPICAL CONDENSATE DRAIN DETAIL
 NOT TO SCALE

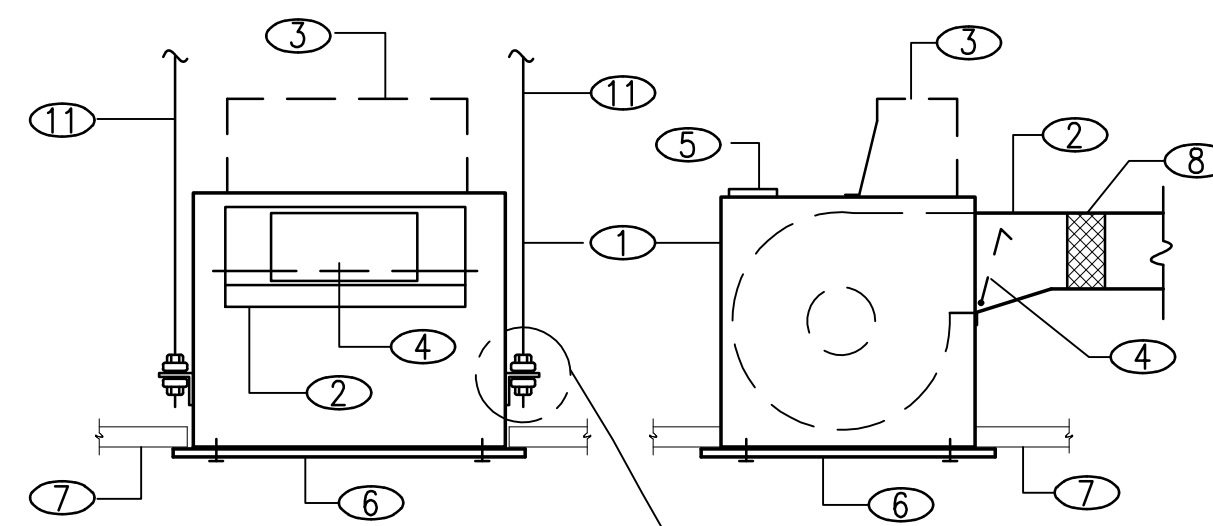

- ① GALVANIZED STEEL HOUSING
- ② HORIZONTAL DISCHARGE DUCT CONNECTION
- ③ OPTIONAL VERTICAL DISCHARGE
- ④ BACKDRAFT DAMPER
- ⑤ EXTERNAL ELECTRICAL ACCESS COVER
- ⑥ REMOVABLE CEILING GRILLE
- ⑦ CEILING CONSTRUCTION
- ⑧ FLEXIBLE DUCT CONNECTOR
- ⑨ ADJUSTABLE MOUNTING FLANGE
- ⑩ VIBRATION ISOLATOR, TOP AND BOTTOM
- ⑪ 3/16" DIAMETER THREADED HANGER RODS, TOTAL OF FOUR, SUPPORT FROM BUILDING STRUCTURE
- ⑫ NUT AND WASHER

CEILING EXHAUST FAN DETAIL
 NOT TO SCALE

35% SUBMITTAL - NOT FOR CONSTRUCTION

REVISION	DATE	DESCRIPTION	BY	APPR'D
BASE CIVIL ENGINEER EGLIN AIR FORCE BASE, FLORIDA				
PROJECT MANAGER		TITLE		
DATE		REPLACE BUR, PAINT INT-EXT, REPAIR-UPGRADE HVAC B6300		
SIGNATURE				
APPROVED				
CENM				
DRAWN BY				
PROJ. ENGR.				
SABER AS-BUILT DRAWING BASED ON 35% DESIGN		CONTENTS MECHANICAL DETAILS		
APPROVED		DATE		
96 CEG/CEN		MAY 2024		
APPROVED		SCALE		
BASE CIVIL ENGINEER		AS SHOWN		
SPEC. NO.	PROJ. NO.	DRAWING NO.	FILE NO.	SHEET OF .
	FTFA 23JC45			

PETERSON ENGINEERING INC.
 (PROF. ENG. # 3600)
 75 SOUTH "F" STREET
 PENSACOLA, FLORIDA 32502
 (850) 434-0513
 PEI 24057

INDEX NO.
M-501

HEAT PUMP – CONDENSING UNIT SCHEDULE															
MARK	DESIGN COOLING		DESIGN HEATING		REF. TYPE	COMPRESSORS		FANS		ELECTRICAL					BOD
	TOTAL MBTU/HR	AMBIENT °F	TOTAL MBTU/HR	AMBIENT °F		NO.	RLA EACH	NO.	FLA EACH	VOLTS	PHASE	HZ	MCA	MOCP	
HPCU-1	48.0	95	48.0	47	410A	1	11.7	1	0.7	208/230	1	60	28	45	TRANE 4TWR6048
HPCU-2	36.0	95	34.0	47	410A	1	15.3	1	0.7	208/230	1	60	20	35	TRANE 4TWR6036


HEAT PUMP – AIR HANDLING UNIT SCHEDULE																						
MARK	AIR DATA			COOLING DESIGN CONDITIONS					HEATING DESIGN			ELECTRICAL						UNIT FILTER DATA			BOD	
	TOTAL AIR CFM	OUTSIDE AIR CFM	E.S.P. IN. H ₂ O	TOTAL MBTU/HR	SENSIBLE MBTU/HR	COIL ENT. DB °F	COIL ENT. WB °F	COIL ENT. MAX VEL. FPM	FACE VEL. FPM	TOTAL MBTU/HR	AMBIENT °F	AUX. HEAT KW	VOLTS	PHASE	Hz	BLOWER HP	MIN. SEER ①	MIN. COP ②	TYPE	SIZE		MAXIMUM VEL. FPM
AHU-1	1600	160	0.5	48	36	80	67	500	48	47	14.4@240V	208/230	1	60	0.5	16.0	3.9	T-AWAY	1"	350	TRANE TEM6AOC48	
AHU-2	1200	120	0.5	36	27	80	67	500	34	47	9.6@240V	208/230	1	60	0.5	16.0	3.9	T-AWAY	1"	350	TRANE TEM6AOC36	

① AT ARI CONDITIONS OF 95°F AMB., 80°F D.B. AND 67°F W.B. COIL ENTERING ② AT ARI CONDITIONS OF 47°F D.B., 70°F D.B. COIL ENTERING

FAN SCHEDULE													
MARK	LOCATION	TYPE	DRIVE	PERFORMANCE DATA				ELECTRICAL				CONTROL	NOTES
				AIR FLOW CFM	E.S.P. IN. H ₂ O	MAX. RPM	MAX. SONES	MAX. HP/WATTS	VOLTS	PHASE	Hz		
EF-1	TOILET	CB	DD	150	0.375	900	3.0	51 W	115	1	60	W/LIGHT SWITCH	BELOW

FAN SCHEDULE LEGEND
 BD – BELT DRIVE
 EF – EXHAUST FAN
 CB – CABINET EXHAUST FAN
 ILC – INLINE CENTRIFUGAL FAN
 ESP – EXTERNAL STATIC PRESSURE

FAN NOTES
 1. ALL EXHAUST FANS SHALL BE INSTALLED WITH FLEXIBLE DUCT CONNECTION, VIBRATION ISOLATORS, AND FLEXIBLE CONDUIT. FAN SHALL NOT BE IN CONTACT WITH ANY OTHER DUCT, PIPING, CONDUIT, OR STRUCTURAL MEMBERS.
 2. THE FANS SHALL BE PROVIDED WITH BACKDRAFT DAMPERS.
 3. THE ROOF MOUNTED FANS SHALL BE PROVIDED WITH PREFABRICATED ROOF CURBS AND BACKDRAFT DAMPER.
 4. ALL DIRECT DRIVE FANS WITH MOTORS LESS THAN 1/2 HP SHALL BE PROVIDED WITH AN ADJUSTABLE ELECTRONIC SPEED CONTROLLER.

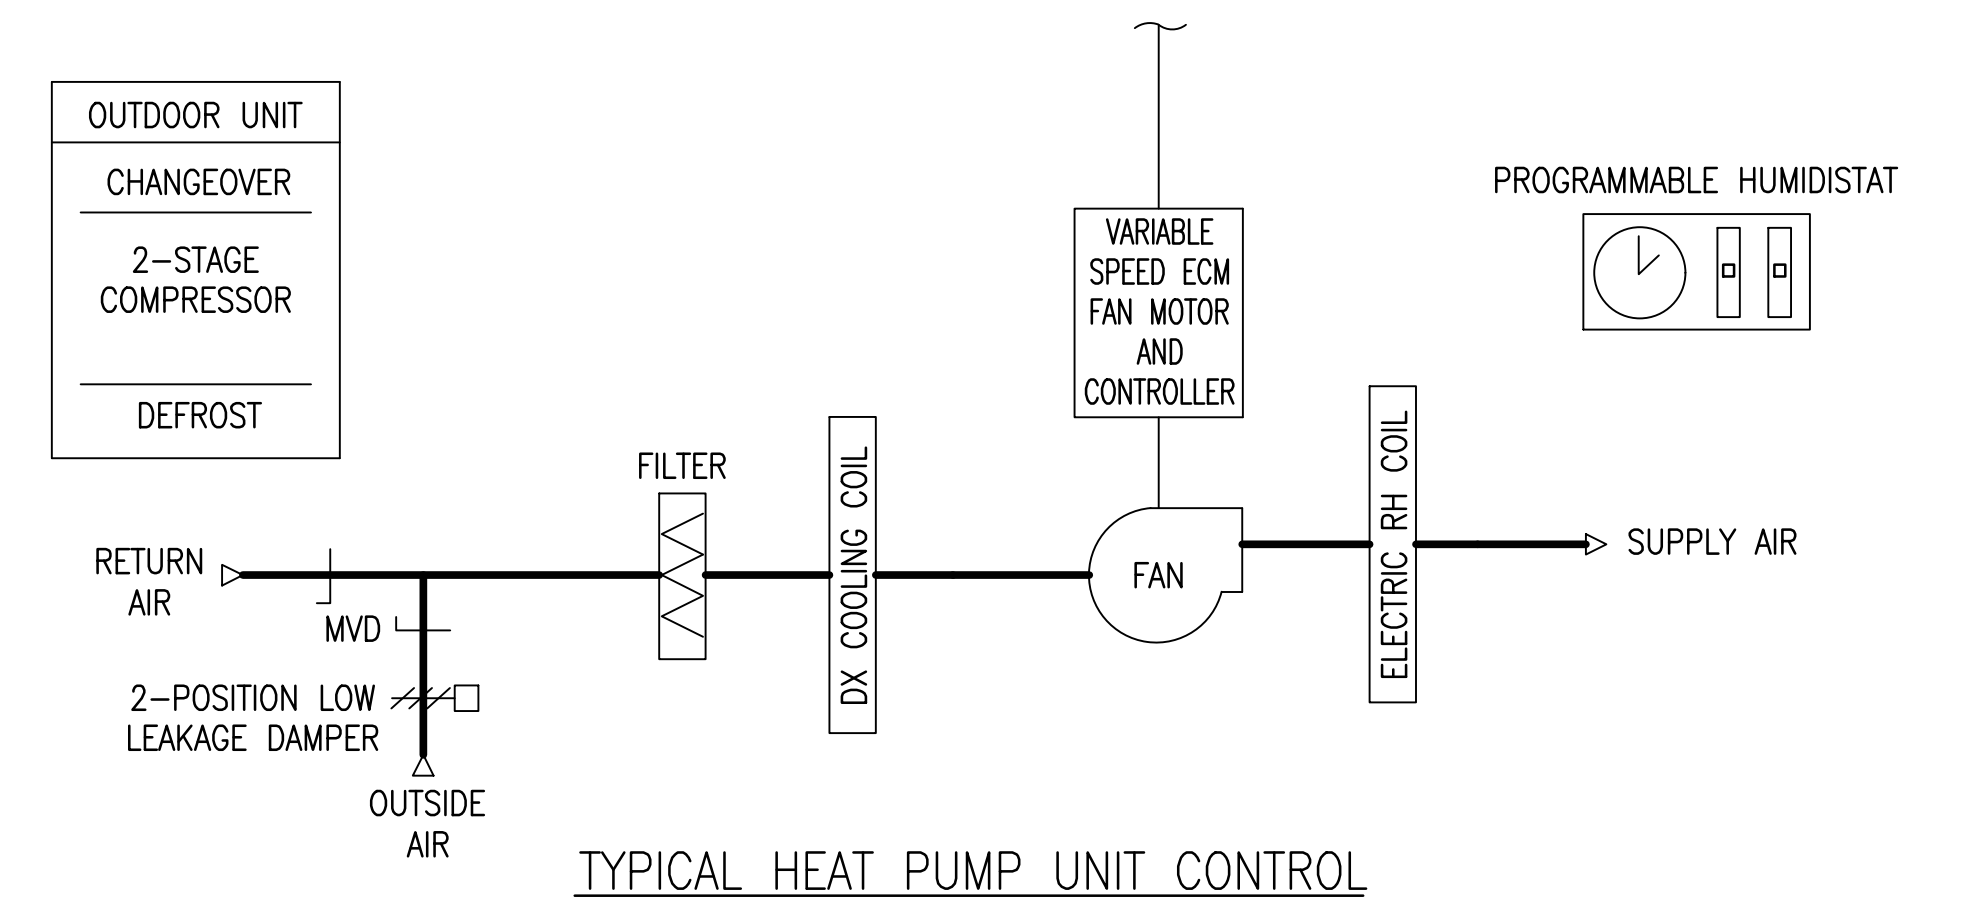

SEQUENCE OF OPERATION

HEATING AND COOLING:

THE INDOOR UNIT FAN SHALL BE STARTED BY THE DDC ACCORDING TO IT'S OCCUPIED/UNOCCUPIED SCHEDULE AS PROGRAMMED. THE TEMPERATURE SET POINTS SHALL BE PROGRAMMED BY THE CONTRACTOR FOR OCCUPIED HOURS AT 75°F (ADJ) COOLING AND 70°F (ADJ) FOR HEATING MODE. WHEN ROOM AIR TEMPERATURE RISES ABOVE THE COOLING SET POINT THE INDOOR FAN, OUTDOOR UNIT AND DX COOLING SHALL BE STAGED BY THE FACTORY CONTROLS AS NEEDED TO SATISFY SPACE COOLING REQUIREMENTS. WHEN ROOM AIR TEMPERATURE FALLS BELOW THE HEATING SET POINT THE INDOOR FAN SHALL RUN AND THE OUTDOOR UNIT REVERSING VALVE AND COMPRESSOR HEAT SHALL BE CONTROLLED BY THE FACTORY CONTROLS AS NEEDED TO SATISFY SPACE HEATING REQUIREMENTS. IF COMPRESSOR HEAT IS INSUFFICIENT TO SATISFY SPACE HEATING DEMAND, THE ELECTRIC AUXILIARY HEAT SHALL CYCLE ON. WHEN THE OUTDOOR UNIT DEFROST CIRCUIT IS ACTIVATED THE AUXILIARY HEAT SHALL CYCLE AS NEEDED TO PREVENT OVERCOOLING THE SPACE.

DEHUMIDIFICATION:

WHEN SPACE RELATIVE HUMIDITY (RH) RISES ABOVE RH SET POINT, THE UNIT WILL ACTIVATE THE COMPRESSOR IN COOLING MODE AS PER THE FACTORY PROGRAMMED CONTROL ALGORITHM UNTIL THE HUMIDITY SET POINT IS MET AT WHICH TIME THE UNIT SHALL RETURN TO NORMAL COOLING OPERATION.

CONTRACTOR SHALL PROGRAM THERMOSTAT WITH OCCUPIED SCHEDULE AND TEMPERATURE/HUMIDITY SET POINTS.

CONFIRM BELOW WITH USERS:

MON-FRI 7AM-6PM OCCUPIED.
 OCCUPIED 74F COOLING
 OCCUPIED 68F HEATING
 UNOCCUPIED 80F COOLING
 UNOCCUPIED 65F HEATING
 RH SETPOINT SHALL BE 60% (ADJ)

35% SUBMITTAL – NOT FOR CONSTRUCTION

REVISION	DATE	DESCRIPTION	BY	APPR'D
BASE CIVIL ENGINEER EGLIN AIR FORCE BASE, FLORIDA				
SABER PROJECT MANAGER		TITLE		
DATE _____		REPLACE BUR, PAINT INT-EXT, REPAIR-UPGRADE HVAC B6300		
SIGNATURE _____				
APPROVED _____				
CENM _____				
PROJ. ENGR. _____				
SABER AS-BUILT DRAWING BASED ON 35% DESIGN		CONTENTS MECHANICAL SCHEDULES AND CONTROLS		
APPROVED _____		DATE MAY 2024		
APPROVED _____		SCALE AS SHOWN		
SPEC. NO. _____		PROJ. NO. FTFA 23JC45	DRAWING NO. _____	FILE NO. _____
INDEX NO. M-601		SHEET OF .		

PETERSON ENGINEERING INC.

(PROF. ENG. #: 3600)
 75 SOUTH "F" STREET
 PENSACOLA, FLORIDA 32502
 (850) 434-0513
 PEI 24057