


GENERAL NOTES


1. DEVICES SHOWN BOLD ARE NEW, ALL ELSE IS EXISTING.

KEYNOTE

① PROVIDE UPDATED TYPE WRITTEN PANEL SCHEDULE IN PANEL INDICATING CURRENT CIRCUIT CONDITIONS.

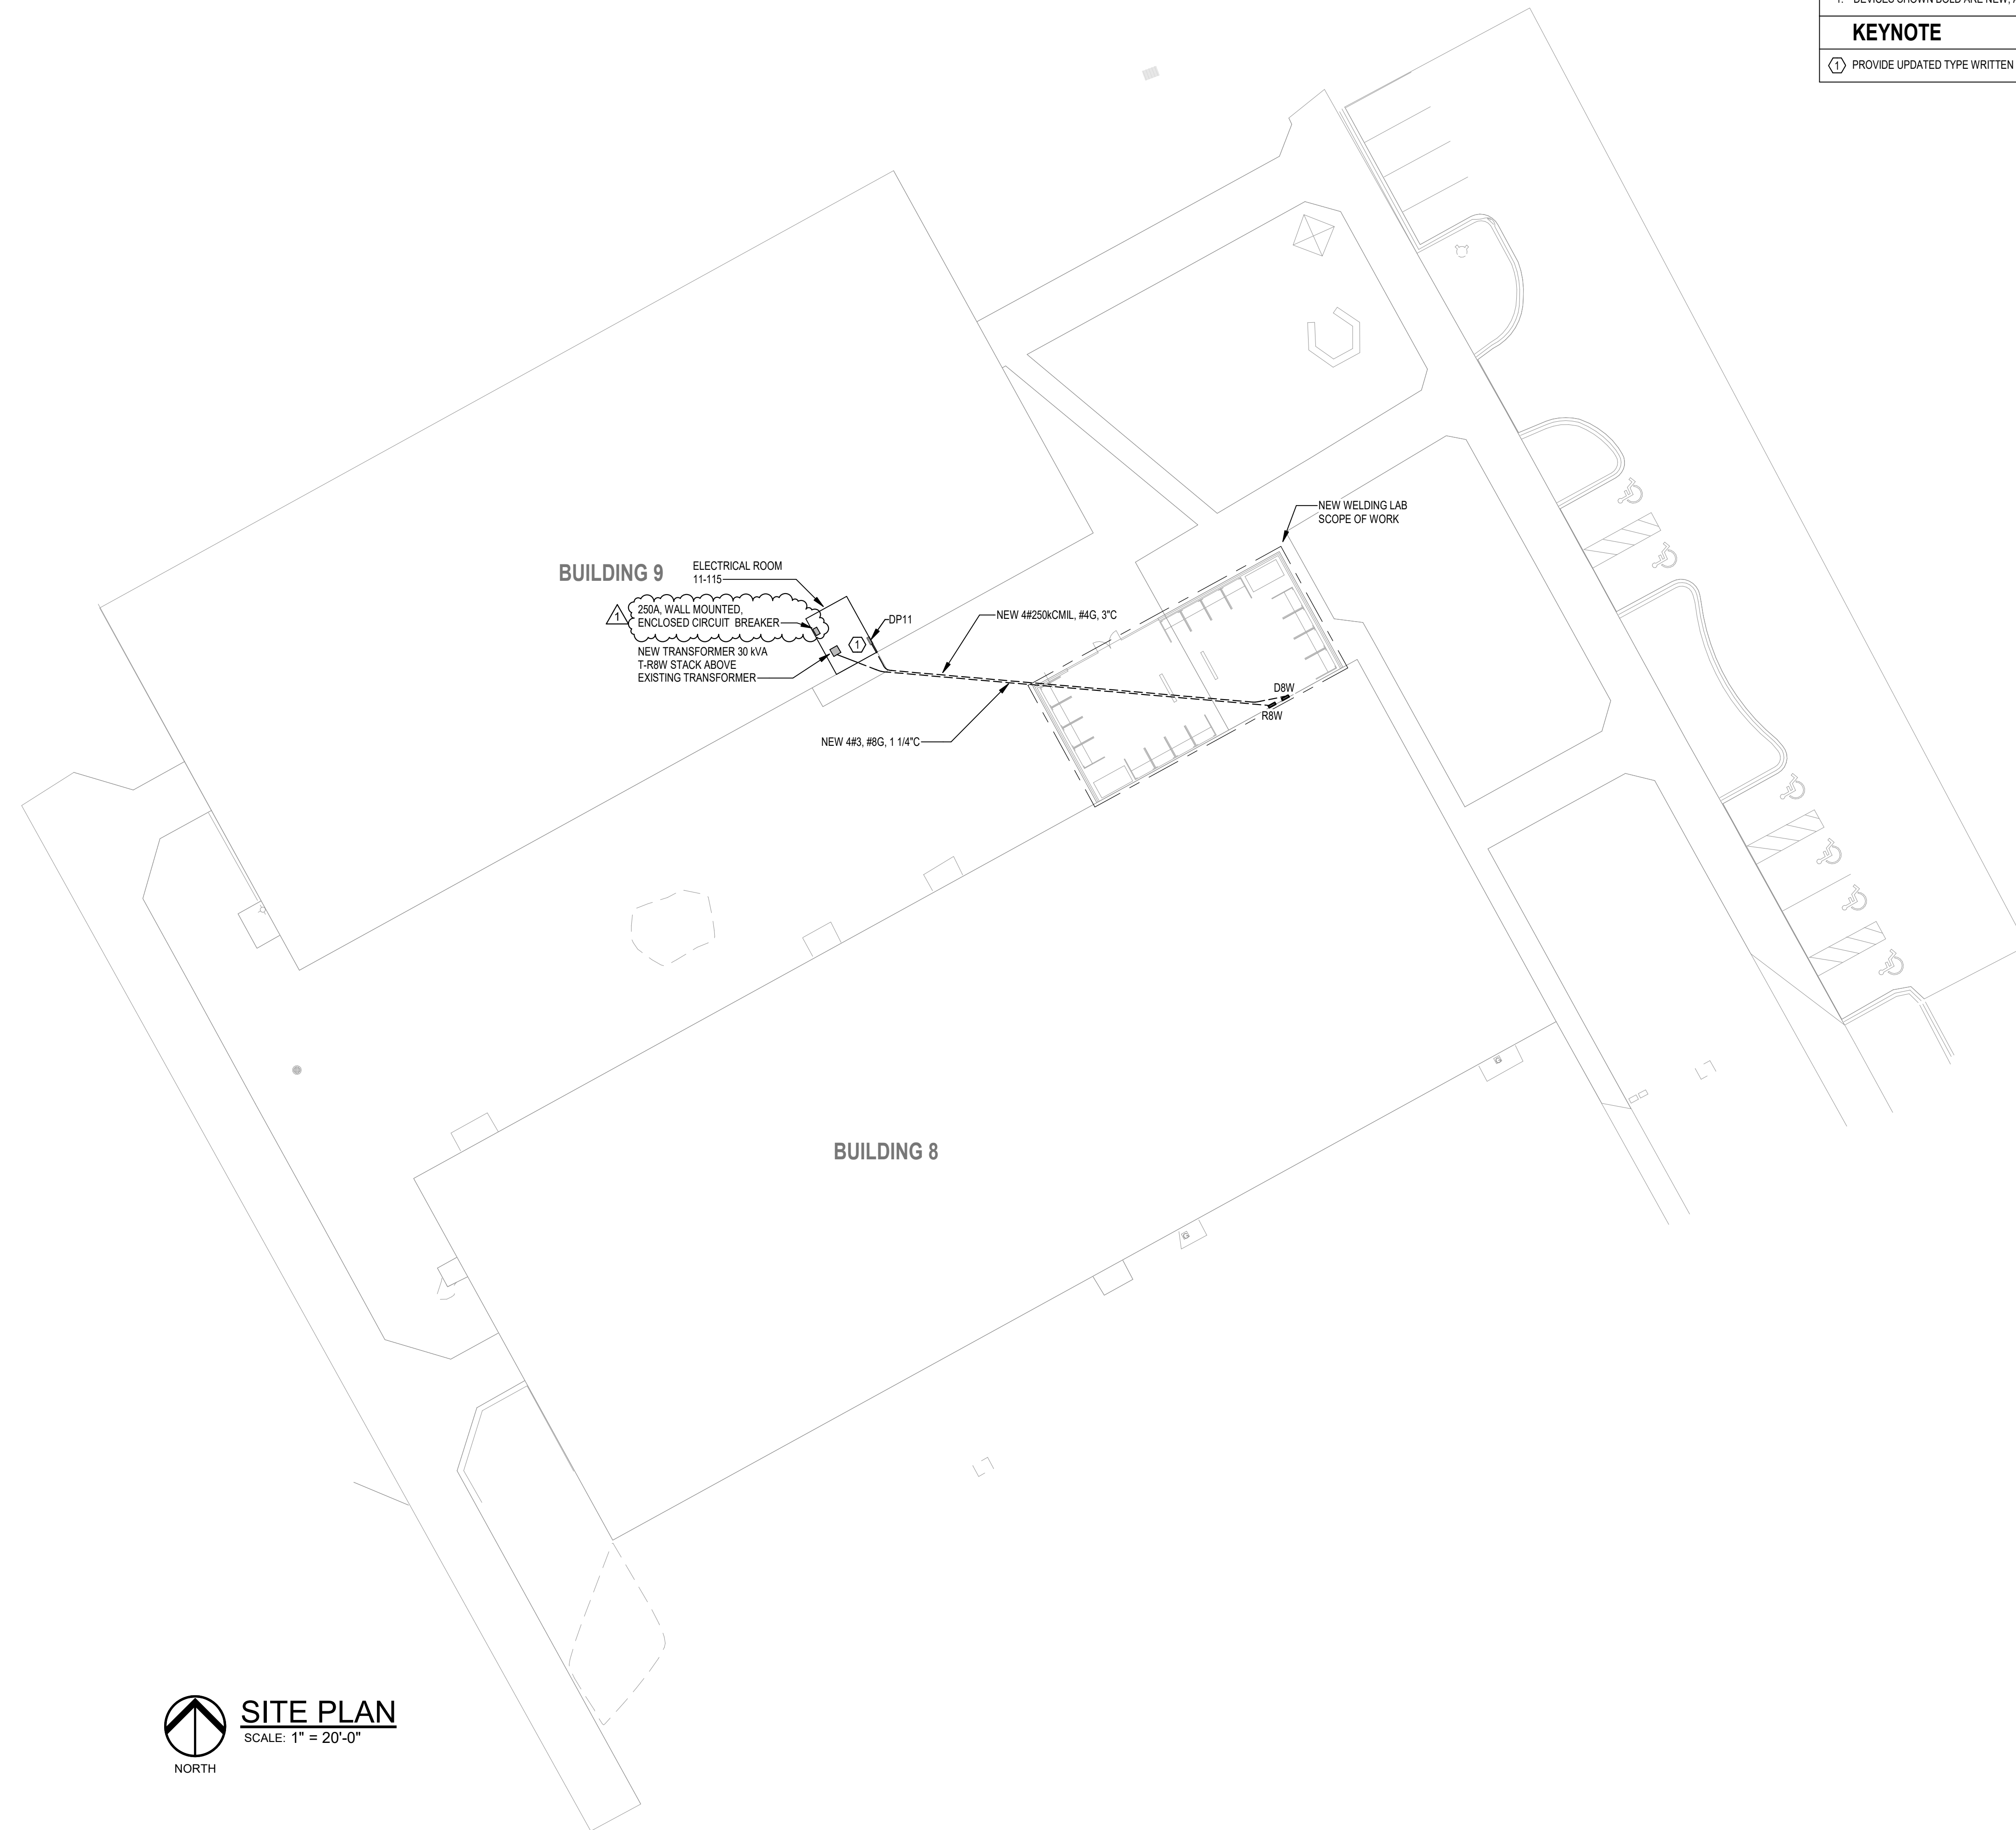

SITE PLAN
SCALE: 1" = 20'-0"
NORTH

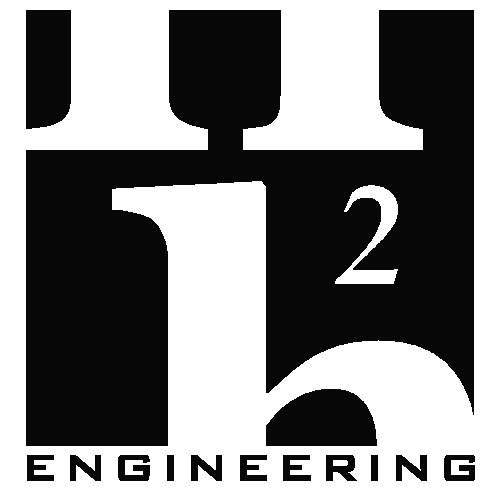

114 EAST 5th AVENUE
TALLAHASSEE, FL 32303
PHONE 850.224.7922
www.H2Engineering.com

H2E PROJECT No. 24105

THIS DOCUMENT IS THE PROPERTY OF H2Engineering AND IS PREPARED AS AN INSTRUMENT OF SERVICE. ITS USE, REUSE OR REPRODUCTION, EXCEPT BY WRITTEN AGREEMENT WITH H2ENGINEERING, INC., IS PROHIBITED.

Florida Registry #2485
Anthony D. Wyrick, P.E. #98346

REVISIONS

NO.	DESCRIPTION	DRAWN	CHECKED	DATE
1	ADDENDUM #1	APA	ADW	12-16-24

PHASE

	DRAWN	CHECKED	DATE
SCHEMATIC DESIGN			07/15/24
DESIGN DEVELOPMENT	GAG	ADW	09/25/24
CONSTRUCTION DOCUMENTS	APA	ADW	11/08/24

JRA ARCHITECTS
2551 BLAIRSTONE PINES DR.
TALLAHASSEE, FL 32301
PHONE: (850) 878-7891
Commission Number: 24855

CONSULTANTS:

PROJECT:
**CHILES HIGH SCHOOL
WELDING LAB**


LEON COUNTY, FLORIDA

SHEET TITLE:

SITE PLAN

SHEET NUMBER:

E1.0

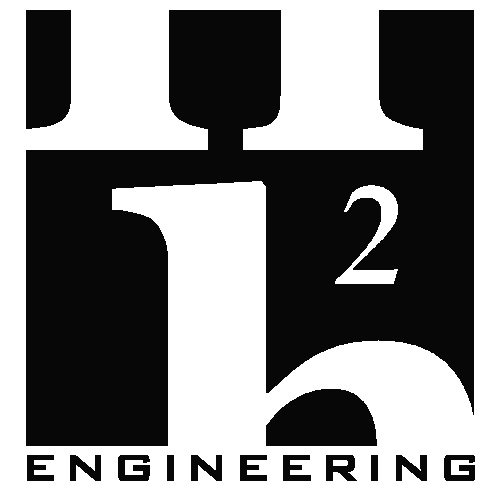


114 EAST 5th AVENUE
TALLAHASSEE, FL 32303
PHONE 850.224.7922
www.H2Engineering.com

H2E PROJECT No. 24105

THIS DOCUMENT IS THE PROPERTY OF H2Engineering AND IS PREPARED AS AN INSTRUMENT OF SERVICE. ITS USE, REUSE OR REPRODUCTION, EXCEPT BY WRITTEN AGREEMENT WITH H2ENGINEERING, INC., IS PROHIBITED.

Florida Registry #2485
Anthony D. Wyrick, P.E. #98346

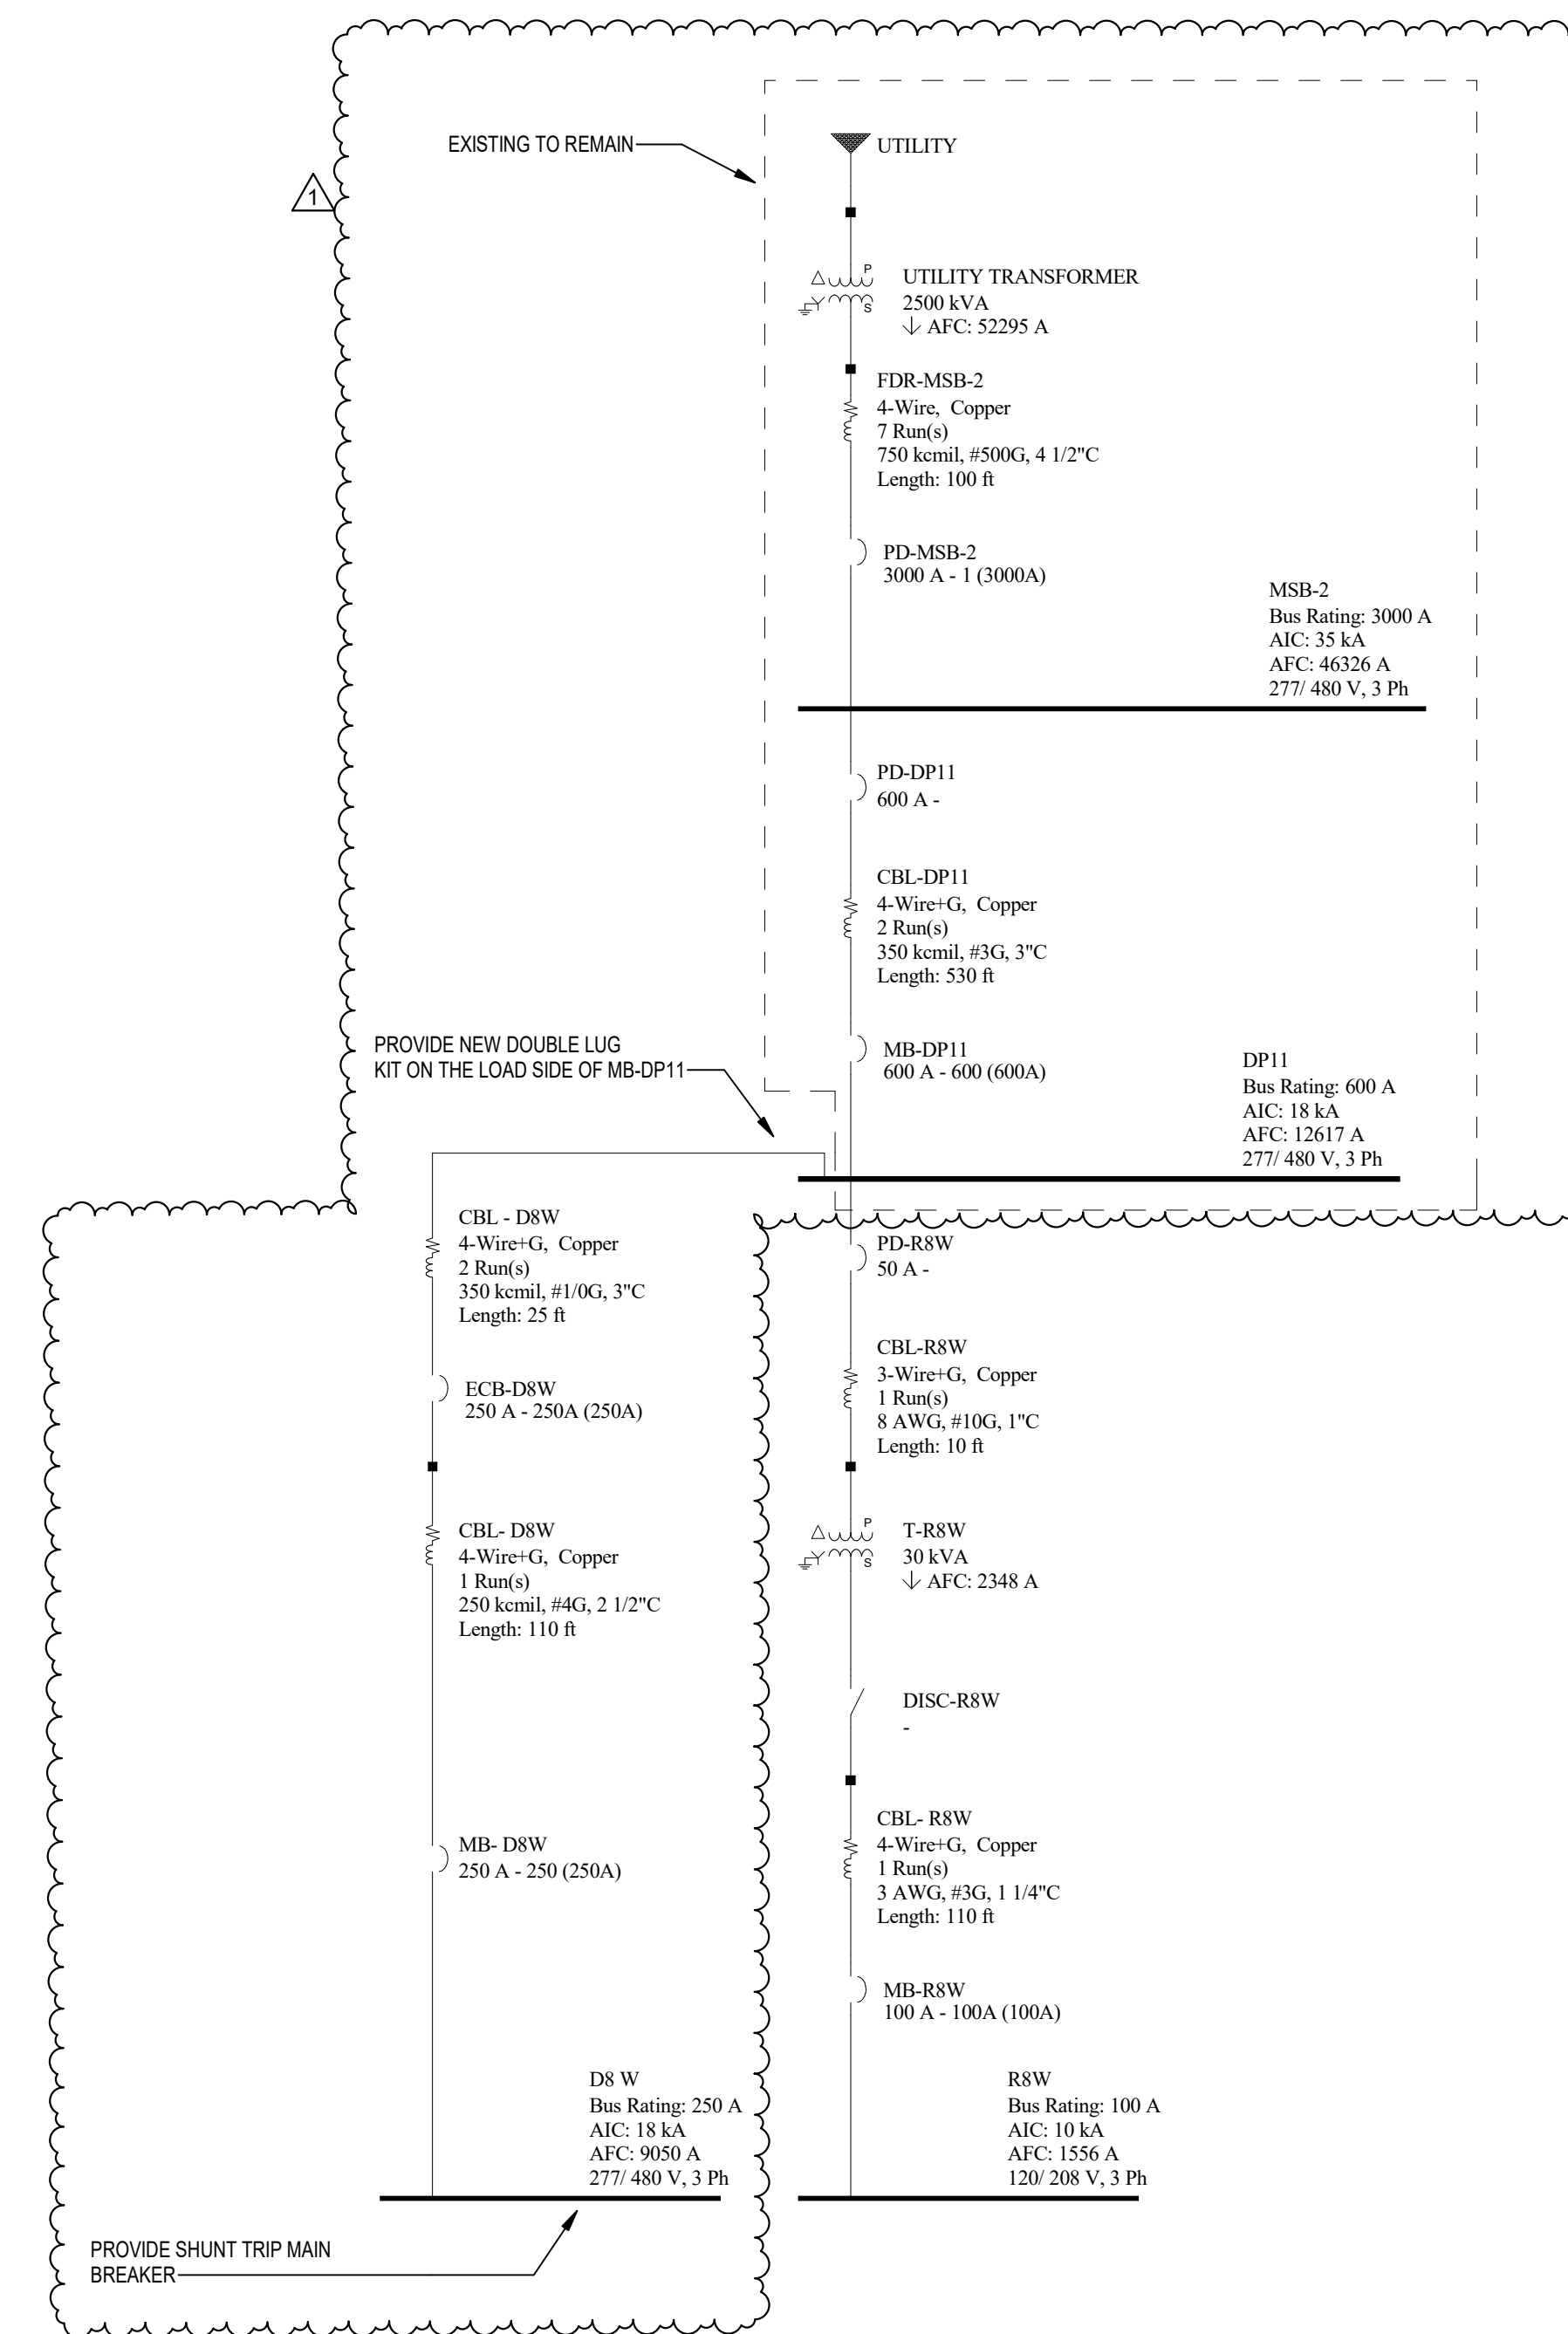

LOAD CALC PER NEC 630.11
INVERTER V276 = 14A ea
2'14" = 28A
1'14" = 11.9A
1'14" = 9.8
12'14" = 100.8
=160.5A = 125 KVA

PANEL DP11 LOAD CALCULATIONS:
EXISTING LOAD TAKEN FROM
AS BUILT DRAWINGS.
- 349.5 KVA

ADDITIONAL LOAD
- D8W = 125 KVA
- R8W = 7 KVA

NEW TOTAL 481.5 KVA = 579.2A @ 480V/3PH

ONE LINE DIAGRAM - ELECTRICAL

SCALE: NONE

GENERAL NOTES:

- SHORT CIRCUIT CALCULATIONS PERFORMED ON 3/30/2023 BASED ON ASSUMED TRANSFORMER SIZES SHOWN.
- PROVIDE ARC FLASH WARNING LABELS ON NEW ELECTRICAL EQUIPMENT DESIGNATED IN NEC 2017 110.16. CONTRACT ENGINEER FOR ELECTRONIC COPY OF LABELS.

NOTE: WIRE LENGTHS SHOWN ON ONE LINE DIAGRAM ARE FOR CALCULATIONS PURPOSES AND NOT INTENDED FOR MATERIAL TAKE-OFFS. CONTRACTOR SHALL USE SCALED PLANS FOR ACTUAL LENGTHS.

Branch Panel: D8W

Location: New Construction
Supply From: Volts: 480/277 Wye
Mounting: Surface Phases: 3
Enclosure: Type 3R Wires: 4
Notes: A.I.C. Rating: 18000 A
Main Type: MCB
Main Rating: 250 A
MCB Rating: 250 A
Trip Function: SHUNT

CKT	Load Name	Special	Trip	Poles	Wire Size	A	B	C	Wire Size	Poles	Trip	Special	Load Name	CKT
1						20,840				1			Space	2
3	WELDING PACK		90 A	3	3-#4, 1-#4, 1-#8		20,840			1			Space	4
5								20,840		1			Space	6
7	WELDING PACK		90 A	3	3-#4, 1-#4, 1-#8		20,840			1			Space	8
9								20,840		1			Space	10
11										1			Space	12
13	Spare		--	1	--	0	--			1			Space	14
15	Spare		--	1	--	0	--			1			Space	16
17	Spare		--	1	--	0	--			1			Space	18
19	Spare		--	1	--	0	--			1			Space	20
21	Spare		--	1	--	0	--			1			Space	22
23	Spare		--	1	--	0	--			1			Space	24
25	Spare		--	1	--	0	--			1			Space	26
27	Spare		--	1	--	0	--			1			Space	28
29	Spare		--	1	--	0	--			1			Space	30
Total Load:						41,680 VA	41,680 VA	41,680 VA						
Total Amps:						150 A	150 A	150 A						

Load Classification	Connected Load	Demand Factor	Estimated Demand	Panel Totals
Other	125040 VA	100.00%	125040 VA	
				Total Conn. Load: 125 KVA
				Total Est. Demand: 125 KVA
				Total Conn.: 150 A
				Total Est. Demand: 150 A

Notes:
*Provide conduit size per NEC 2017 Annex C, Tables C.1-C12a for specified wire type, size, and conductor material.

Branch Panel: R8W

Location: New Construction
Supply From: Volts: 120/208 Wye
Mounting: Surface Phases: 3
Enclosure: Type 3R Wires: 4
Notes: A.I.C. Rating: 10000 A
Main Type: MCB
Main Rating: 100 A
MCB Rating: 100 A
Trip Function:

CKT	Load Name	Special	Trip	Poles	Wire Size	A	B	C	Wire Size	Poles	Trip	Special	Load Name	CKT
1	RECEPT WEST BOOTHS		20 A	1	1-#12, 1-#12, 1-#12	720	450			1-#12, 1-#12, 1-#12	1	20 A	LIGHTING	2
3	RECEPT SOUTH BOOTHS		20 A	1	1-#12, 1-#12, 1-#12			720	250	1-#12, 1-#12, 1-#12	1	20 A	SHUNT TRIP POWER	4
5	RECEPT EAST BOOTHS		20 A	1	1-#12, 1-#12, 1-#12					1-#12, 1-#12, 1-#12	1	20 A	HVLS FAN	6
7	RECEPT NORTH BOOTHS		20 A	1	1-#12, 1-#12, 1-#12	720	720		900	1-#10, 1-#10, 1-#10	1	20 A	HVLS FAN	8
9	RECEPT KNEE WALL		20 A	1	1-#12, 1-#12, 1-#12			540	--	1-#10, 1-#10, 1-#10	1	--	Space	10
11	RECEPT KNEE WALL		20 A	1	1-#12, 1-#12, 1-#12				540	--	1	--	Space	12
13	RECEPT KNEE WALL		20 A	1	1-#12, 1-#12, 1-#12	540	--			--	1	--	Space	14
15	RECEPT KNEE WALL		20 A	1	1-#12, 1-#12, 1-#12			540	--	--	1	--	Space	16
17	RECEPT CORD REEL		20 A	1	1-#12, 1-#12, 1-#12				360	--	1	--	Space	18
19	RECEPT CORD REEL		20 A	1	1-#12, 1-#12, 1-#12	360	--			--	1	--	Space	20
21	Spare		--	1	--			0	--	--	1	--	Space	22
23	Spare		--	1	--			0	--	--	1	--	Space	24
25	Spare		--	1	--	0	--			--	1	--	Space	26
27	Spare		--	1	--	0	--			--	1	--	Space	28
29	Spare		--	1	--	0	--			--	1	--	Space	30
Total Load:						3,510 VA	2,050 VA	2,520 VA						
Total Amps:						30 A	17 A	22 A						

Load Classification	Connected Load	Demand Factor	Estimated Demand	Panel Totals
Lighting	450 VA	100.00%	450 VA	
Motor	1440 VA	112.50%	1620 VA	Total Conn. Load: 8 KVA
Other	250 VA	100.00%	250 VA	Total Est. Demand: 8 KVA
Receptacle	5940 VA	100.00%	5940 VA	Total Conn.: 22 A
				Total Est. Demand: 23 A

Notes:
*Provide conduit size per NEC 2020 Annex C, Tables C.1-C12a for specified wire type, size, and conductor material.

REVISIONS

NO.	DESCRIPTION	DRAWN	CHECKED	DATE
1	ADDENDUM #1	APA	ADW	12-16-24

PHASE

	DRAWN	CHECKED	DATE
SCHEMATIC DESIGN			07/15/24
DESIGN DEVELOPMENT	GAG	ADW	09/25/24
CONSTRUCTION DOCUMENTS	APA	ADW	11/08/24

JRA ARCHITECTS 2551 BLAIRSTONE PINES DR.
TALLAHASSEE, FL 32301
PHONE: (850) 878-7891
Commission Number: 24855

CONSULTANTS:

PROJECT:
CHILES HIGH SCHOOL WELDING LAB

LEON COUNTY, FLORIDA

SHEET TITLE:
PANEL SCHEDULES

SHEET NUMBER:
E4.0