SUPPLEMENT 1

Walton Schools District Office

Allstate Construction, Inc. February 14, 2025

Bid Date Change

1. The bid date has been extended. The revised subcontractor bid due date is March 4, 2025, 2:00pm Eastern Time.

Schedule

2. For bid purposes, reference attached Construction Schedule dated February 13, 2025, along with Schedule Narrative.

Architect's Addendum


- 3. Incorporate Architect's Addendum No. 1 which consists of:
 - Architect's Narrative
 - 14 Structural (S) drawings
 - 42 Architectural (A) drawings
 - 3 Fire Protection (FP) drawings
 - 8 Fire & Emergency (FE) drawings
 - 18 Plumbing (P drawings
 - 19 Mechanical (M) drawings
 - 3 Instrumentation & Controls (IC) drawings
 - 4 Electrical (E) drawings
 - 18 Telecommunications (T) drawings
 - 6 Access Control (ACS) drawings
 - 3 Security (SEC) drawings

Scopes of Work

4. The following bid package scopes of work (dated ____) have been posted to plan room website.


Complete this checklist and include it with the Bid Proposal form. These will be posted next week in a separate supplement.


END OF SUPPLEMENT

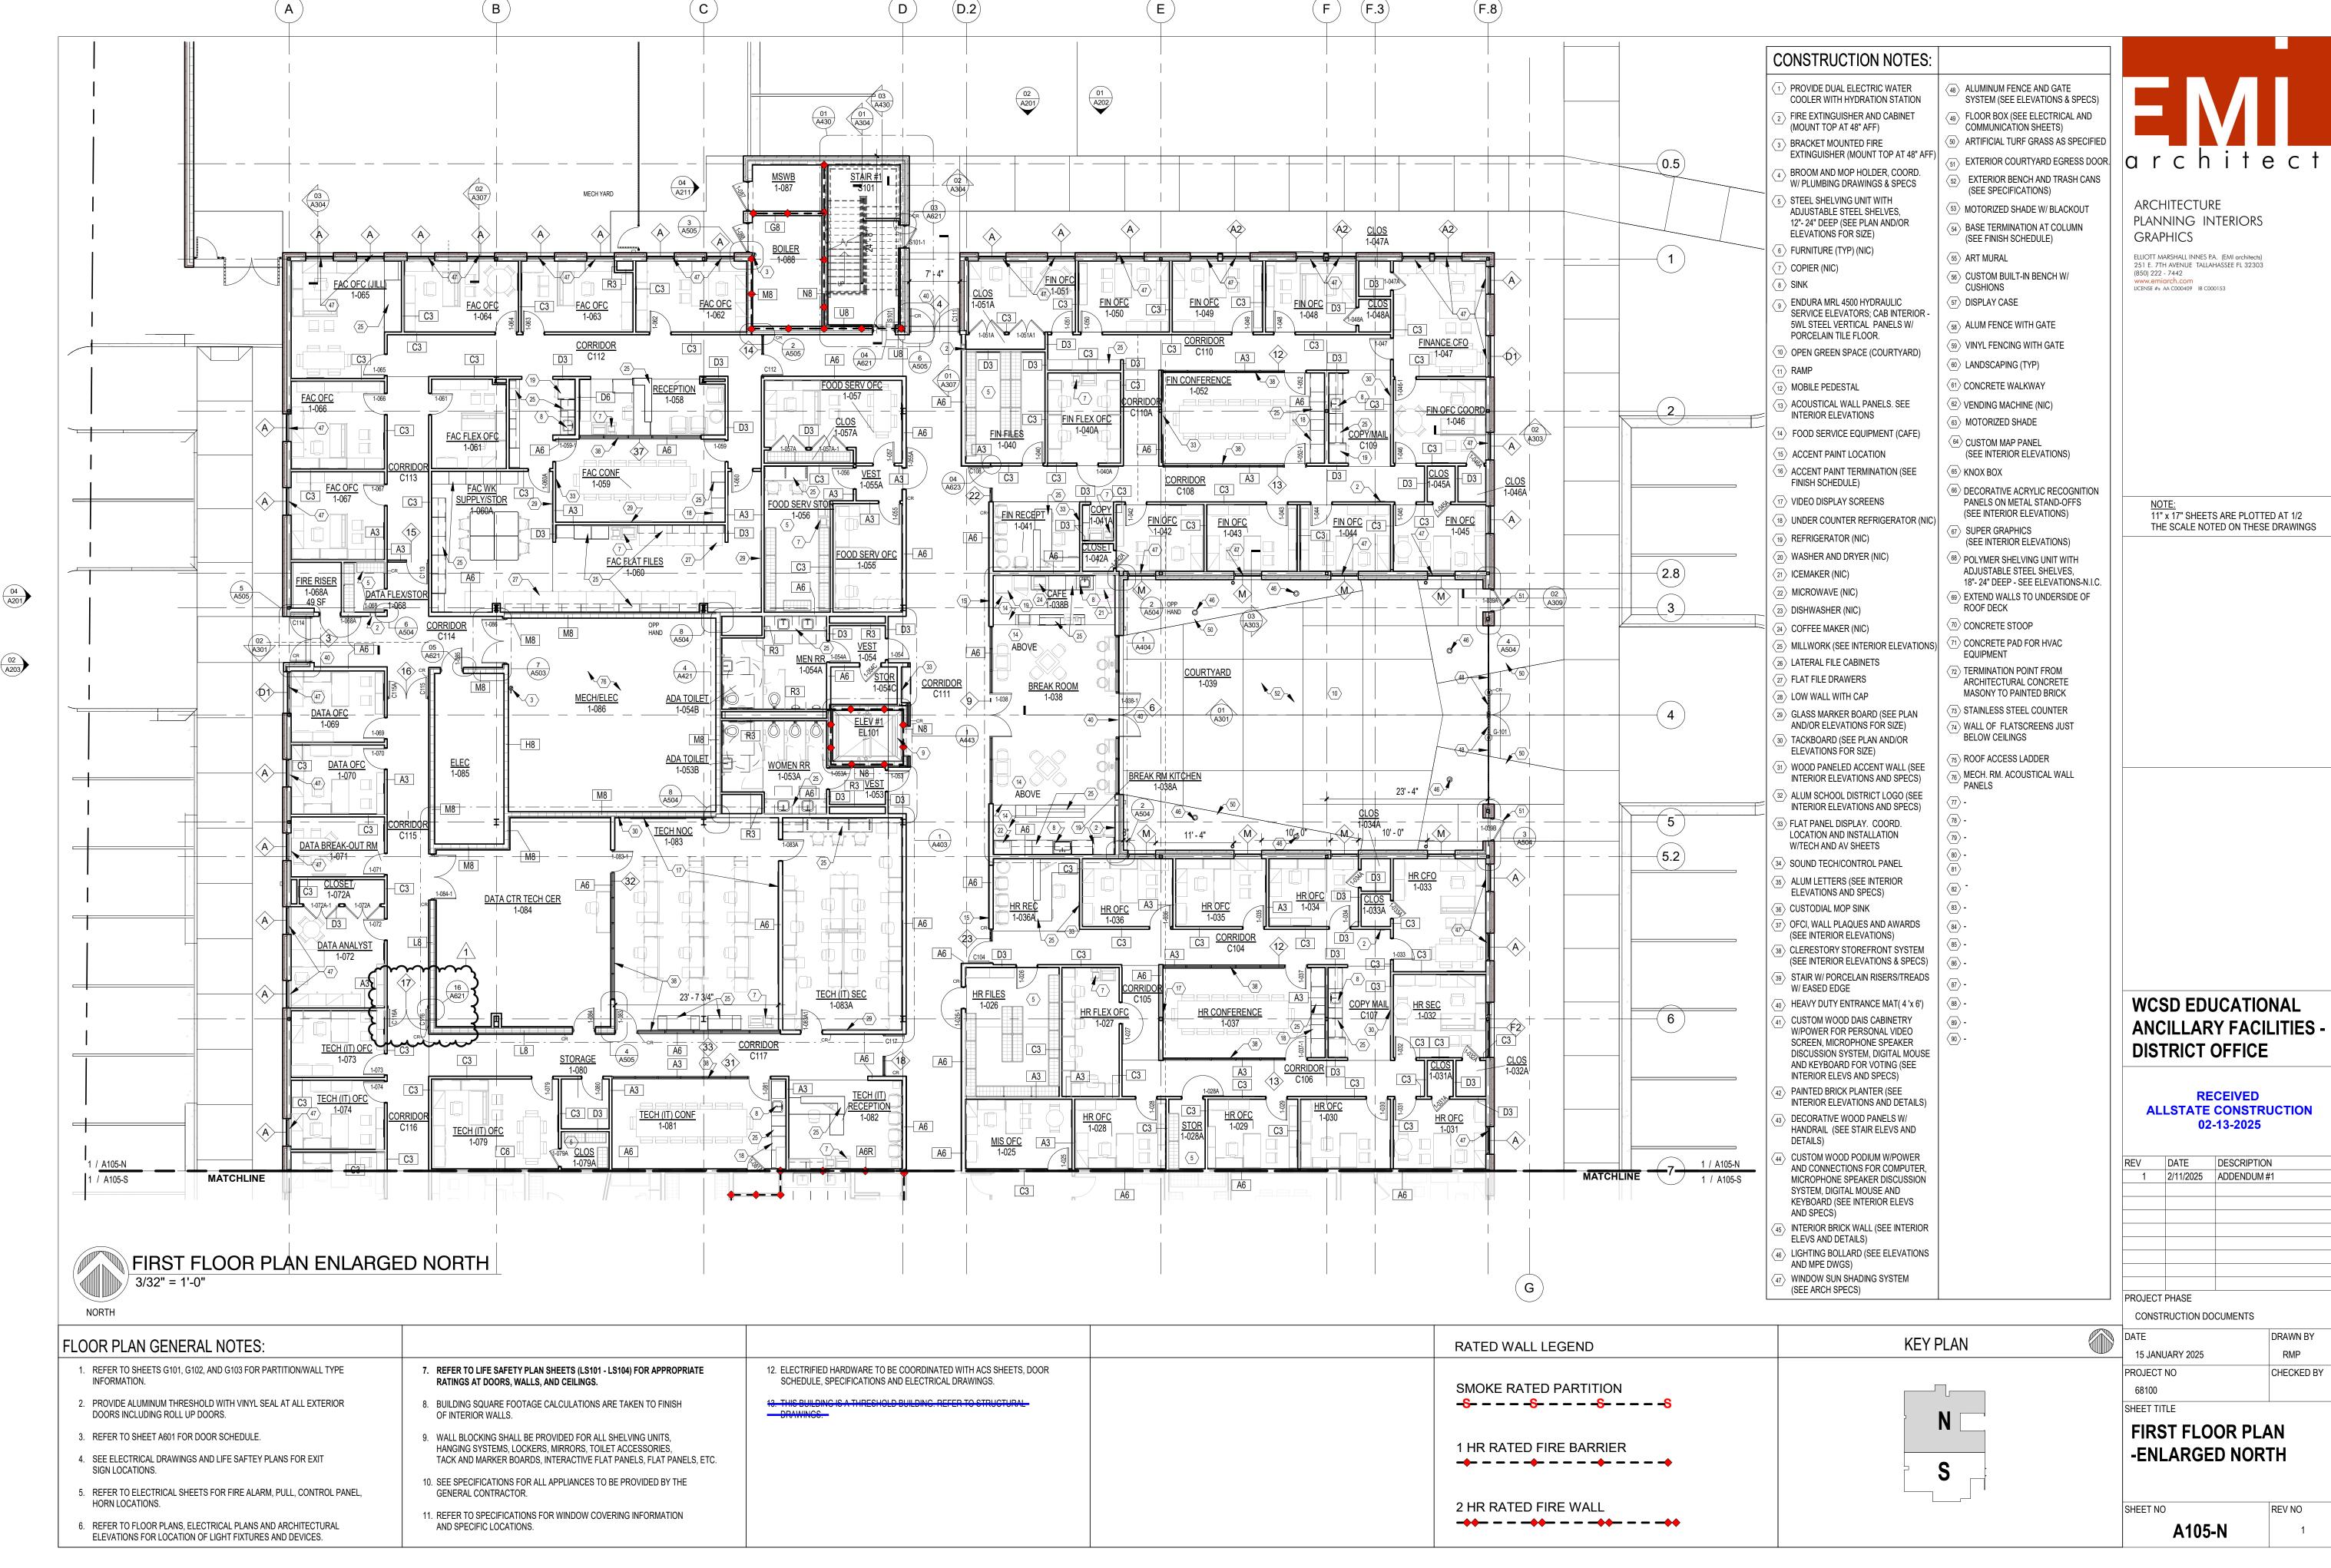








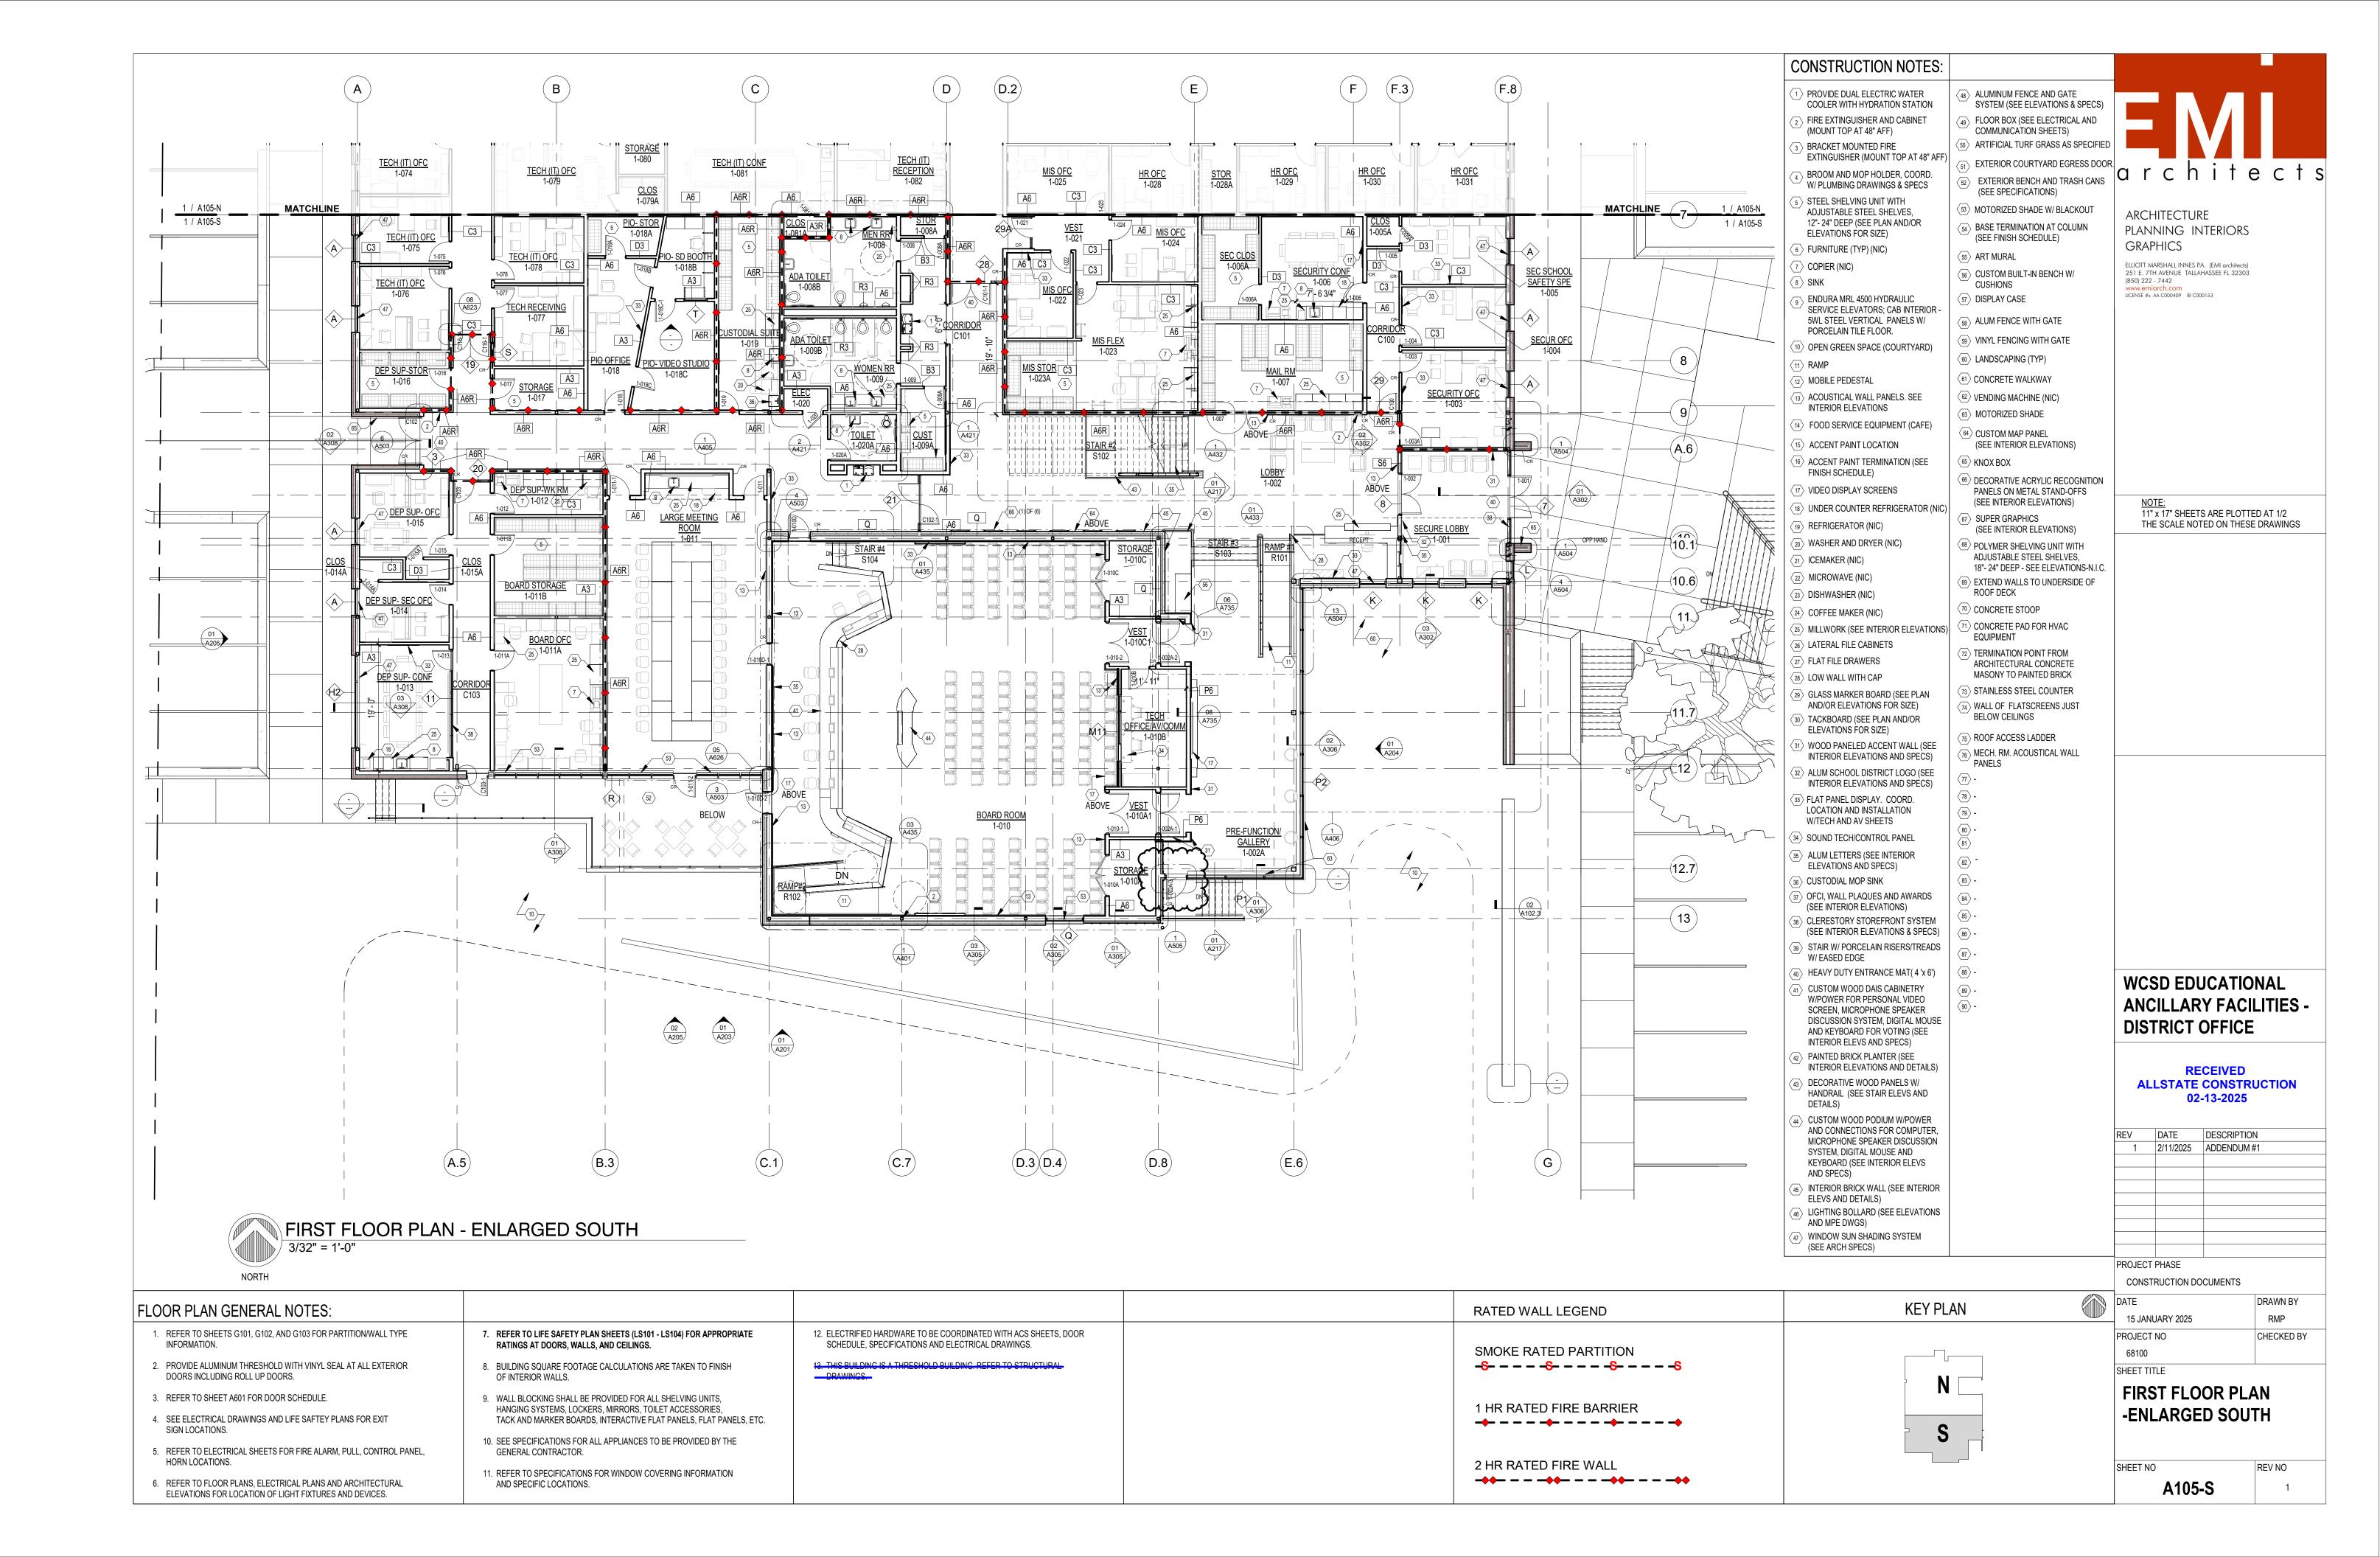


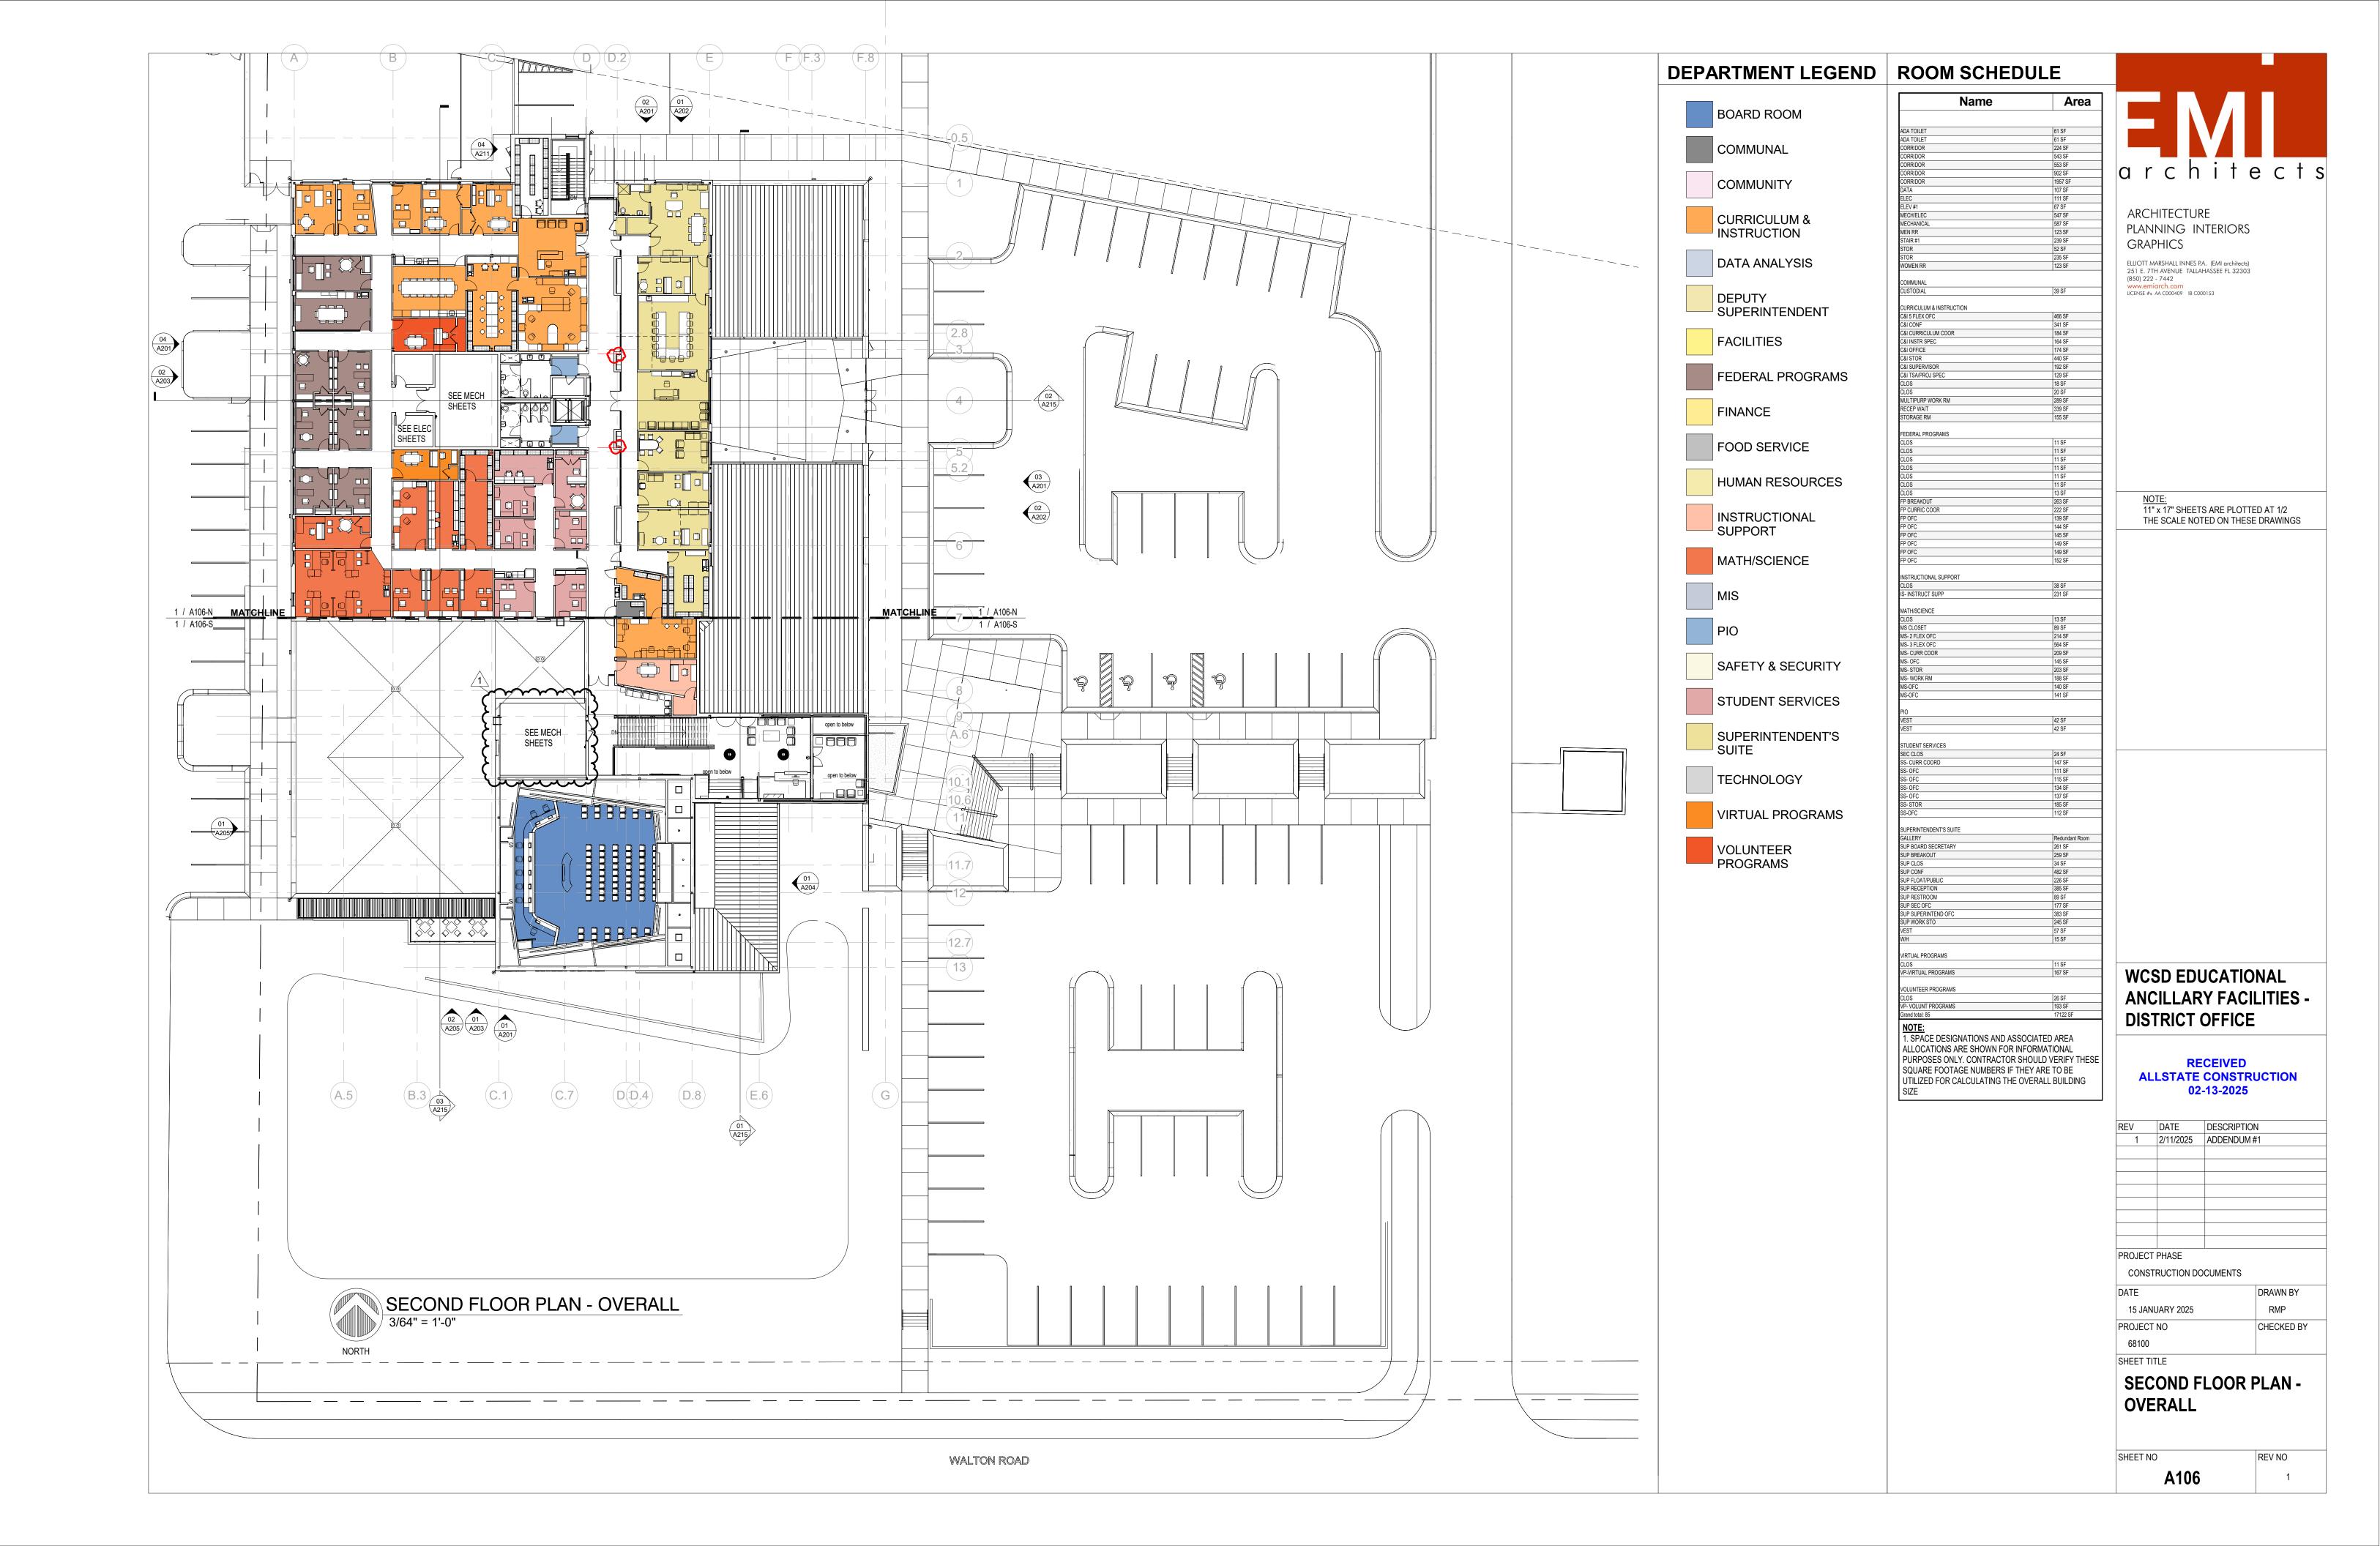

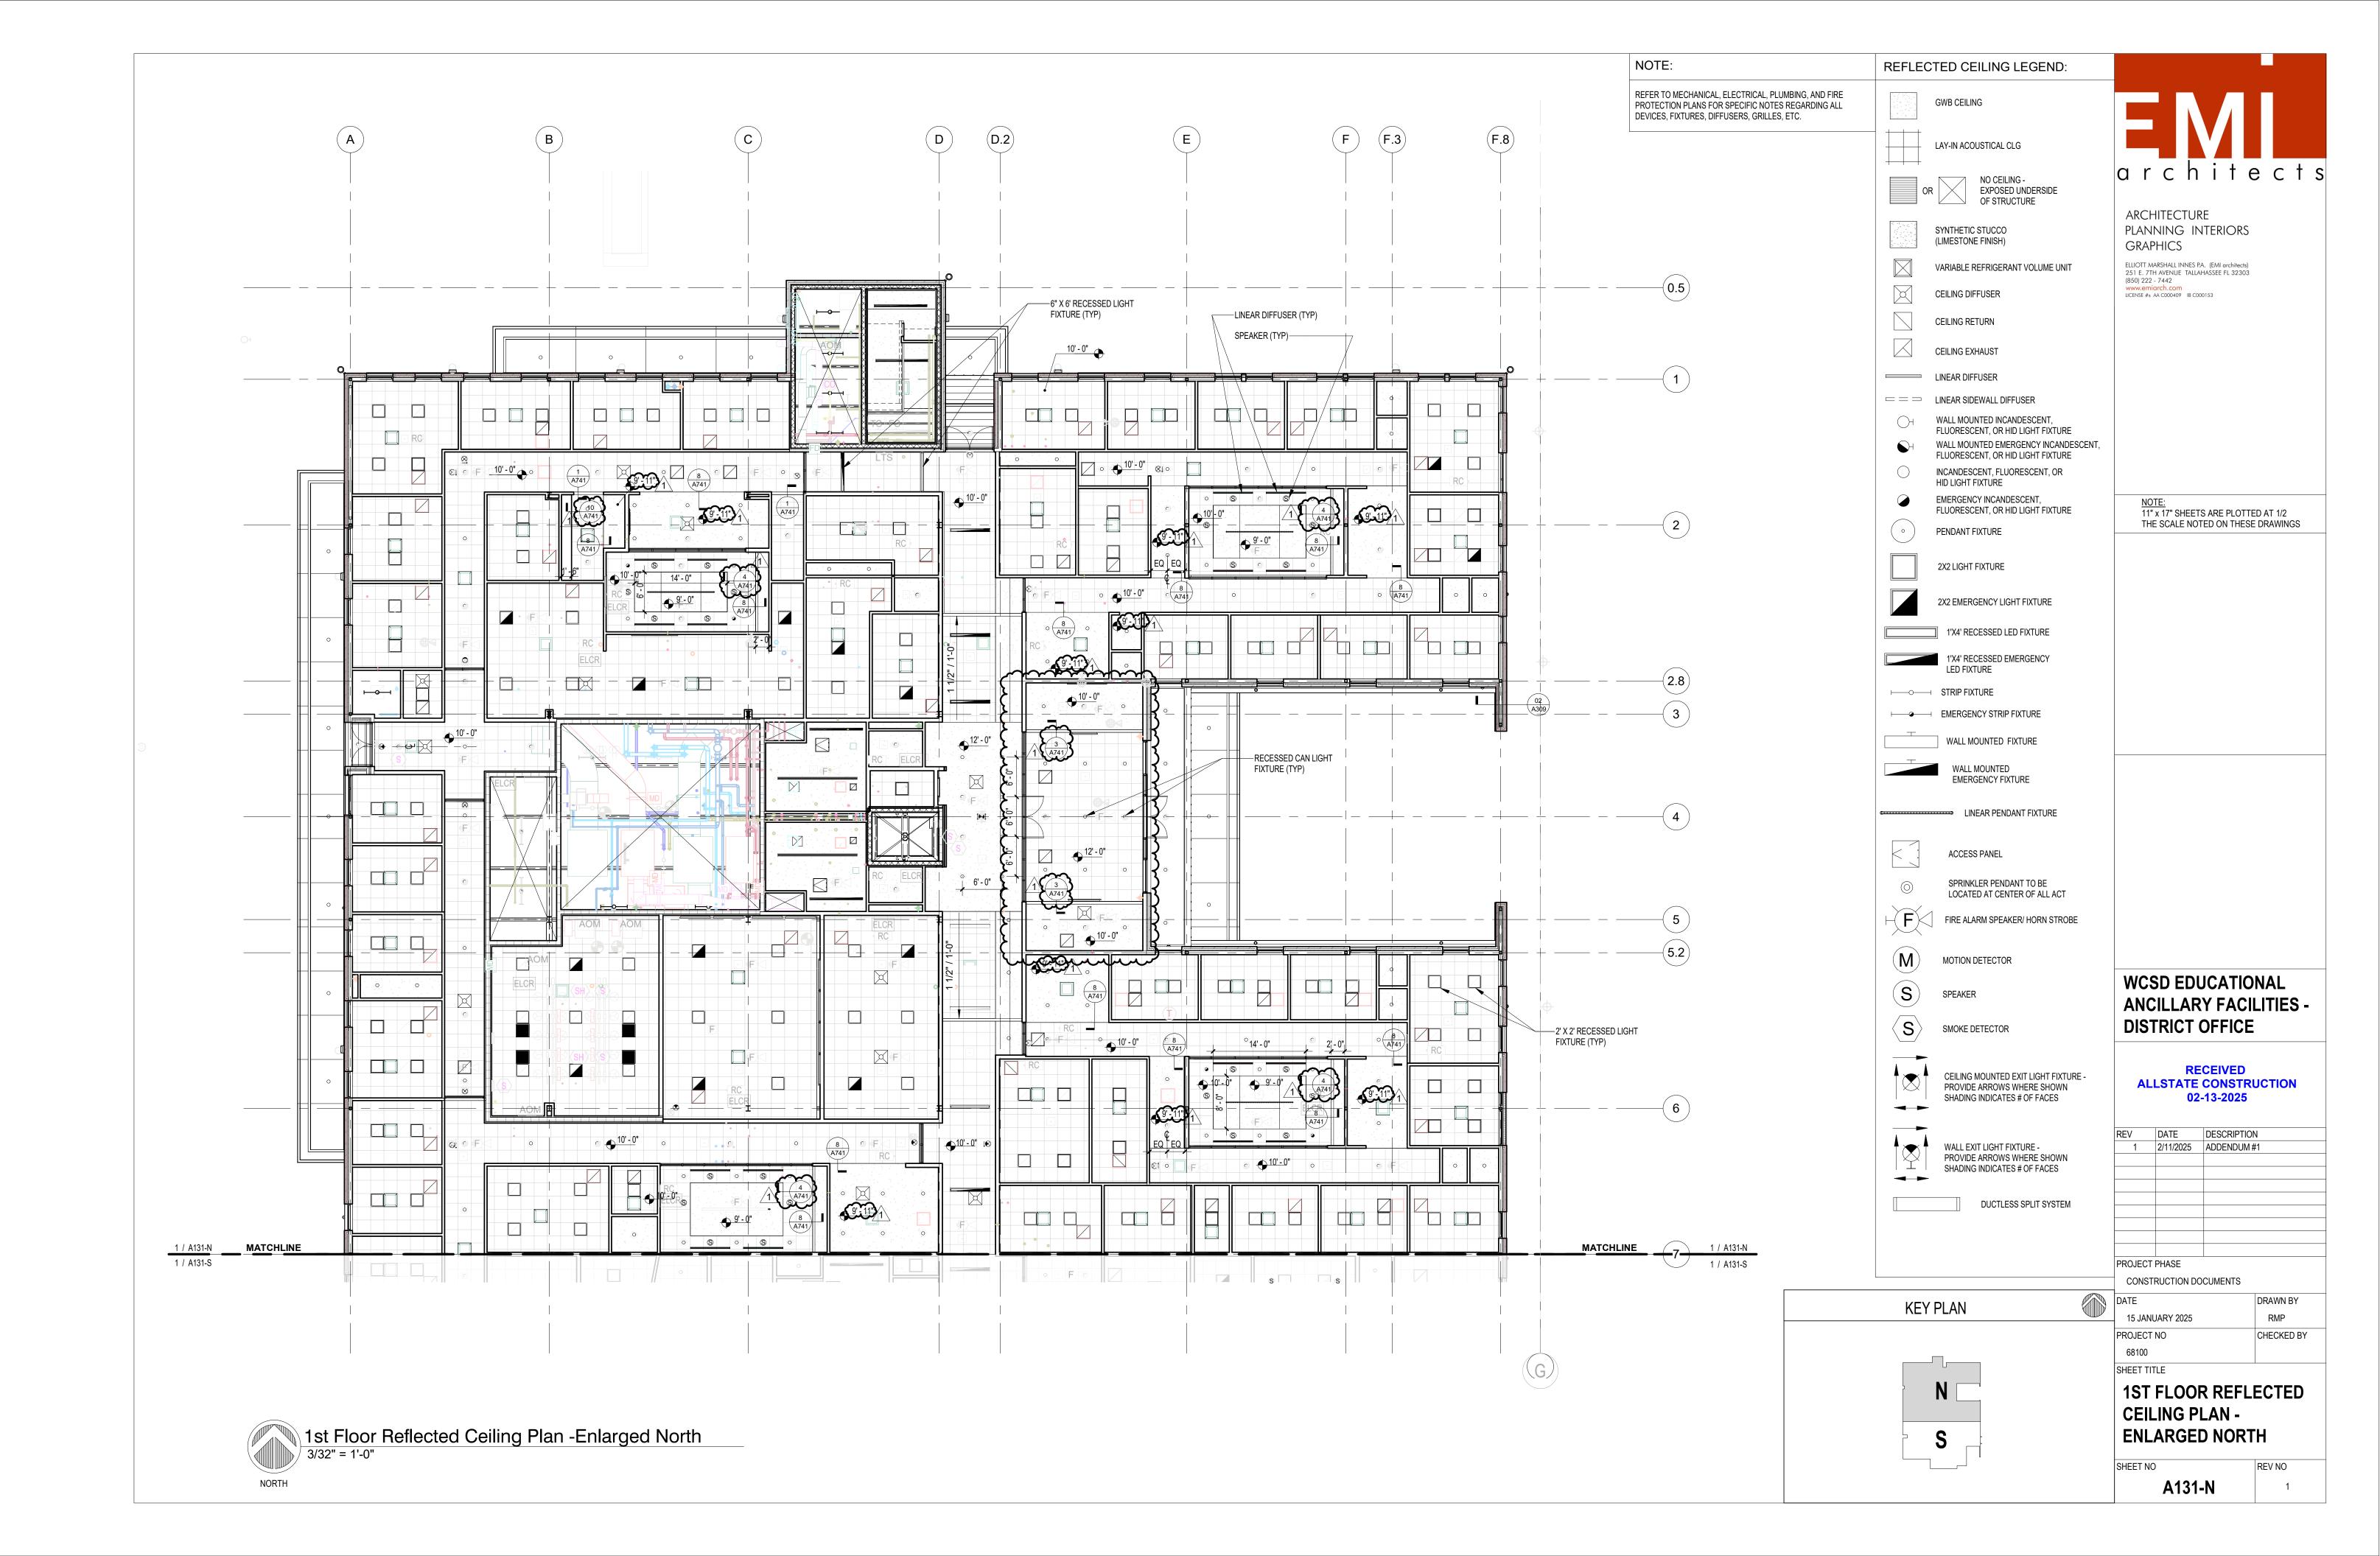


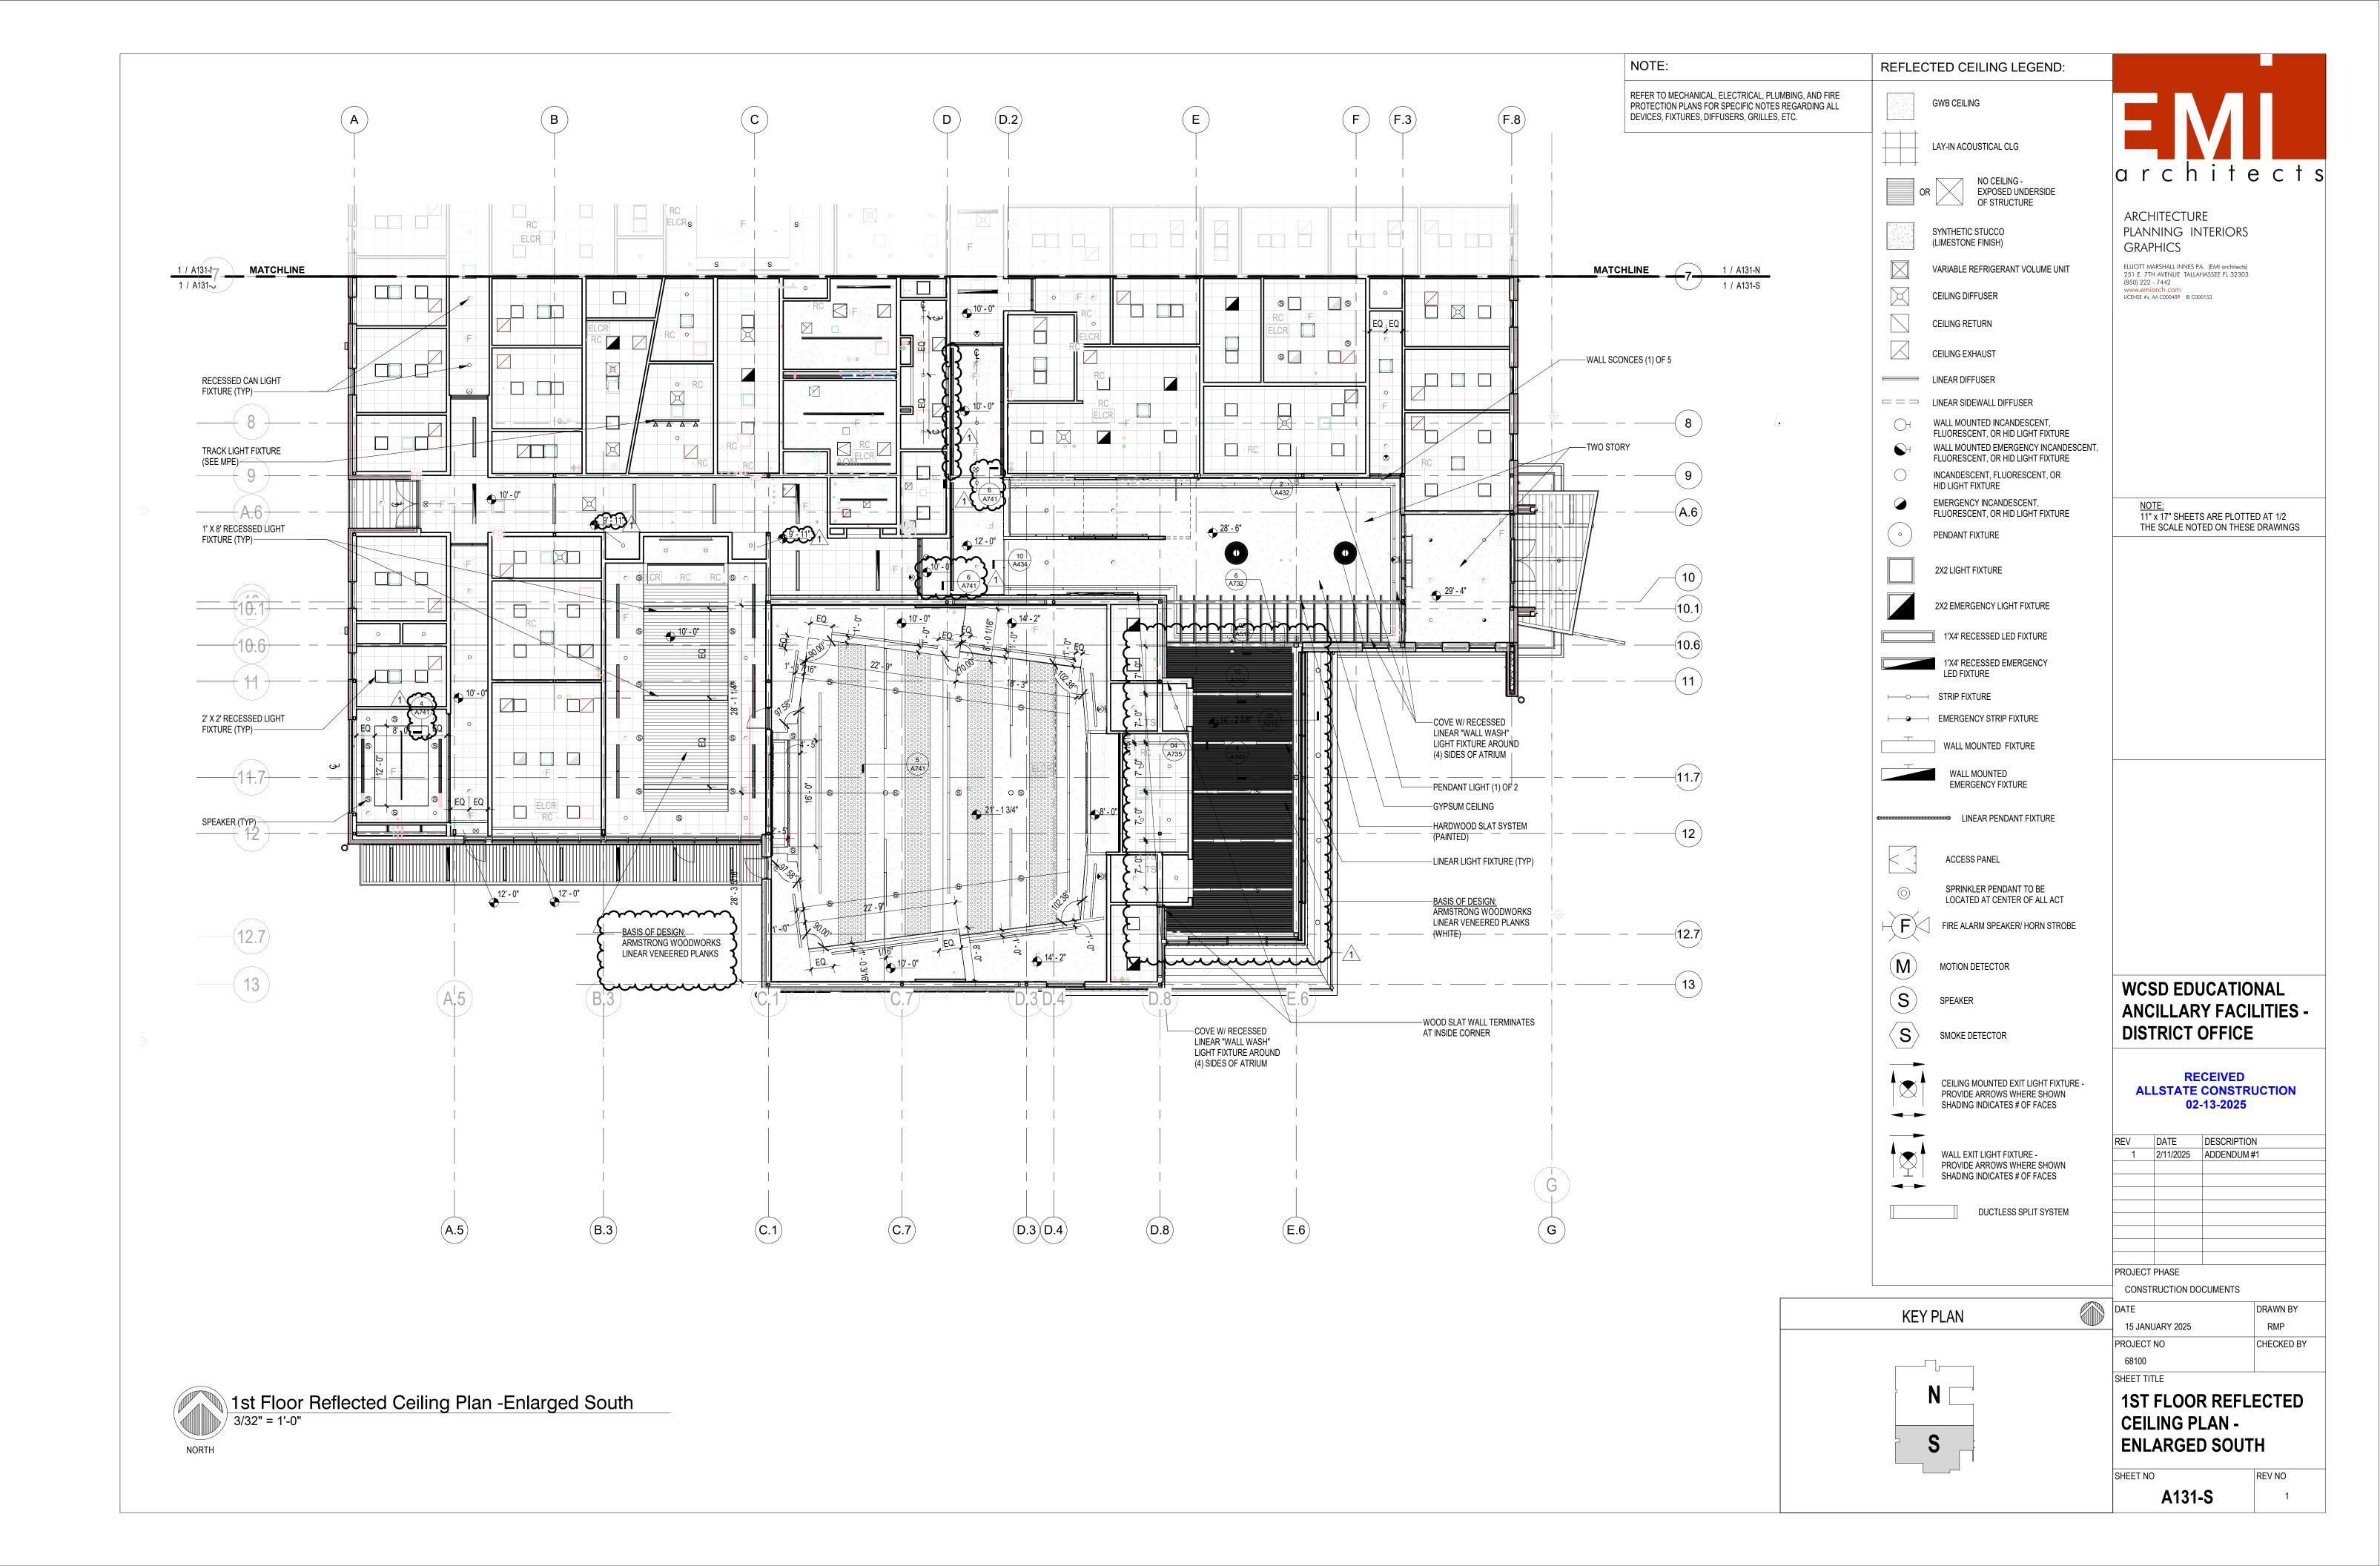

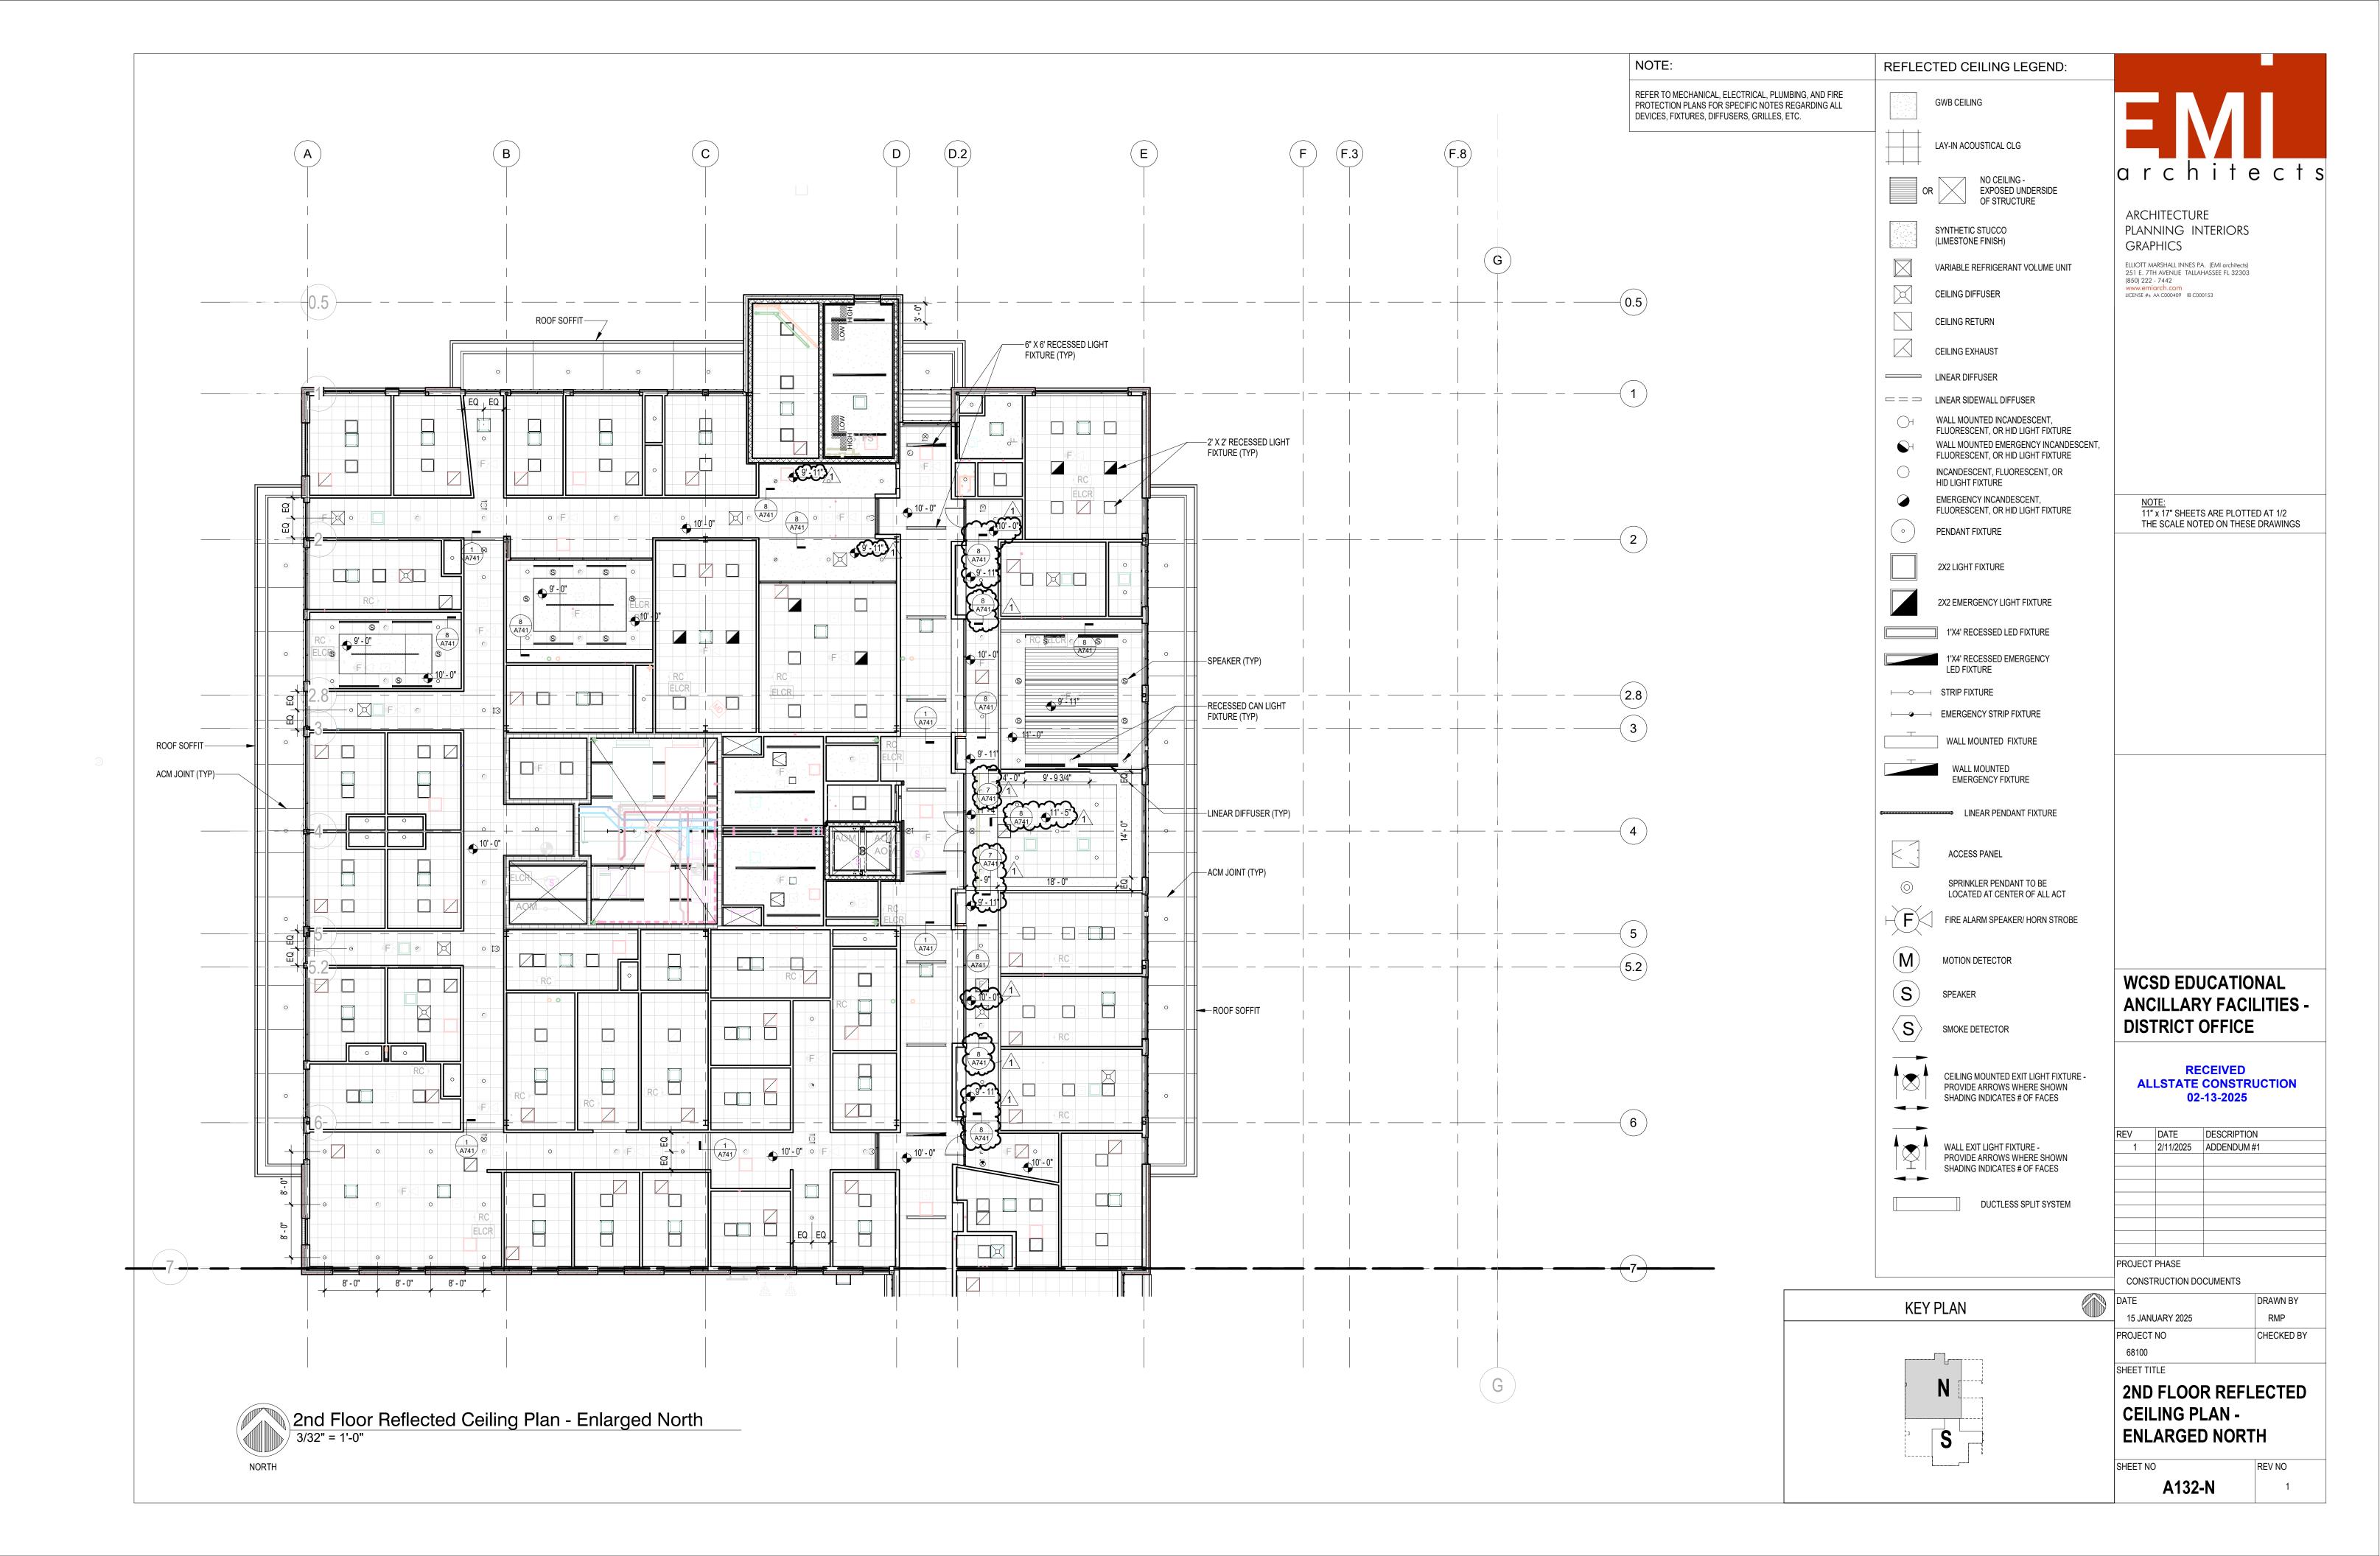

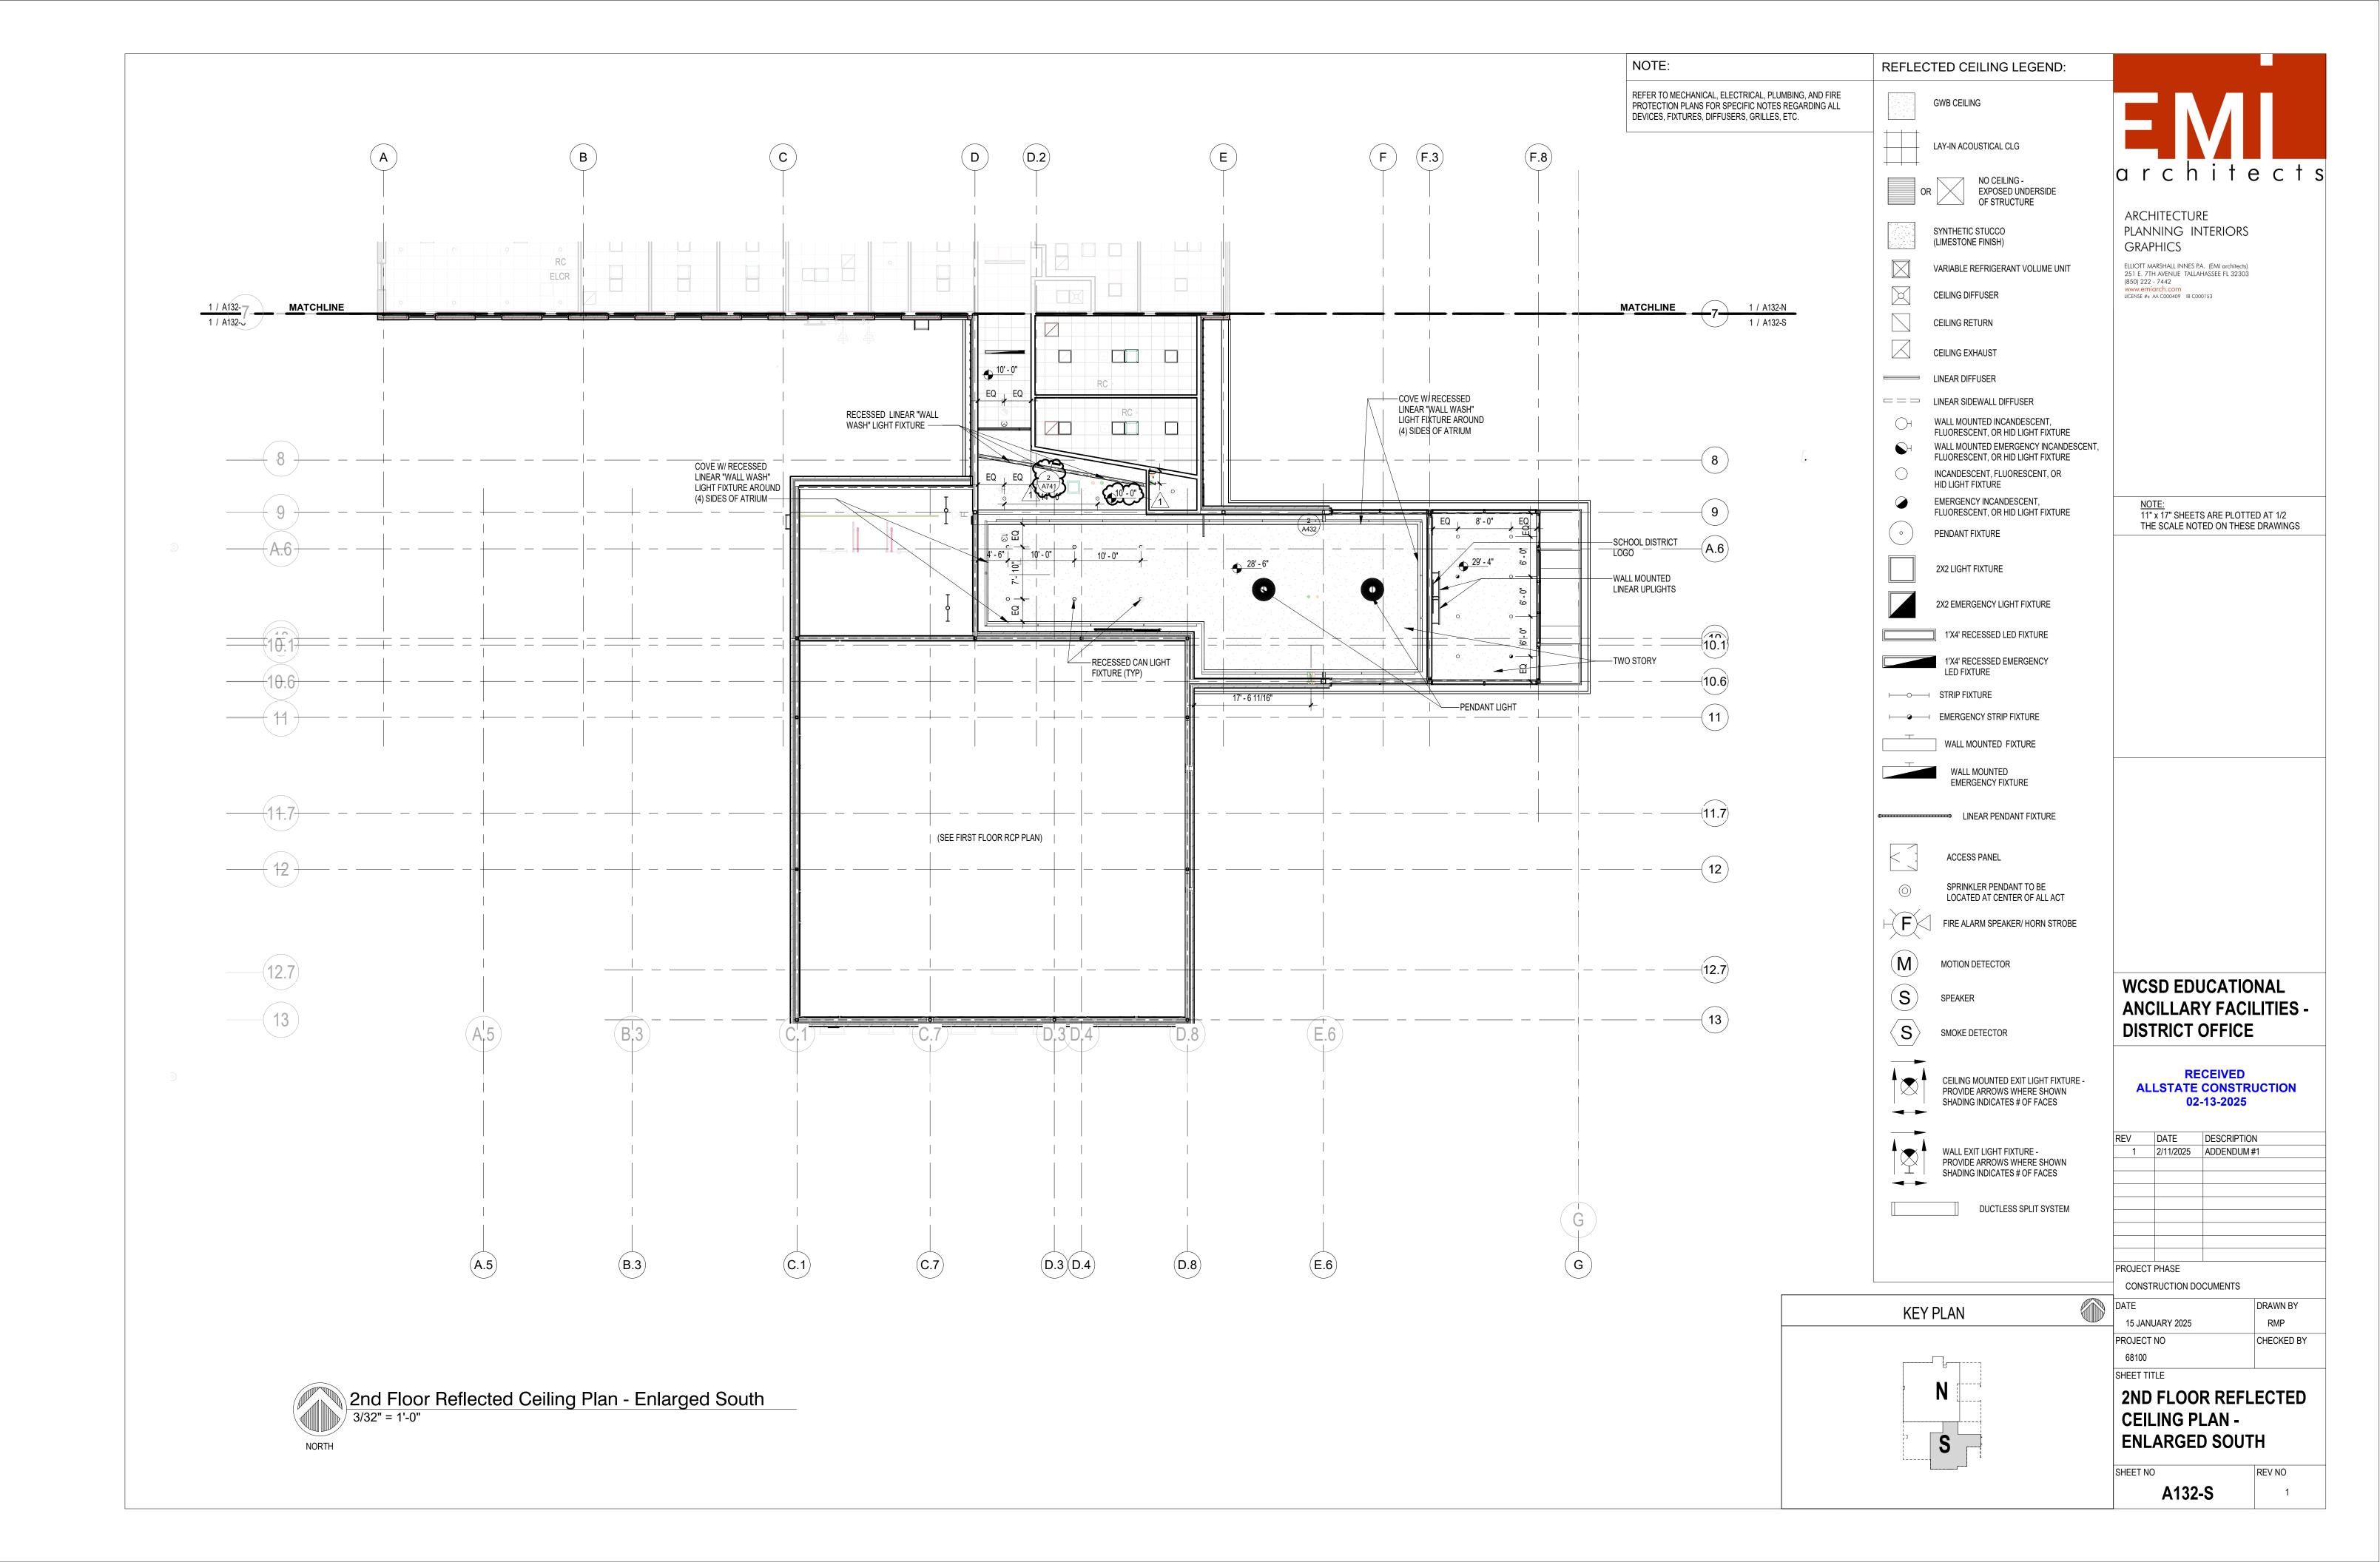

	RICK VENEER FB-1	WHITE PAINTED FACE BRICK
DARK BRONZE DARK BRONZE ALUM DOORS ALUM DOORS DARK BRONZE ALUMINUM ALUM DOOR FRAMES DARK BRONZE ALUMINUM ALUM DOOR FRAMES DARK BRONZE ALUMINUM DARK BRONZE ALUMINUM STEEL COLUMNS AND BEAMS TO BE SELECTED BY ARCHITECT EXTERIOR HAND RAILS TO BE SELECTED BY ARCHITECT CAULK @ WINDOWS, CONSTRUCTION JOINTS TO BE SELECTED BY ARCHITECT BRICK TO BRICK JOINTS TO BE SELECTED BY ARCHITECT BRICK TO BRICK EXPANSION JOINTS, ETC. TO BE SELECTED BY ARCHITECT BRICK TO BRICK EXPANSION JOINTS, ETC. TO BE SELECTED BY ARCHITECT BRICK TO BRICK LI (MWP-1) BRONZE METAL PANEL 1 (MWP-2) BRONZE METAL PANEL BOARD AND BATTEN PROFILE METAL WALL PANEL 1 (MWP-3) BRONZE METAL PANEL PENCIL RIB PROFILE METAL WALL PANEL 1 (MWP-3) BRONZE WETICAL FLUSH METAL PANELS STANDING SEAM METAL ROOF TO BE SELECTED BY ARCHITECT TO BE SELECTED BY ARCHITECT TO SELECT FROM MFR RANGE OF MEDIUM-TO-MEDIUM LIGHT GREY COLOR TO BE SELECTED BY ARCHITECT TO SELECT FROM MFR RANGE OF MEDIUM-TO-MEDIUM LIGHT GREY COLOR TO BE SELECTED BY ARCHITECT TO SELECT FROM MFR RANGE OF MEDIUM-TO-MEDIUM LIGHT GREY COLOR TO BE SELECTED BY ARCHITECT TO SELECT FROM MFR RANGE OF MEDIUM-TO-MEDIUM LIGHT GREY COLOR TO BE SELECTED BY ARCHITECT TO SELECT FROM MFR RANGE OF MEDIUM-TO-MEDIUM LIGHT GREY COLOR TO BE SELECTED BY ARCHITECT	RICK VENEER FB-2	WOOD MOULD REDDISH - BROWN FACE BRICK
DARK BRONZE ALUM DOORS ALUM DOOR FRAMES DARK BRONZE ALUMINUM ALUM DOOR FRAMES DARK BRONZE ALUMINUM STEEL COLUMNS AND BEAMS TO BE SELECTED BY ARCHITECT EXTERIOR HAND RAILS TO BE SELECTED BY ARCHITECT CAULK @ WINDOWS, CONSTRUCTION JOINTS TO BE SELECTED BY ARCHITECT BRICK TO BRICK JOINTS TO BE SELECTED BY ARCHITECT BRICK TO BRICK EXPANSION JOINTS, ETC. TO BE SELECTED BY ARCHITECT ROLL UP DOORS TBD METAL WALL PANEL 1 (MWP-1) BRONZE METAL PANEL BOARD AND BATTEN PROFILE METAL WALL PANEL 1 (MWP-3) BRONZE METAL PANEL PENCIL RIB PROFILE METAL WALL PANEL 1 (MWP-3) BRONZE VERTICAL FLUSH METAL PANELS STANDING SEAM METAL ROOF TO BE SELECTED BY ARCHITECT TO BE SELECTED BY ARCHITECT GRONZE METAL PANEL PANEL PANELS TO BE SELECTED BY ARCHITECT	/INDOW FRAMES	DARK BRONZE ANODIZED
DARK BRONZE ALUMINUM ALUM DOOR FRAMES DARK BRONZE ALUMINUM STEEL COLUMNS AND BEAMS TO BE SELECTED BY ARCHITECT EXTERIOR HAND RAILS TO BE SELECTED BY ARCHITECT EXTERIOR GUARD RAILS TO BE SELECTED BY ARCHITECT CAULK @ WINDOWS, CONSTRUCTION JOINTS TO BE SELECTED BY ARCHITECT WORTAR TO BE SELECTED BY ARCHITECT BRICK TO BRICK JOINTS TO BE SELECTED BY ARCHITECT BRICK TO BRICK EXPANSION JOINTS, ETC. TO BE SELECTED BY ARCHITECT ROLL UP DOORS TBD METAL WALL PANEL 1 (MWP-1) BRONZE METAL PANEL BOARD AND BATTEN PROFILE METAL WALL PANEL 1 (MWP-2) BRONZE METAL PANEL PENCIL RIB PROFILE METAL WALL PANEL 1 (MWP-3) BRONZE WETAL FLUSH METAL PANELS STANDING SEAM METAL ROOF TO BE SELECTED BY ARCHITECT DOWNSPOUTS TO BE SELECTED BY ARCHITECT GREY. ARCHITECT TO SELECT FROM MFR RANGE OF MEDIUM-TO-MEDIUM LIGHT GREY COLOR	M DOORS	DARK BRONZE
ALUM DOOR FRAMES DARK BRONZE ALUMINUM STEEL COLUMNS AND BEAMS TO BE SELECTED BY ARCHITECT EXTERIOR HAND RAILS TO BE SELECTED BY ARCHITECT EXTERIOR GUARD RAILS TO BE SELECTED BY ARCHITECT CAULK @ WINDOWS, CONSTRUCTION JOINTS TO BE SELECTED BY ARCHITECT MORTAR TO BE SELECTED BY ARCHITECT BRICK TO BRICK JOINTS TO BE SELECTED BY ARCHITECT BRICK TO BRICK EXPANSION JOINTS, ETC. TO BE SELECTED BY ARCHITECT BRICK TO BRICK EXPANSION JOINTS, ETC. TO BE SELECTED BY ARCHITECT BRONZE METAL PANEL BOARD AND BATTEN PROFILE METAL WALL PANEL 1 (MWP-1) BRONZE METAL PANEL BOARD AND BATTEN PROFILE METAL WALL PANEL 1 (MWP-2) BRONZE METAL PANEL PENCIL RIB PROFILE METAL WALL PANEL 1 (MWP-3) BRONZE VERTICAL FLUSH METAL PANELS STANDING SEAM METAL ROOF TO BE SELECTED BY ARCHITECT	M FRAMES	DARK BRONZE
TO BE SELECTED BY ARCHITECT EXTERIOR HAND RAILS TO BE SELECTED BY ARCHITECT EXTERIOR GUARD RAILS TO BE SELECTED BY ARCHITECT CAULK @ WINDOWS, CONSTRUCTION JOINTS TO BE SELECTED BY ARCHITECT MORTAR TO BE SELECTED BY ARCHITECT BRICK TO BRICK JOINTS TO BE SELECTED BY ARCHITECT BRICK TO BRICK EXPANSION JOINTS, ETC. TO BE SELECTED BY ARCHITECT BRICK TO BRICK EXPANSION JOINTS, ETC. TO BE SELECTED BY ARCHITECT BRICK TO BRICK EXPANSION JOINTS, ETC. TO BE SELECTED BY ARCHITECT BRICK TO BRICK EXPANSION JOINTS, ETC. TO BE SELECTED BY ARCHITECT BRONZE METAL PANEL BOARD AND BATTEN PROFILE METAL WALL PANEL 1 (MWP-1) BRONZE METAL PANEL PENCIL RIB PROFILE METAL WALL PANEL 1 (MWP-2) BRONZE METAL PANEL PENCIL RIB PROFILE METAL WALL PANEL 1 (MWP-3) BRONZE VERTICAL FLUSH METAL PANELS STANDING SEAM METAL ROOF TO BE SELECTED BY ARCHITECT DOWNSPOUTS TO BE SELECTED BY ARCHITECT	LUM DOORS	DARK BRONZE ALUMINUM
EXTERIOR HAND RAILS TO BE SELECTED BY ARCHITECT MORTAR TO BE SELECTED BY ARCHITECT BRICK TO BRICK JOINTS TO BE SELECTED BY ARCHITECT BRICK TO BRICK EXPANSION JOINTS, ETC. TO BE SELECTED BY ARCHITECT BROLL UP DOORS TBD METAL WALL PANEL 1 (MWP-1) BRONZE METAL PANEL BOARD AND BATTEN PROFILE METAL WALL PANEL 1 (MWP-2) BRONZE METAL PANEL PENCIL RIB PROFILE METAL WALL PANEL 1 (MWP-3) BRONZE VERTICAL FLUSH METAL PANELS STANDING SEAM METAL ROOF TO BE SELECTED BY ARCHITECT DOWNSPOUTS TO BE SELECTED BY ARCHITECT GREY. ARCHITECT TO SELECT FROM MFR RANGE OF MEDIUM-TO-MEDIUM LIGHT GREY COLOR GREY. ARCHITECT TO SELECT FROM MFR RANGE OF MEDIUM-TO-MEDIUM LIGHT GREY COLOR TO BE SELECTED TO SELECT FROM MFR RANGE OF MEDIUM-TO-MEDIUM LIGHT GREY COLOR TO BE SELECTED TO SELECT FROM MFR RANGE OF MEDIUM-TO-MEDIUM LIGHT GREY COLOR TO BE SELECTED TO SELECT FROM MFR RANGE OF MEDIUM-TO-MEDIUM LIGHT GREY COLOR TO BE SELECTED TO SELECT FROM MFR RANGE OF MEDIUM-TO-MEDIUM LIGHT GREY COLOR TO BE SELECTED TO SELECT FROM MFR RANGE OF MEDIUM-TO-MEDIUM LIGHT GREY COLOR TO BE SELECTED TO SELECT TO SELECT FROM MFR RANGE OF MEDIUM-TO-MEDIUM LIGHT GREY COLOR TO BE SELECTED TO SELECT TO SELECT FROM MFR RANGE OF MEDIUM-TO-MEDIUM LIGHT GREY COLOR TO BE SELECTED TO SELECT TO SELECT FROM MFR RANGE OF MEDIUM-TO-MEDIUM LIGHT GREY COLOR TO BE SELECTED TO SELECT TO SELECT FROM MFR RANGE OF MEDIUM-TO-MEDIUM LIGHT GREY COLOR TO BE SELECTED TO SELECT FROM MFR TRANGE OF MEDIUM-TO-MEDIUM LIGHT GREY COLOR TO BE SELECTED TO SELECT FROM MFR TRANGE OF MEDIUM-TO-MEDIUM LIGHT GREY COLOR TO BE SELECTED TO SELECT FROM MFR TRANGE OF MEDIUM-TO-MEDIUM LIGHT GREY COLOR TO BE SELECTED TO SELECT FROM MFR TRANGE OF MEDIUM-TO-MEDIUM LIGHT GREY COLOR TO BE SELECTED TO SELECT FROM MFR TRANGE OF MEDIUM-TO-MEDIUM LIGHT GREY COLOR TO BE SELECTED BY ARCHITECT TO SELECT FROM MFR TRANGE OF MEDIUM-TO-MEDIUM LIGHT GREY COLOR TO BE SELECTED	LUM DOOR FRAMES	DARK BRONZE ALUMINUM
TO BE SELECTED BY ARCHITECT CAULK @ WINDOWS, CONSTRUCTION JOINTS TO BE SELECTED BY ARCHITECT MORTAR TO BE SELECTED BY ARCHITECT BRICK TO BRICK JOINTS BRICK TO BRICK EXPANSION JOINTS, ETC. TO BE SELECTED BY ARCHITECT BROLL UP DOORS TBD METAL WALL PANEL 1 (MWP-1) BRONZE METAL PANEL BOARD AND BATTEN PROFILE METAL WALL PANEL 1 (MWP-2) BRONZE METAL PANEL PENCIL RIB PROFILE METAL WALL PANEL 1 (MWP-3) BRONZE VERTICAL FLUSH METAL PANELS STANDING SEAM METAL ROOF TO BE SELECTED BY ARCHITECT DOWNSPOUTS TO BE SELECTED BY ARCHITECT GREY. ARCHITECT TO SELECT FROM MFR RANGE OF MEDIUM-TO-MEDIUM LIGHT GREY COLOR GREY. ARCHITECT TO SELECT FROM MFR RANGE OF MEDIUM-TO-MEDIUM LIGHT GREY COLOR TO BE SELECTED BY ARCHITECT TO SELECT FROM MFR RANGE OF MEDIUM-TO-MEDIUM LIGHT GREY COLOR TO BE SELECTED TO SELECT FROM MFR RANGE OF MEDIUM-TO-MEDIUM LIGHT GREY COLOR TO BE SELECTED TO SELECT TROM MFR RANGE OF MEDIUM-TO-MEDIUM LIGHT GREY COLOR TO BE SELECTED TO SELECT FROM MFR RANGE OF MEDIUM-TO-MEDIUM LIGHT GREY COLOR TO BE SELECTED TO SELECT FROM MFR RANGE OF MEDIUM-TO-MEDIUM LIGHT GREY COLOR TO BE SELECTED TO SELECT TROM MFR RANGE OF MEDIUM-TO-MEDIUM LIGHT GREY COLOR TO BE SELECTED TO SELECT TROM MFR RANGE OF MEDIUM-TO-MEDIUM LIGHT GREY COLOR TO BE SELECTED TO SELECT TROM MFR RANGE OF MEDIUM-TO-MEDIUM LIGHT GREY COLOR TO BE SELECTED TO SELECT TROM MFR RANGE OF MEDIUM-TO-MEDIUM LIGHT GREY COLOR TO BE SELECTED TO SELECT TROM MFR RANGE OF MEDIUM-TO-MEDIUM LIGHT GREY COLOR TO BE SELECTED TO SELECT TROM MFR RANGE OF MEDIUM-TO-MEDIUM LIGHT GREY COLOR TO BE SELECTED TO SELECT TROM MFR RANGE OF MEDIUM-TO-MEDIUM LIGHT TO BE SELECTED BY ARCHITECT BRICK TO BRICK JOINTS TO BE SELECTED BY ARCHITECT BRICK TO BRICK EXPANSION JOINTS, ETC. TO BE SELECTED BY ARCHITECT ROLL UP DOORS TBD METAL WALL PANEL 1 (MWP-1) BRONZE METAL PANEL BOARD AND BATTEN PROFILE METAL WALL PANEL 1 (MWP-2) BRONZE METAL PANEL PENCIL RIB PROFILE METAL WALL PANEL 1 (MWP-3) BRONZE VERTICAL FLUSH METAL PANELS STANDING SEAM METAL ROOF TO BE SELECTED BY ARCHITECT DOWNSPOUTS TO BE SELECTED BY ARCHITECT GREY. ARCHITECT TO SELECT FROM MFR RANGE OF MEDIUM-TO-MEDIUM LIGHT GREY COLOR TO BE SELECTED TO SELECT TROM MFR RANGE OF MEDIUM-TO-MEDIUM LIGHT GREY COLOR TO BE SELECTED TO SELECT TROM MFR RANGE OF MEDIUM-TO-MEDIUM LIGHT GREY COLOR TO BE SELECTED TO SELECT TROM MFR RANGE OF MEDIUM-TO-MEDIUM LIGHT GREY COLOR TO BE SELECTED TO SELECT TROM MFR RANGE OF MEDIUM-TO-MEDIUM LIGHT GREY COLOR TO BE SELECTED TO SELECT TROM MFR RANGE OF MEDIUM-TO-MEDIUM LIGHT GREY COLOR TO BE SELECTED TO SELECT TROM MFR RANGE OF MEDIUM-TO-MEDIUM LIGHT GREY COLOR TO BE SELECTED TO SELECT TROM MFR RANGE OF MEDIUM-TO-MEDIUM LIGHT GREY COLOR TO BE SELECTED TO SELECT TROM MFR RANGE OF MEDIUM-TO-MEDIUM LIGHT GREY COLOR TO BE SELECTED TO SELECT TROM MFR RANGE OF MEDIUM-TO-MEDIUM LIGHT GREY COLOR TO BE SELECTED TO SELECT TROM MFR RANGE OF MEDIUM-TO-MEDIUM LIGHT GREY COLOR TO BE SELECTED TO SELECT TROM MFR RANGE OF MEDIUM-TO-MEDIUM LIGHT GREY COLOR TO BE SELECTED TO SELECT TROM MFR RANGE OF MEDIUM-TO-MEDIUM LIGHT GREY COLOR TO BE SELECTED TO SELECT TROM MFR TRANGE OF MEDIUM-TO-MEDIUM LIGHT GREY COLOR TO BE SELECTED TO SELECT TROM MFR TRANGE OF MEDIUM-TO-MEDIUM LIGHT GREY COLOR TO BE SELECTED TO SELECT TROM MFR TRANGE OF MEDIUM-TO-MEDIUM LIGHT GREY COLOR TO BE SELECTED TO SELECT TROM MFR TRANGE OF MEDIUM-TO-MEDIUM LIGHT GREY COLOR TO SELECT TROM MFR TRANGE OF MEDIUM-TO-MEDIUM LIGHT GREY COLOR TO SELECT TROM MFR TRANGE OF MEDIUM-TO-MEDIUM LIGHT GREY COLOR TO SELECT TROM MFR TRANGE OF MEDIUM-TO-MEDIUM LIGHT GREY COLOR TO SELECT TROM MFR TRANGE OF MEDIUM LIGHT GREY COLOR	XTERIOR GUARD RAILS	TO BE SELECTED BY ARCHITECT
BRICK TO BRICK JOINTS TO BE SELECTED BY ARCHITECT TBD METAL WALL PANEL 1 (MWP-1) BRONZE METAL PANEL BOARD AND BATTEN PROFILE METAL WALL PANEL 1 (MWP-2) BRONZE METAL PANEL PENCIL RIB PROFILE METAL WALL PANEL 1 (MWP-3) BRONZE VERTICAL FLUSH METAL PANELS STANDING SEAM METAL ROOF TO BE SELECTED BY ARCHITECT DOWNSPOUTS TO BE SELECTED BY ARCHITECT PRECAST CONCRETE PC-#W GREY. ARCHITECT TO SELECT FROM MFR RANGE OF MEDIUM-TO-MEDIUM LIGHT GREY COLOR TO BE SELECTED TO SELECT FROM MFR RANGE OF MEDIUM-TO-MEDIUM LIGHT GREY COLOR TO BE SELECTED TO SELECT FROM MFR RANGE OF MEDIUM-TO-MEDIUM LIGHT GREY COLOR TO BE SELECTED TO SELECT FROM MFR RANGE OF MEDIUM-TO-MEDIUM LIGHT GREY COLOR TO BE SELECTED TO SELECT FROM MFR RANGE OF MEDIUM-TO-MEDIUM LIGHT GREY COLOR TO BE SELECTED TO SELECT FROM MFR RANGE OF MEDIUM-TO-MEDIUM LIGHT GREY COLOR TO BE SELECTED TO SELECT FROM MFR RANGE OF MEDIUM-TO-MEDIUM LIGHT GREY COLOR TO BE SELECTED TO SELECT FROM MFR RANGE OF MEDIUM-TO-MEDIUM LIGHT GREY COLOR TO BE SELECTED TO SELECT FROM MFR RANGE OF MEDIUM-TO-MEDIUM LIGHT GREY COLOR TO BE SELECTED TO SELECT FROM MFR RANGE OF MEDIUM-TO-MEDIUM LIGHT GREY COLOR TO BE SELECTED BRICK TO BRICK EXPANSION JOINTS, ETC. TO BE SELECTED BY ARCHITECT TBD METAL WALL PANEL 1 (MWP-1) BRONZE METAL PANEL BOARD AND BATTEN PROFILE METAL WALL PANEL 1 (MWP-2) BRONZE METAL PANEL PENCIL RIB PROFILE METAL WALL PANEL 1 (MWP-3) BRONZE VERTICAL FLUSH METAL PANELS STANDING SEAM METAL ROOF TO BE SELECTED BY ARCHITECT DOWNSPOUTS TO BE SELECTED BY ARCHITECT GREY. ARCHITECT TO SELECT FROM MFR RANGE OF MEDIUM-TO-MEDIUM LIGHT GREY COLOR TO BE SELECTED TO SELECT FROM MFR RANGE OF MEDIUM-TO-MEDIUM LIGHT GREY COLOR TO BE SELECTED TO SELECT FROM MFR RANGE OF MEDIUM-TO-MEDIUM LIGHT GREY COLOR TO BE SELECTED TO SELECT FROM MFR RANGE OF MEDIUM-TO-MEDIUM LIGHT GREY COLOR TO BE SELECTED TO SELECT FROM MFR RANGE OF MEDIUM-TO-MEDIUM LIGHT GREY COLOR TO BE SELECTED TO SELECT FROM MFR RANGE OF MEDIUM-TO-MEDIUM LIGHT GREY COLOR TO BE SELECTED TO SELECT FROM MFR RANGE OF MEDIUM-TO-MEDIUM LIGHT GREY COLOR TO BE SELECTED TO SELECT FROM MFR RANGE OF MEDIUM-TO-MEDIUM LIGHT GREY COLOR TO BE SELECTED TO SELECT FROM MFR RANGE OF MEDIUM-TO-MEDIUM LIGHT GREY COLOR TO BE SELECTED TO SELECT FROM MFR RANGE OF MEDIUM-TO-MEDIUM LIGHT GREY COLOR TO BE SELECTED TO SELECT FROM MFR RANGE OF MEDIUM-TO-MEDIUM LIGHT GREY COLOR TO BE SELECTED TO SELECT FROM MFR RANGE OF MEDIUM-TO-MEDIUM LIGHT GREY COLOR TO BE SELECTED TO SELECT FROM MFR RANGE OF MEDIUM-TO-MEDIUM LIGHT GREY COLOR TO BE SELECTED TO SELECT FROM MFR RANGE OF MEDIUM-TO-MEDIUM LIGHT GREY COLOR TO BE SELECTED TO SELECT FROM MFR RANGE OF MEDIUM-TO-MEDIUM LIGHT GREY COLOR TO BE SELECTED TO SELECT FROM MFR RANGE OF MEDIUM-TO-MEDIUM LIGHT GREY COLOR TO BE SELECTED TO SELECT FROM MFR RANGE OF MEDIUM-TO-MEDIUM LIGHT GREY COLOR TO BE SELECTED TO SELECT FROM MFR RANGE OF MEDIUM-TO-MEDIUM LIGHT GREY COLOR TO BE SELECTED TO SELECT FROM MFR RANGE OF MEDIUM-TO-MEDIUM LIGHT GREY COLOR TO BE SELECTED TO SELECT FROM MFR RANGE OF MEDIUM-TO-MEDIUM LIGHT GREY COLOR TO BE SELECTED TO SELECT FROM MFR RANGE OF MEDIUM LIGHT GREY COLOR TO BE SELECTED TO SELECT FROM MFR RANGE OF M	ORTAR	TO BE SELECTED BY ARCHITECT
ROLL UP DOORS TBD METAL WALL PANEL 1 (MWP-1) METAL WALL PANEL 1 (MWP-2) METAL WALL PANEL 1 (MWP-2) METAL WALL PANEL 1 (MWP-3) BRONZE METAL PANEL PENCIL RIB PROFILE METAL WALL PANEL 1 (MWP-3) BRONZE VERTICAL FLUSH METAL PANELS STANDING SEAM METAL ROOF TO BE SELECTED BY ARCHITECT DOWNSPOUTS TO BE SELECTED BY ARCHITECT PRECAST CONCRETE PC-#W GREY. ARCHITECT TO SELECT FROM MFR RANGE OF MEDIUM-TO-MEDIUM LIGHT GREY COLOR	RICK TO BRICK JOINTS	TO BE SELECTED BY ARCHITECT
METAL WALL PANEL 1 (MWP-1) BRONZE METAL PANEL BOARD AND BATTEN PROFILE BRONZE METAL PANEL PENCIL RIB PROFILE BRONZE WETAL PANEL PENCIL RIB PROFILE BRONZE VERTICAL FLUSH METAL PANELS TO BE SELECTED BY ARCHITECT DOWNSPOUTS TO BE SELECTED BY ARCHITECT PRECAST CONCRETE PC-#W BRONZE METAL PANEL BOARD AND BATTEN PROFILE TO BE SELECTED BY ARCHITECT GREY. ARCHITECT TO SELECT FROM MFR RANGE OF MEDIUM-TO-MEDIUM LIGHT GREY COLOR	RICK TO BRICK EXPANSION JOINTS, ETC.	TO BE SELECTED BY ARCHITECT
BRONZE METAL PANEL PENCIL RIB PROFILE METAL WALL PANEL 1 (MWP-3) BRONZE VERTICAL FLUSH METAL PANELS STANDING SEAM METAL ROOF TO BE SELECTED BY ARCHITECT DOWNSPOUTS TO BE SELECTED BY ARCHITECT PRECAST CONCRETE PC-#W GREY. ARCHITECT TO SELECT FROM MFR RANGE OF MEDIUM-TO-MEDIUM LIGHT GREY COLOR	OLL UP DOORS	TBD
BRONZE VERTICAL FLUSH METAL PANELS STANDING SEAM METAL ROOF TO BE SELECTED BY ARCHITECT TO BE SELECTED BY ARCHITECT PRECAST CONCRETE PC- #W BRONZE VERTICAL FLUSH METAL PANELS TO BE SELECTED BY ARCHITECT GREY. ARCHITECT TO SELECT FROM MFR RANGE OF MEDIUM-TO-MEDIUM LIGHT GREY COLOR	ETAL WALL PANEL 1 (MWP-1)	BRONZE METAL PANEL BOARD AND BATTEN PROFILE
TO BE SELECTED BY ARCHITECT DOWNSPOUTS TO BE SELECTED BY ARCHITECT TO BE SELECTED BY ARCHITECT GREY. ARCHITECT TO SELECT FROM MFR RANGE OF MEDIUM-TO-MEDIUM LIGHT GREY COLO	ETAL WALL PANEL 1 (MWP-2)	BRONZE METAL PANEL PENCIL RIB PROFILE
DOWNSPOUTS TO BE SELECTED BY ARCHITECT PRECAST CONCRETE PC- #W GREY. ARCHITECT TO SELECT FROM MFR RANGE OF MEDIUM-TO-MEDIUM LIGHT GREY COLO	ETAL WALL PANEL 1 (MWP-3)	BRONZE VERTICAL FLUSH METAL PANELS
PRECAST CONCRETE PC- #W GREY. ARCHITECT TO SELECT FROM MFR RANGE OF MEDIUM-TO-MEDIUM LIGHT GREY COLO	TANDING SEAM METAL ROOF	TO BE SELECTED BY ARCHITECT
	OWNSPOUTS	TO BE SELECTED BY ARCHITECT
DDFGAGT CONCRETE DO UID	RECAST CONCRETE PC- #W	GREY. ARCHITECT TO SELECT FROM MFR RANGE OF MEDIUM-TO-MEDIUM LIGHT GREY COLORS
PRECAST CONCRETE PC- #R MATCH COLOR OF BRICK	RECAST CONCRETE PC- #R	MATCH COLOR OF BRICK

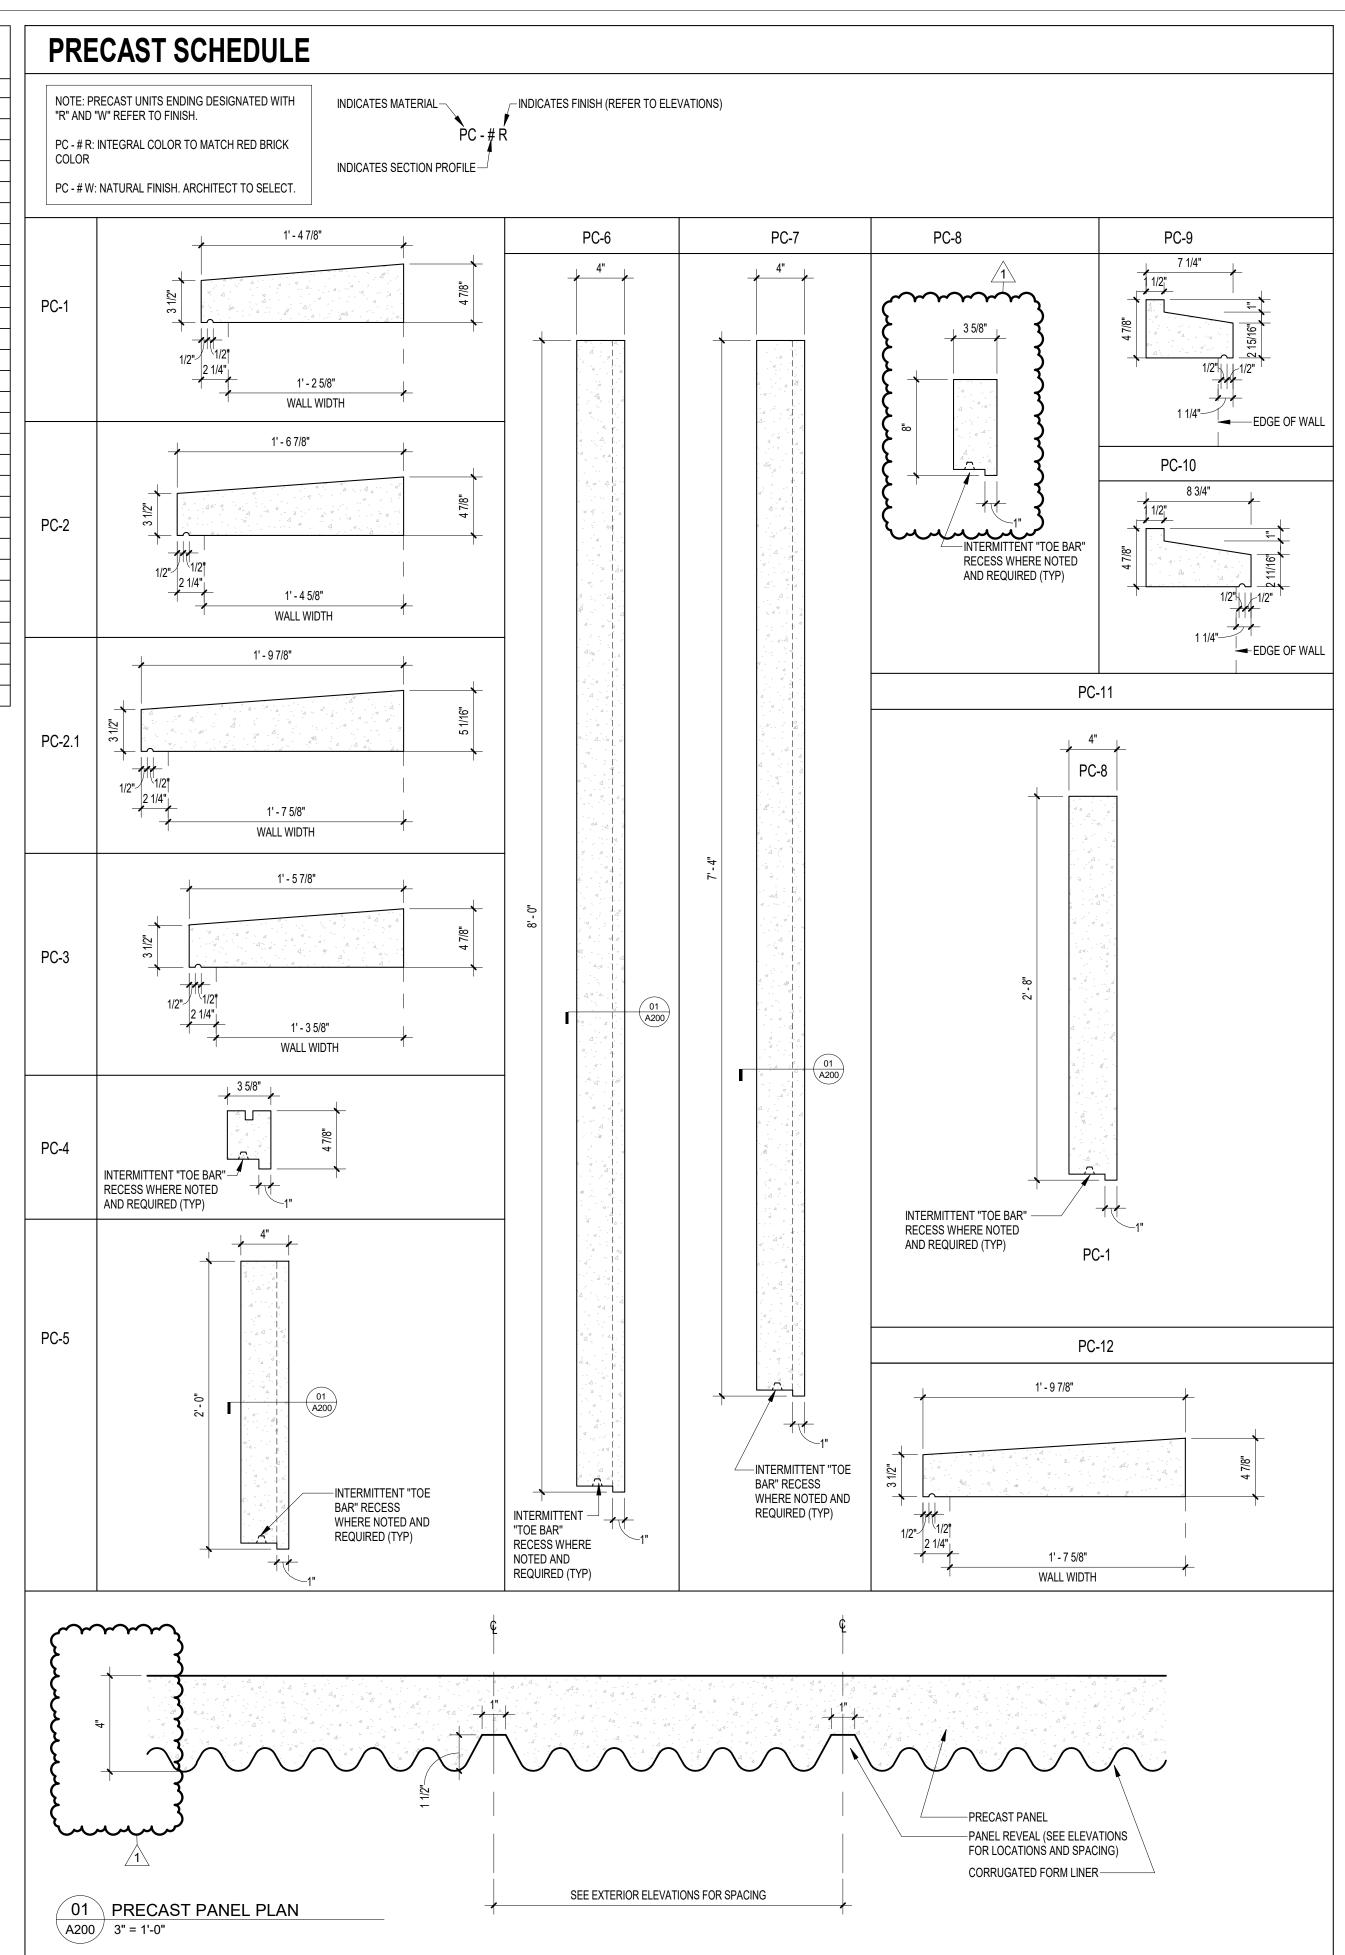



ELLIOTT MARSHALL INNES P.A. (EMI architects)
251 E. 7TH AVENUE TALLAHASSEE FL 32303
(850) 222 - 7442
www.emiarch.com
LICENSE #s AA C000409 IB C000153

NOTE: 11" x 17" SHEETS ARE PLOTTED AT 1/2 THE SCALE NOTED ON THESE DRAWINGS


WCSD EDUCATIONAL ANCILLARY FACILITIES -DISTRICT OFFICE


RECEIVED
ALLSTATE CONSTRUCTION
02-13-2025


1	2/11/2025	ADDENDUM #	‡ 1
PROJECT	PHASE		
CONST	RUCTION DO	CUMENTS	
DATE			DRAWN BY
15 JANI	JARY 2025		RMP
PROJECT	NO		CHECKED BY
68100			
SHEET TIT	ΠF		


BUILDING ELEVATIONS-EXTERIOR FINISHES

SHEET NO REV NO 1

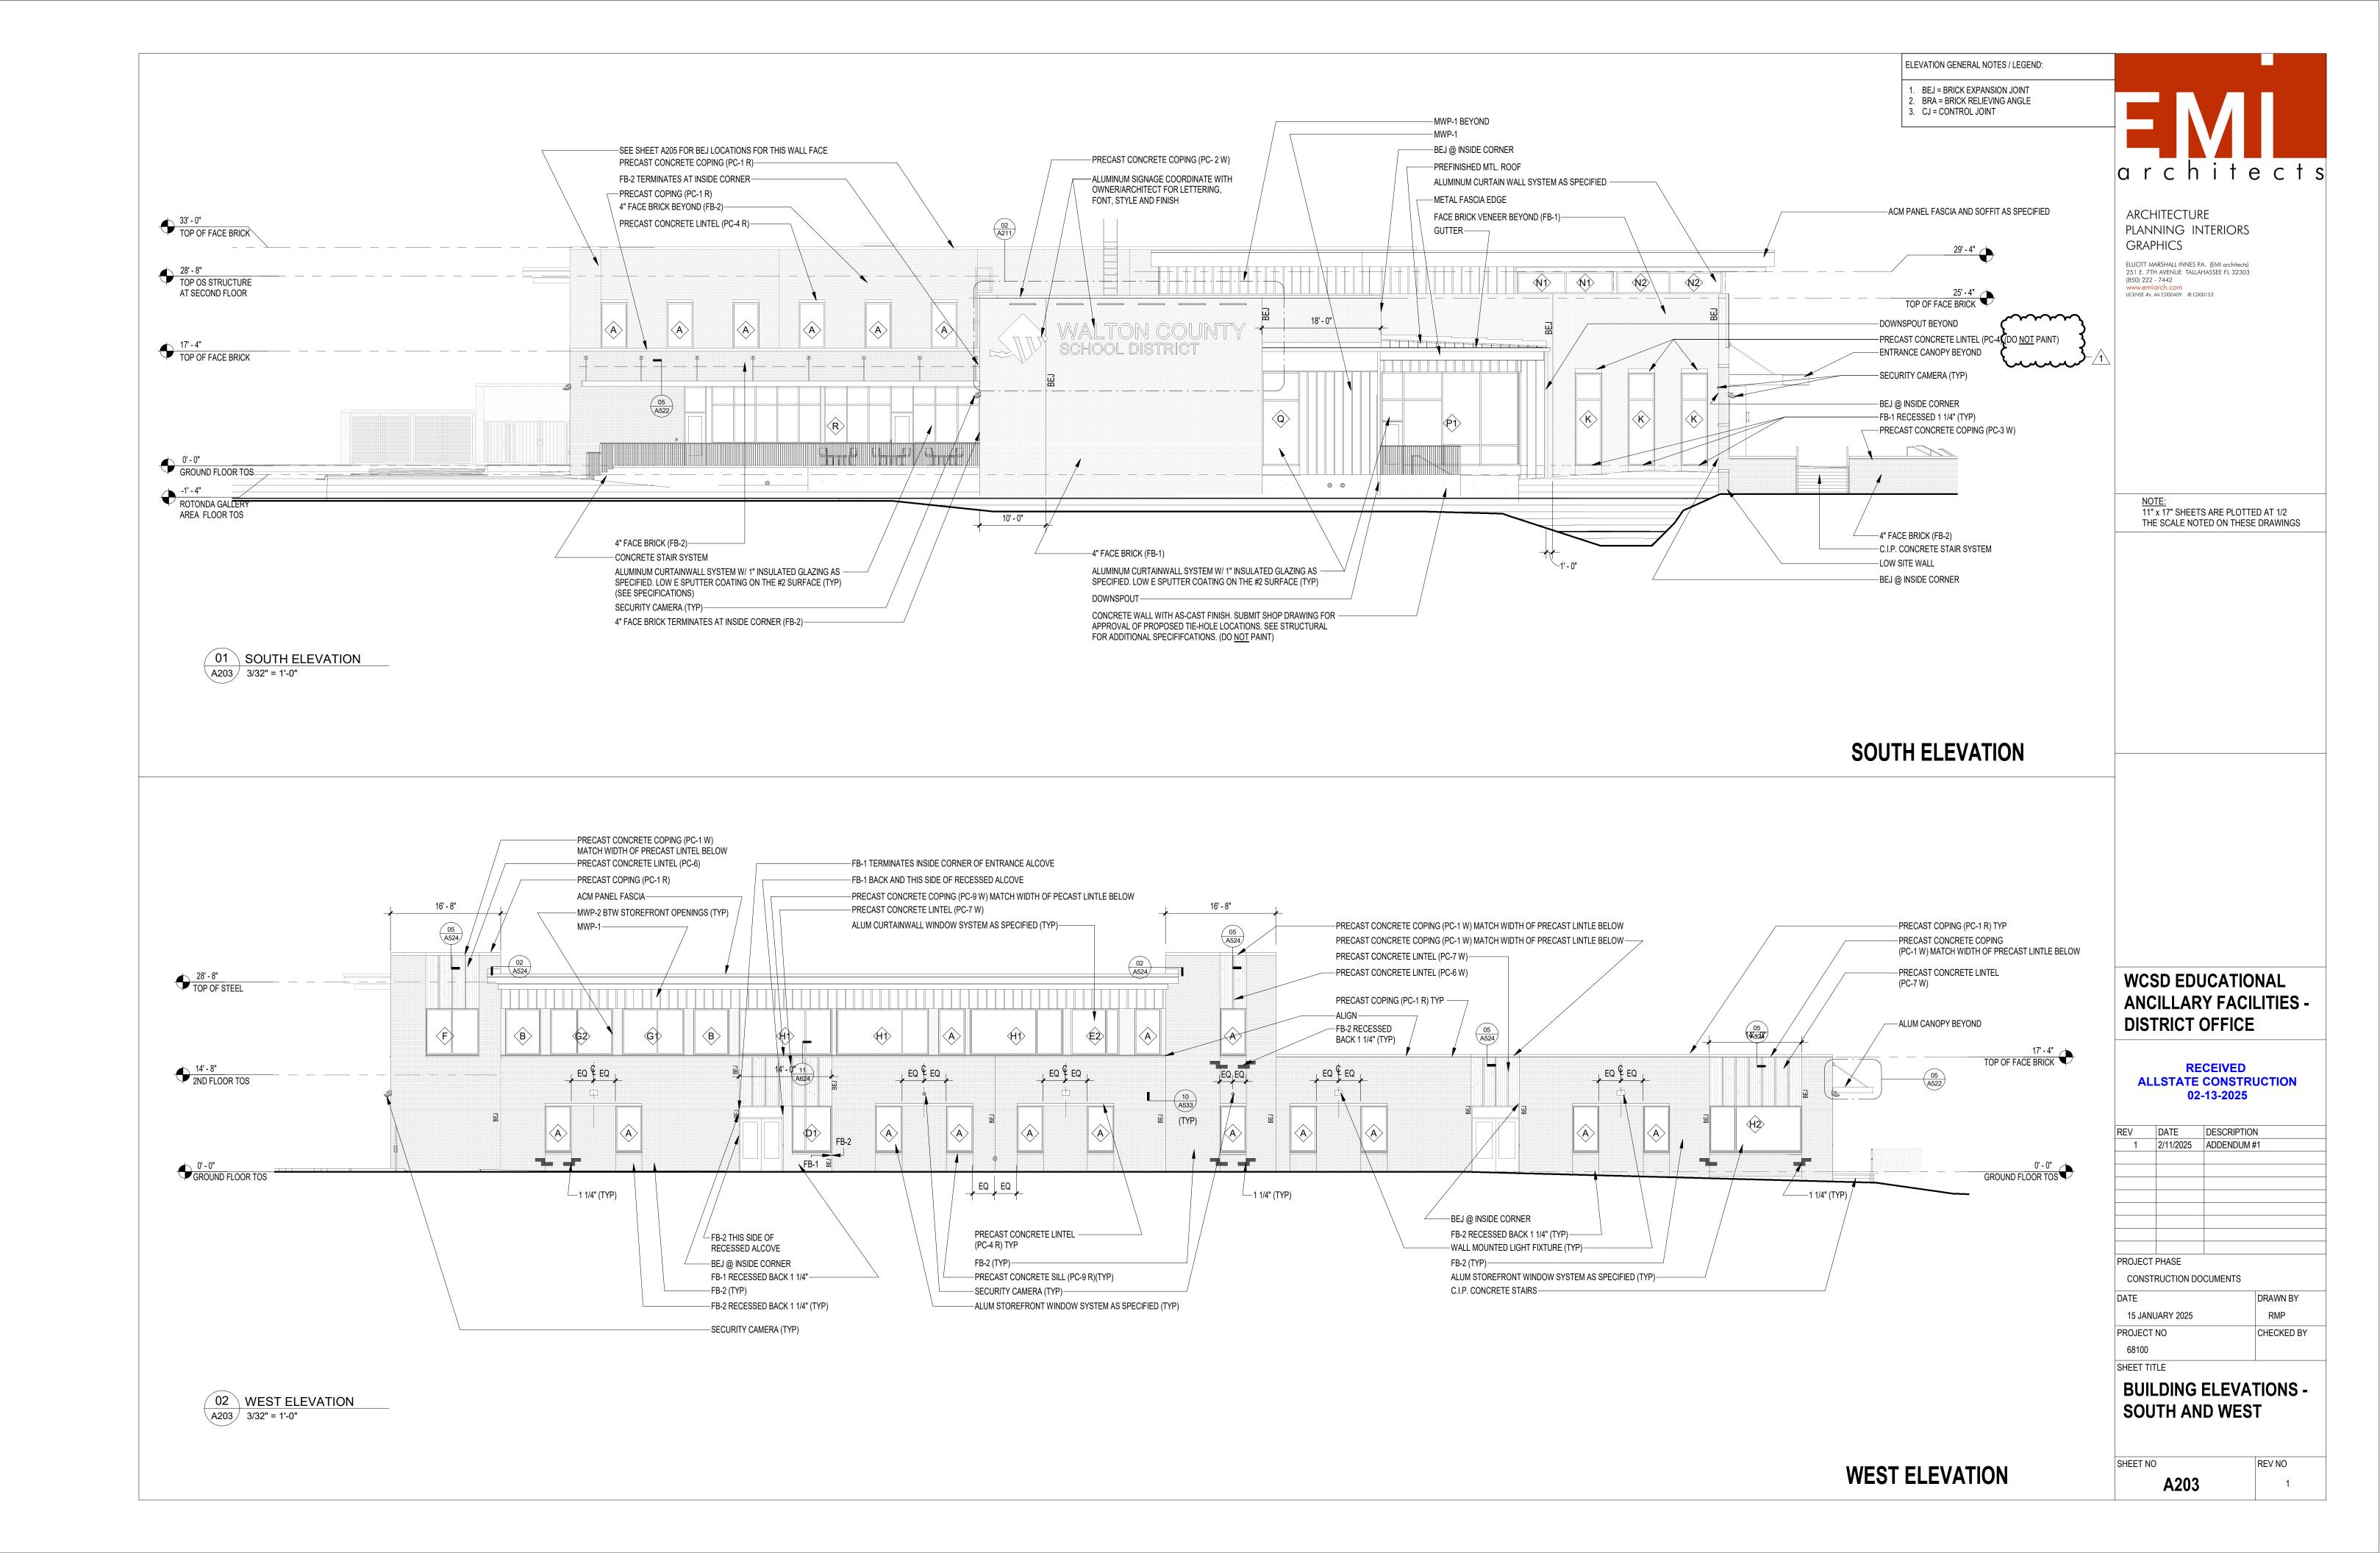

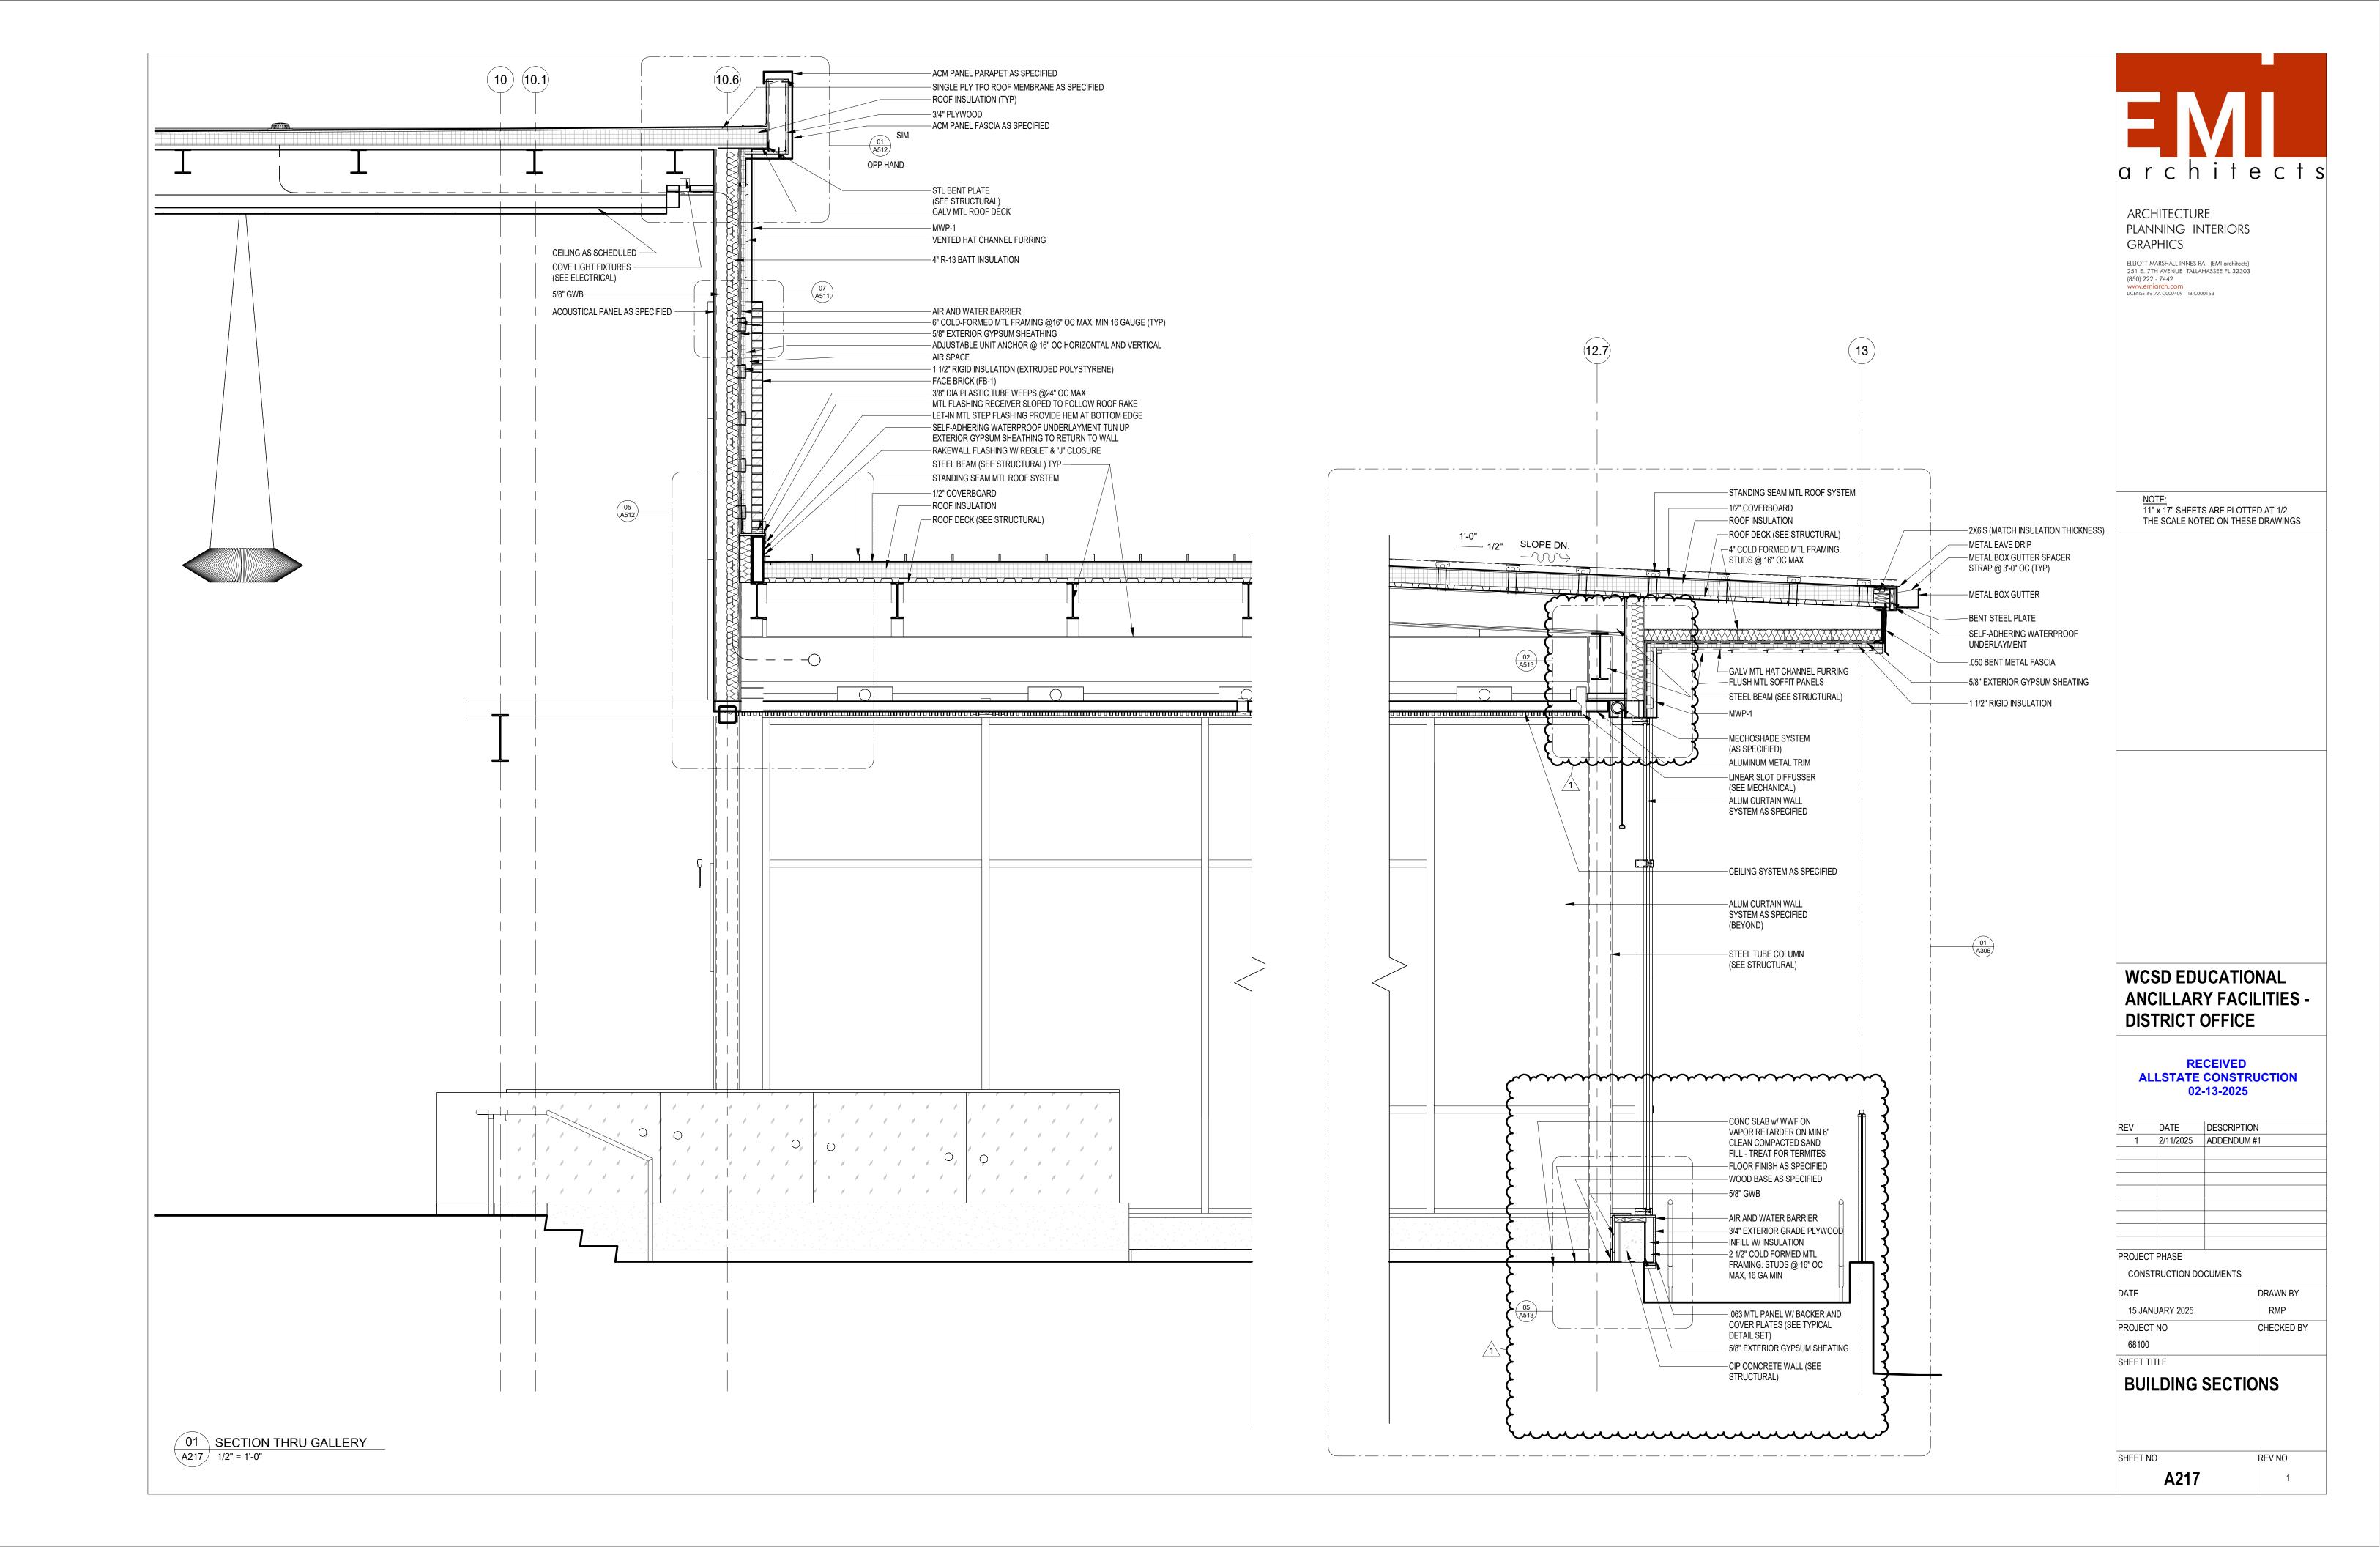

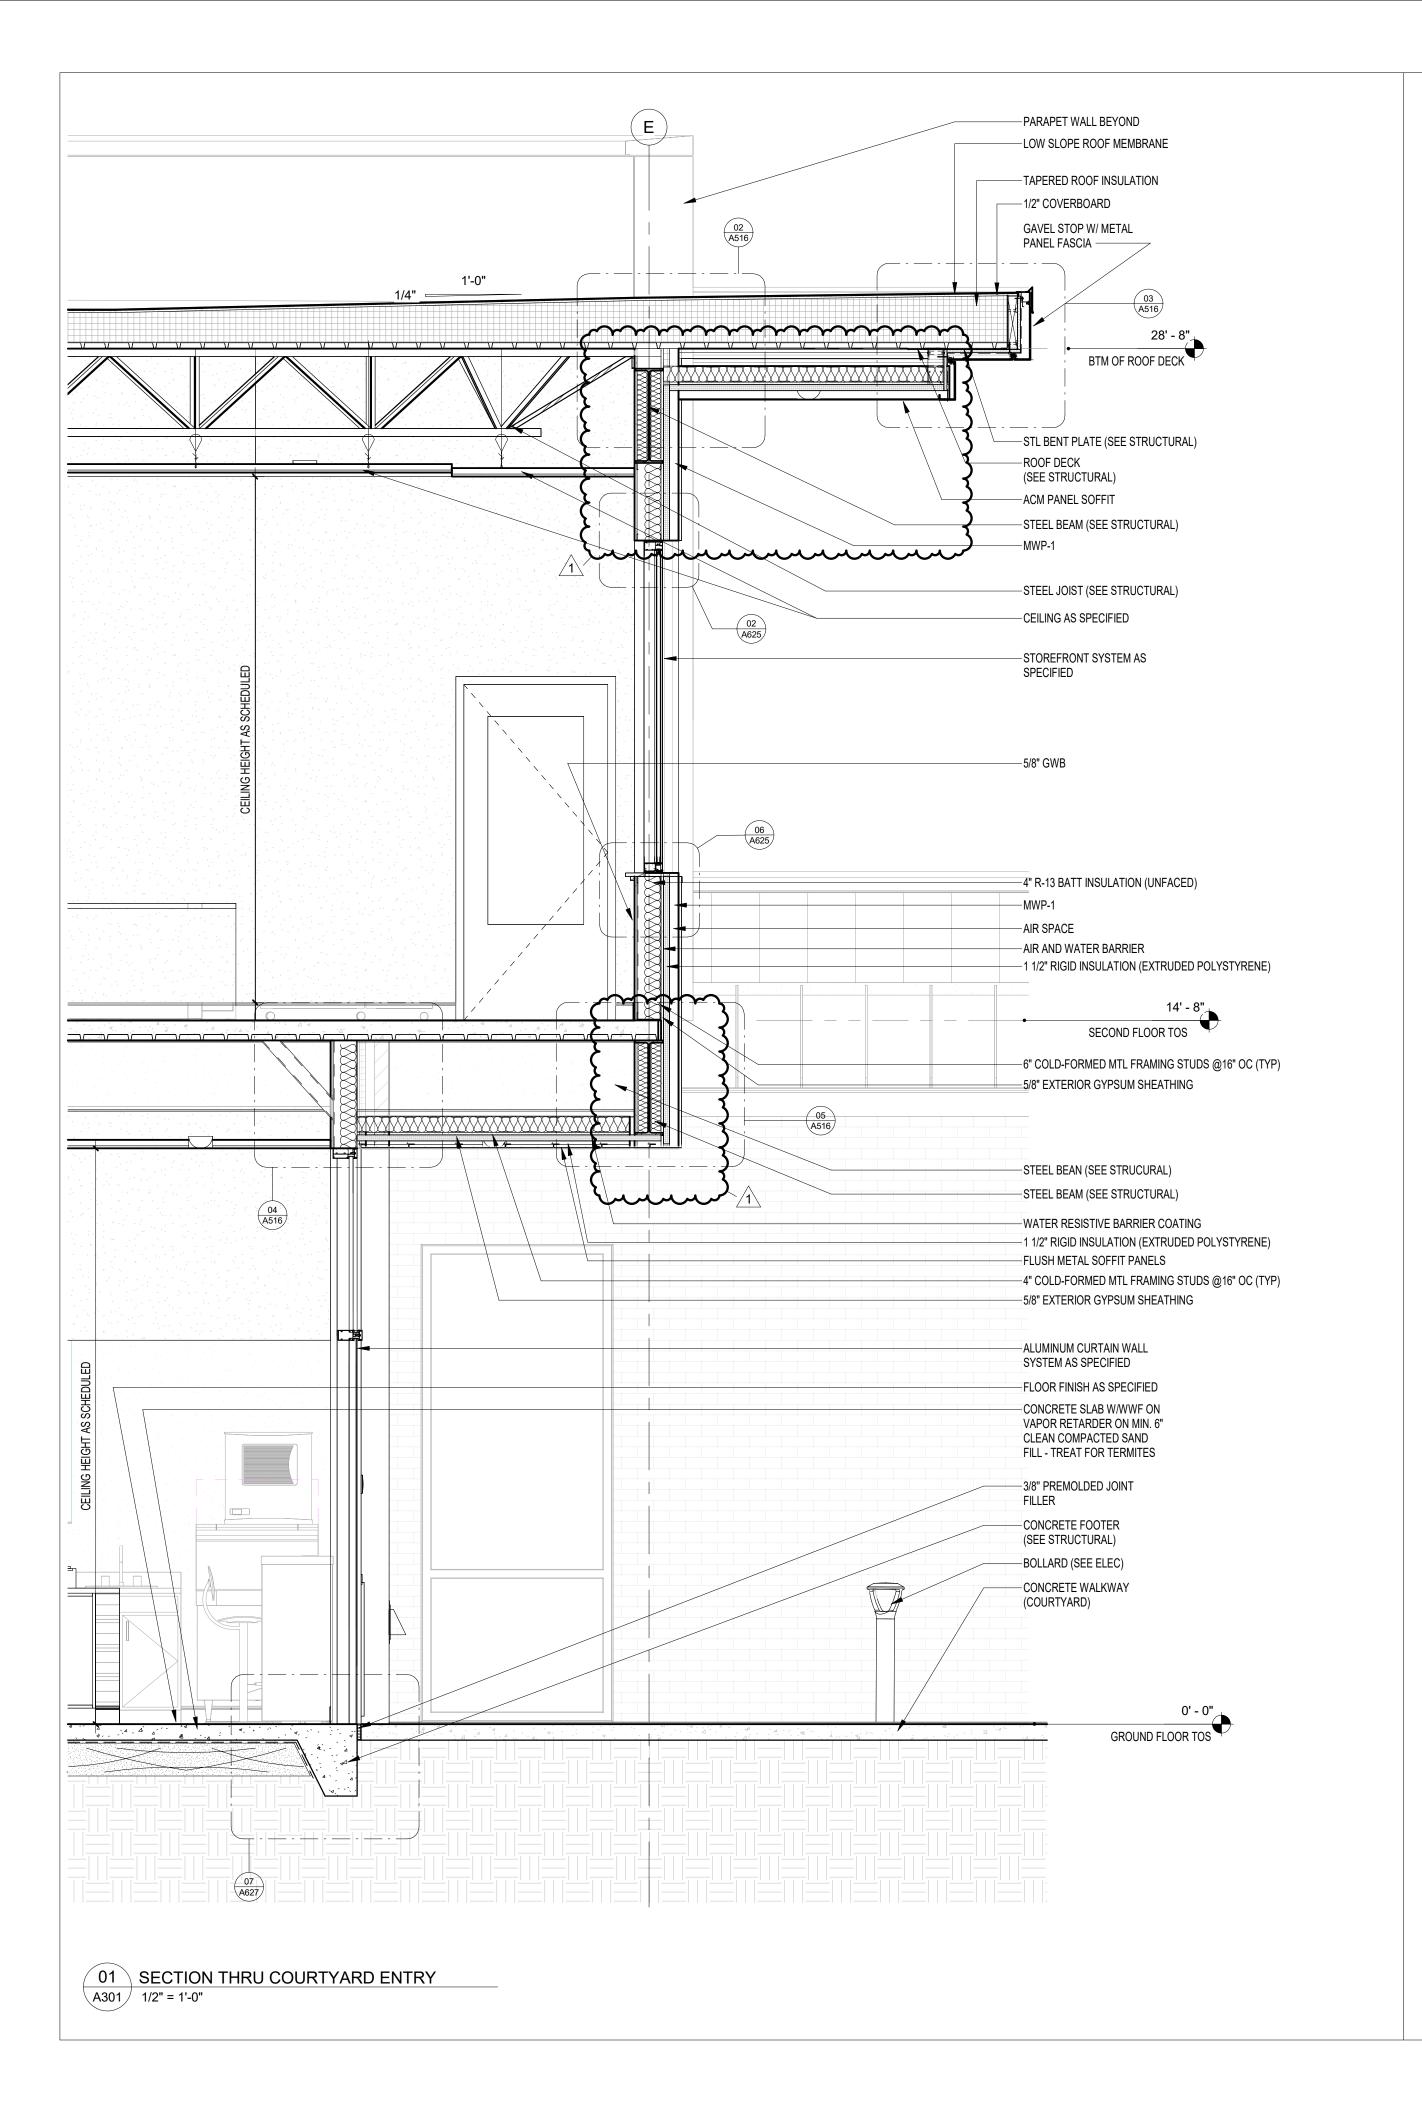

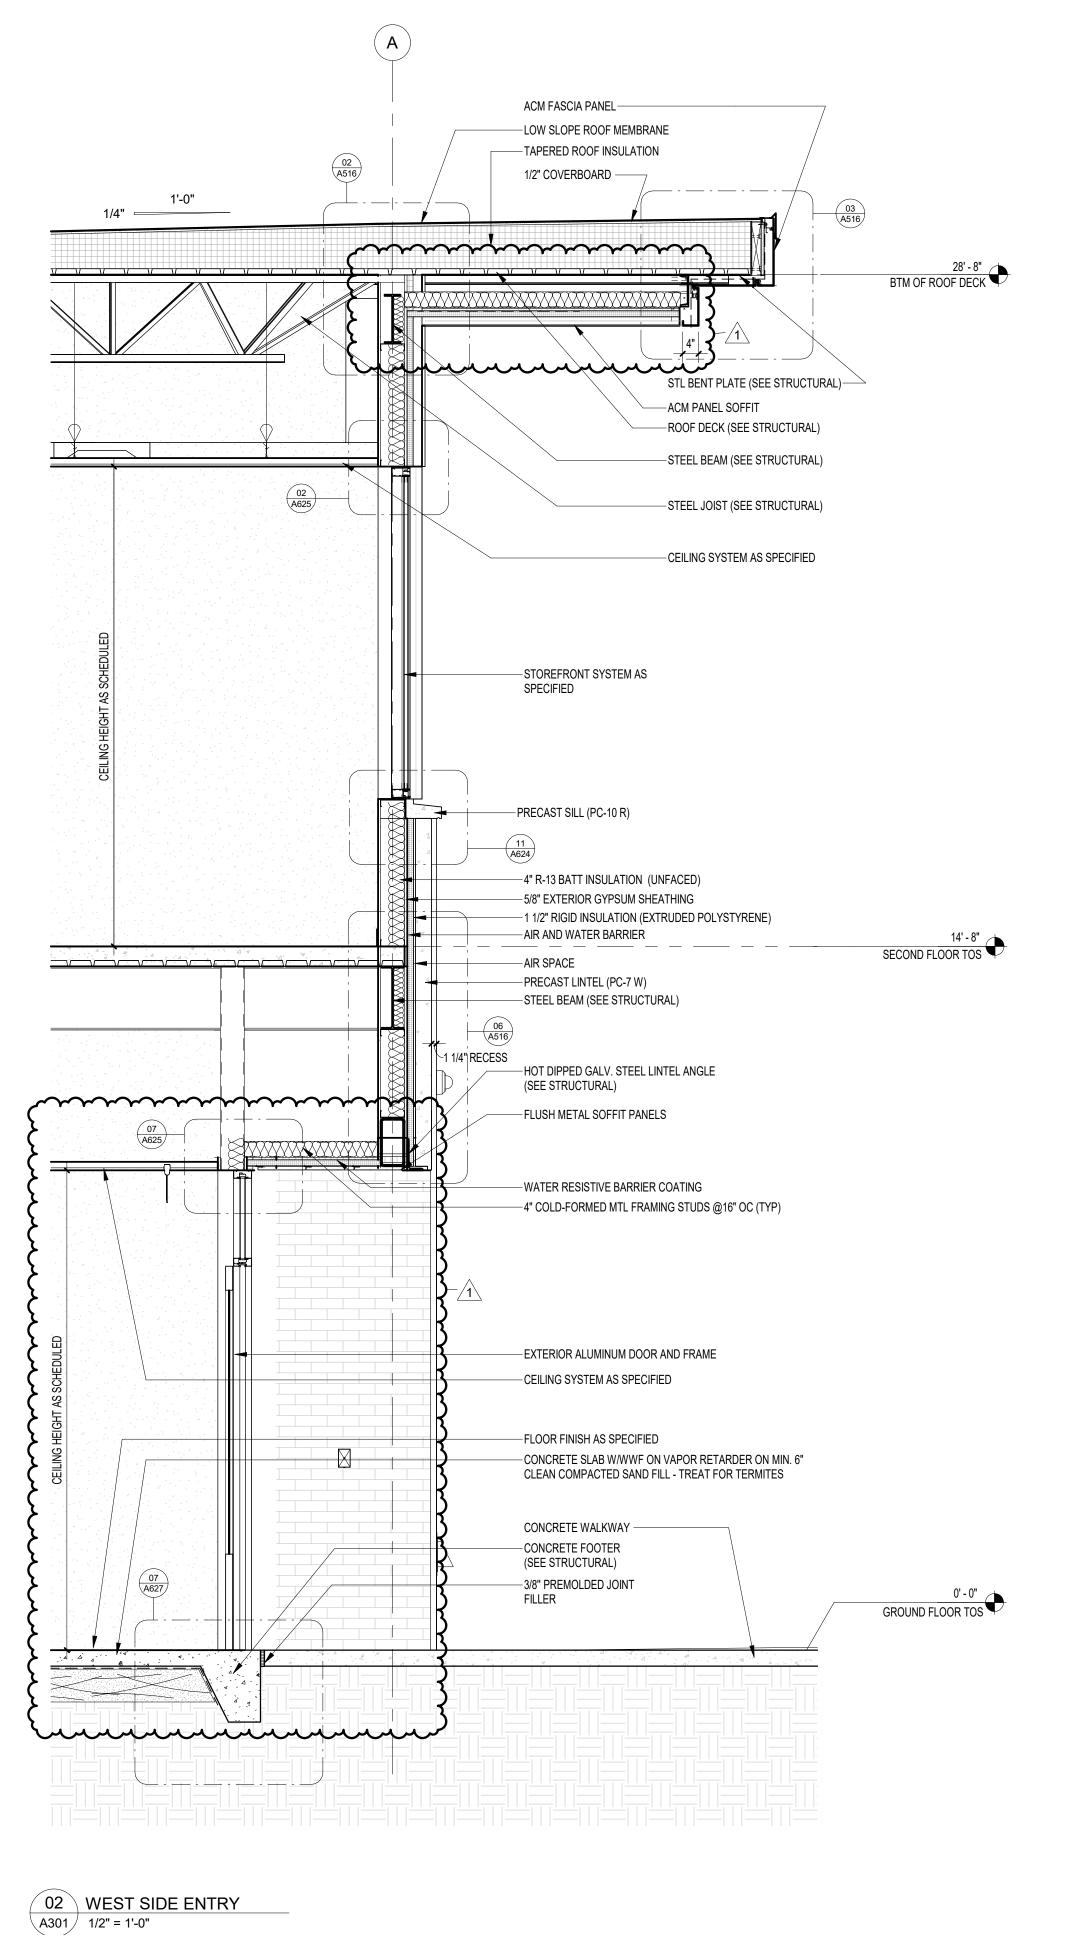



ELLIOTT MARSHALL INNES P.A. (EMI architects)
251 E. 7TH AVENUE TALLAHASSEE FL 32303
(850) 222 - 7442
www.emiarch.com
LICENSE #s AA C000409 IB C000153

NOTE: 11" x 17" SHEETS ARE PLOTTED AT 1/2 THE SCALE NOTED ON THESE DRAWINGS

WCSD EDUCATIONAL ANCILLARY FACILITIES -DISTRICT OFFICE


RECEIVED
ALLSTATE CONSTRUCTION
02-13-2025


REV DATE DESCRIPTION


A301


			-
1	2/11/2025	ADDENDUM #	‡ 1
PROJECT	PHASE		
CONST	RUCTION DO	CUMENTS	
DATE			DRAWN BY
15 JANU	JARY 2025		RMP
PROJECT	NO		CHECKED BY
68100			ВІ
SHEET TIT	LE		
WΔI	L SEC	TIONS	
	L OLO	110110	

REV NO

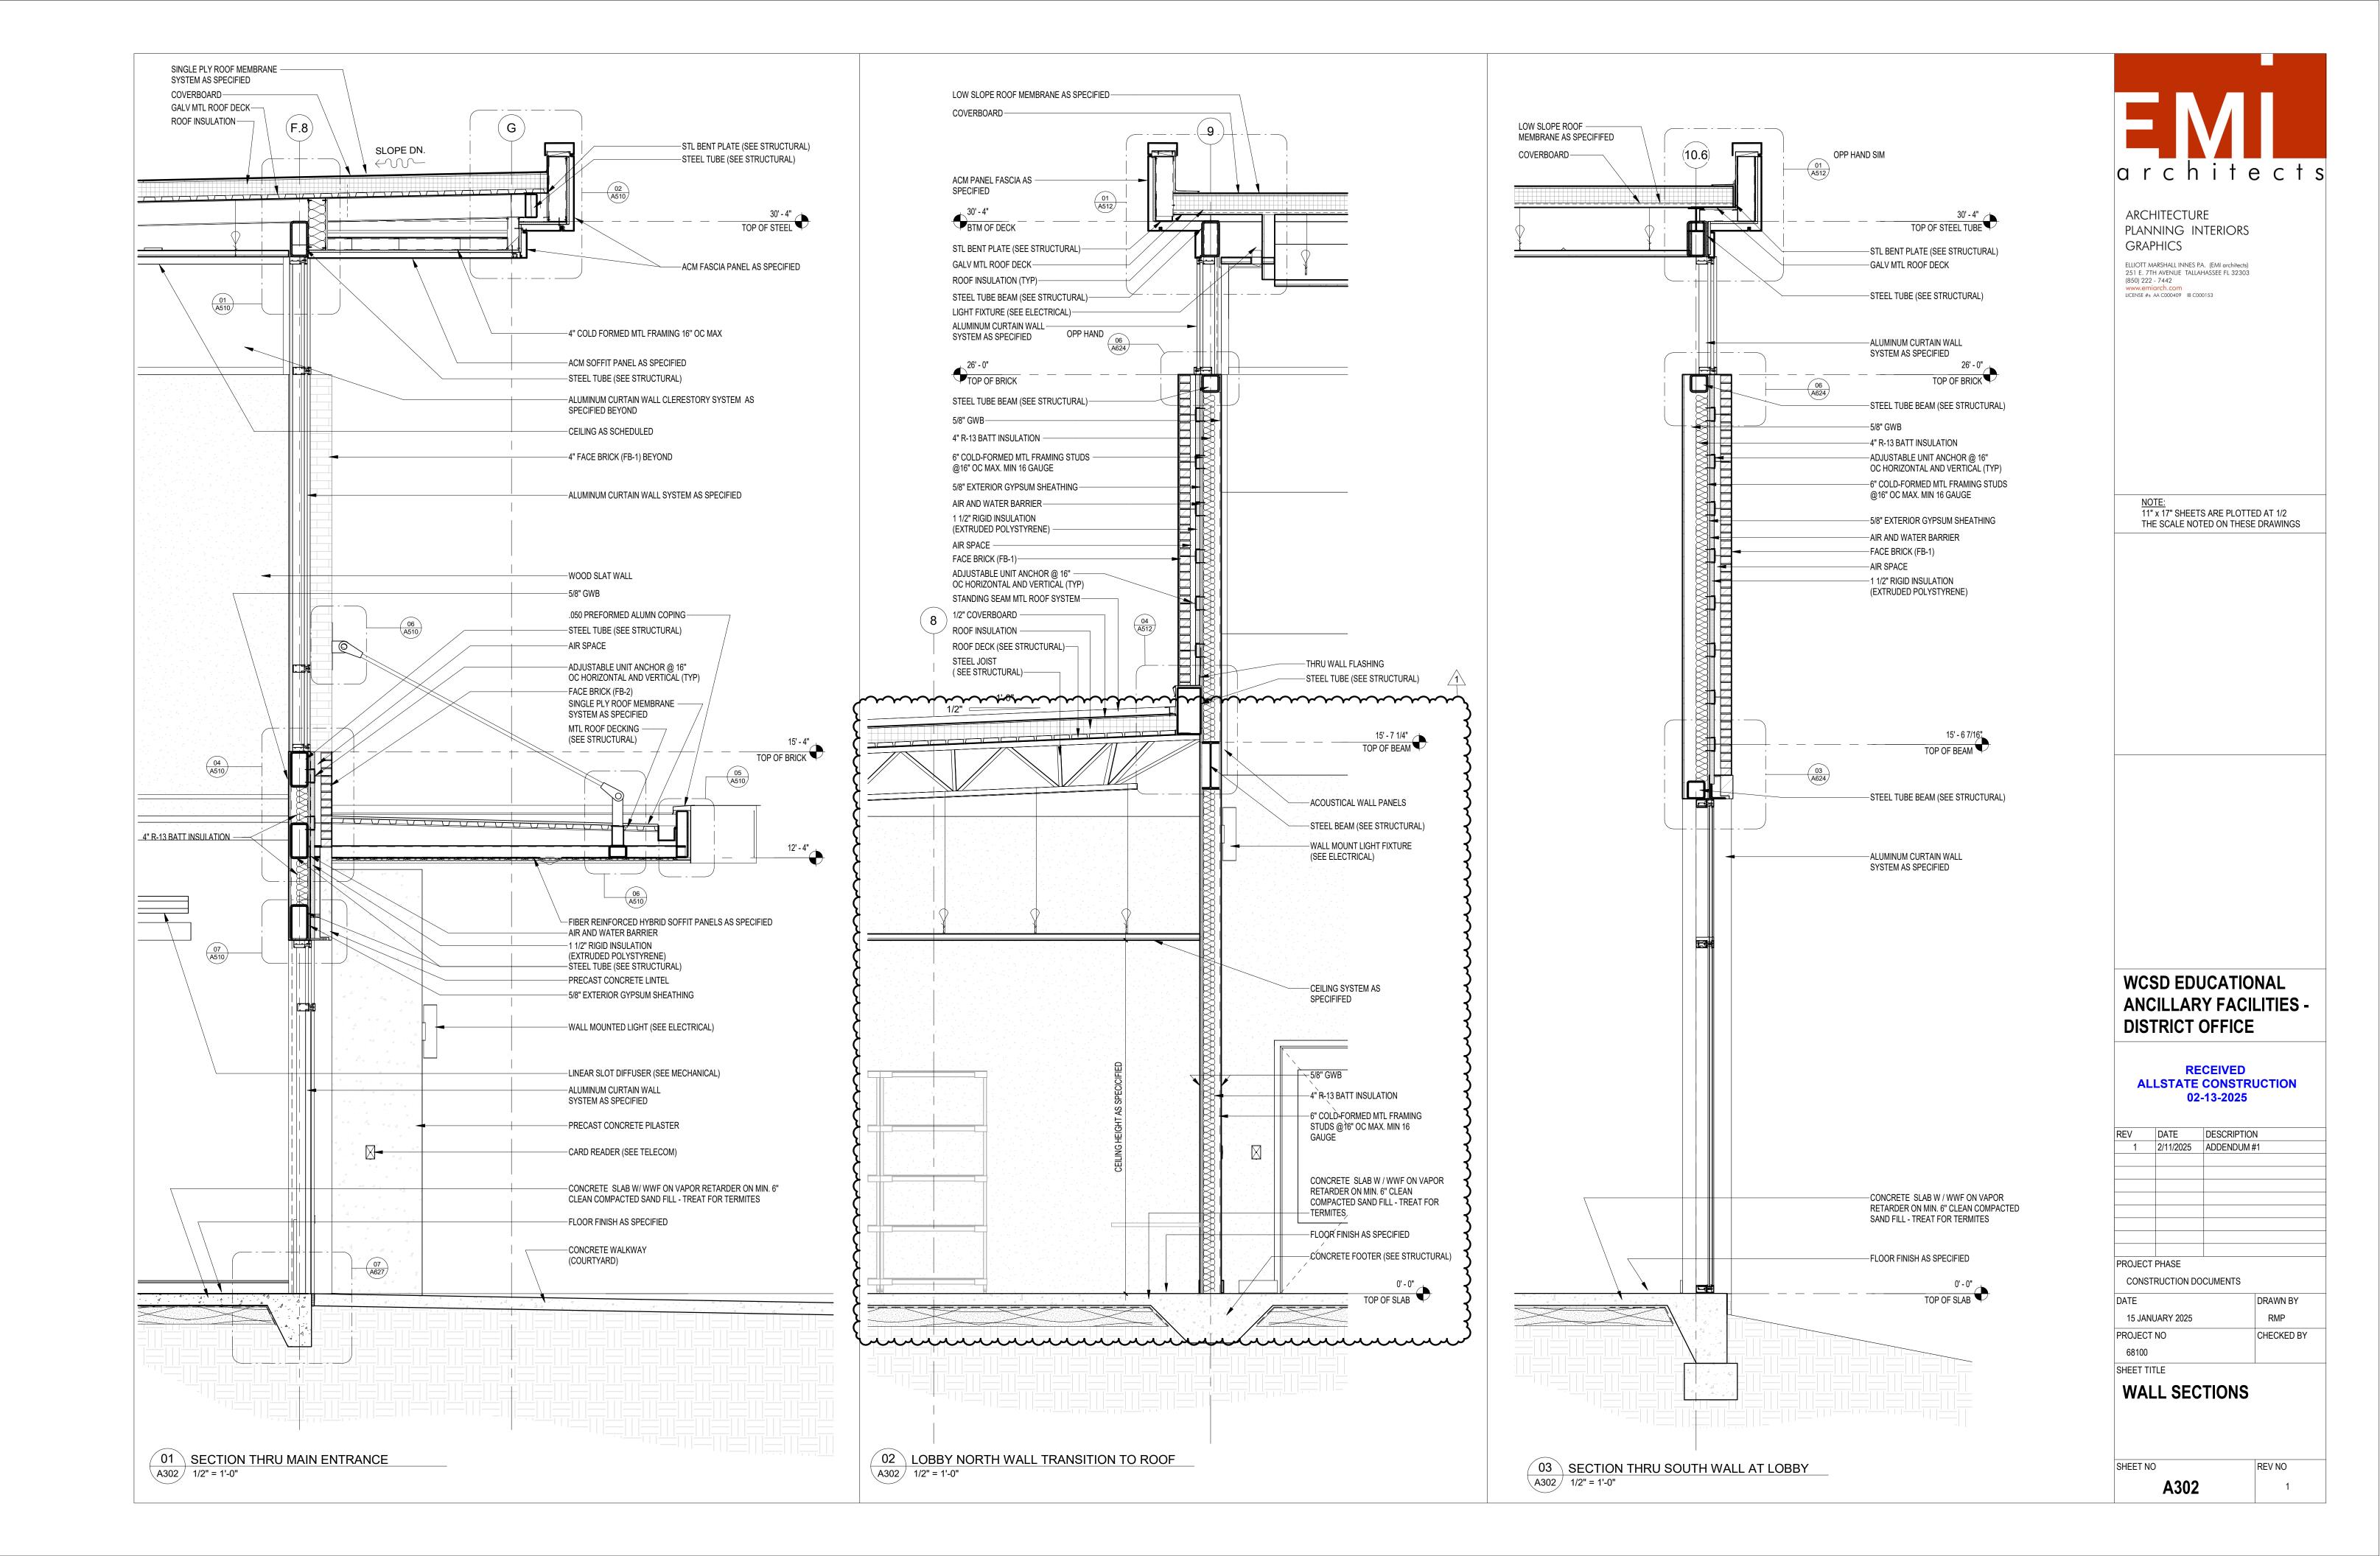

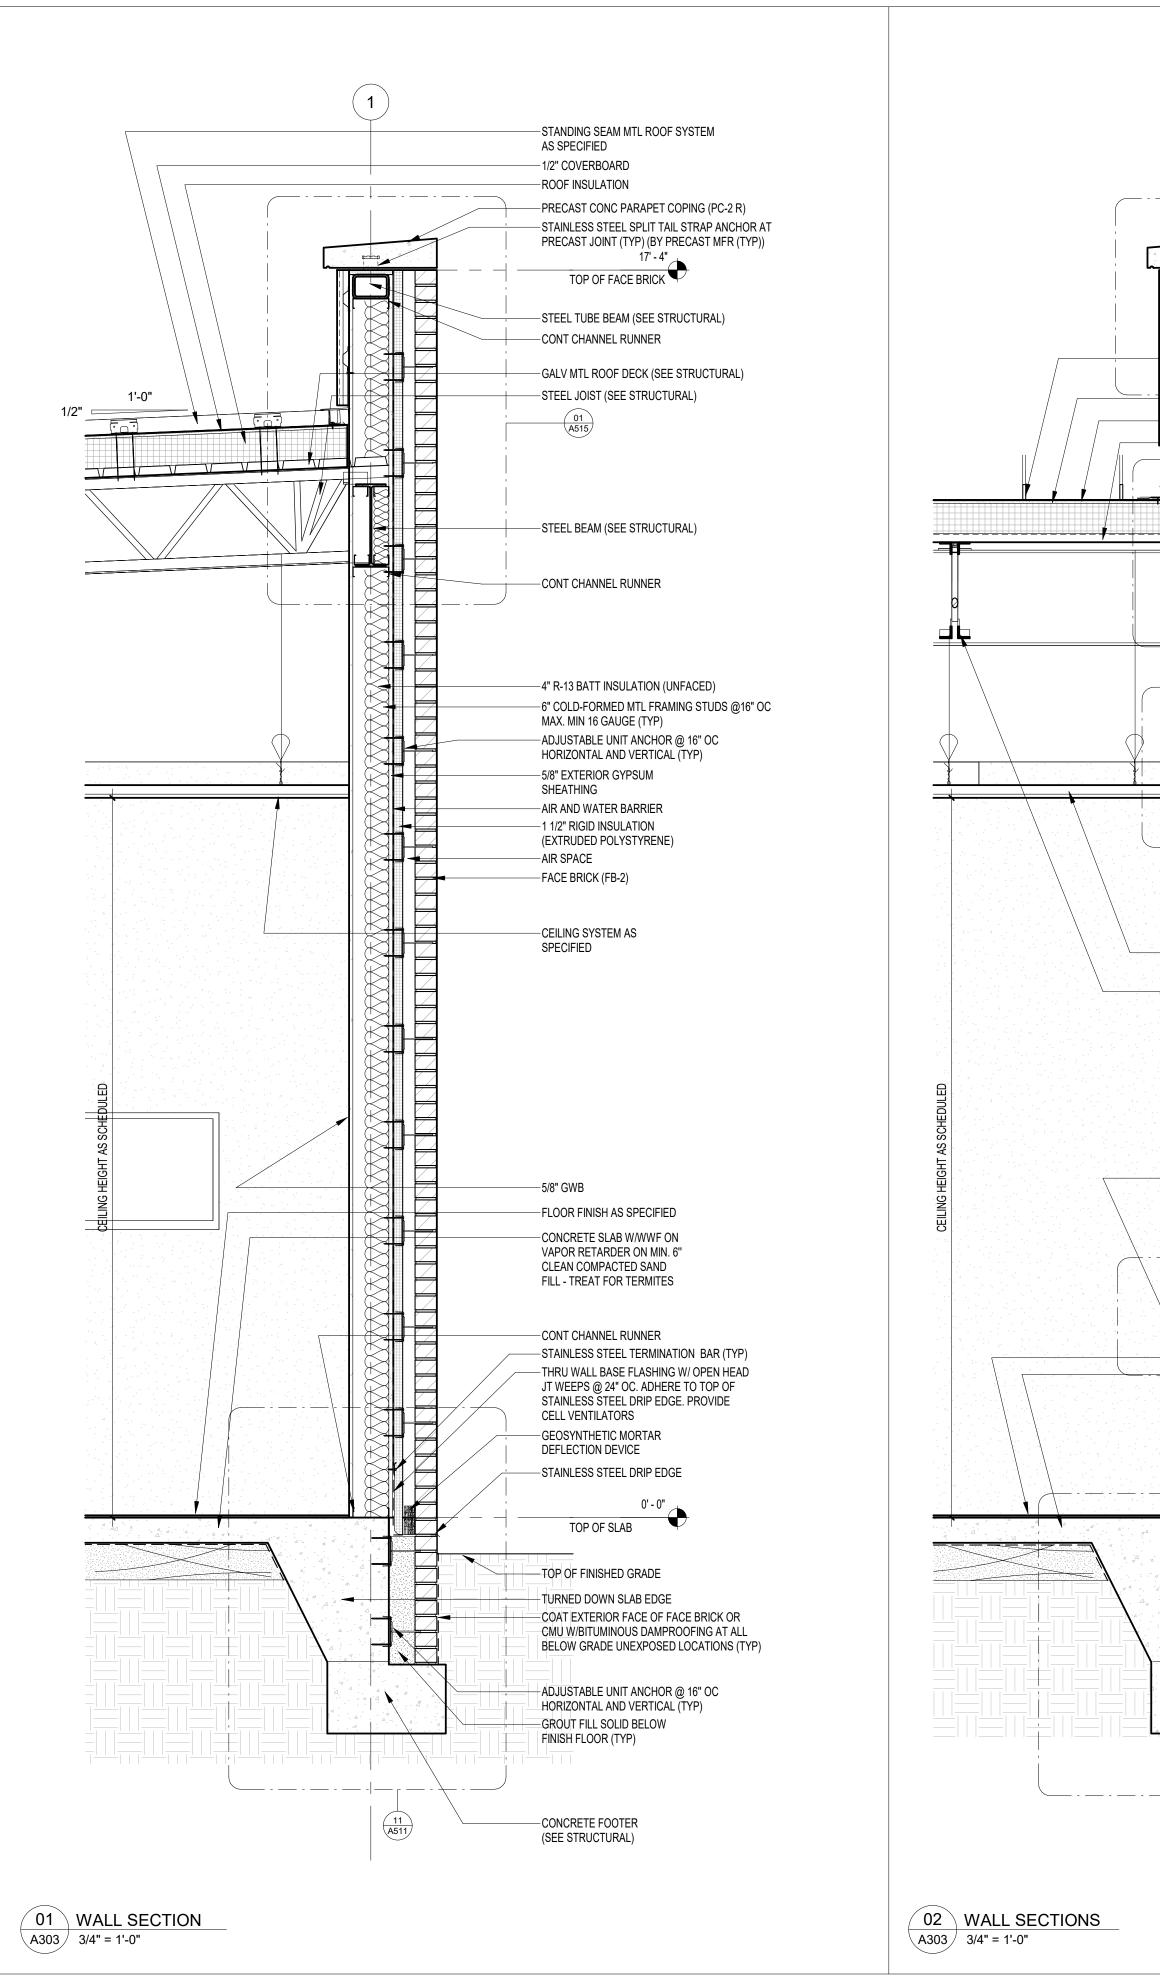

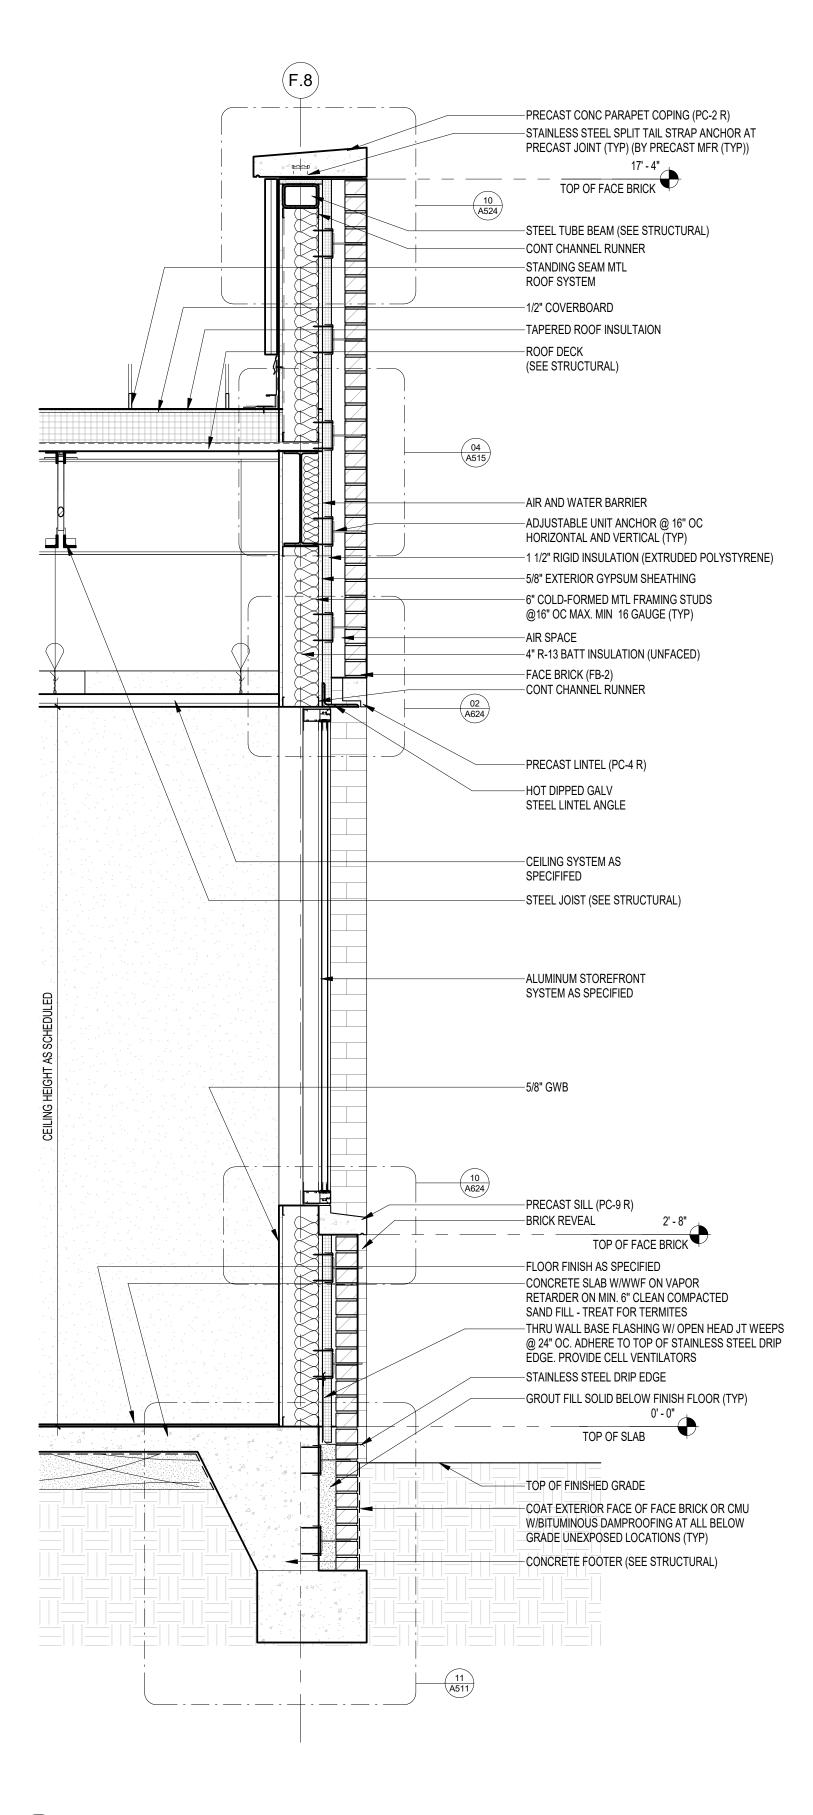

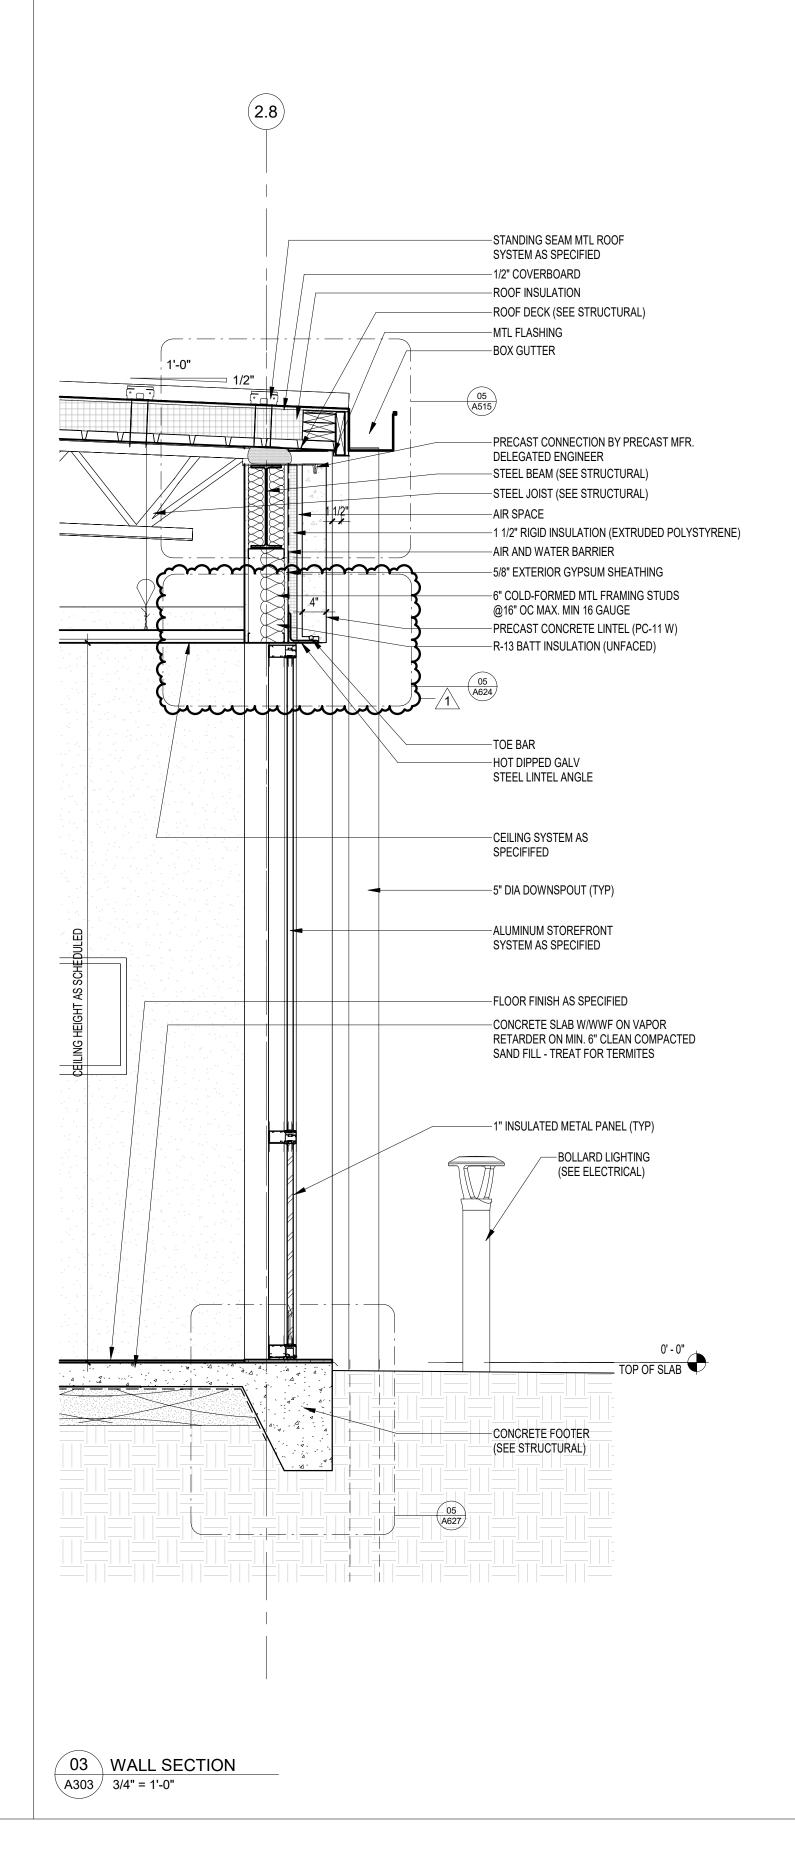



ELLIOTT MARSHALL INNES P.A. (EMI architects)
251 E. 7TH AVENUE TALLAHASSEE FL 32303
(850) 222 - 7442
www.emiarch.com
LICENSE #s AA C000409 IB C000153

11" x 17" SHEETS ARE PLOTTED AT 1/2 THE SCALE NOTED ON THESE DRAWINGS

WCSD EDUCATIONAL ANCILLARY FACILITIES -DISTRICT OFFICE


RECEIVED
ALLSTATE CONSTRUCTION
02-13-2025


REV DATE DESCRIPTION


A303

1	2/11/2025	ADDENDUM#	1
PROJEC1	PHASE		
	TRUCTION DO	OCUMENTS	
DATE			DRAWN BY
15 JAN	IUARY 2025		RMP
PROJEC1	NO		CHECKED BY
68100			ВІ
SHEET TI	TLE		
W/AI	I SEC	TIONS	

REV NO

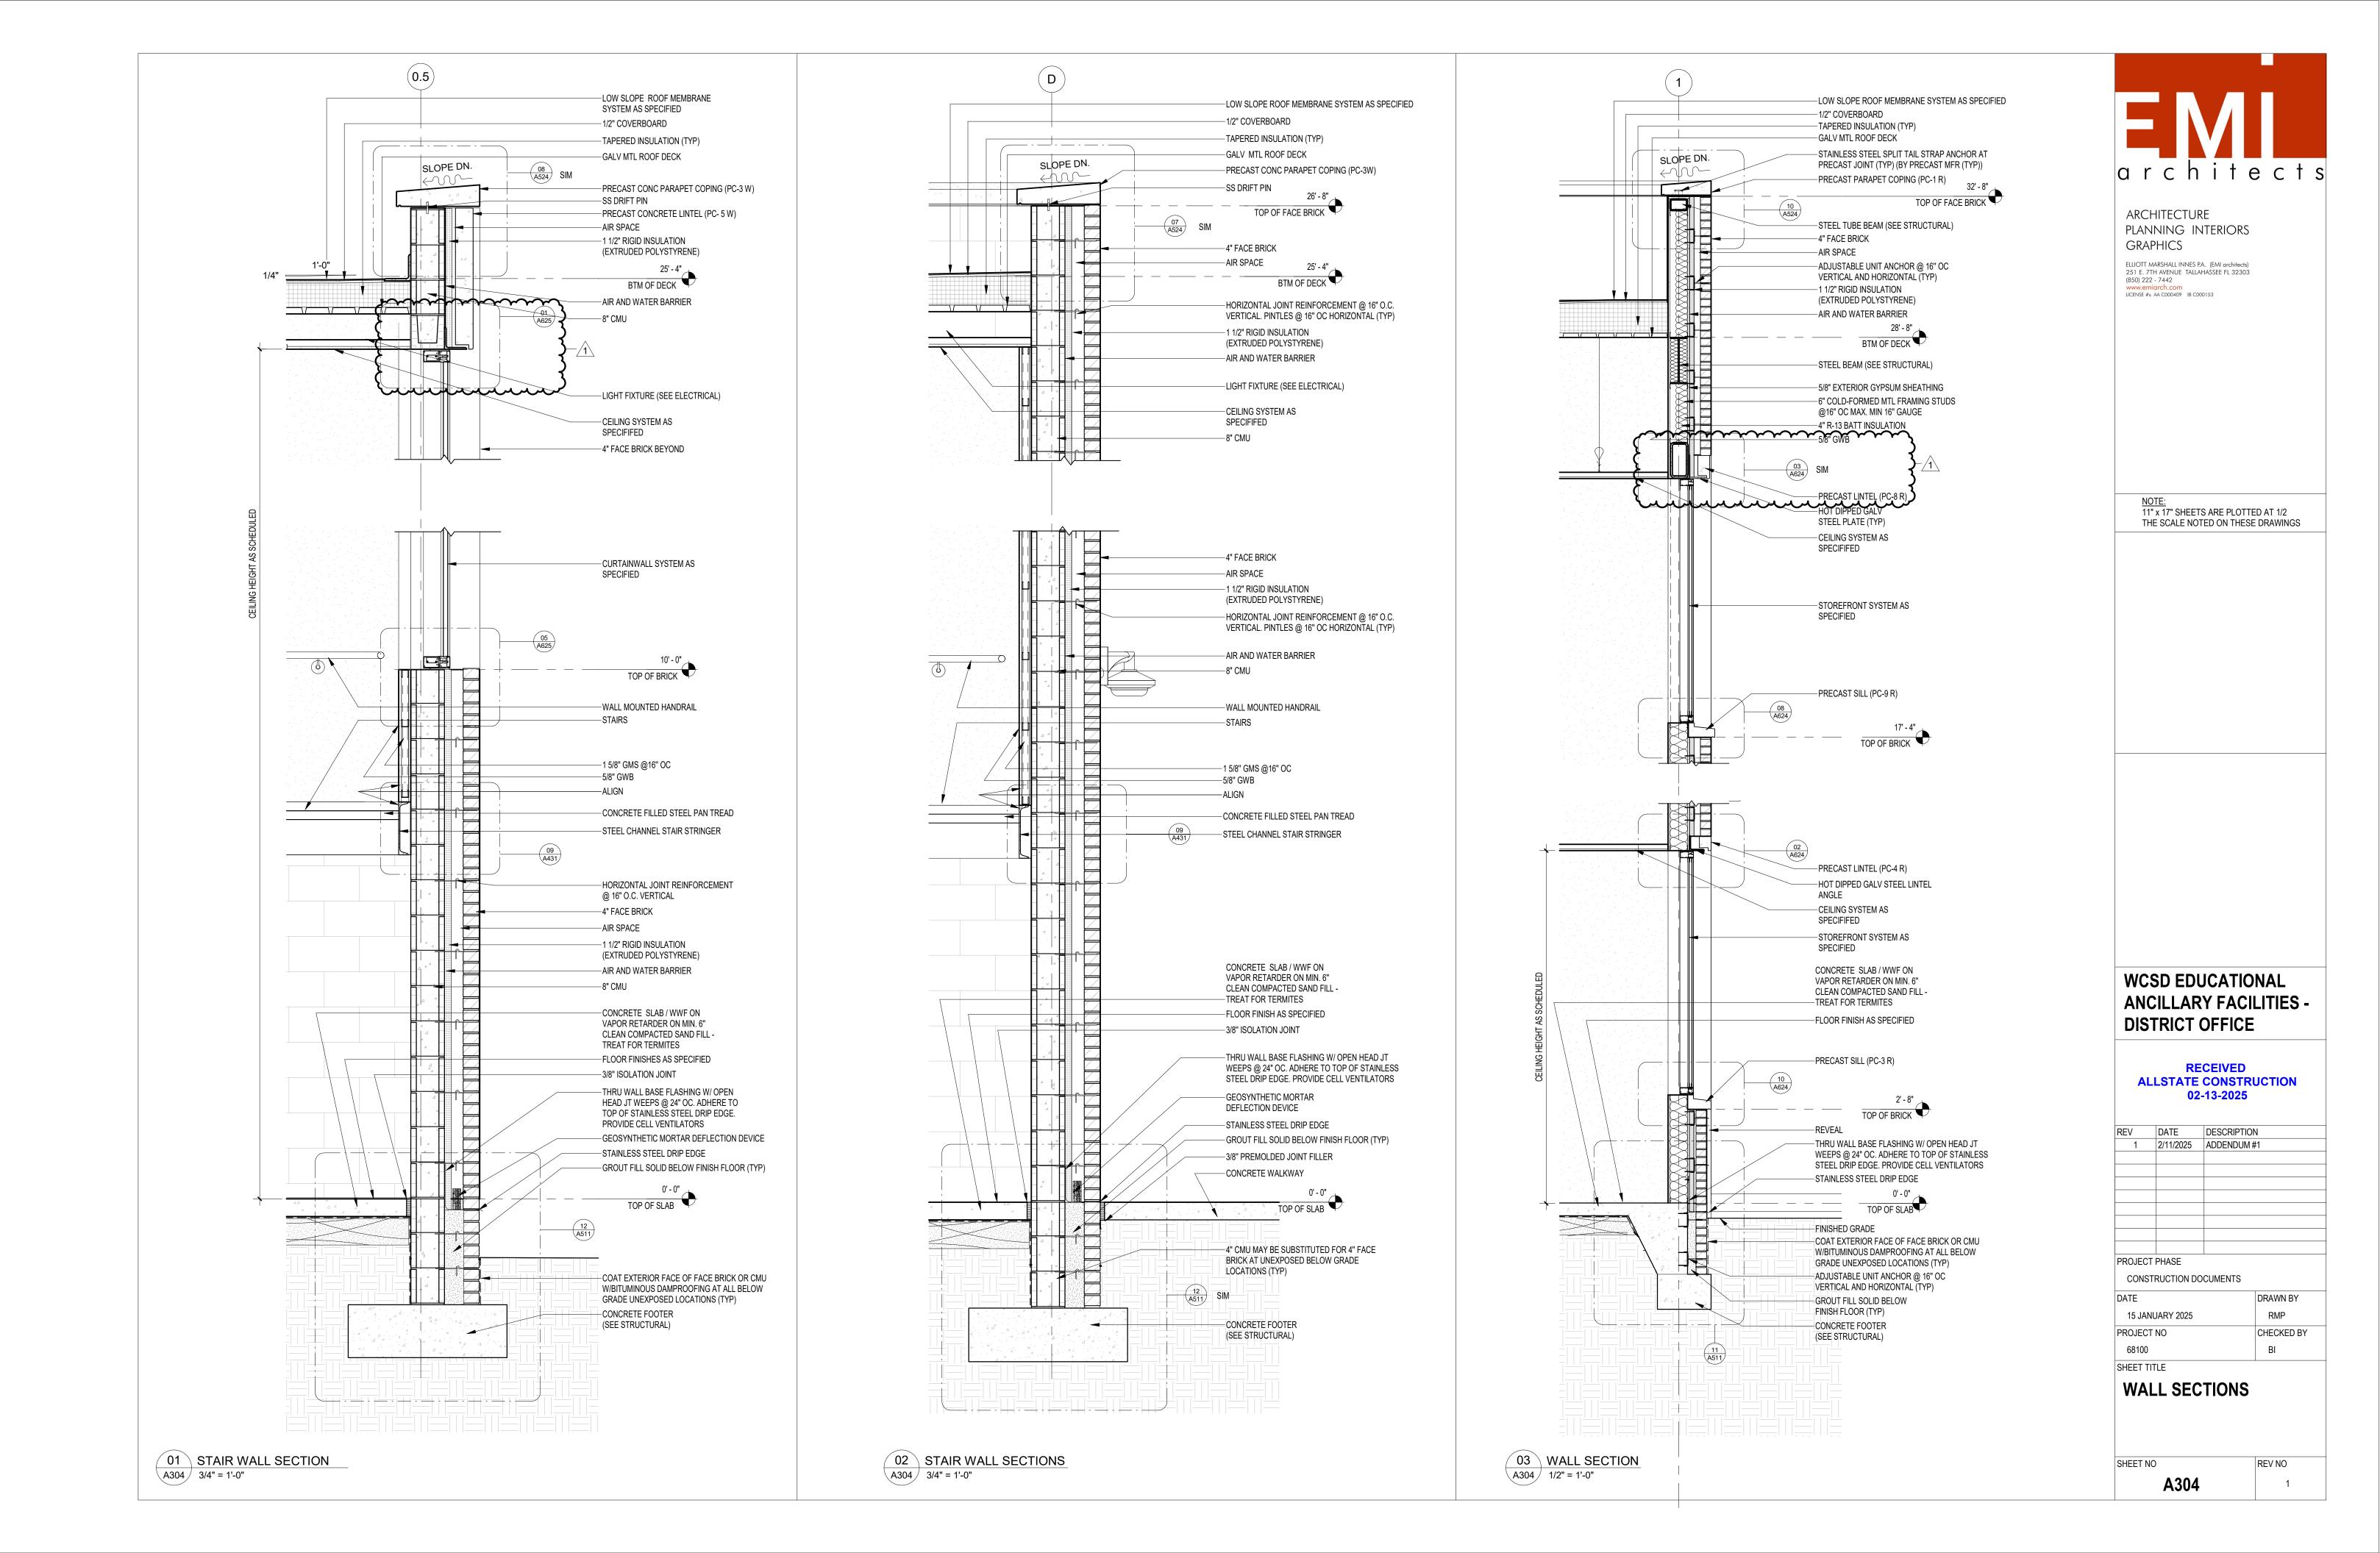

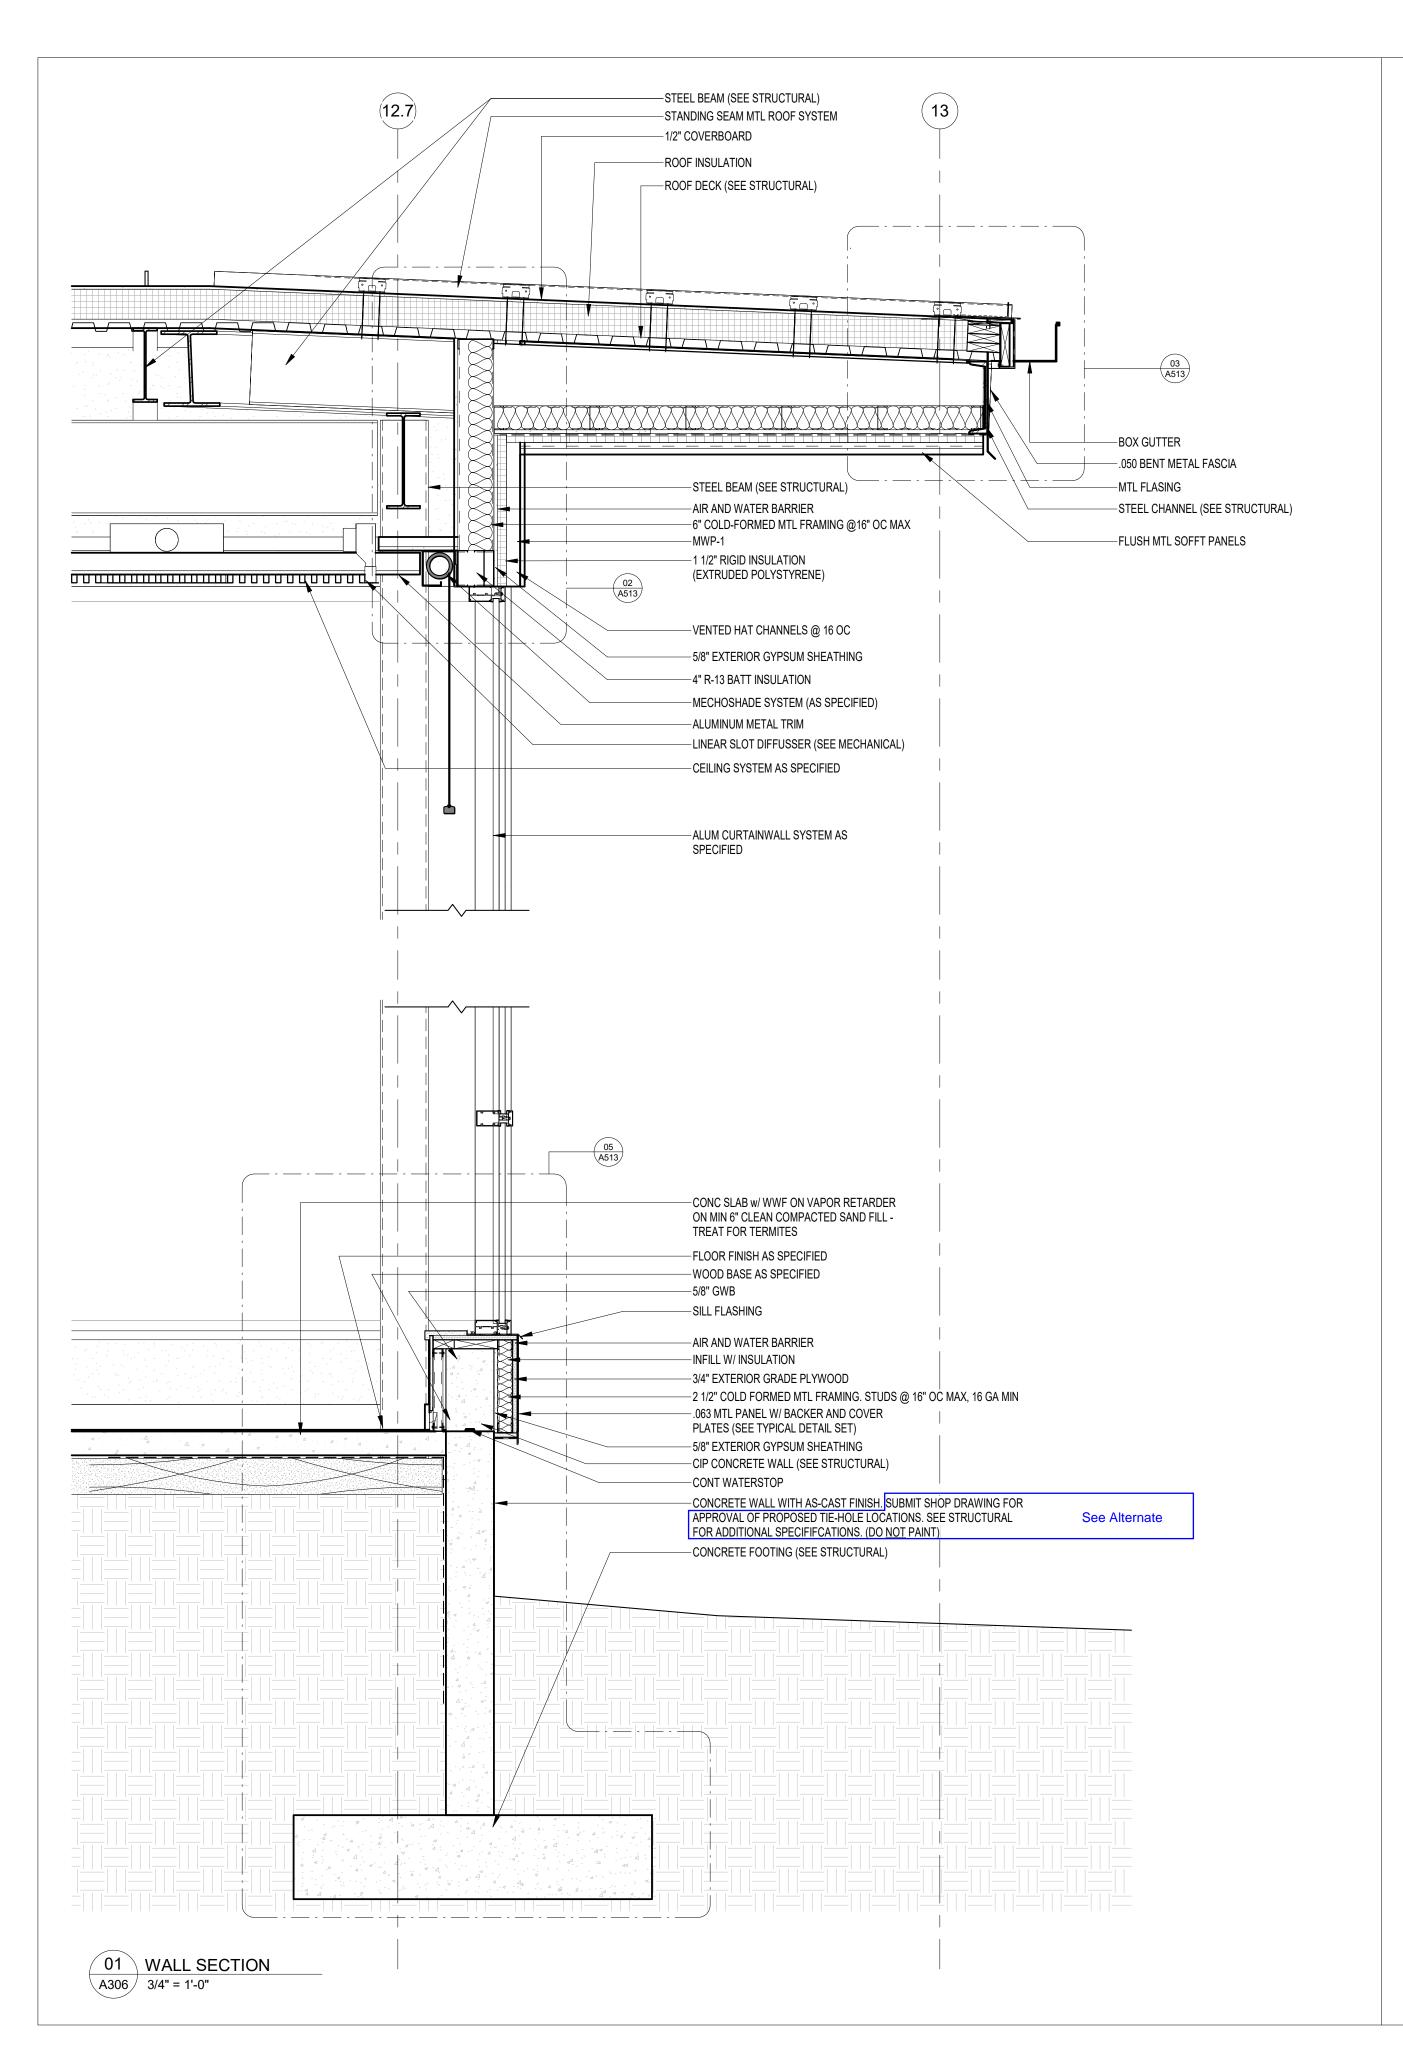

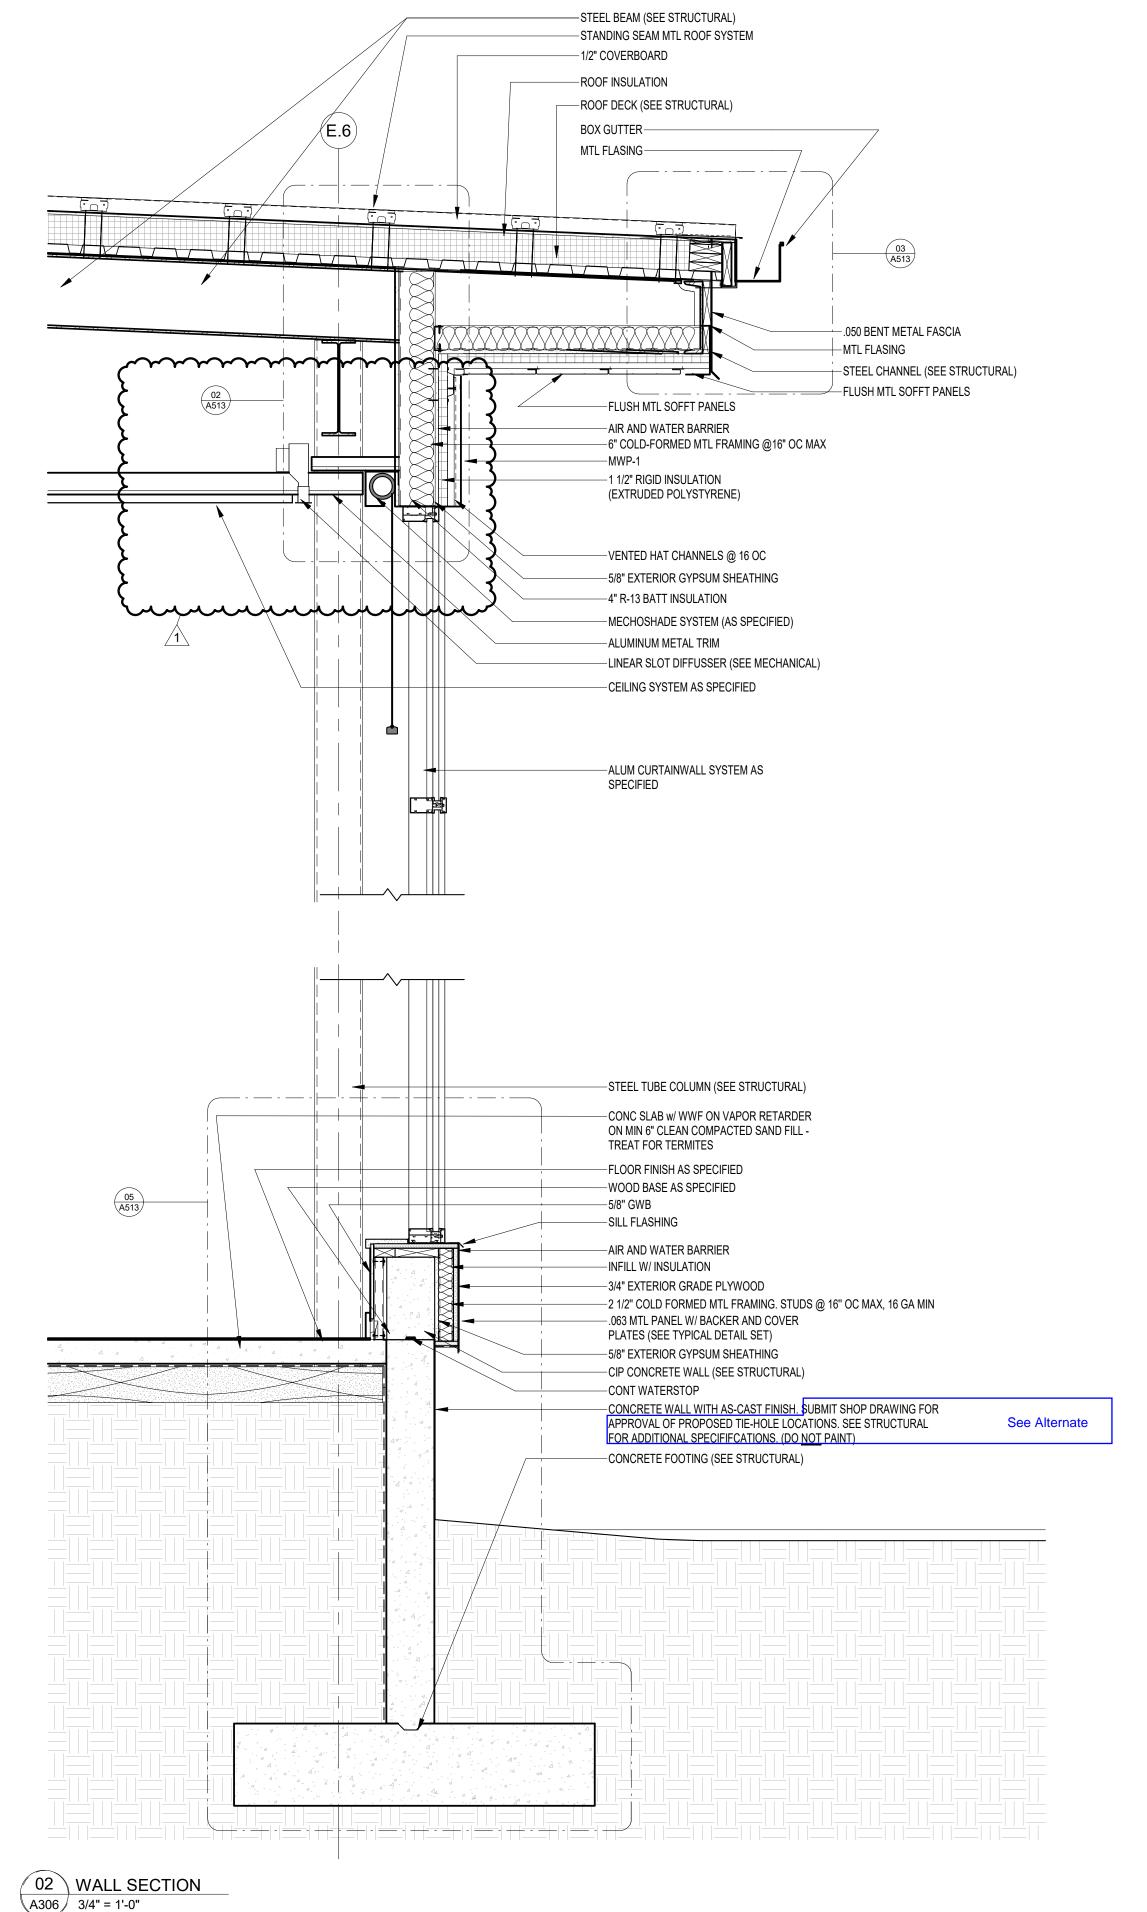



ELLIOTT MARSHALL INNES P.A. (EMI architects)
251 E. 7TH AVENUE TALLAHASSEE FL 32303
(850) 222 - 7442
www.emiarch.com
LICENSE #s AA C000409 IB C000153


NOTE: 11" x 17" SHEETS ARE PLOTTED AT 1/2 THE SCALE NOTED ON THESE DRAWINGS

WCSD EDUCATIONAL ANCILLARY FACILITIES -DISTRICT OFFICE

RECEIVED
ALLSTATE CONSTRUCTION
02-13-2025

	DATE	DESCRIPTION	
1	2/11/2025	ADDENDUM #1	
PROJEC1	 ΓPHASE		
CONS	TRUCTION D	OCUMENTS	
DATE			DRAWN BY
15 JAN	IUARY 2025		RMP
PROJECT	Г NO		CHECKED BY
68100			
SHEET T	ITLE		
\A/ A		PHONE	
VVA	LL SE	CTIONS	

REV NO

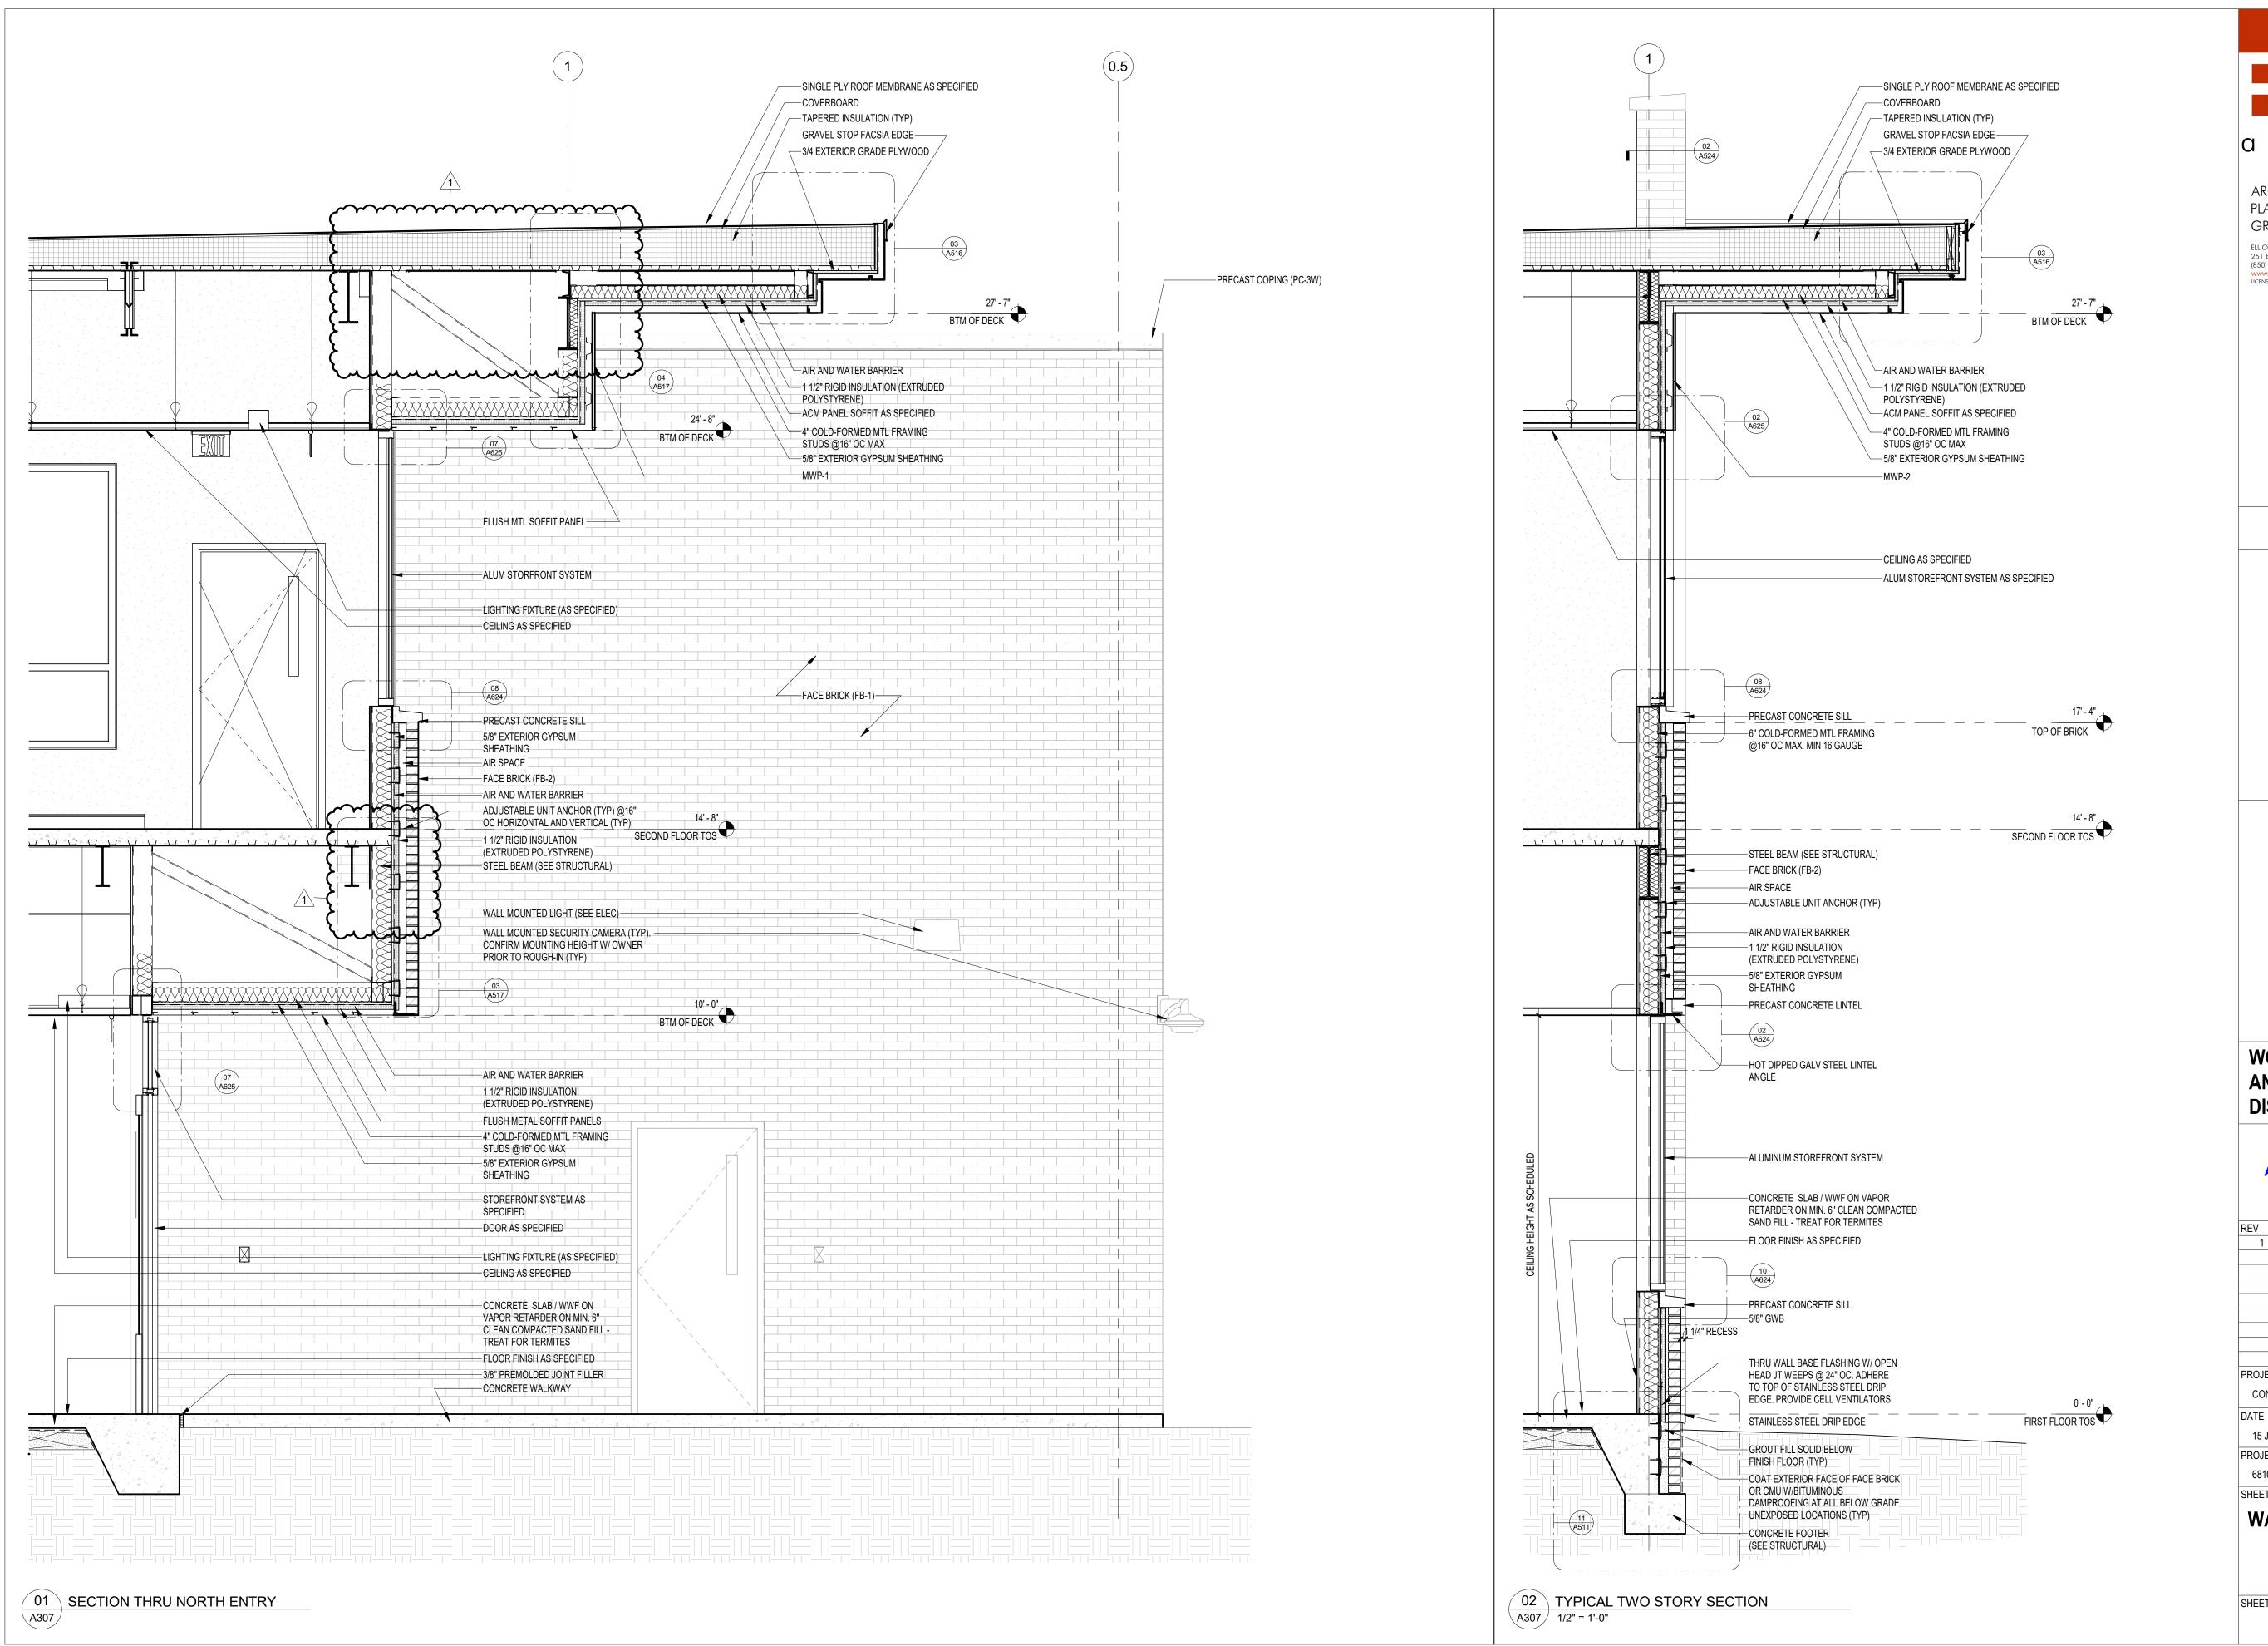

architects

ARCHITECTURE PLANNING INTERIORS **GRAPHICS**

ELLIOTT MARSHALL INNES P.A. (EMI architects)
251 E. 7TH AVENUE TALLAHASSEE FL 32303
(850) 222 - 7442
www.emiarch.com
LICENSE #s AA C000409 IB C000153

NOTE: 11" x 17" SHEETS ARE PLOTTED AT 1/2 THE SCALE NOTED ON THESE DRAWINGS


WCSD EDUCATIONAL **ANCILLARY FACILITIES -**DISTRICT OFFICE


RECEIVED ALLSTATE CONSTRUCTION 02-13-2025


DATE DESCRIPTION


1 2/11/2025 ADDENDUM #1 PROJECT PHASE CONSTRUCTION DOCUMENTS DRAWN BY RMP 15 JANUARY 2025 PROJECT NO CHECKED BY 68100 SHEET TITLE WALL SECTIONS


REV NO A307

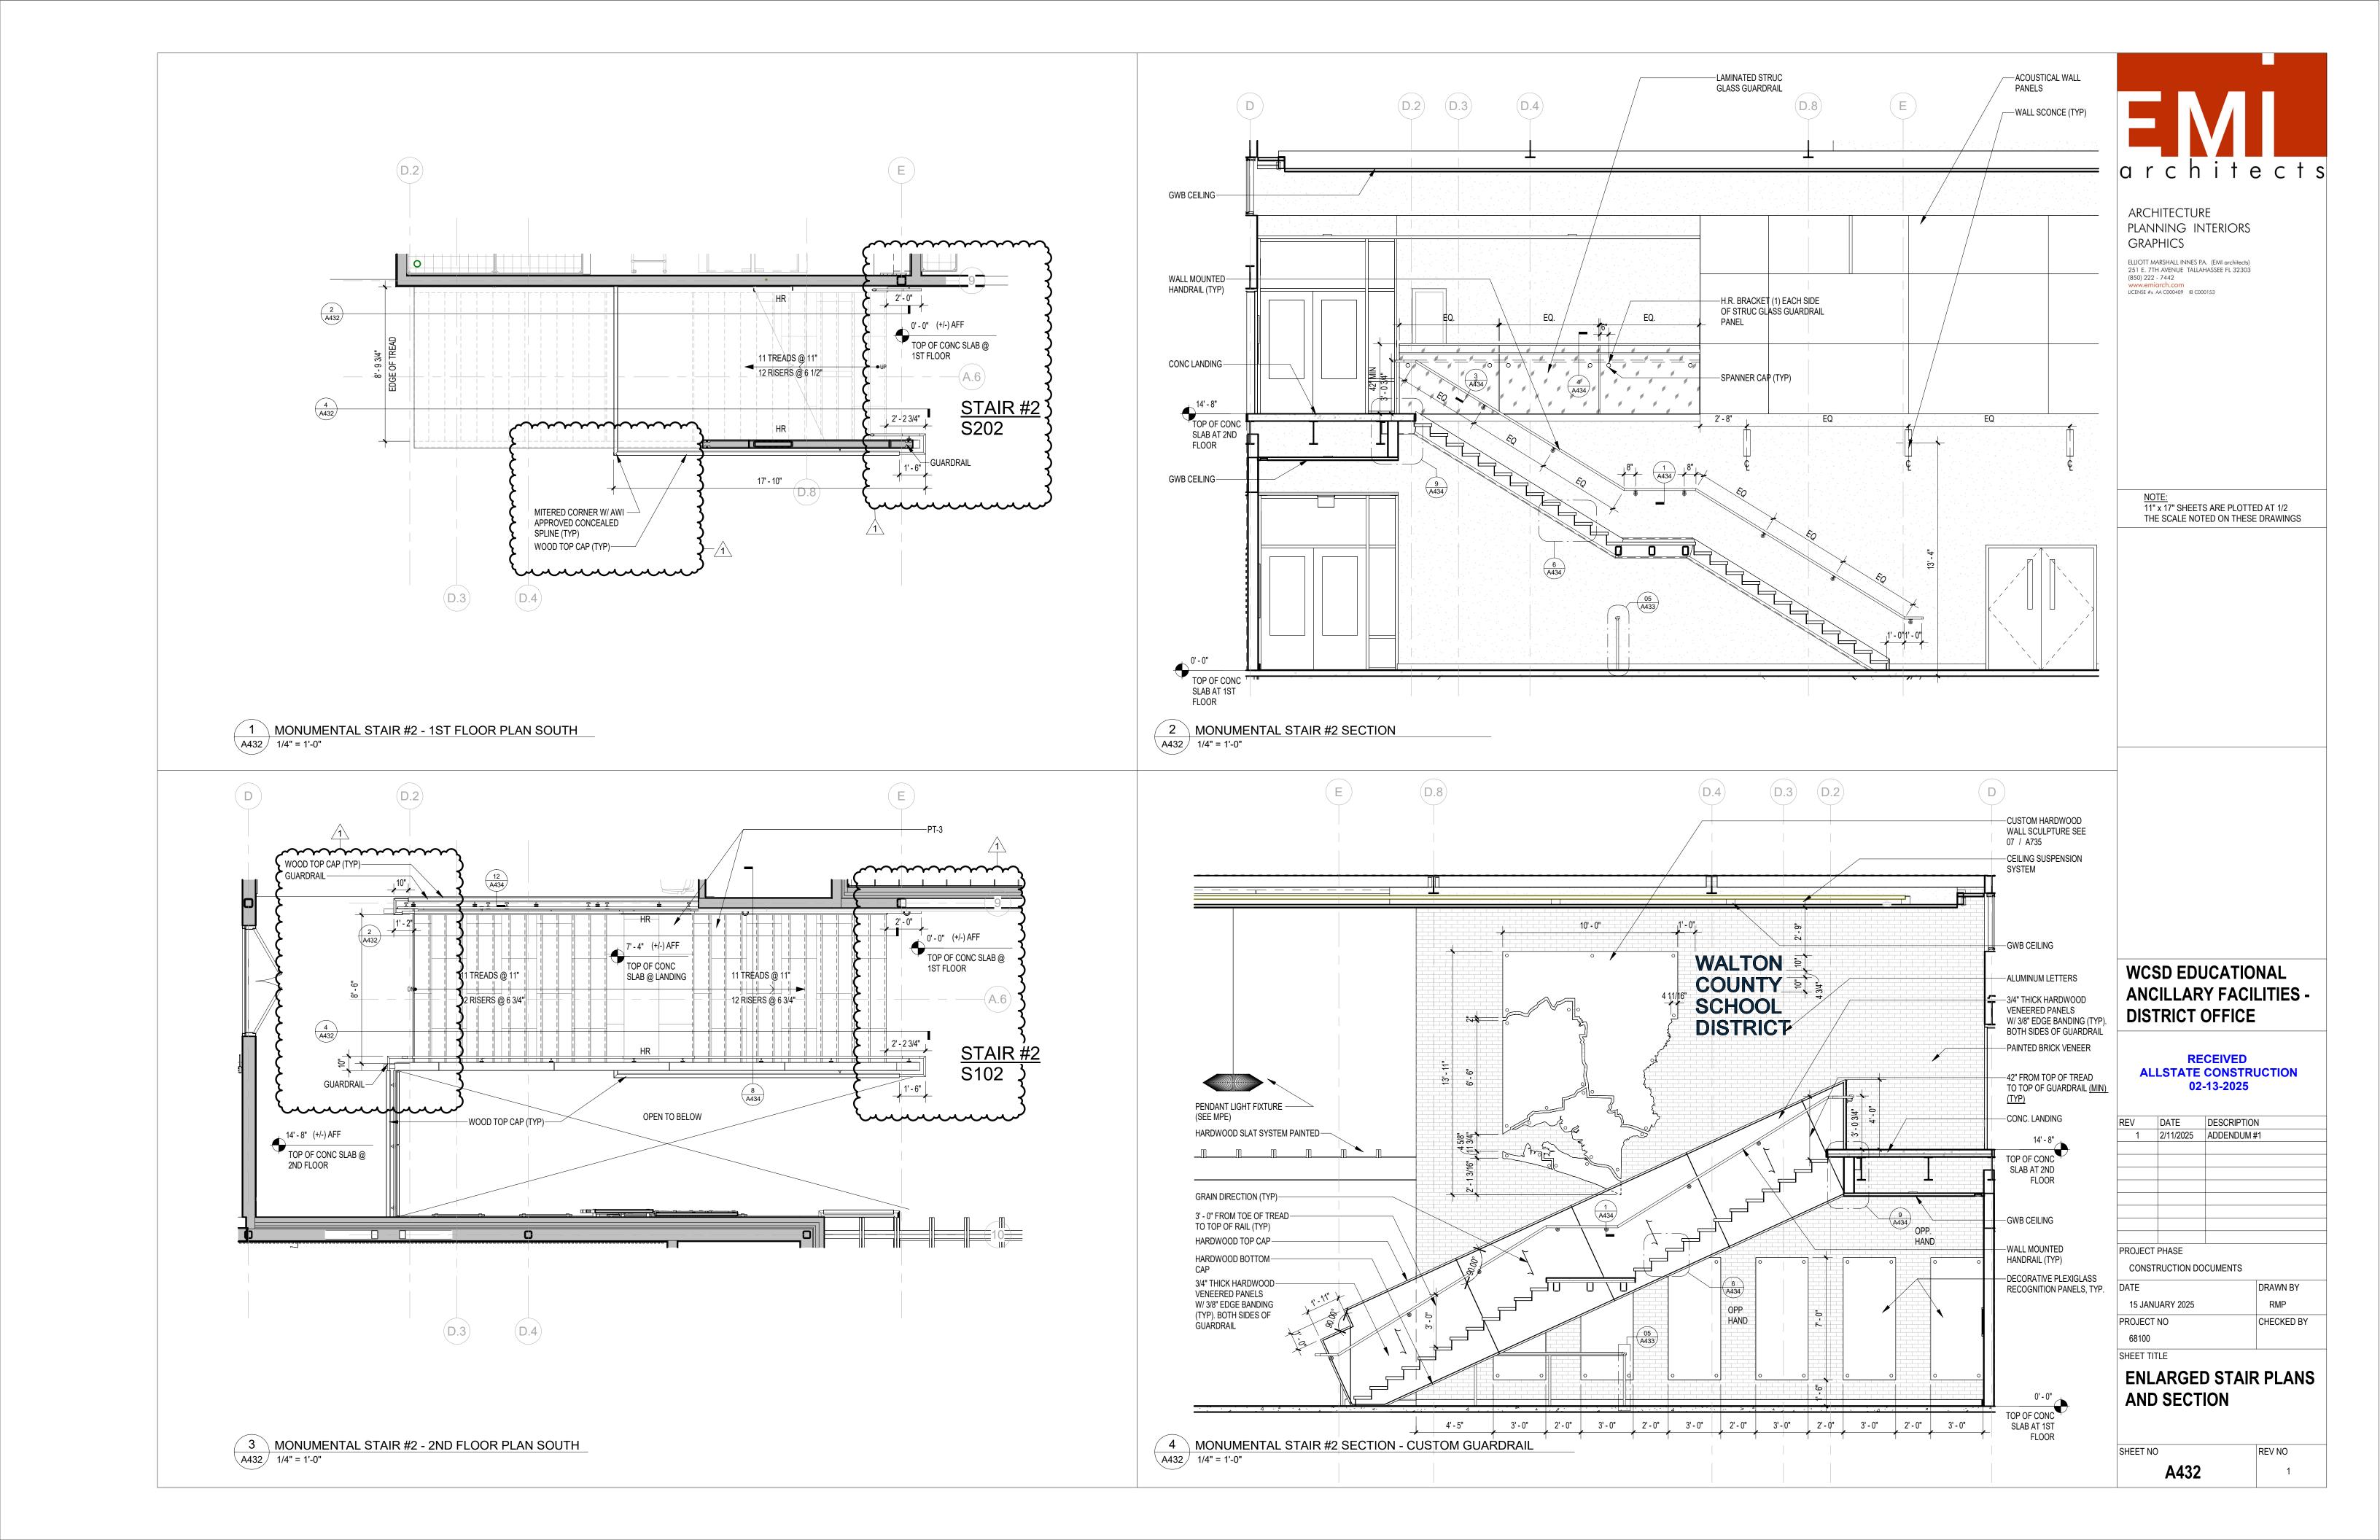


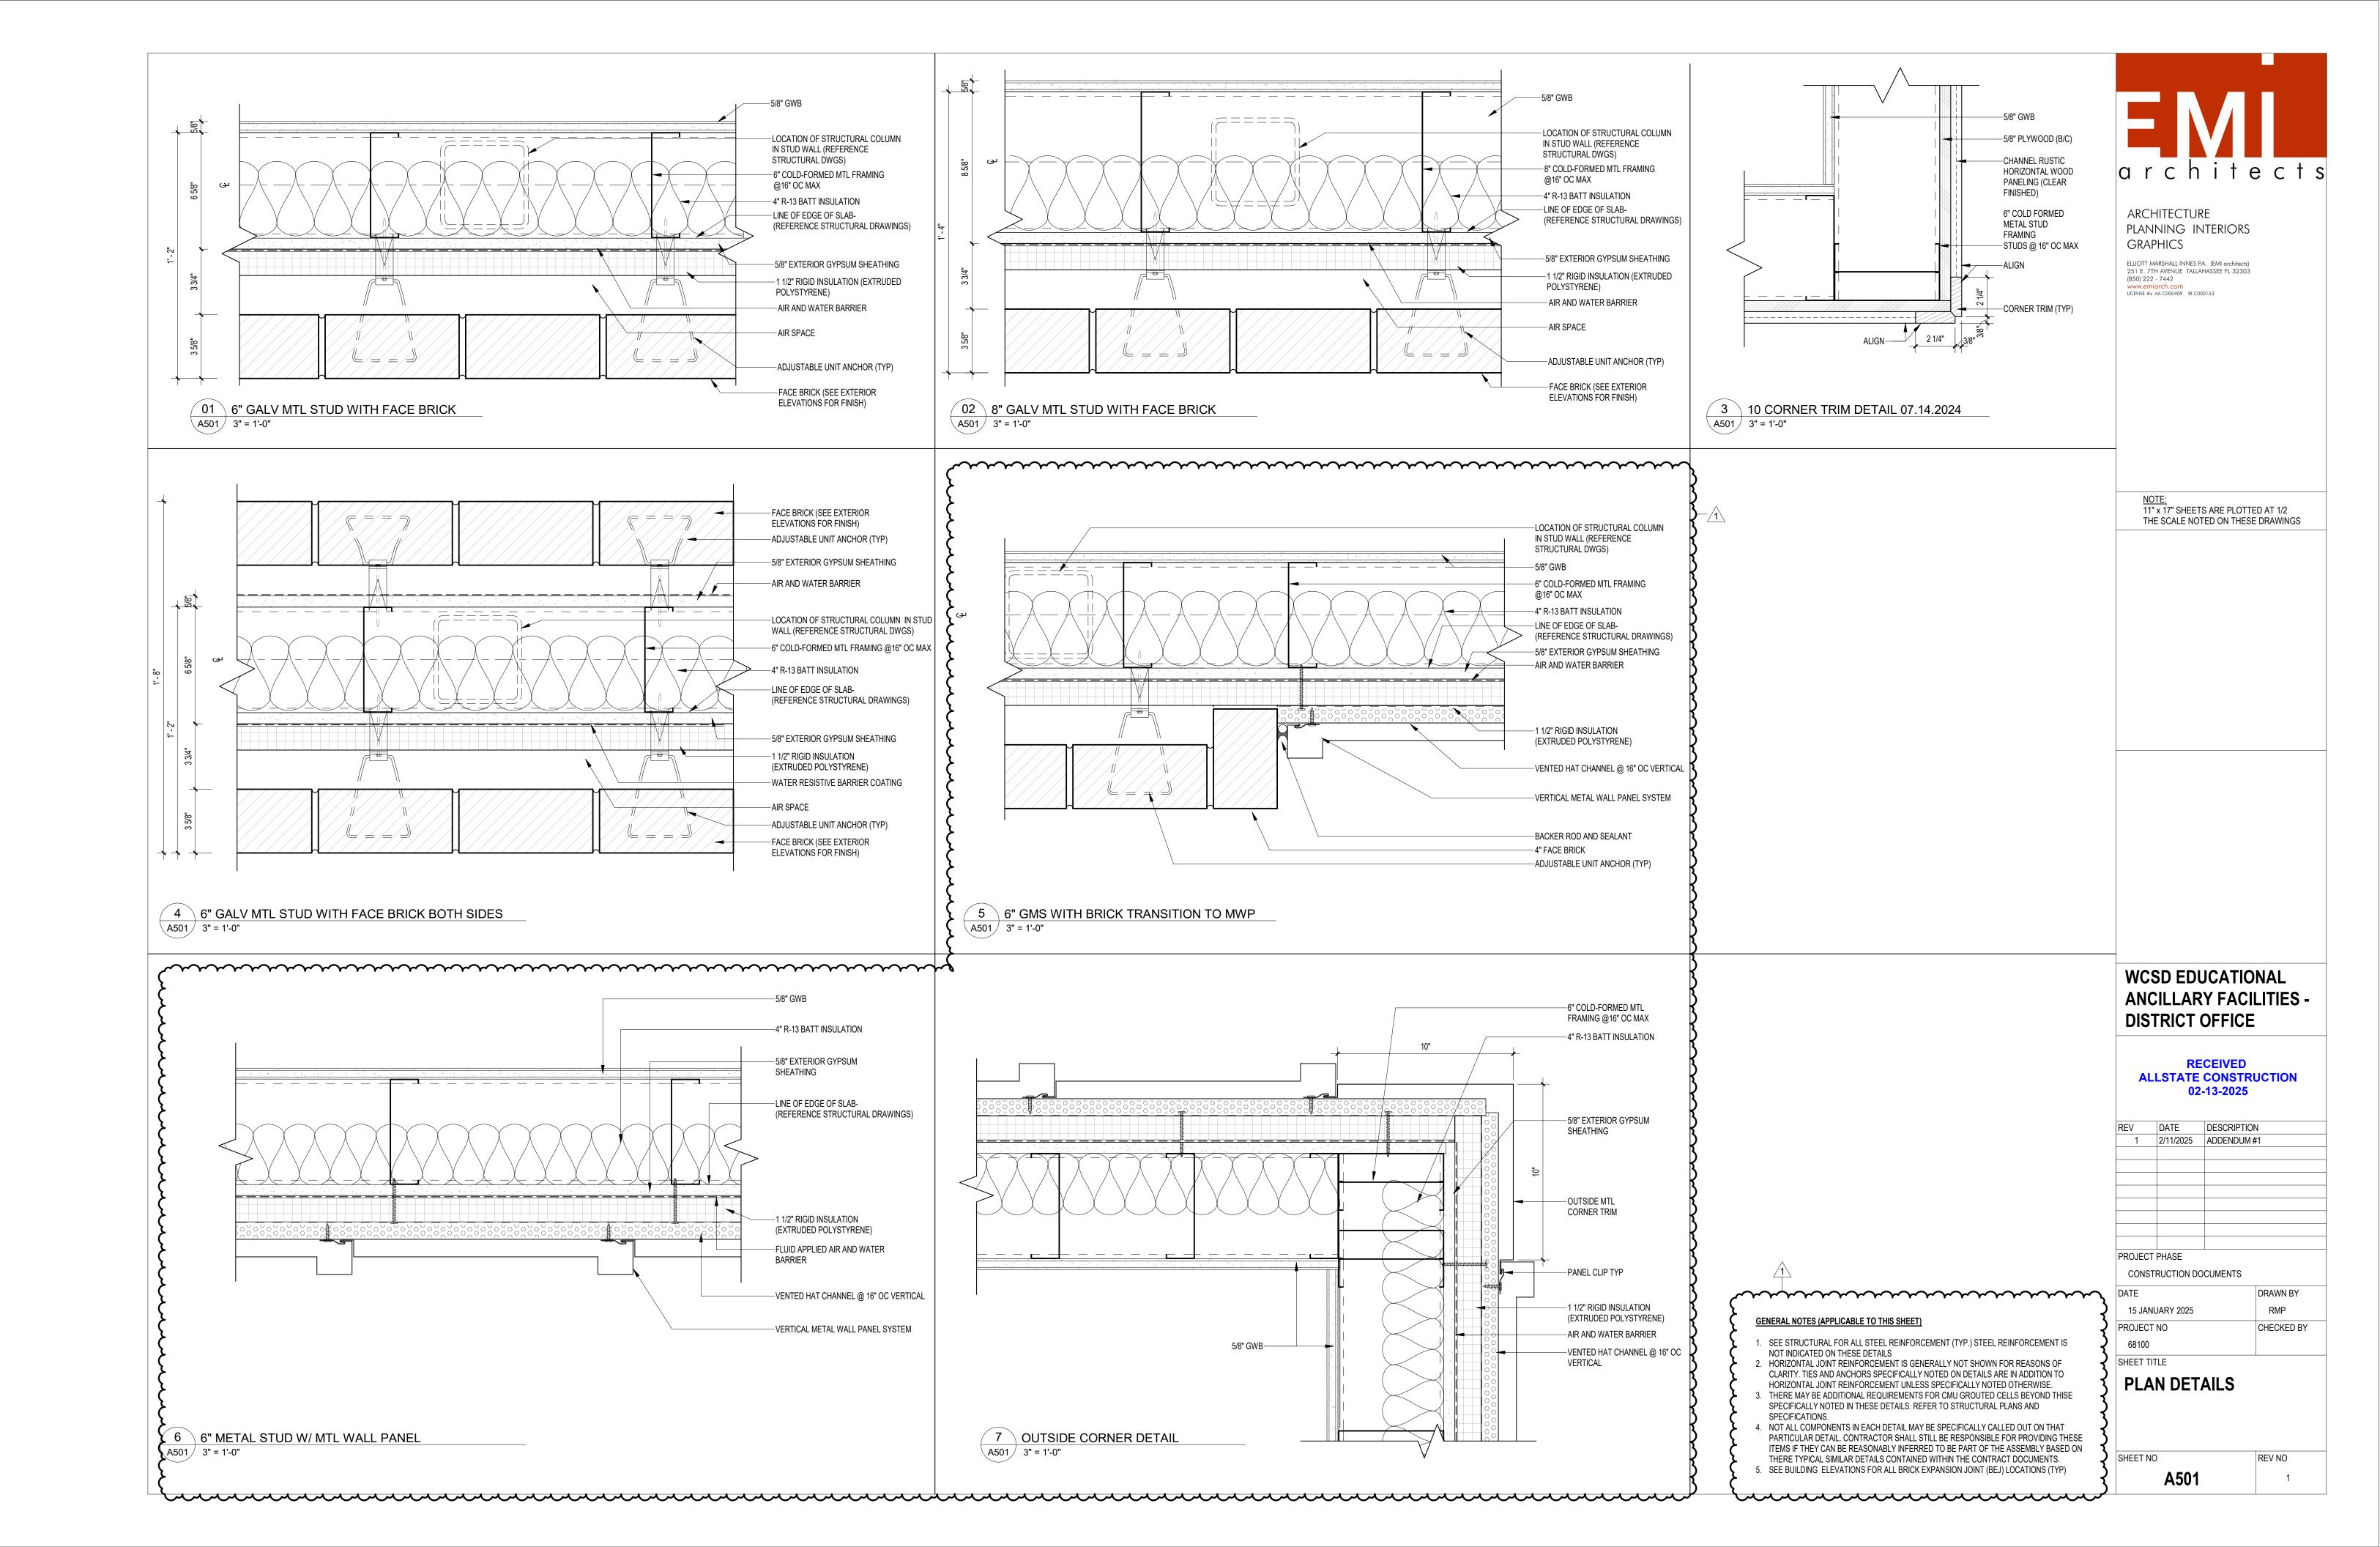


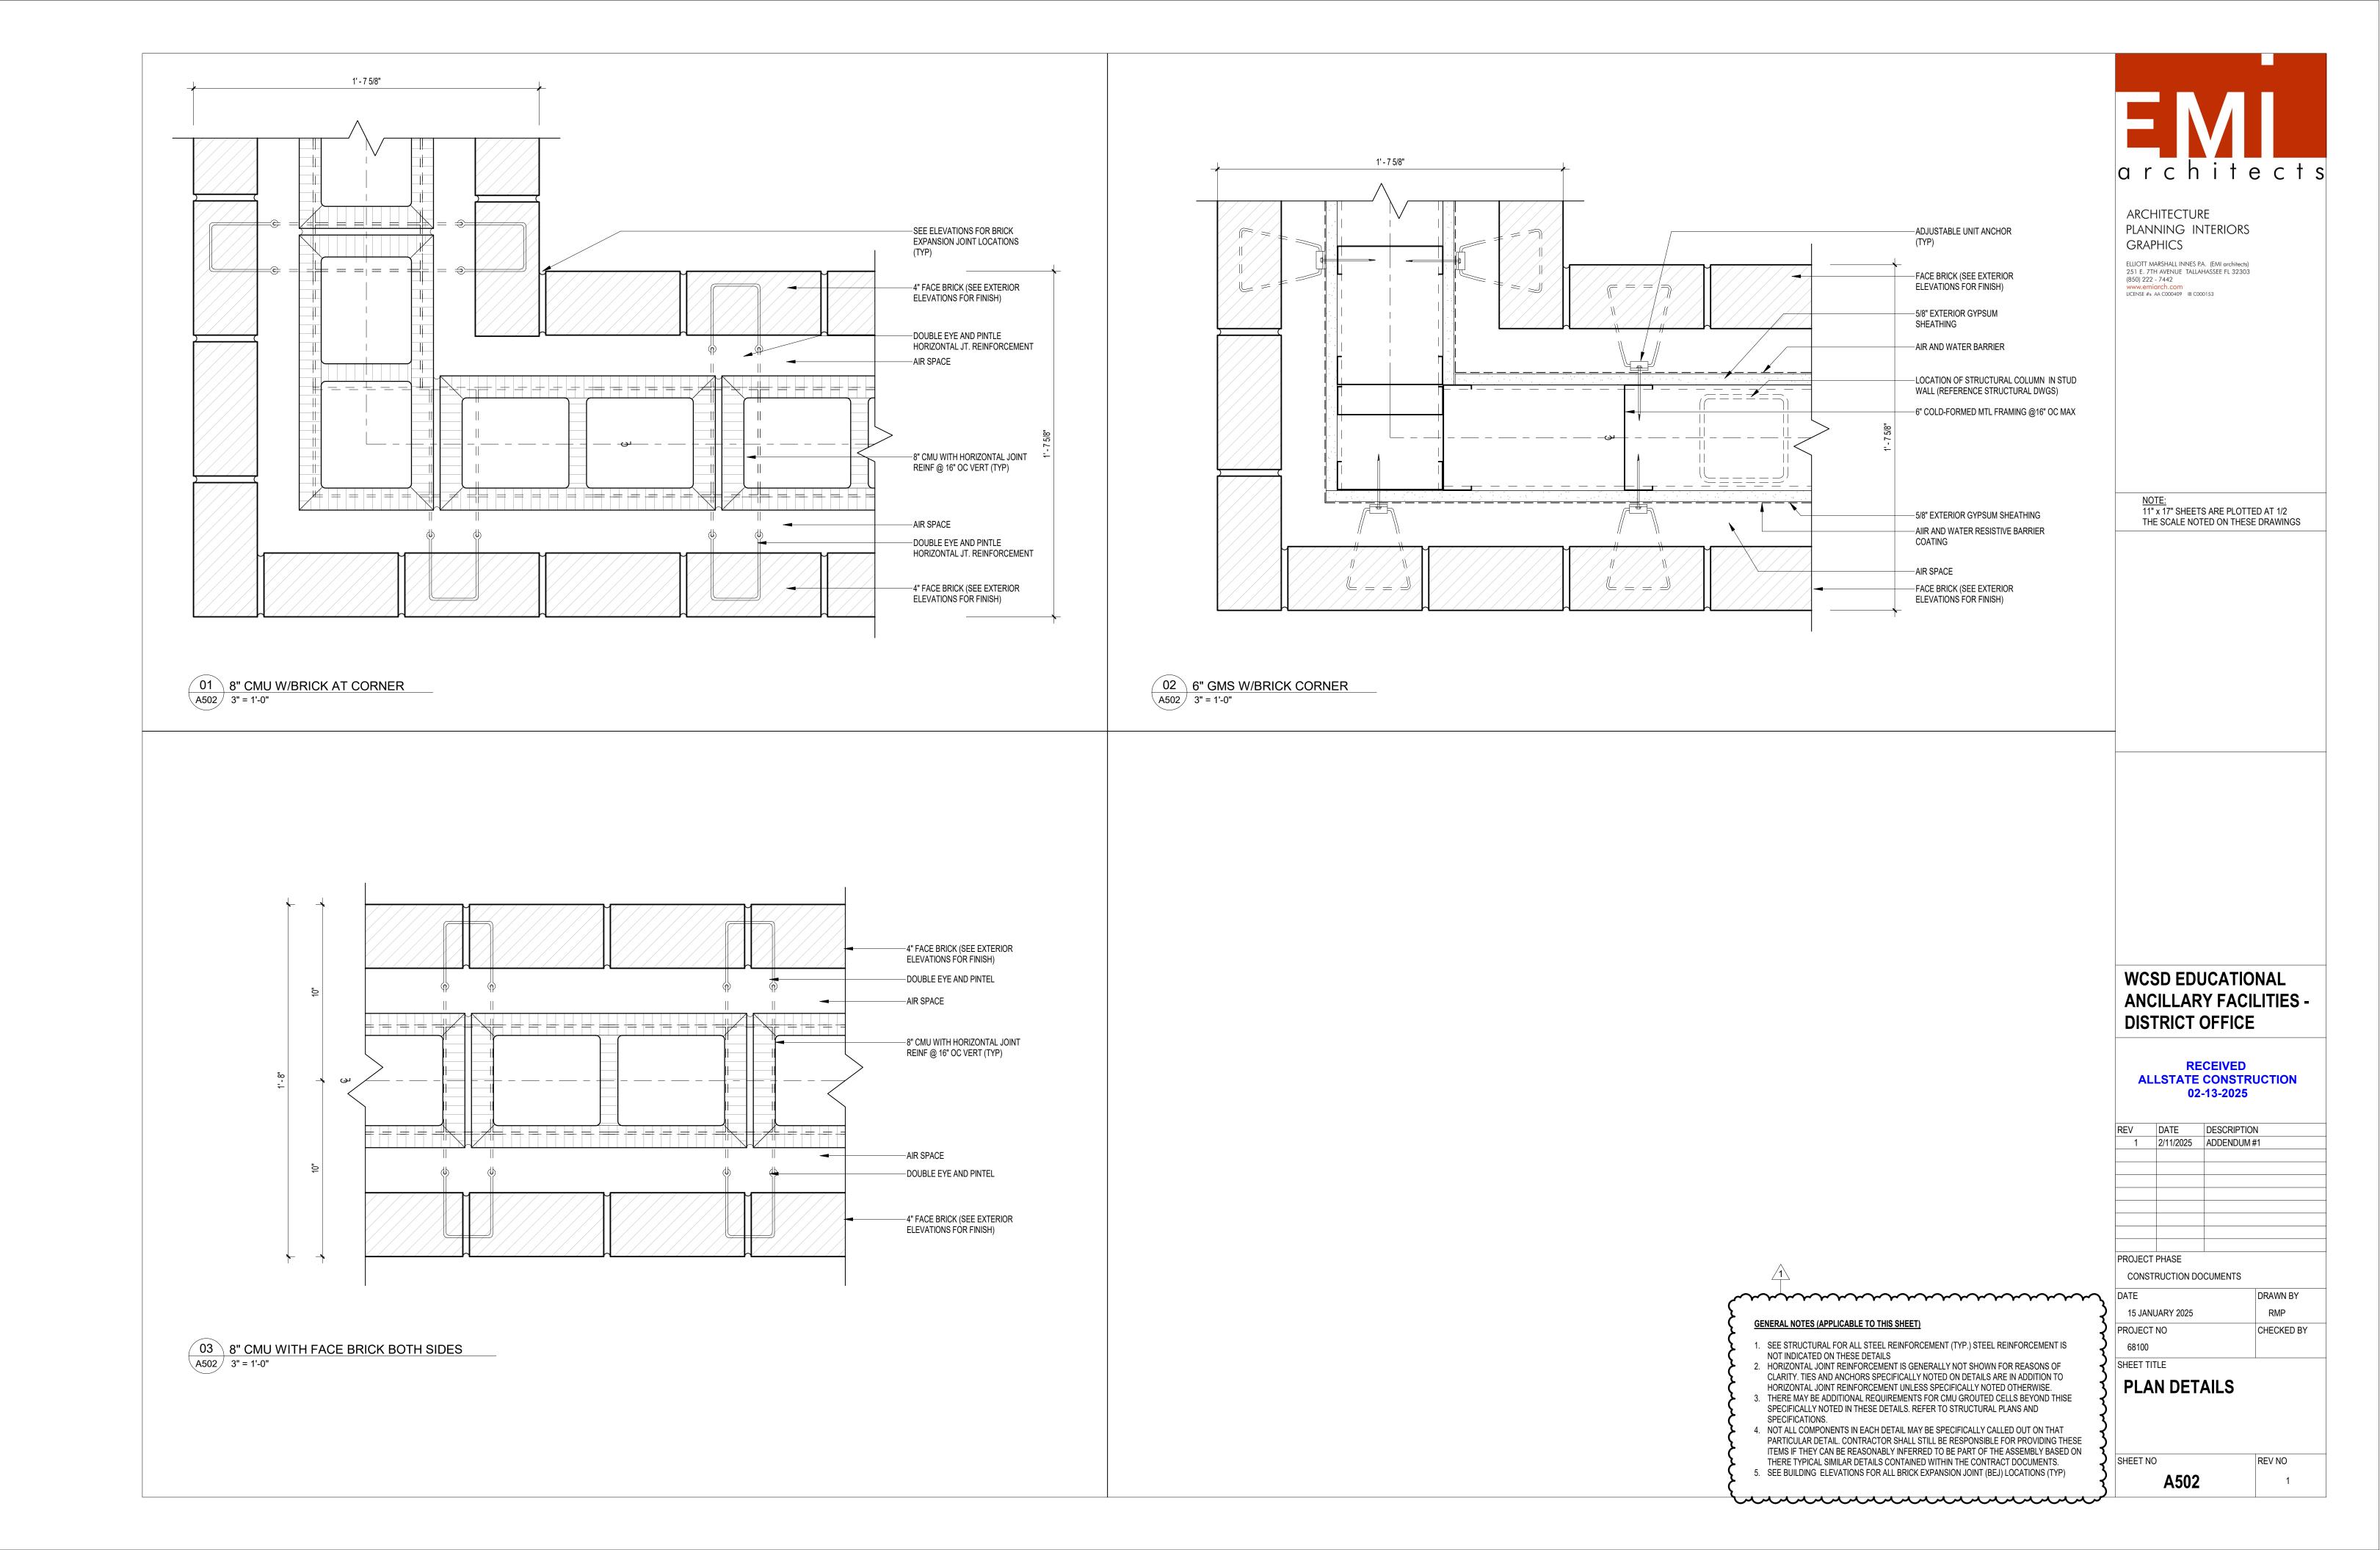


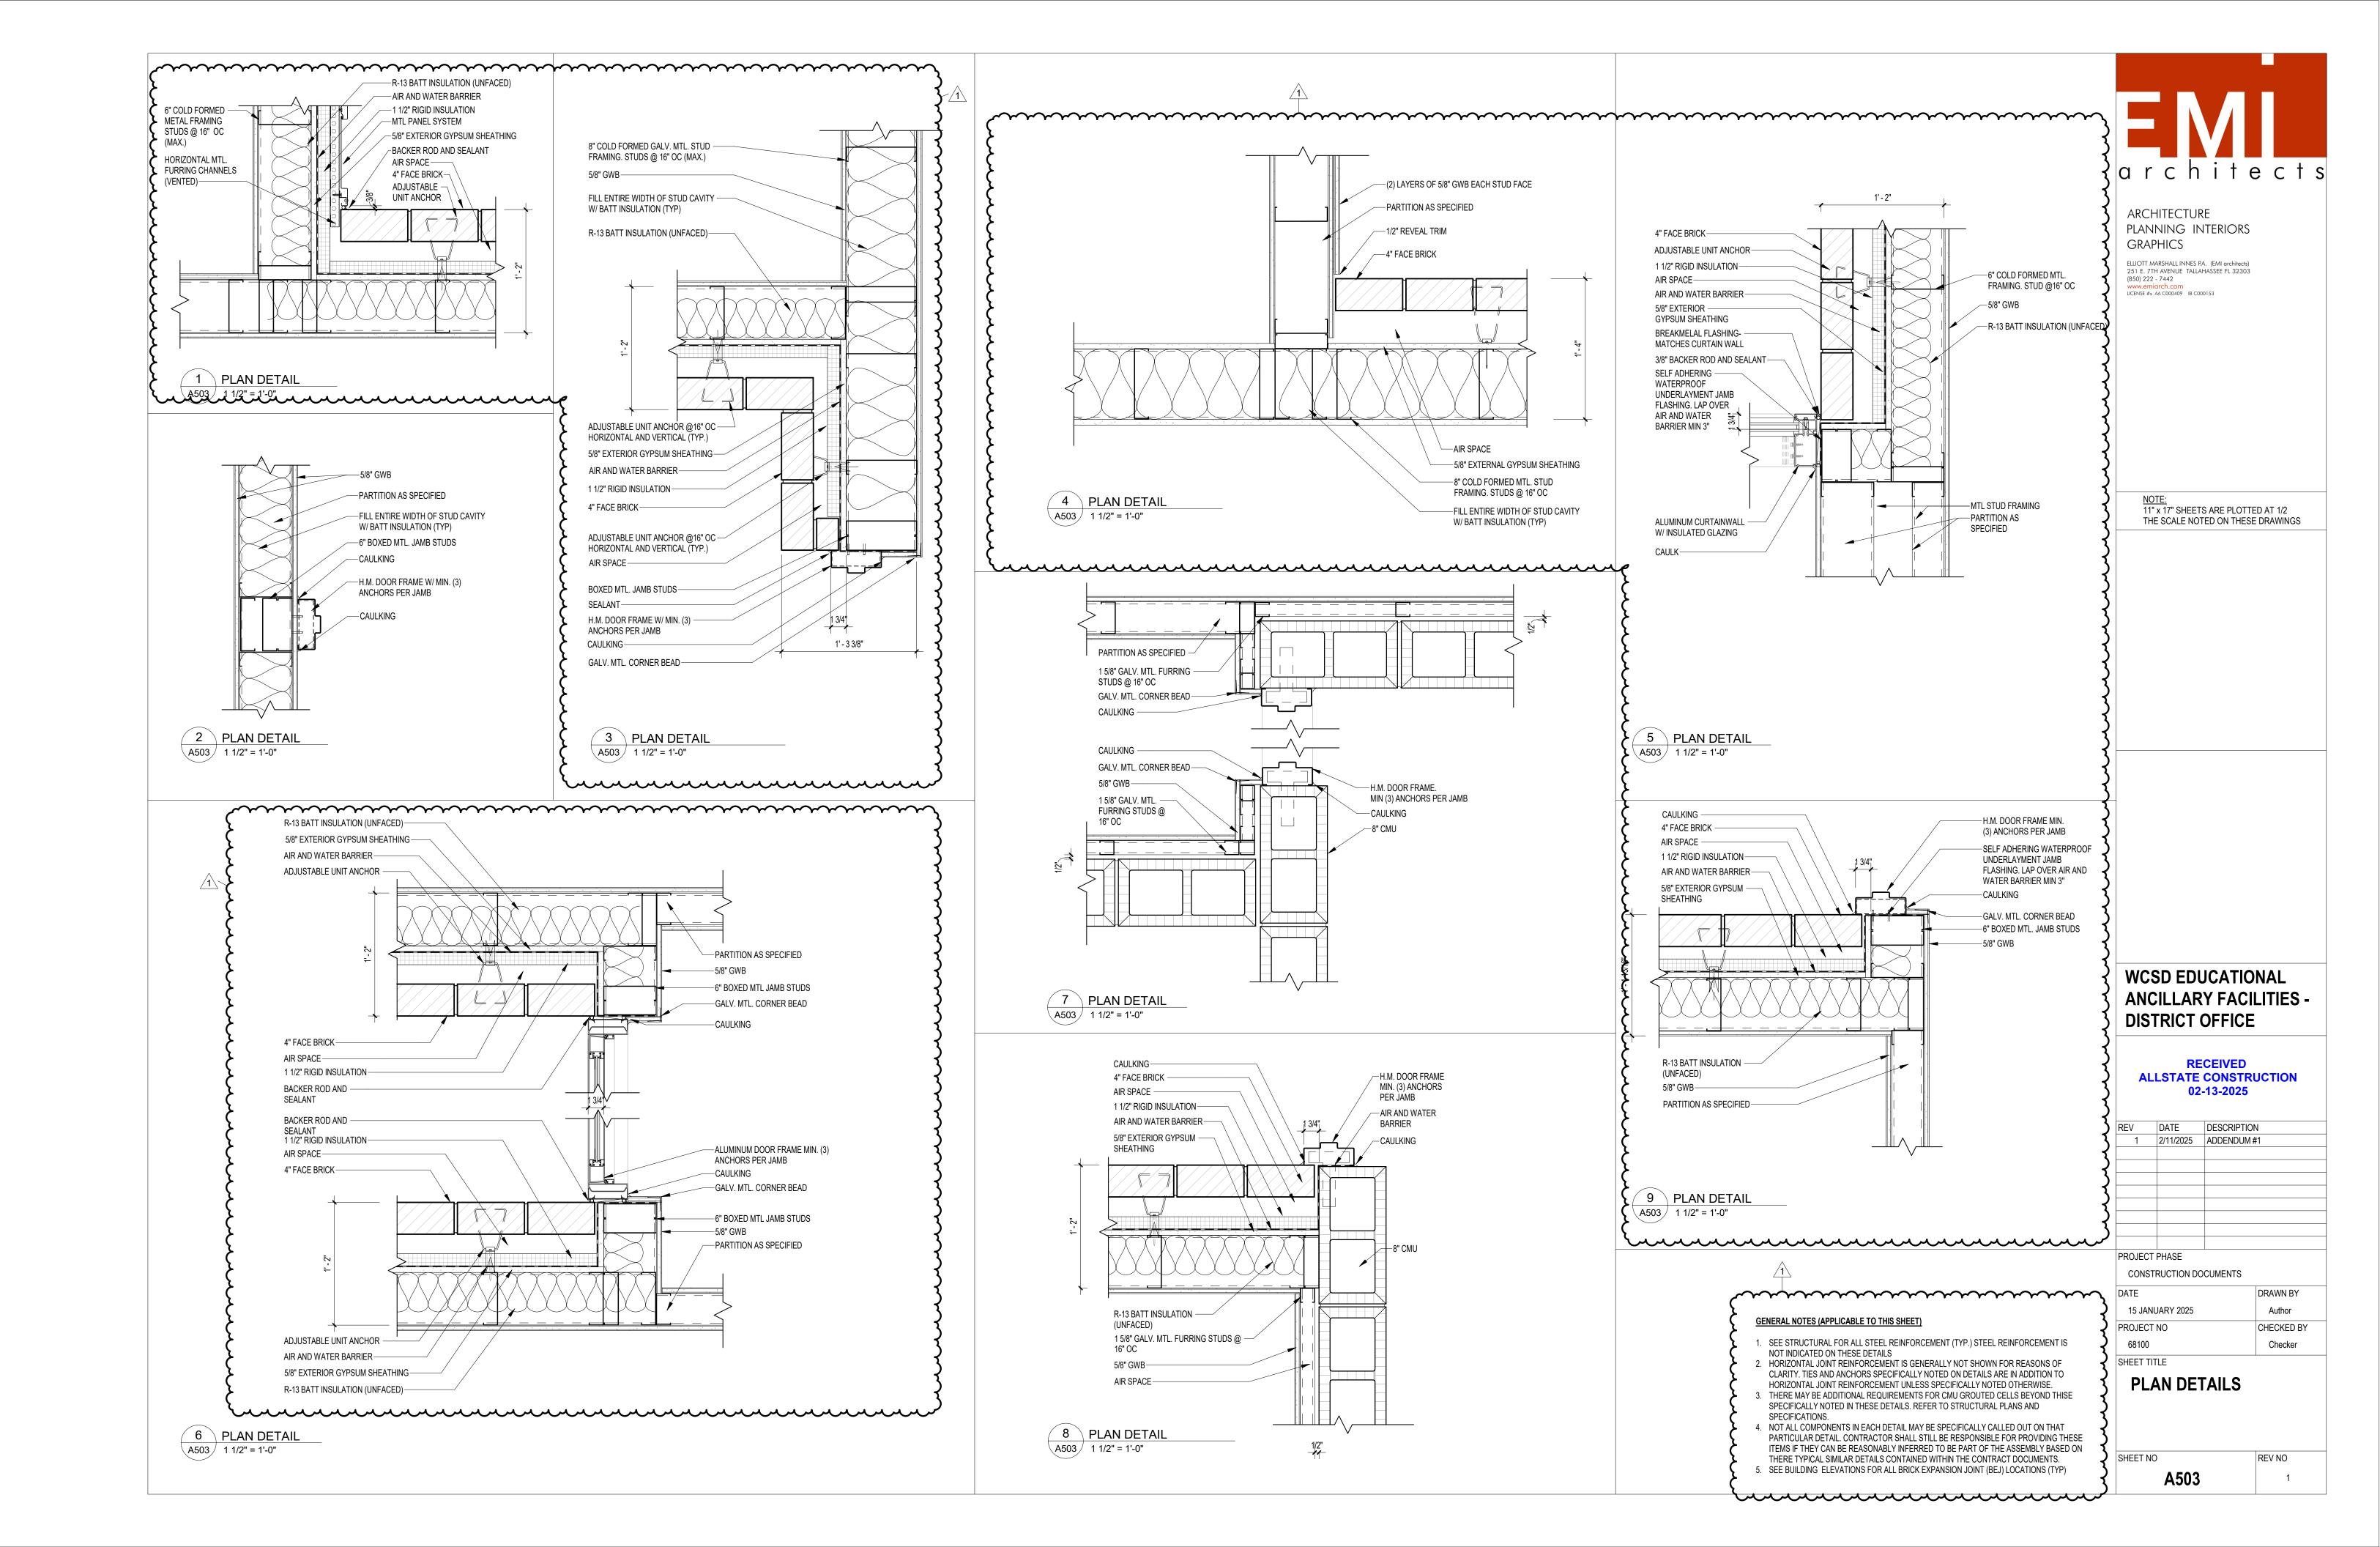


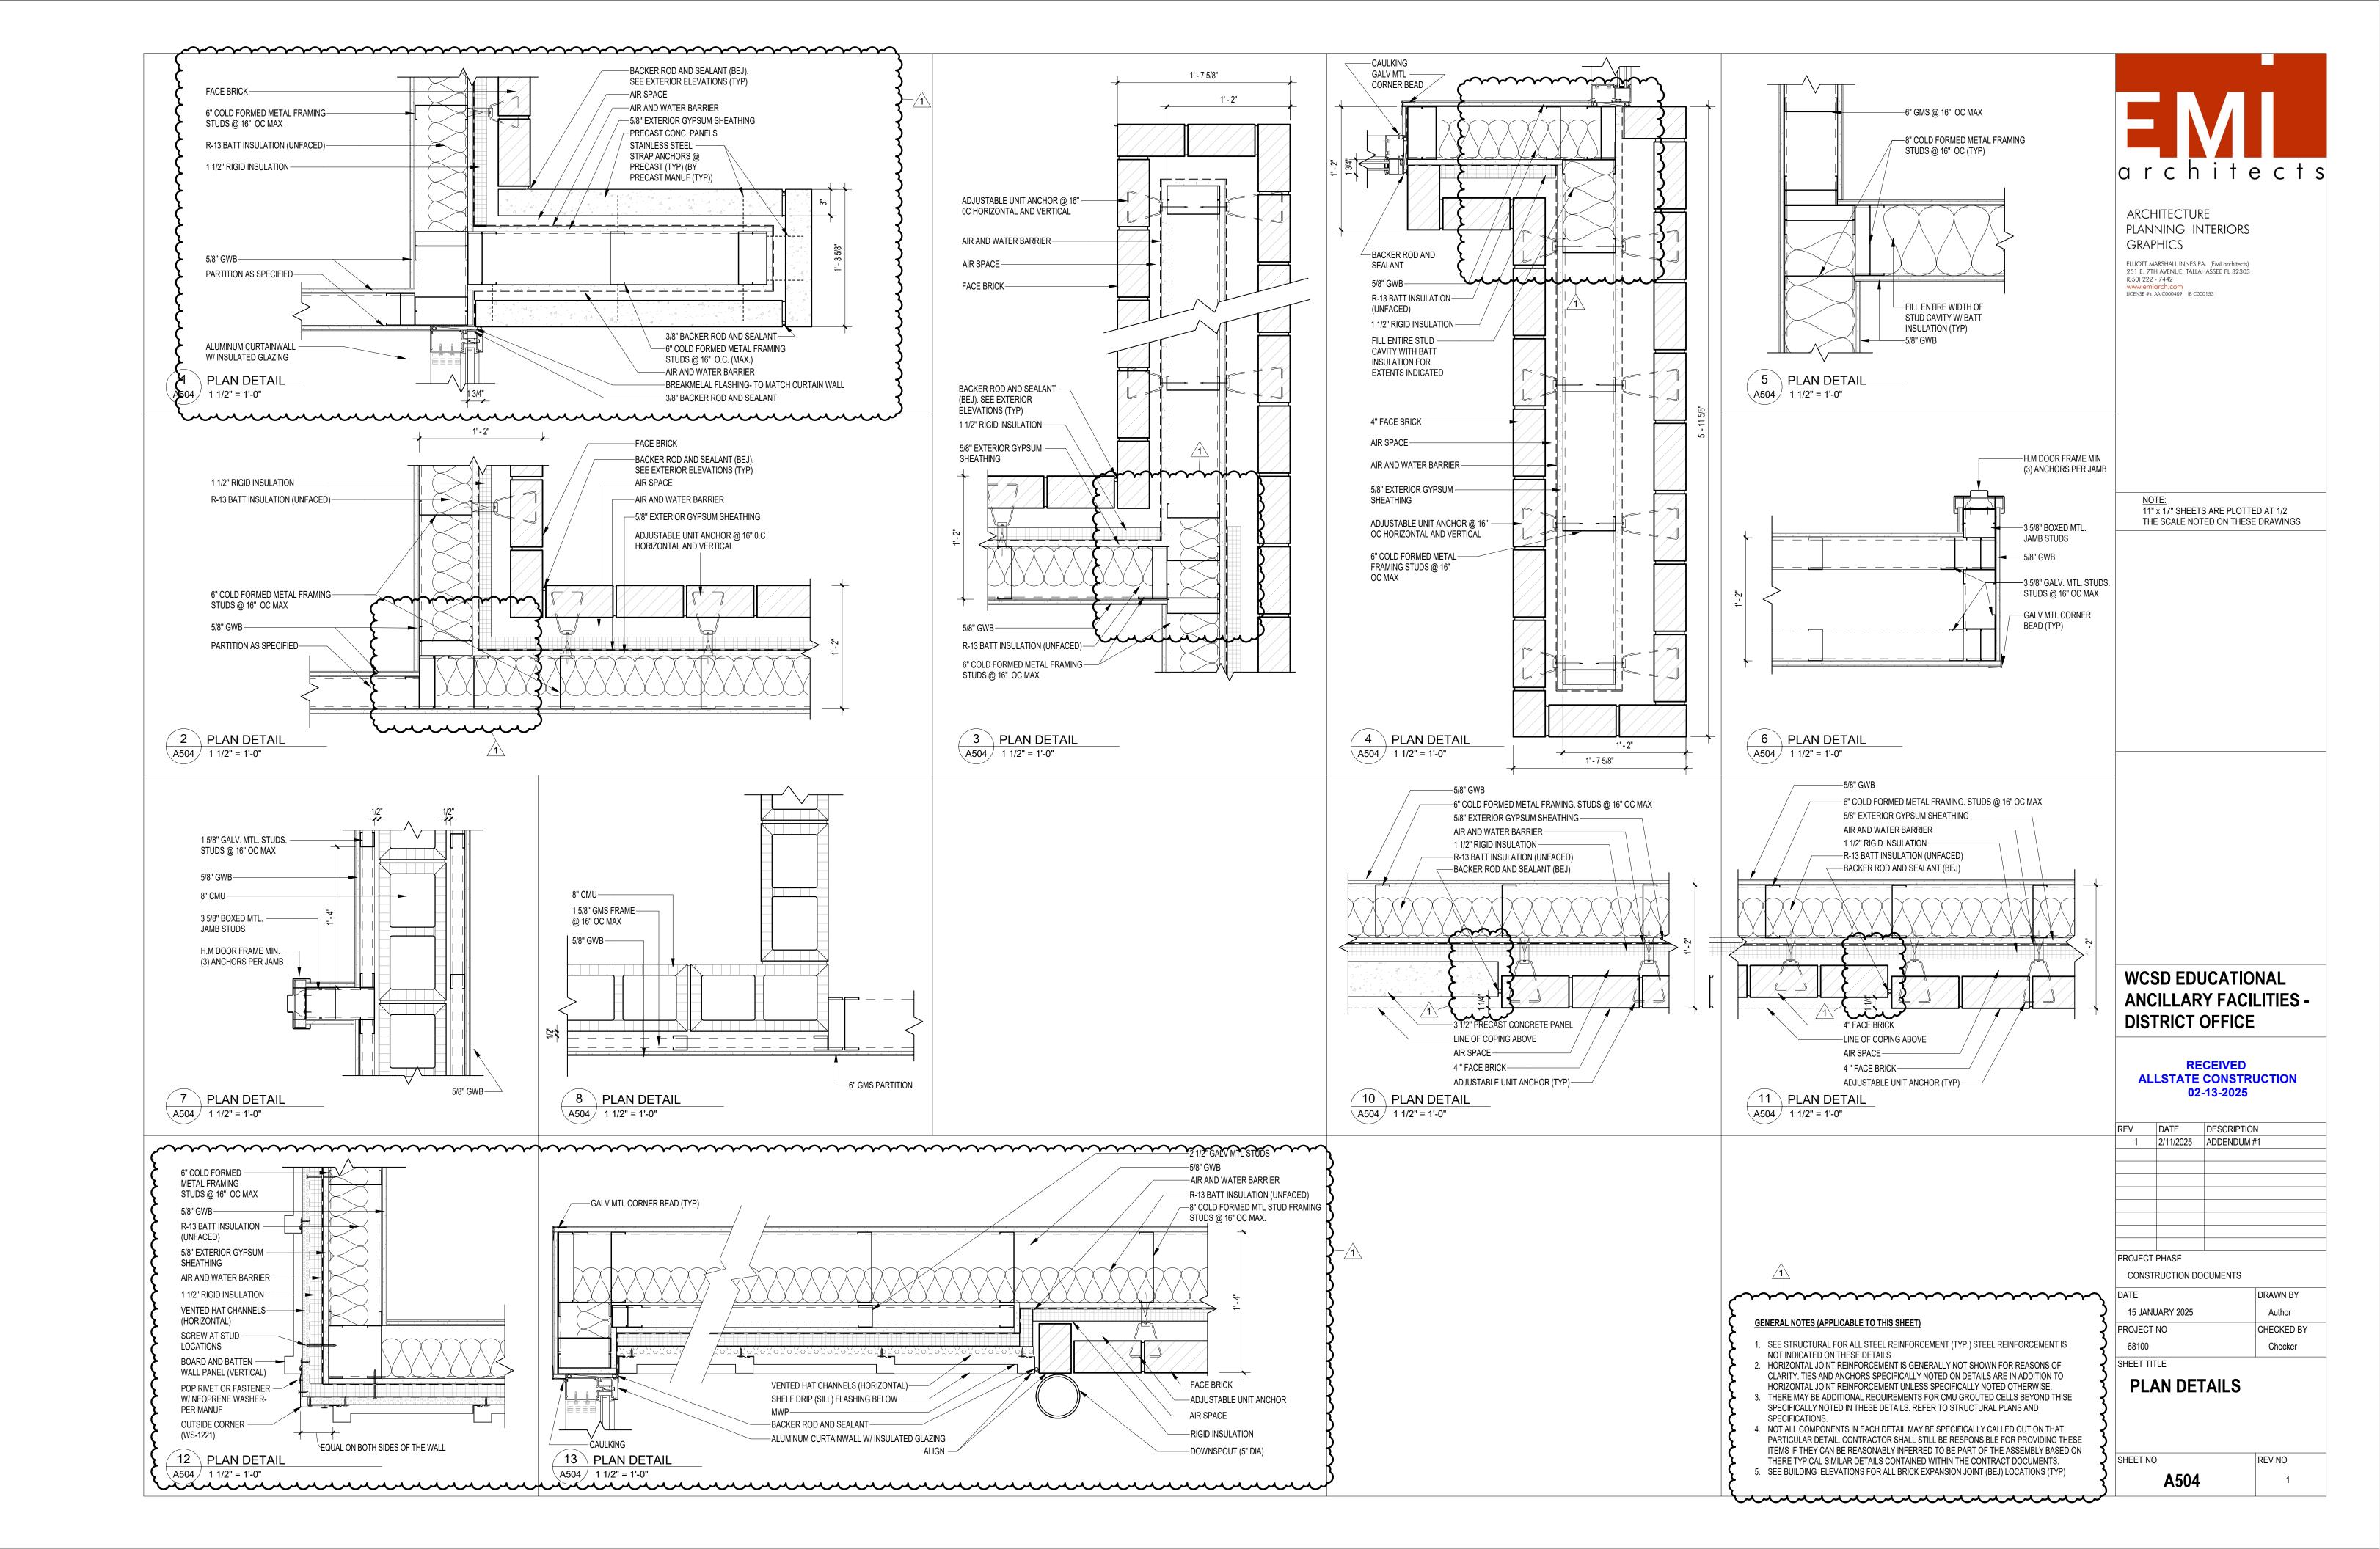


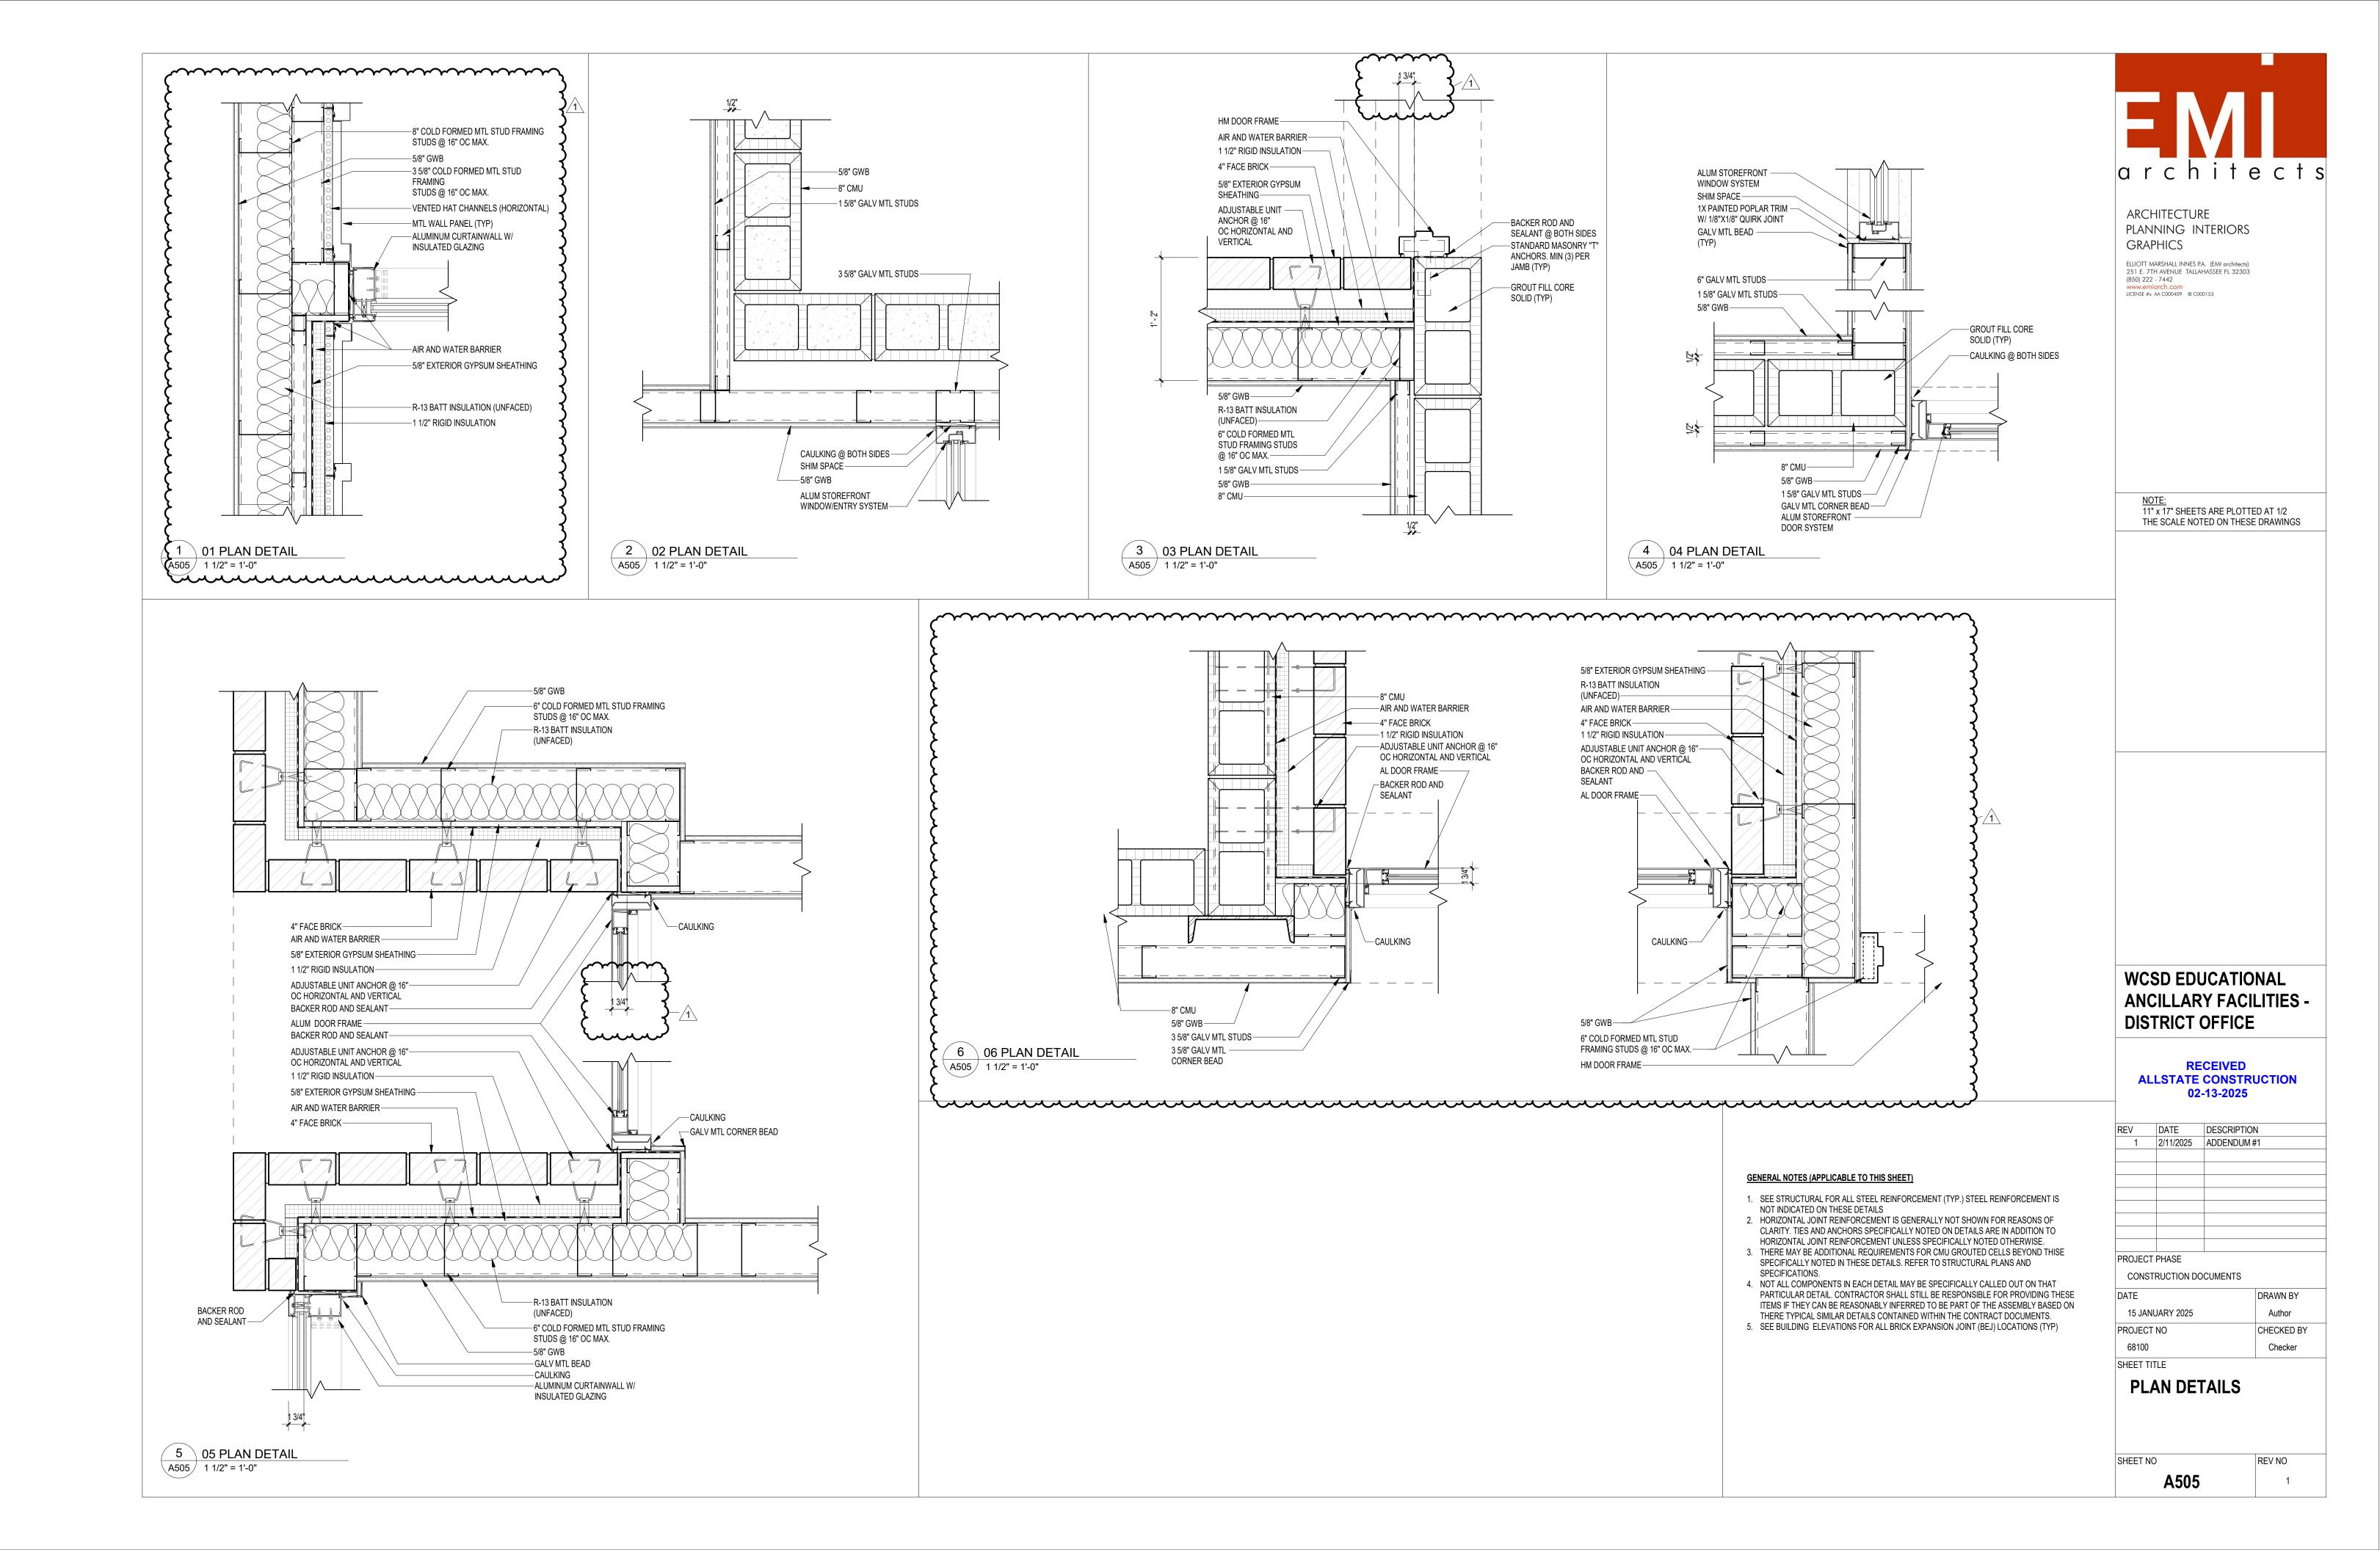


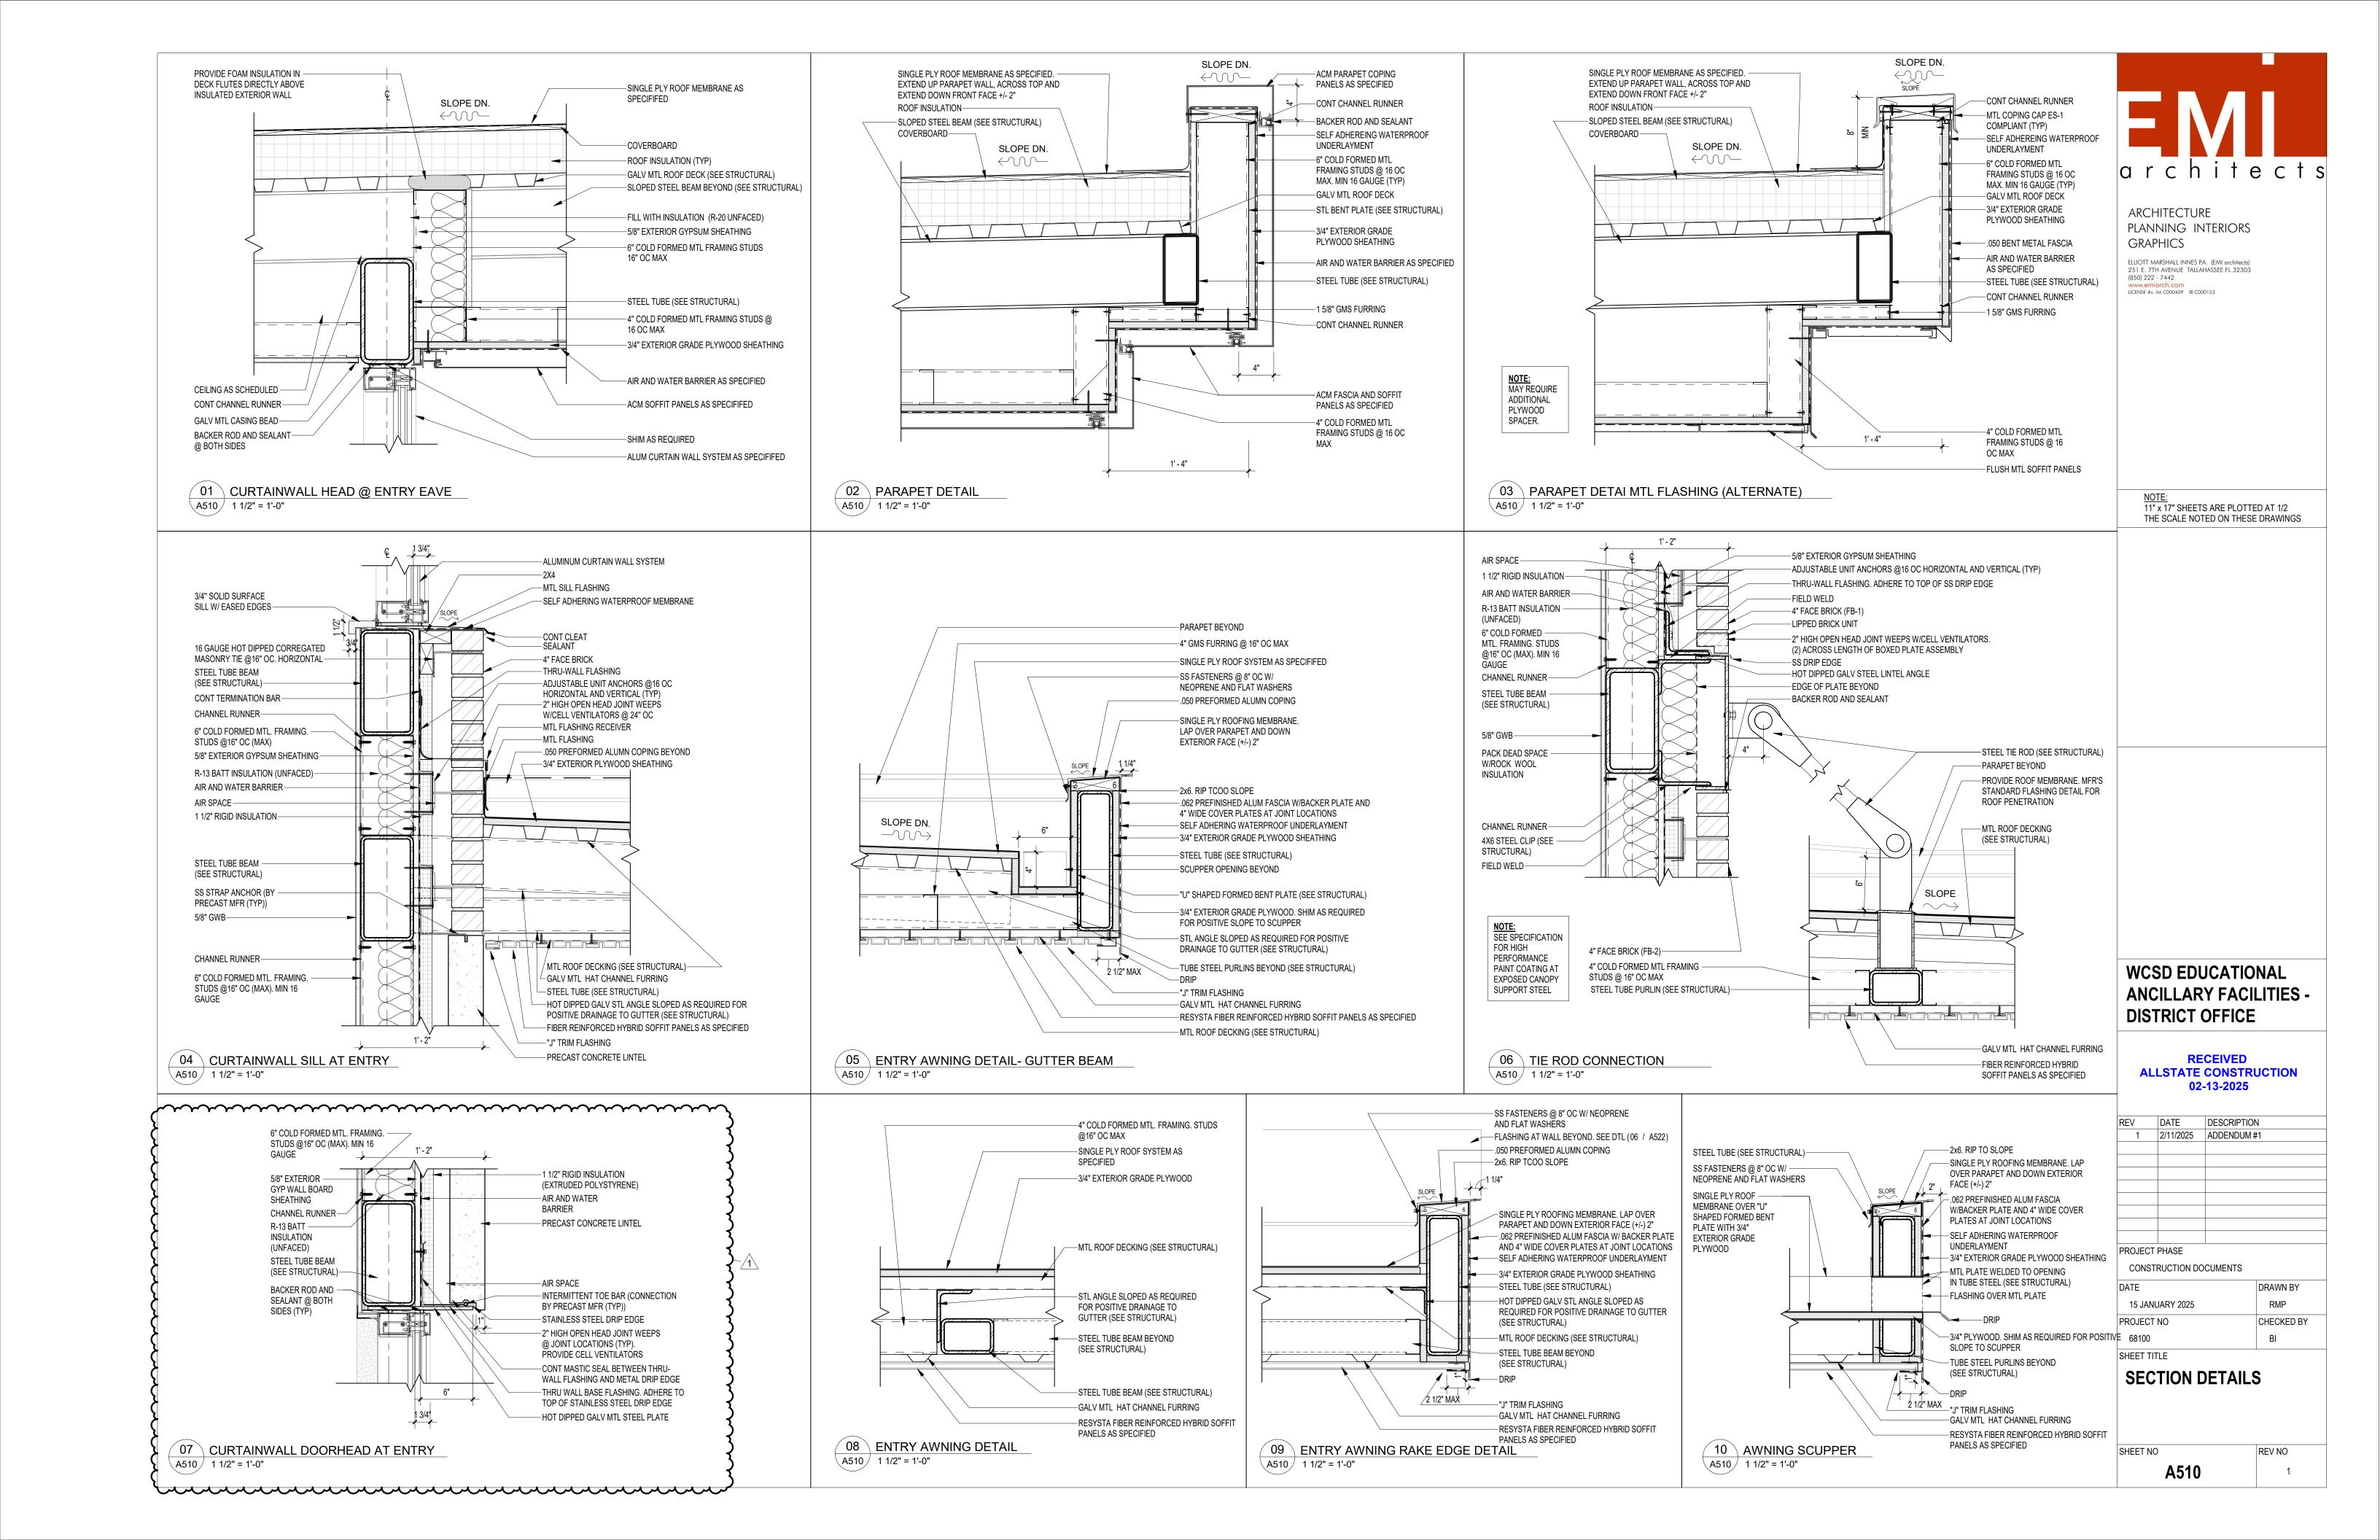


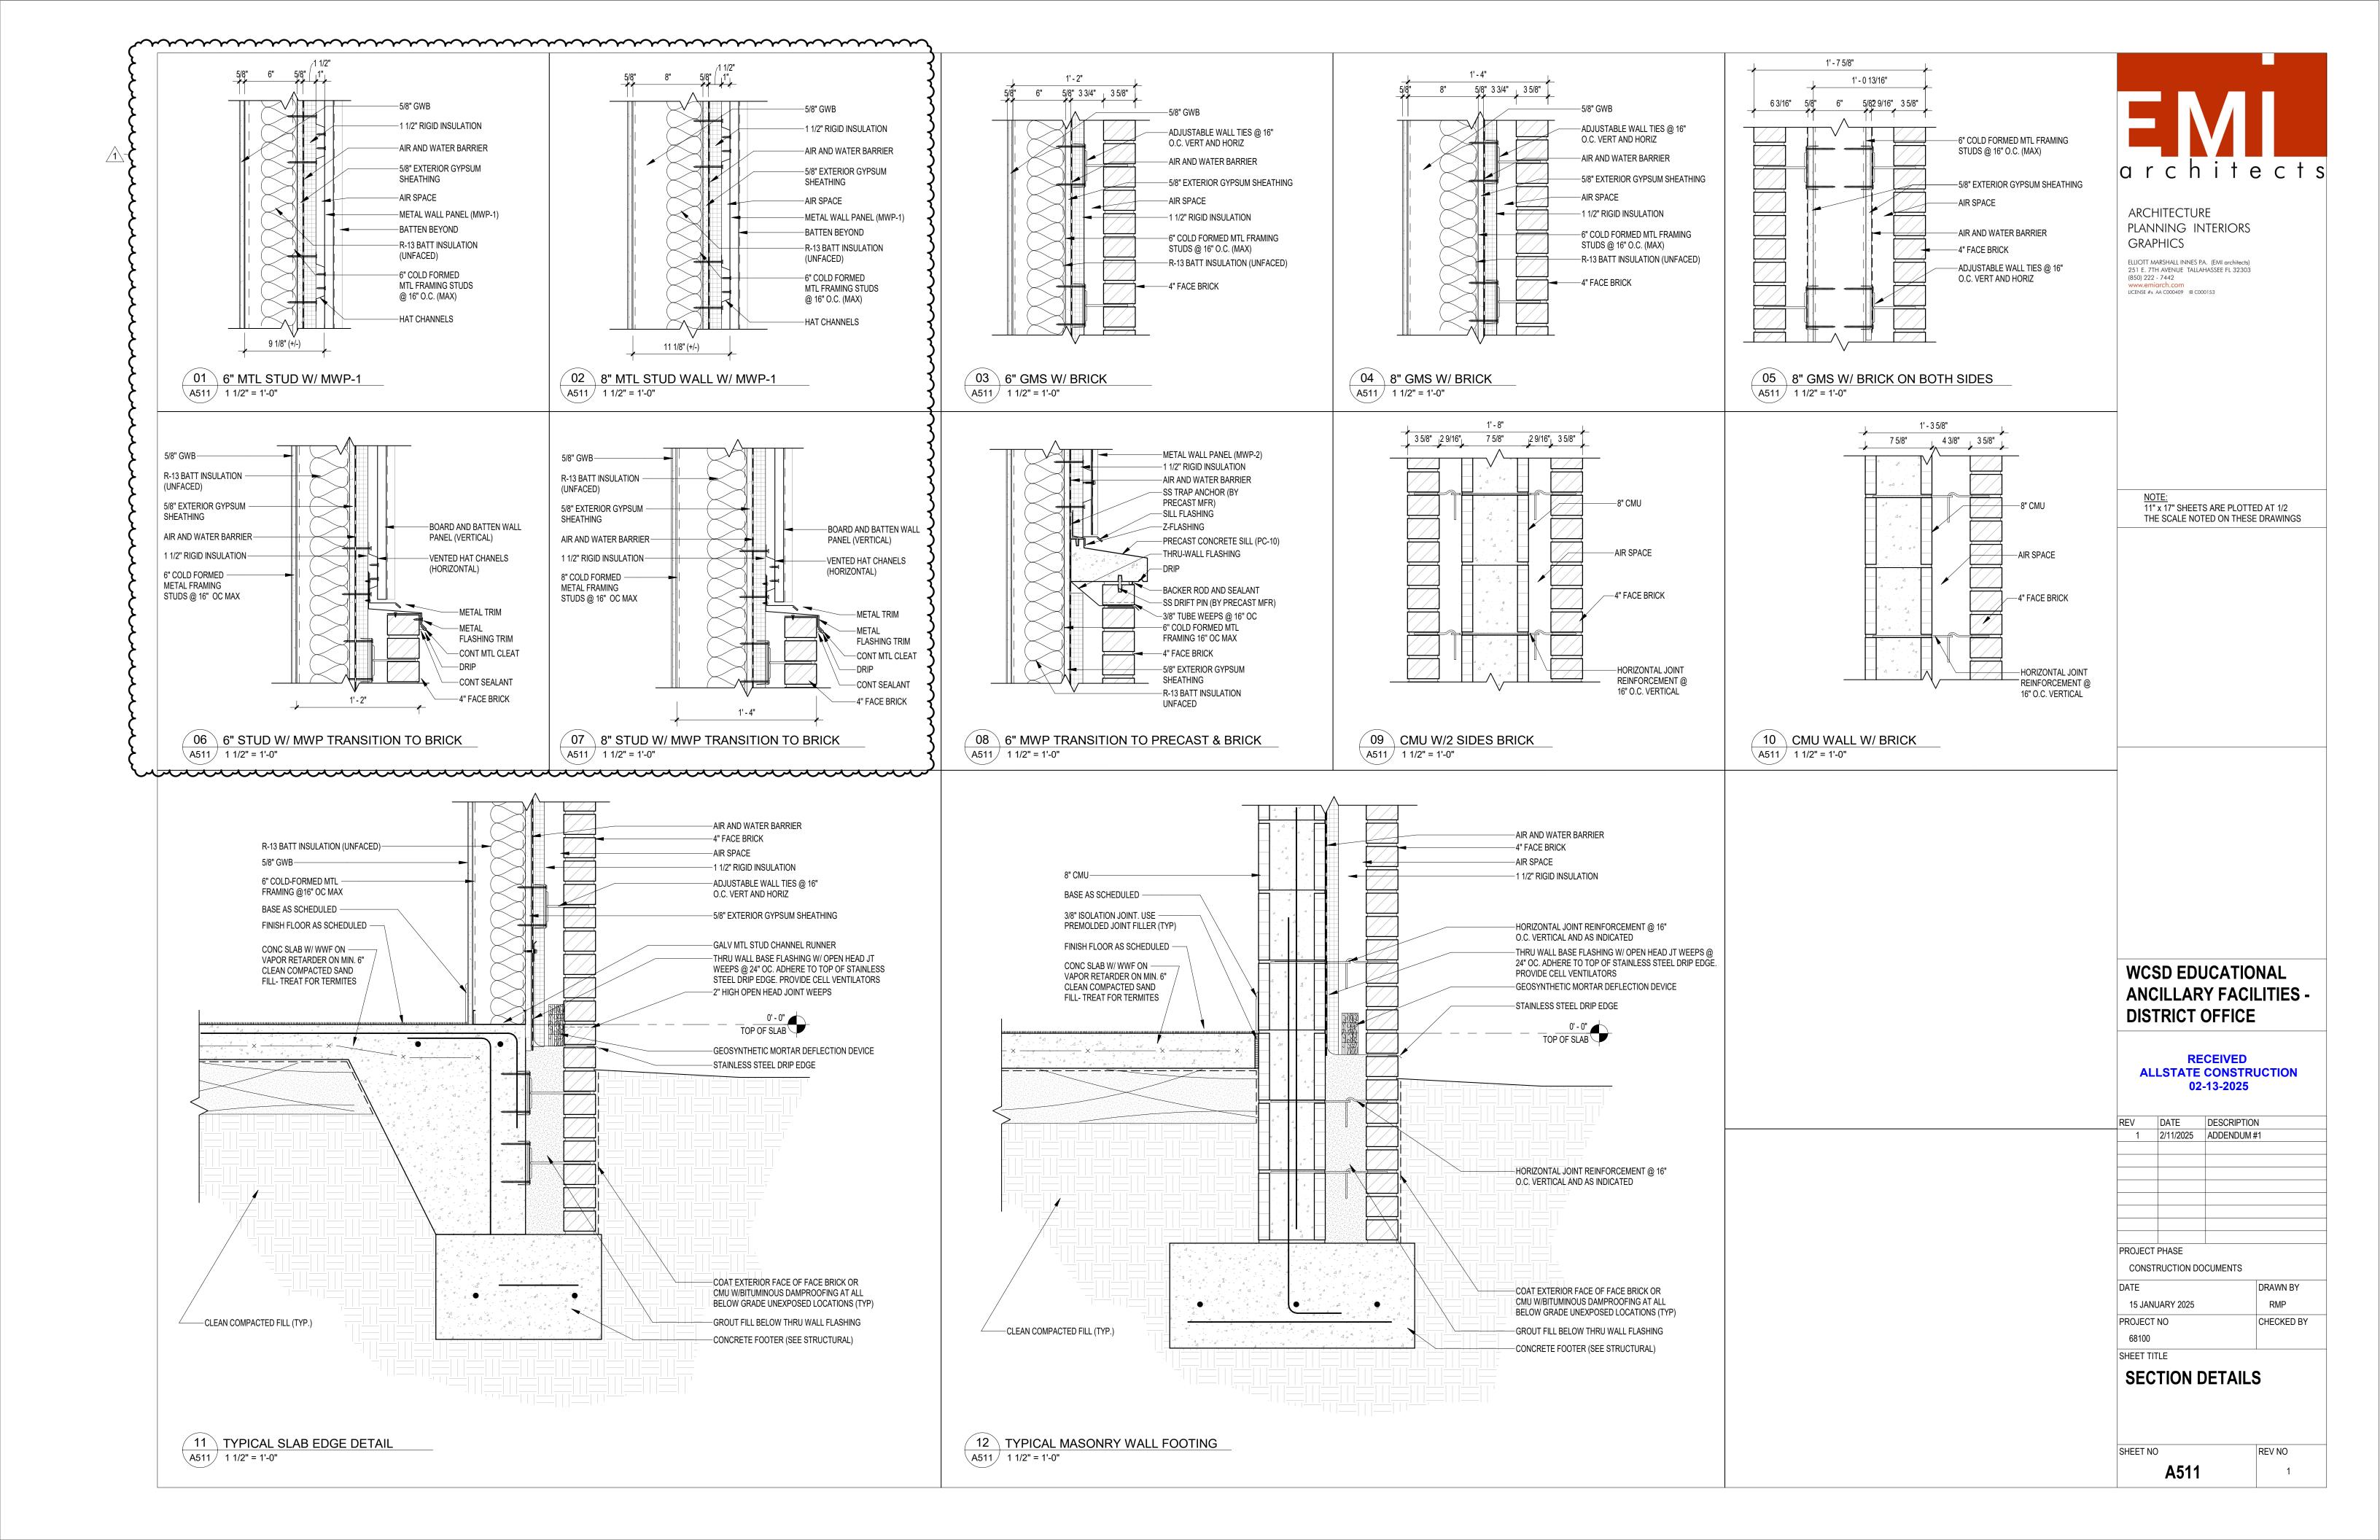


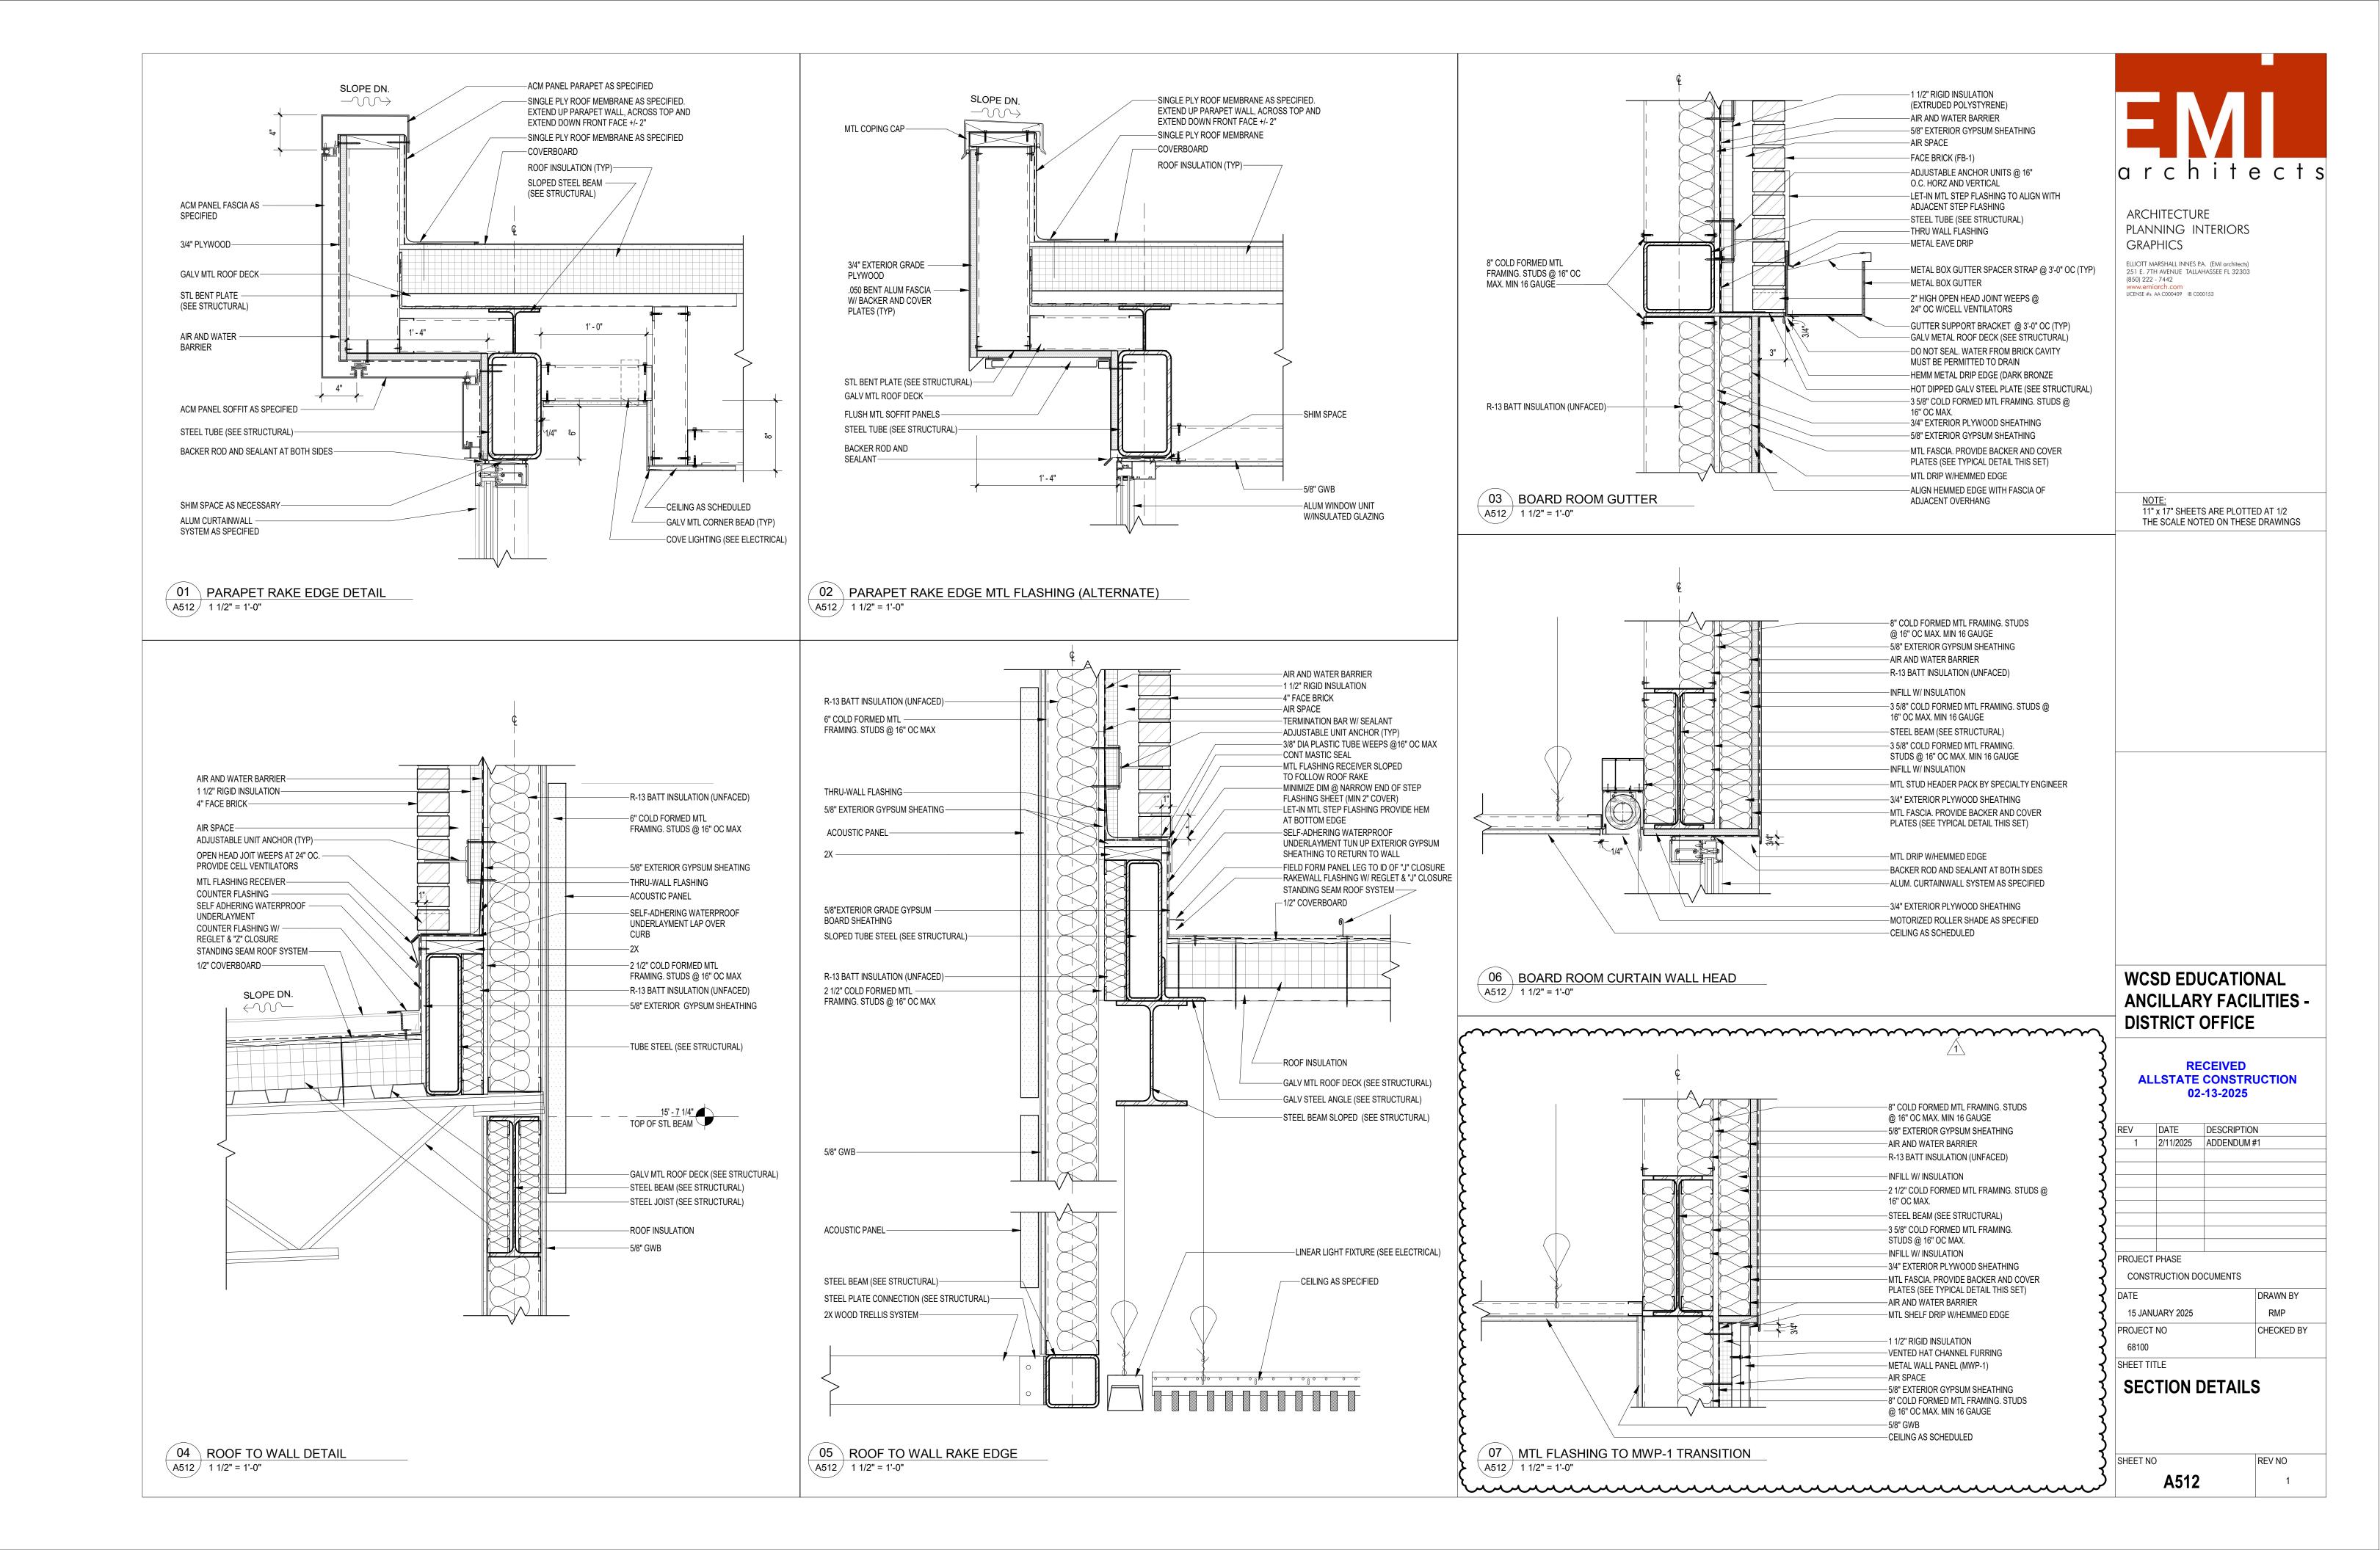


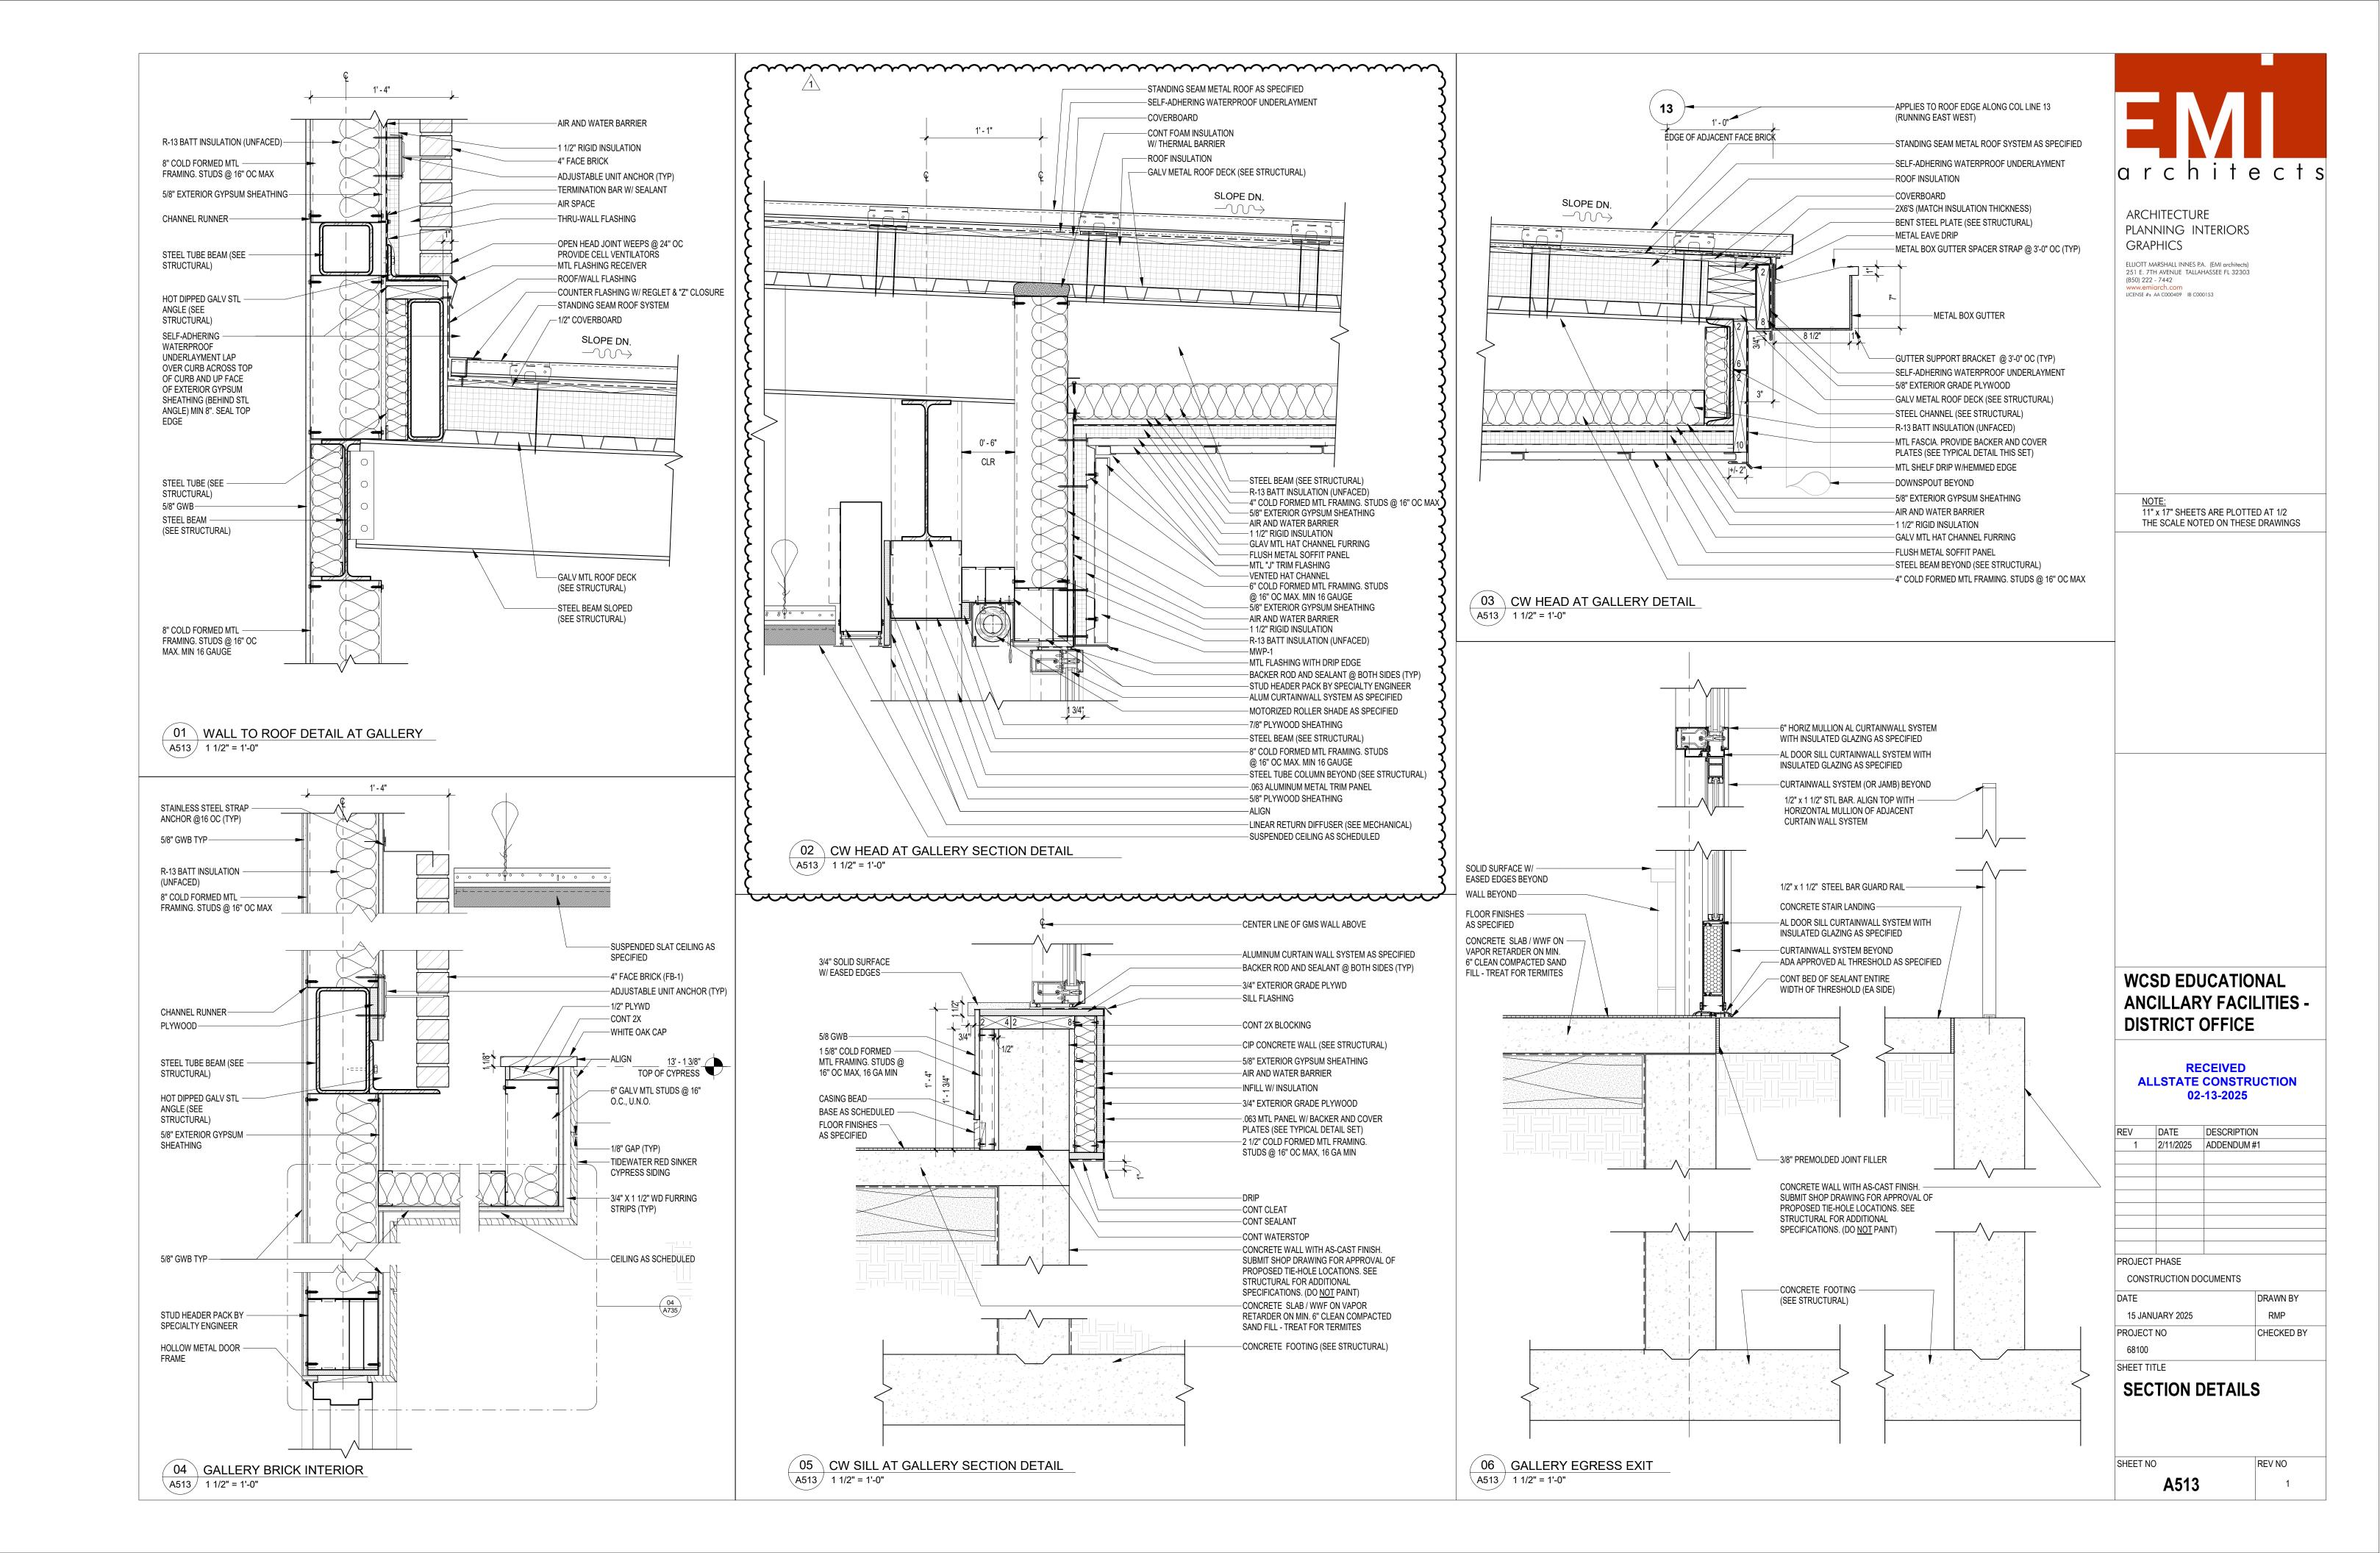


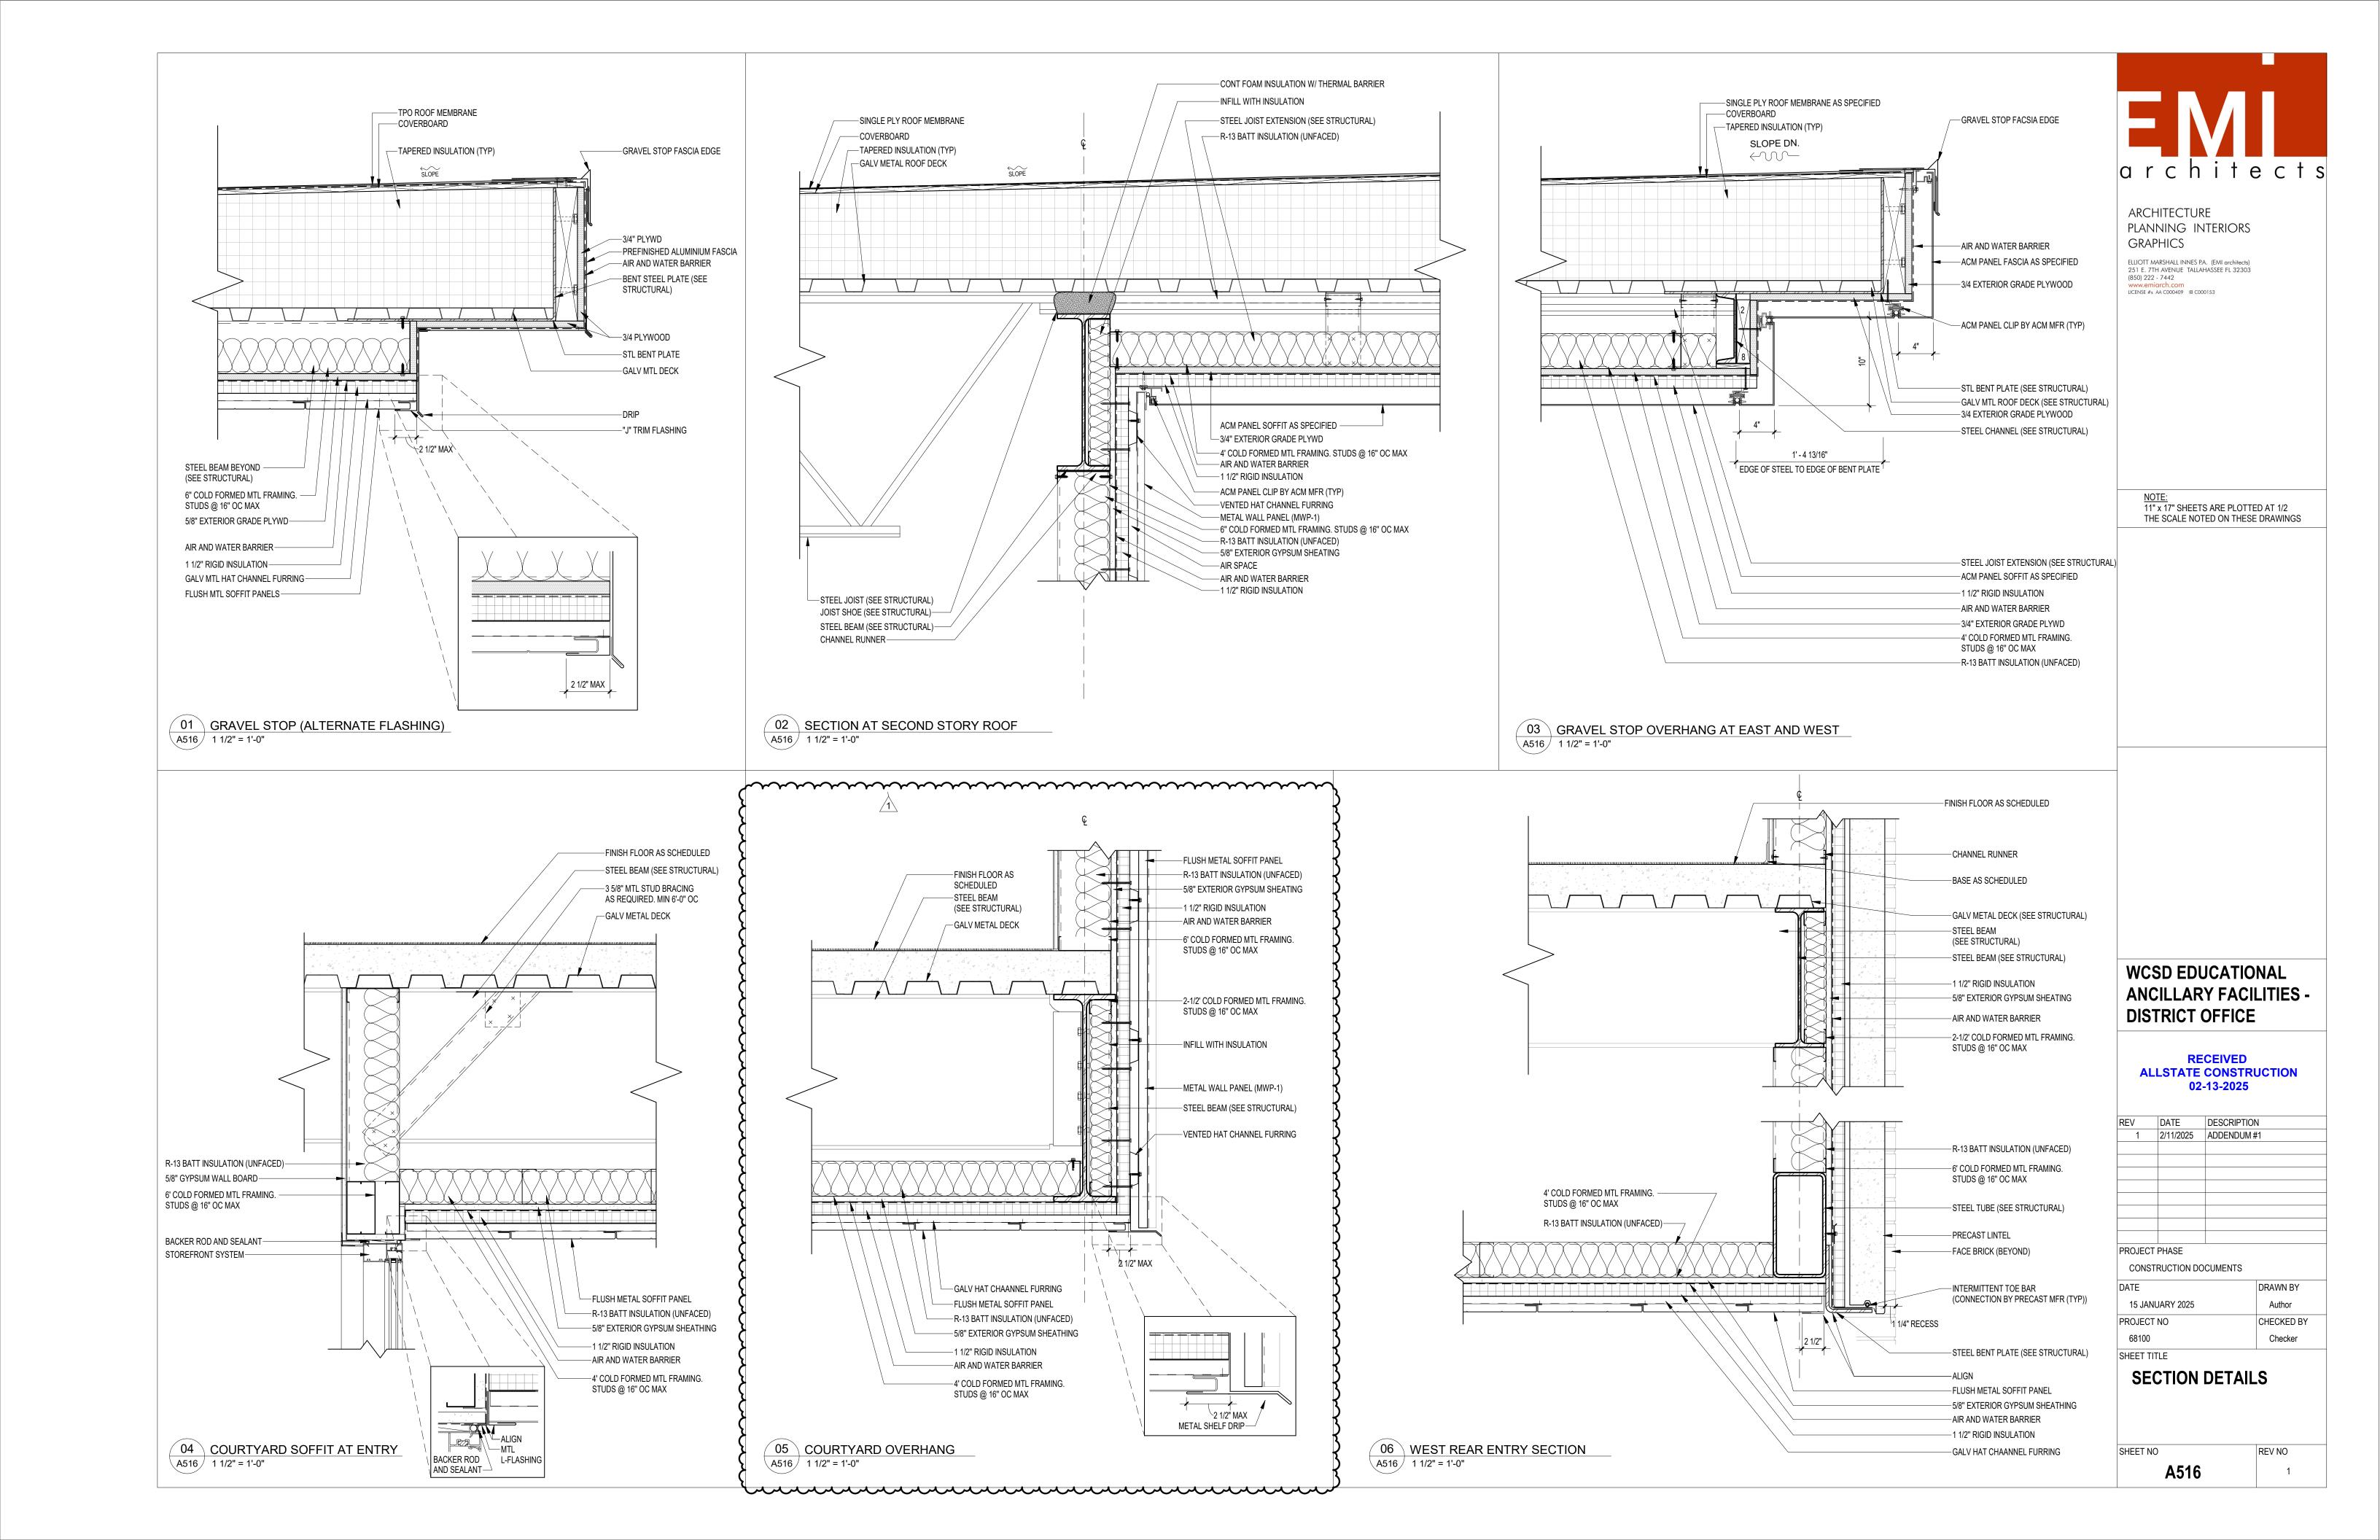


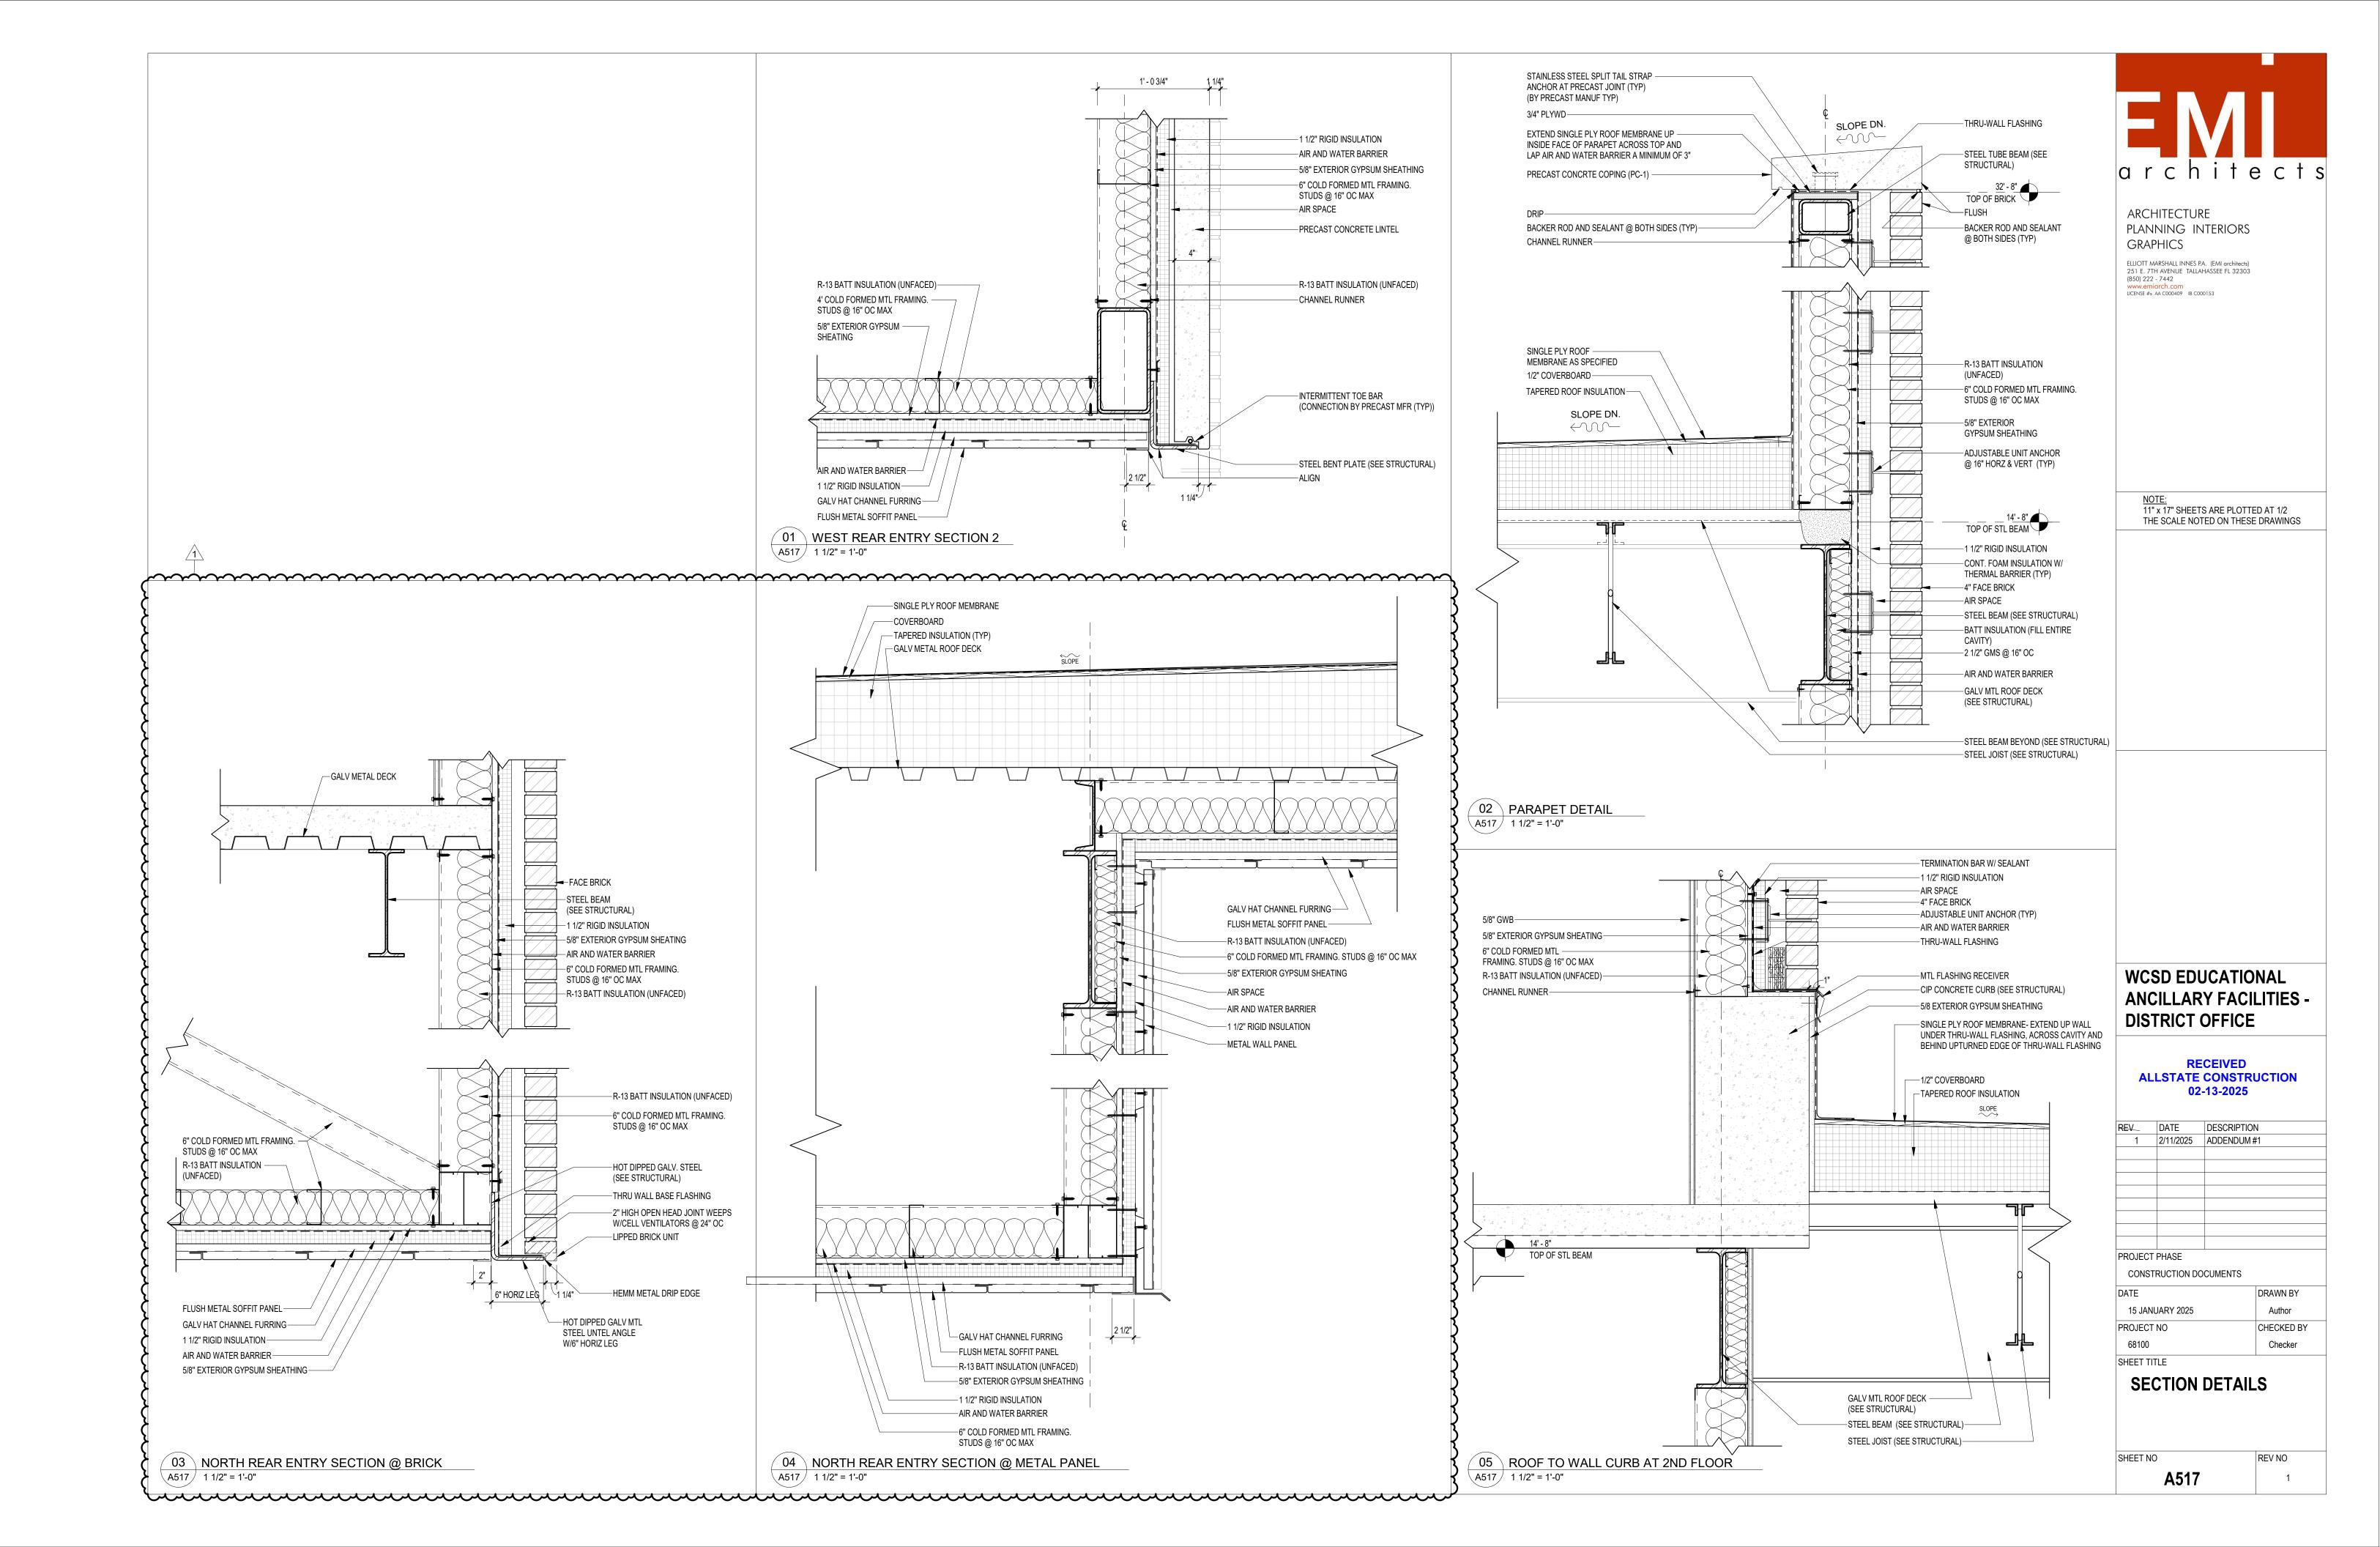


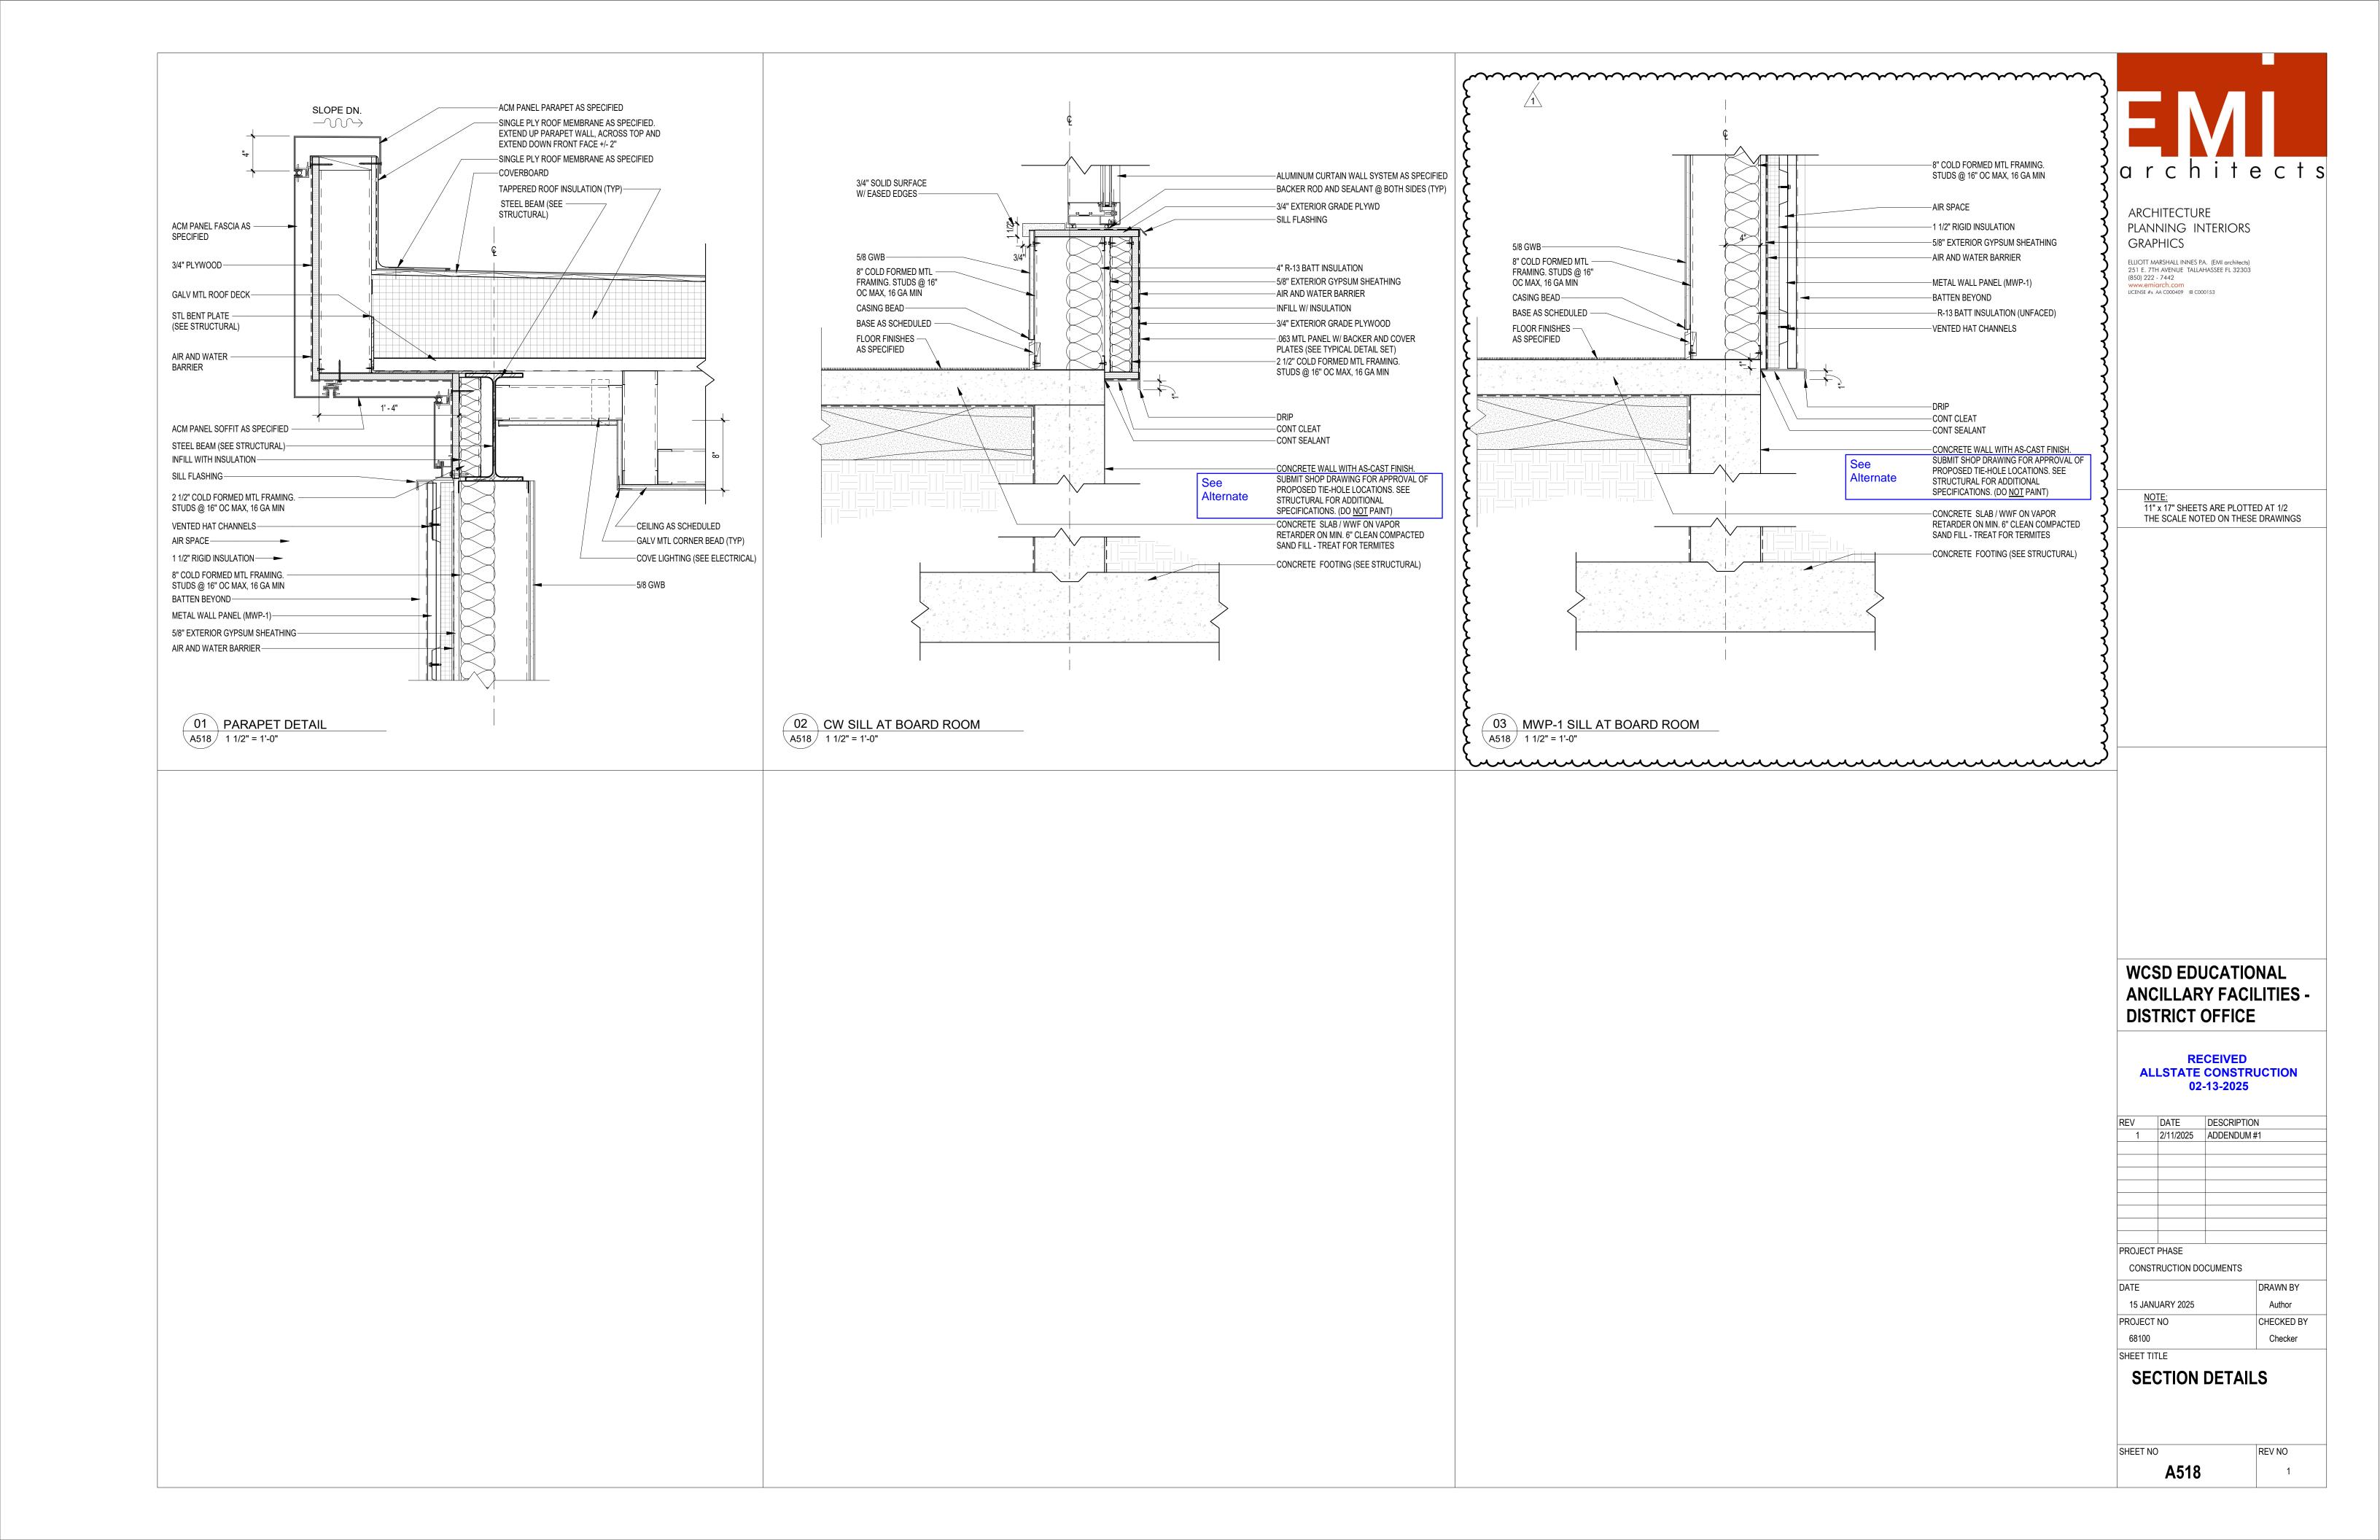


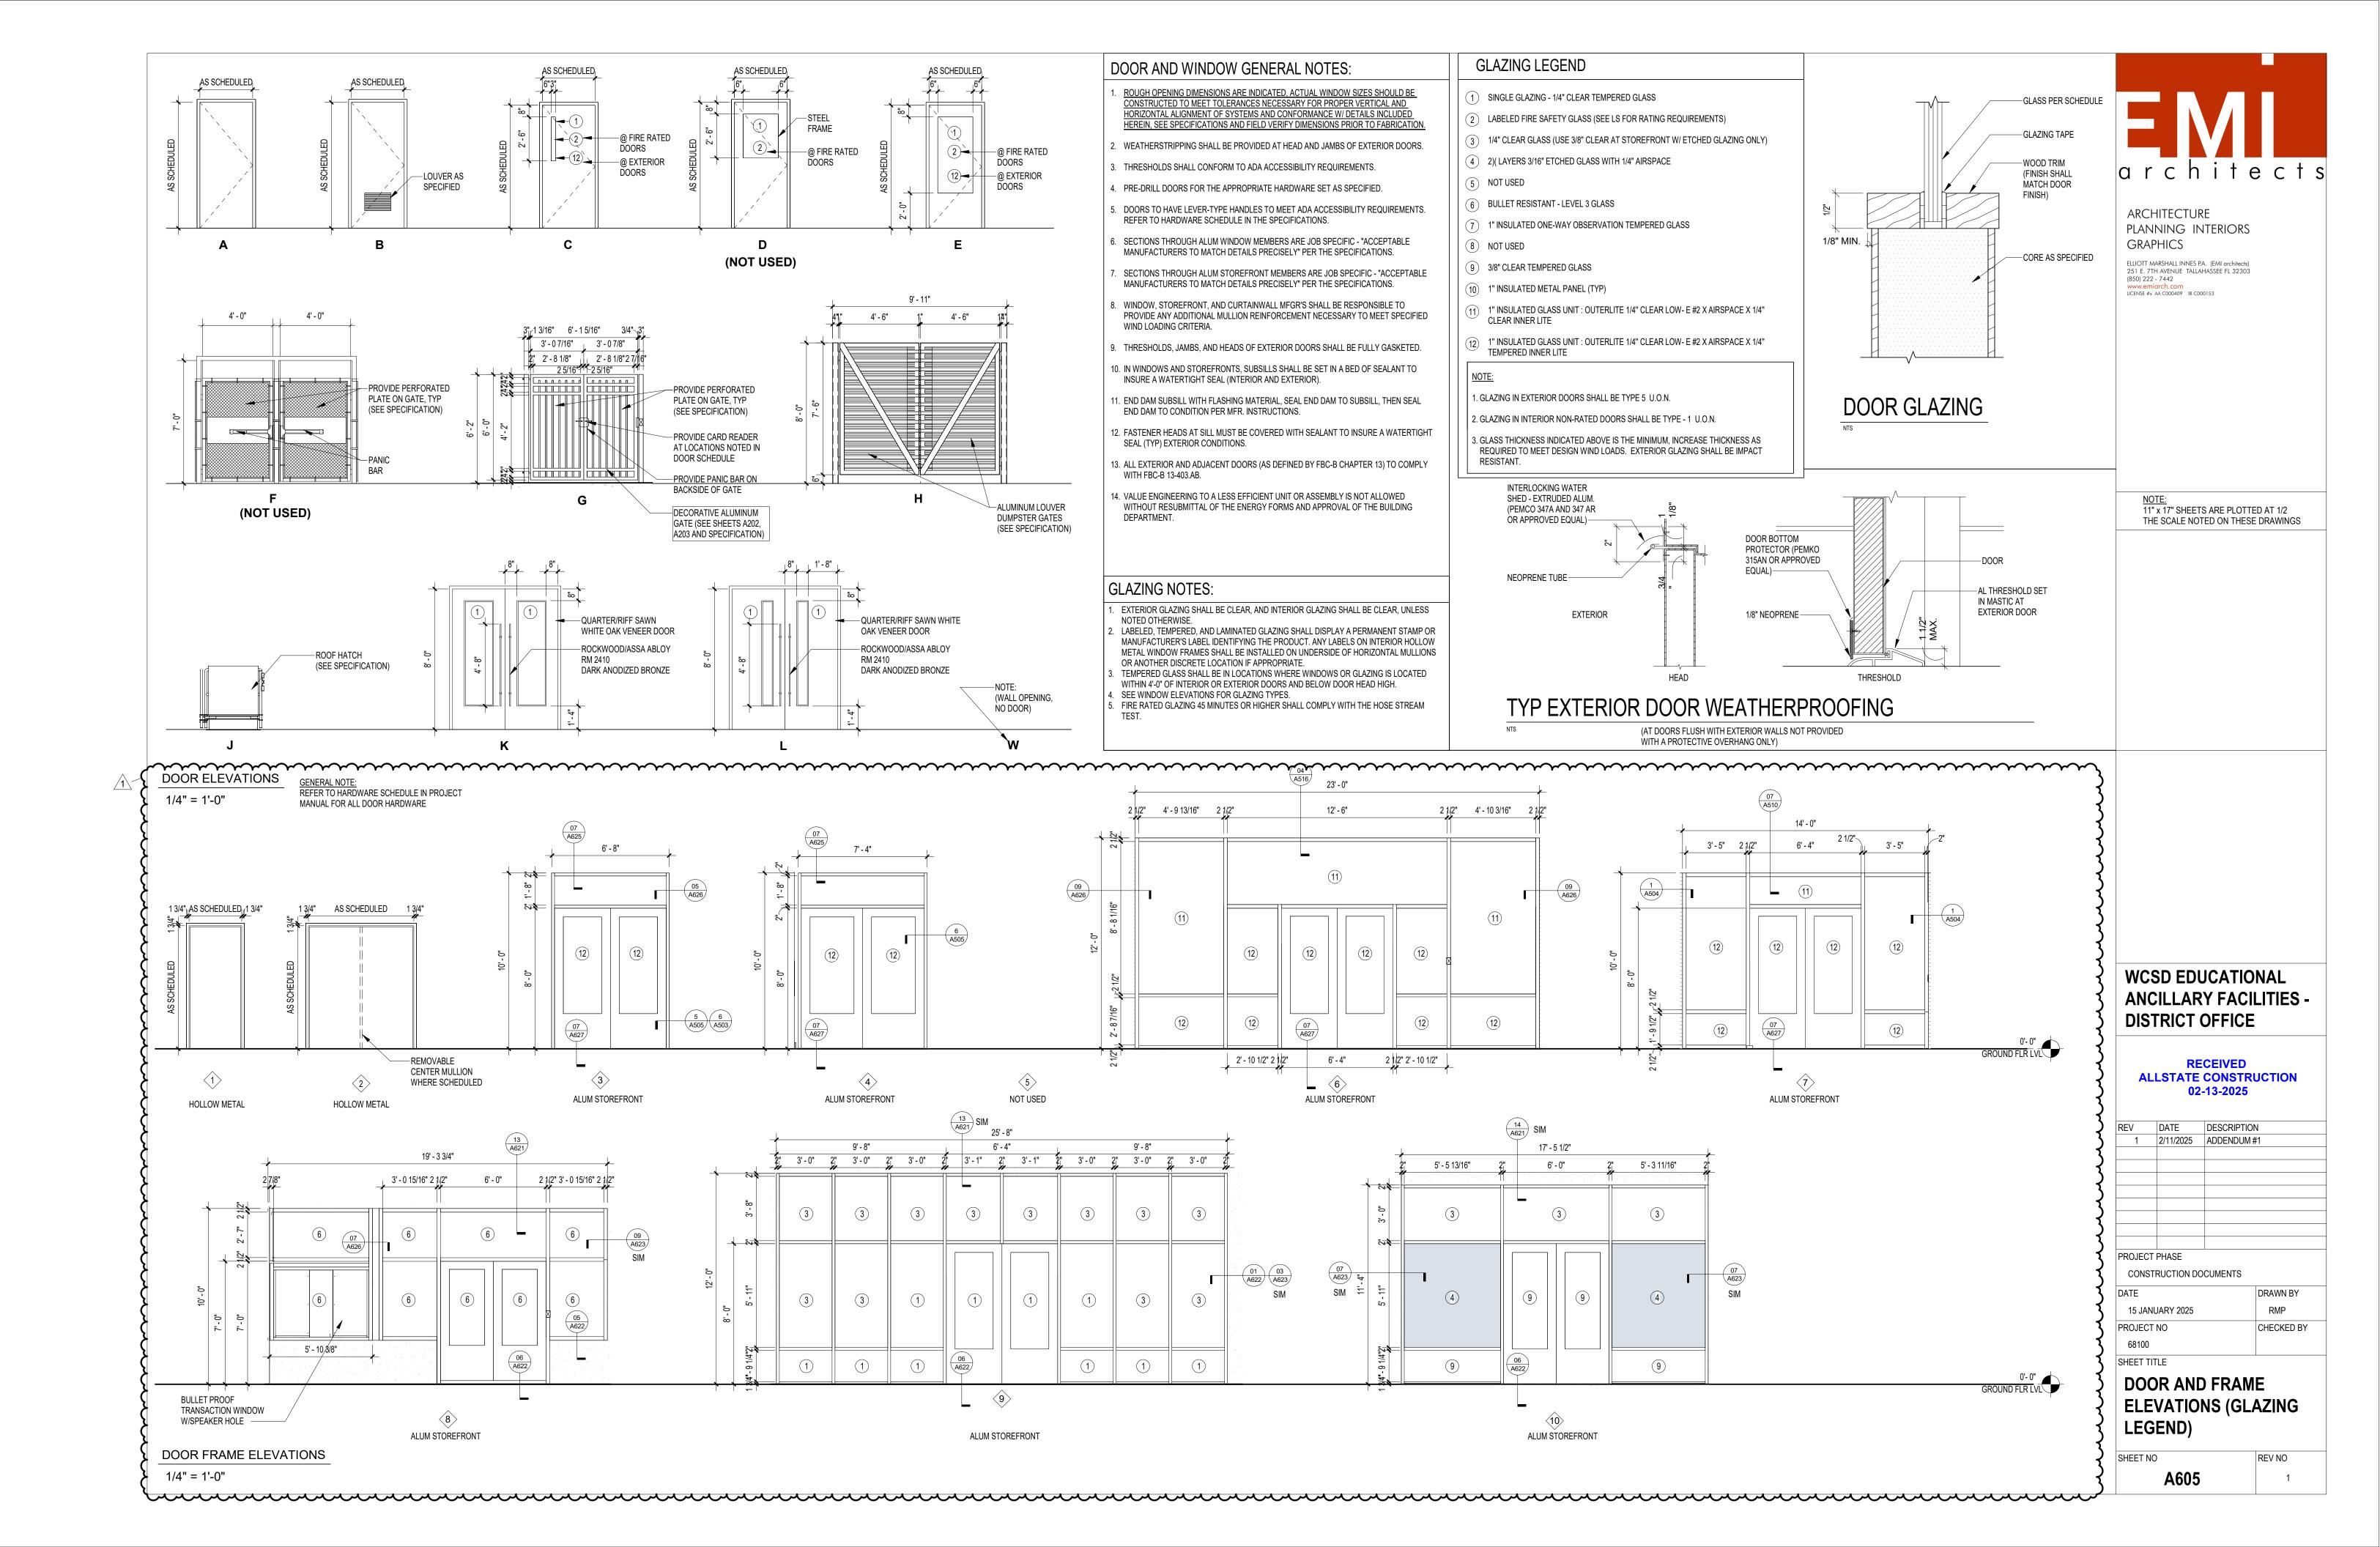


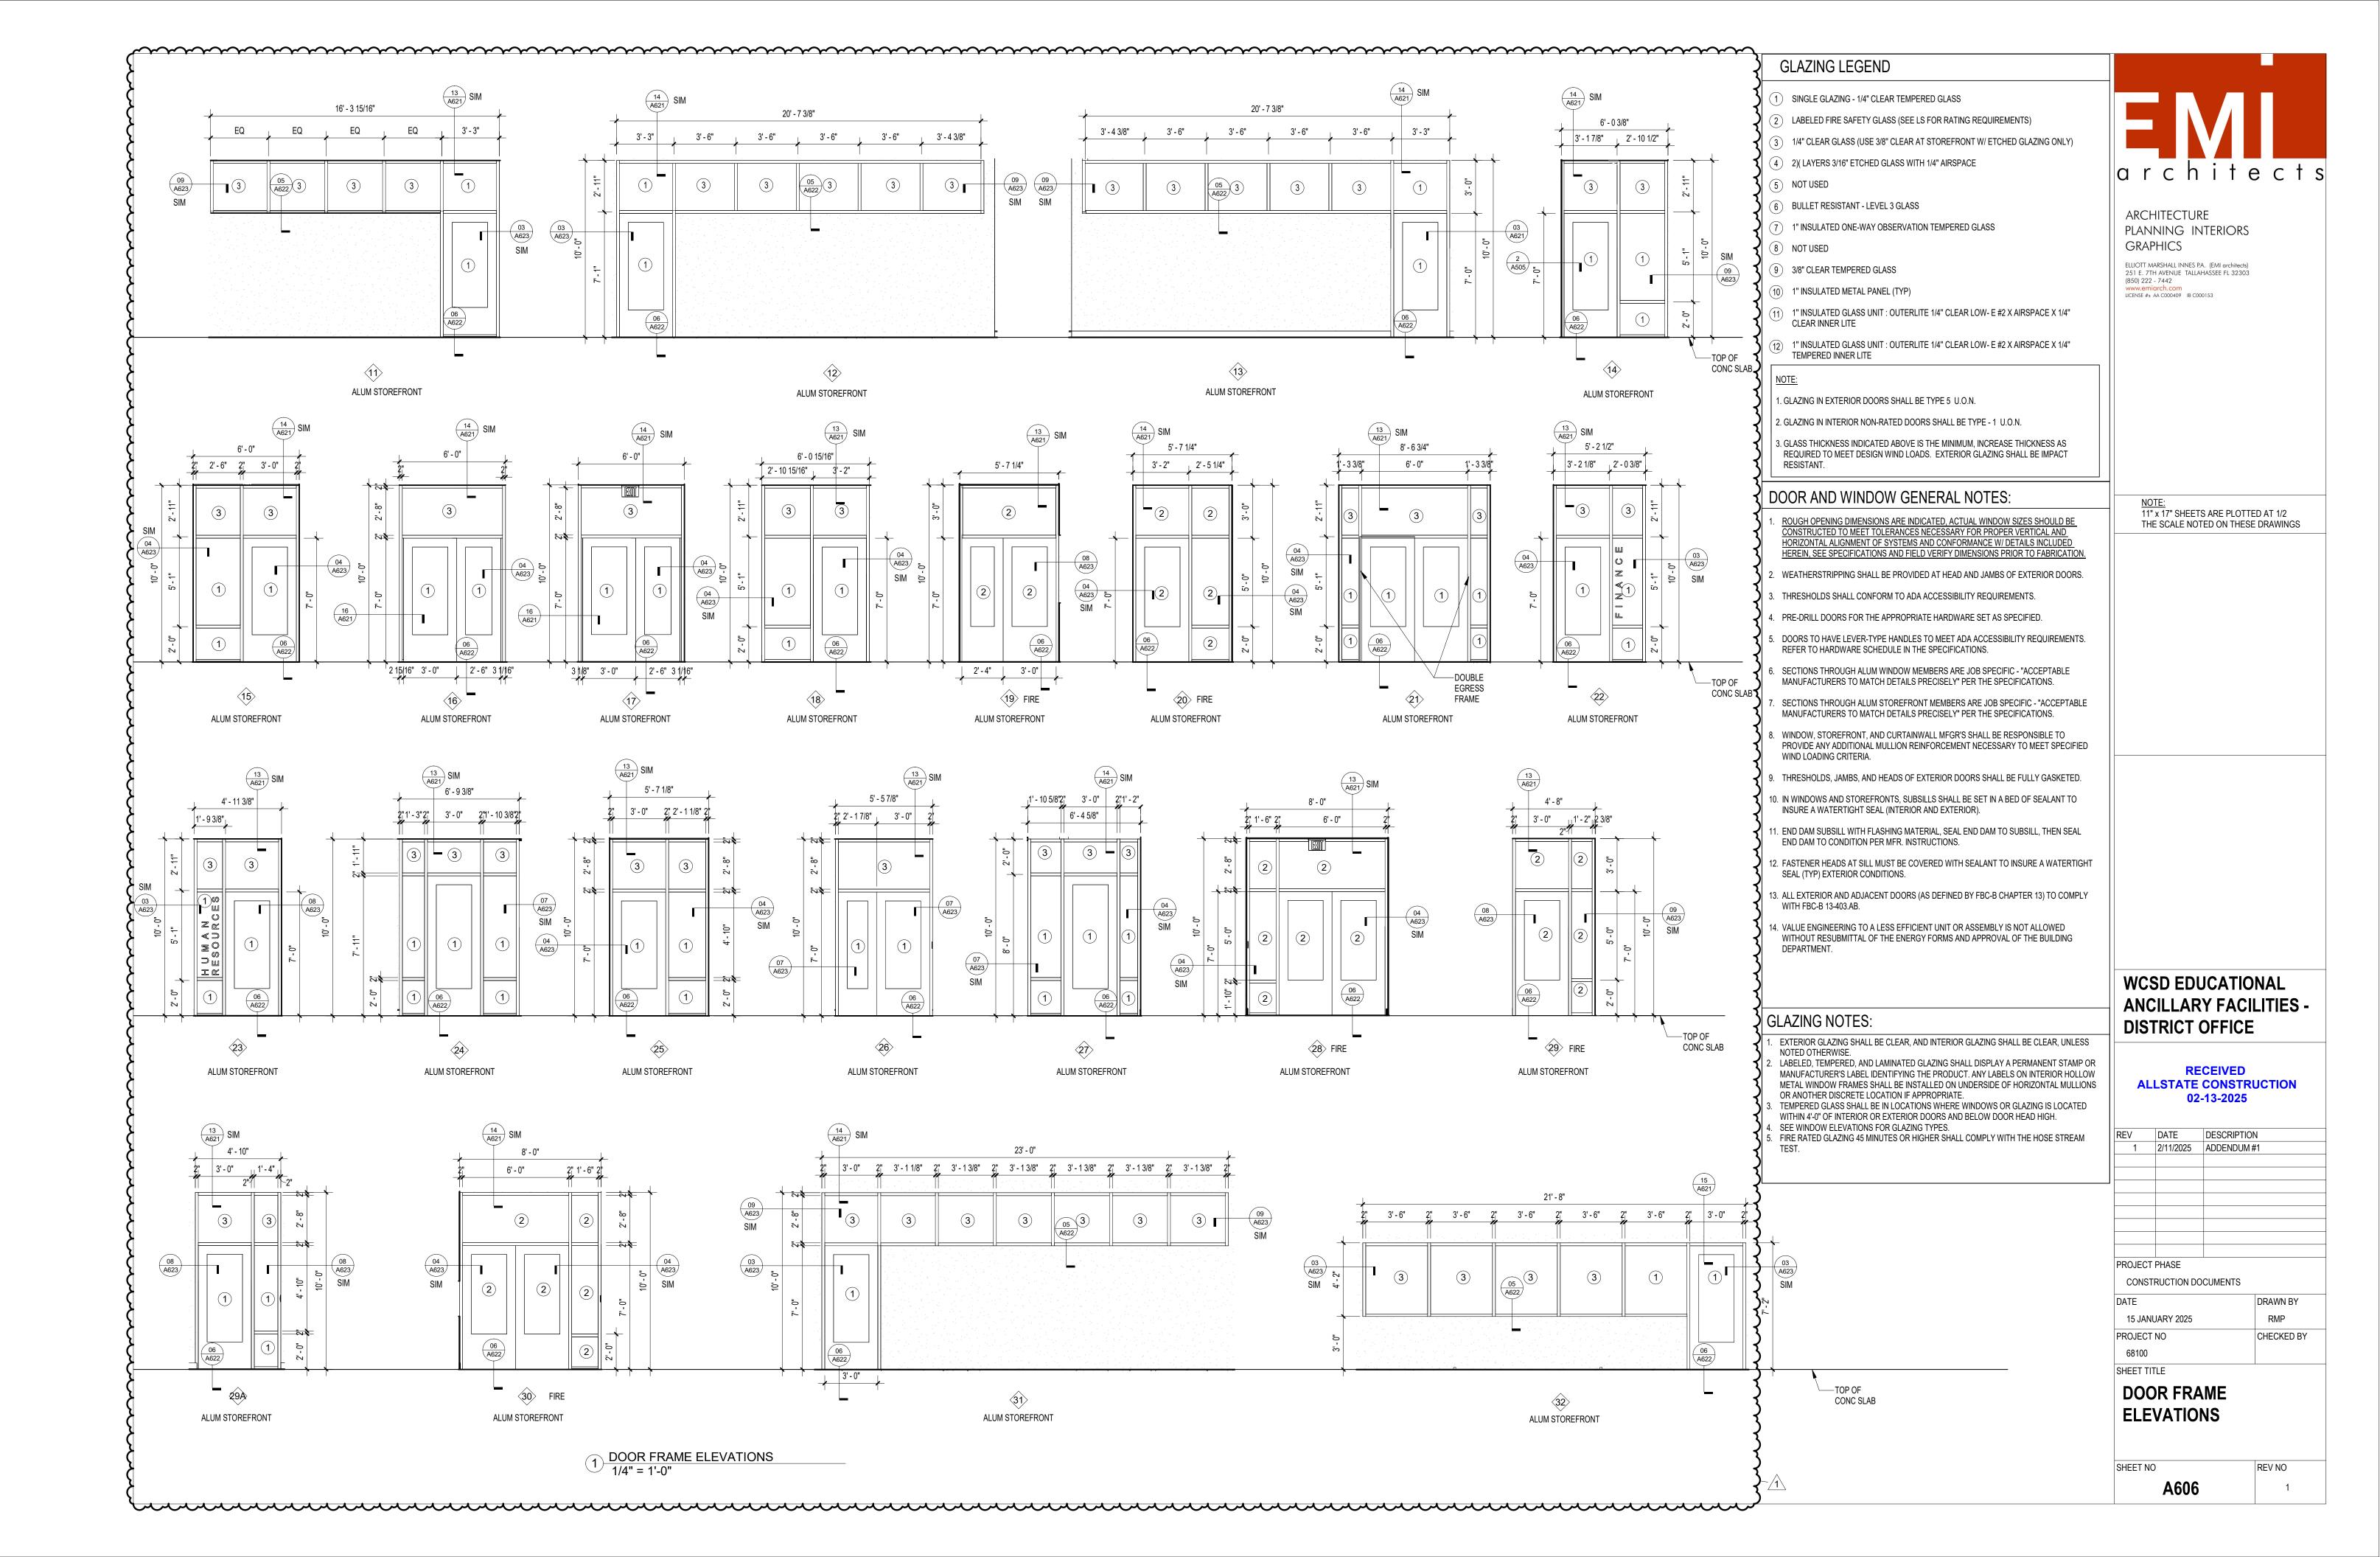


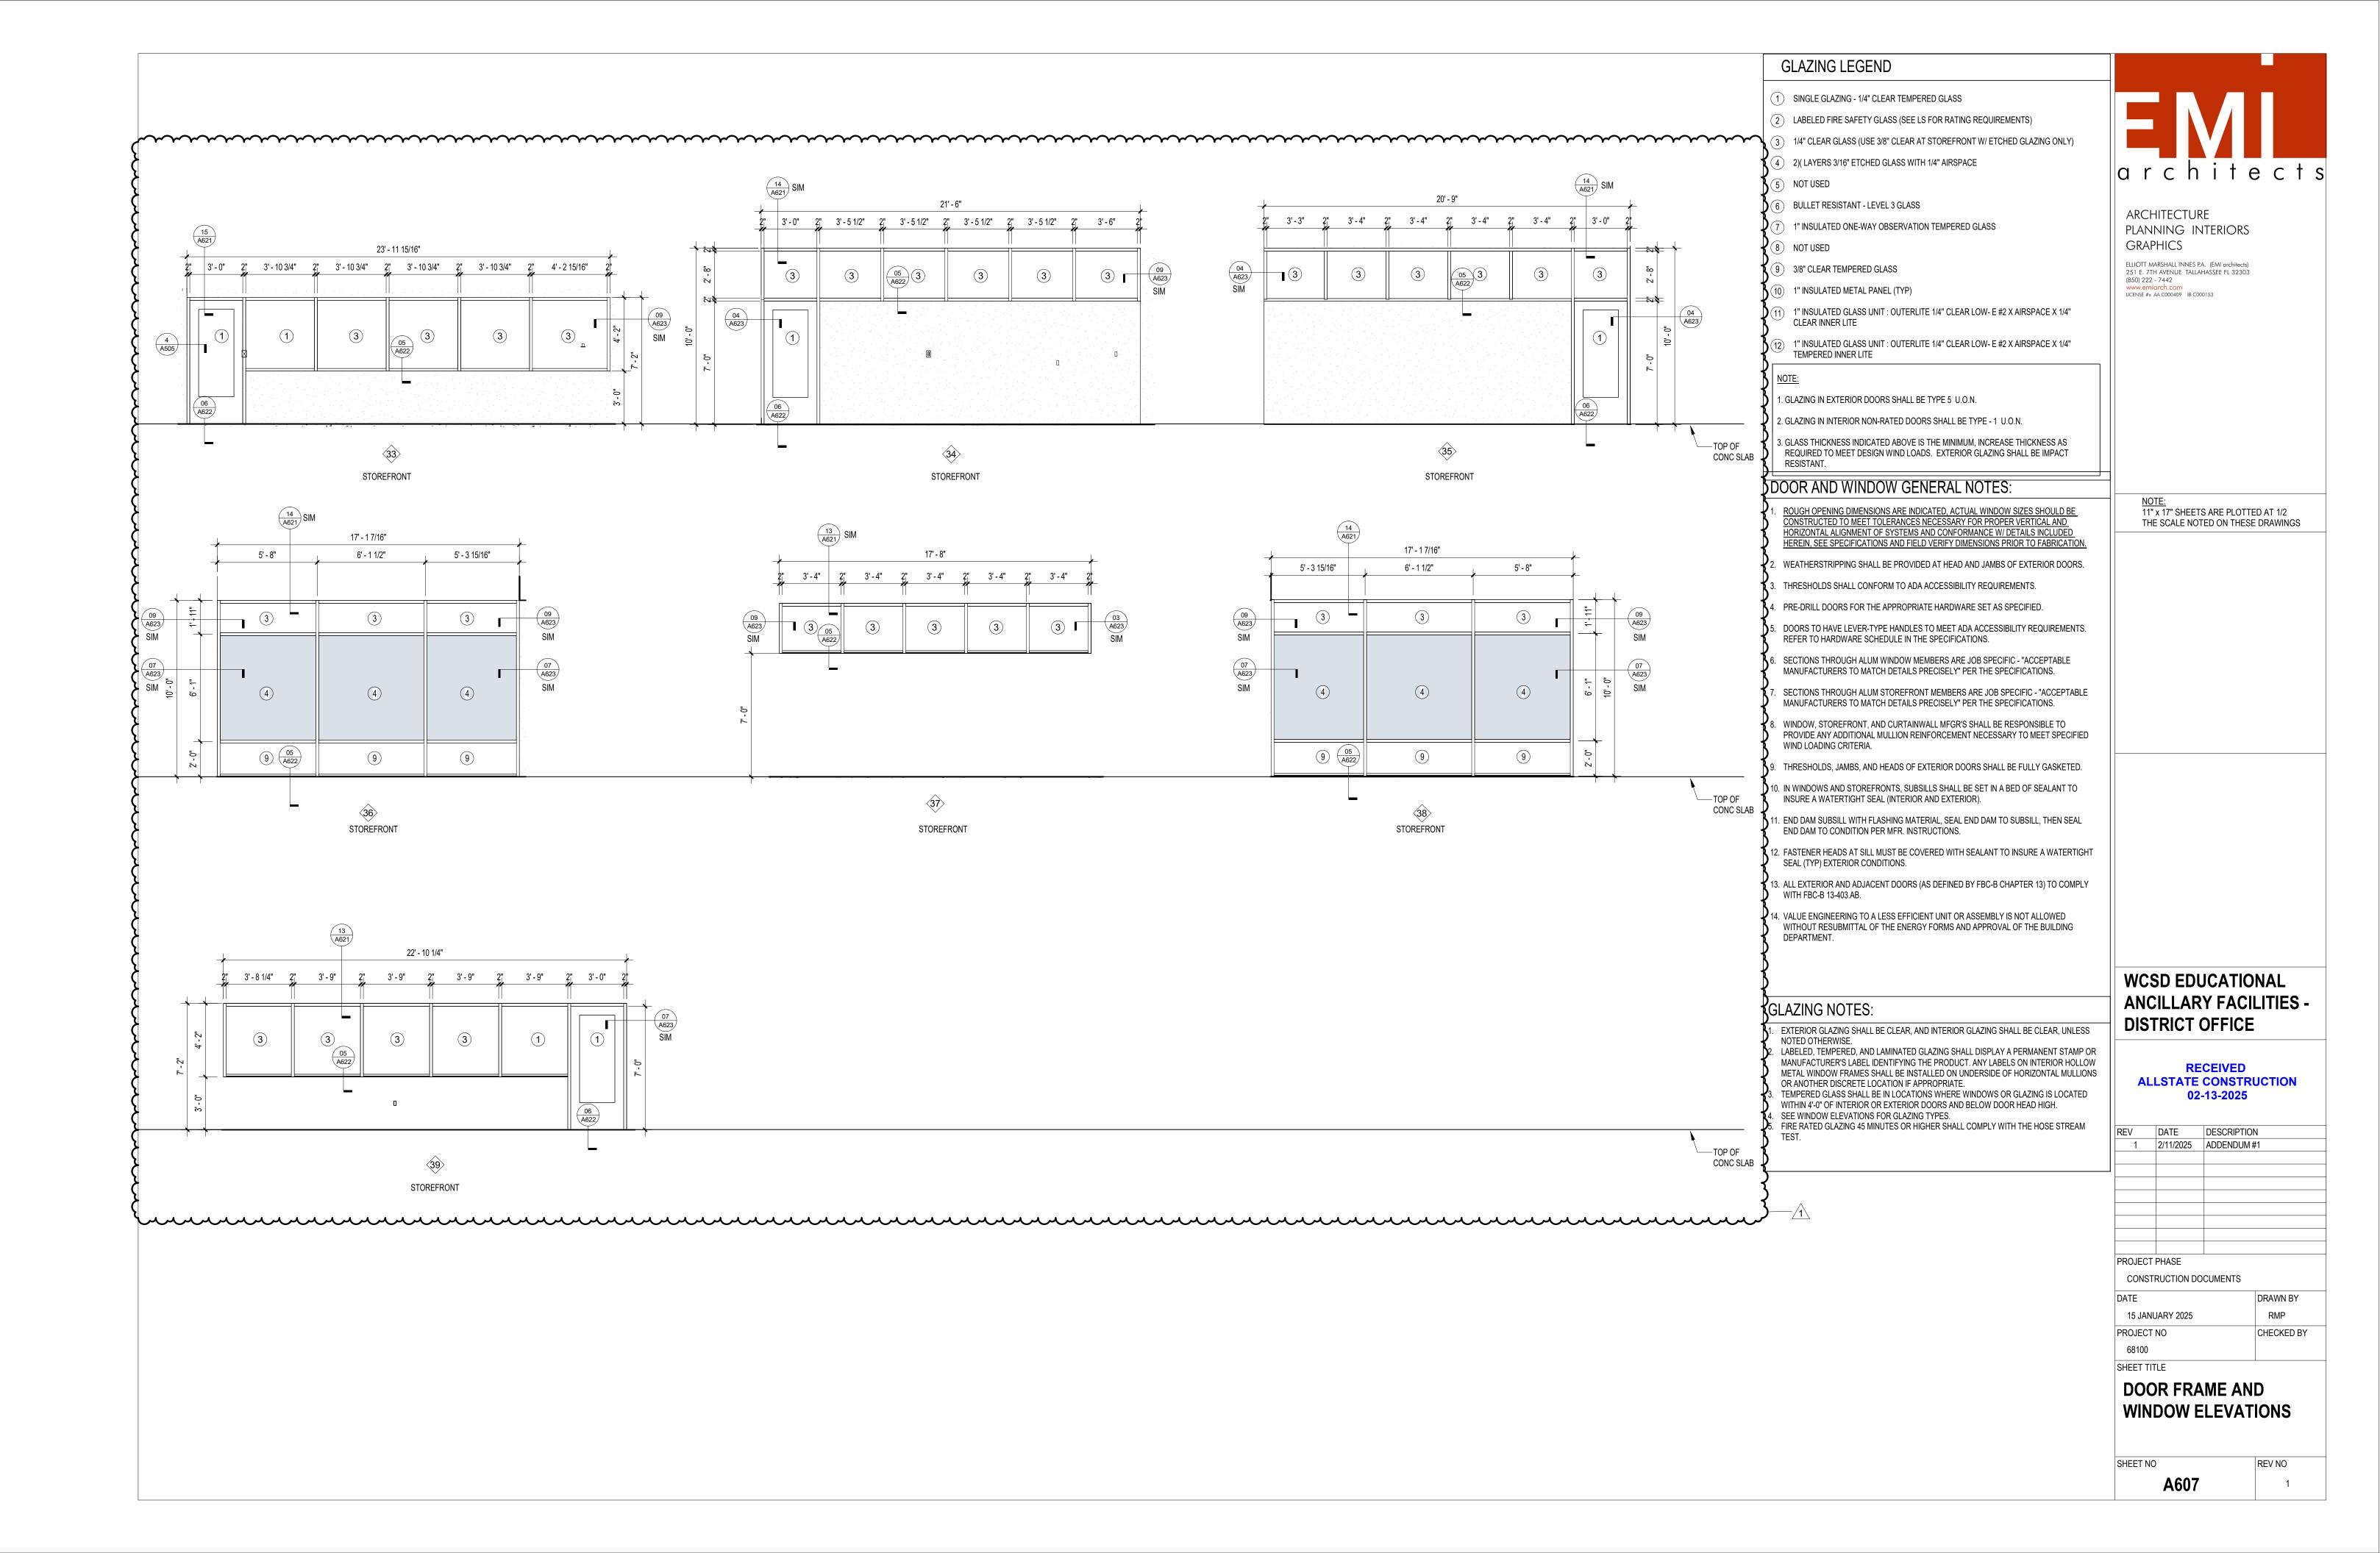


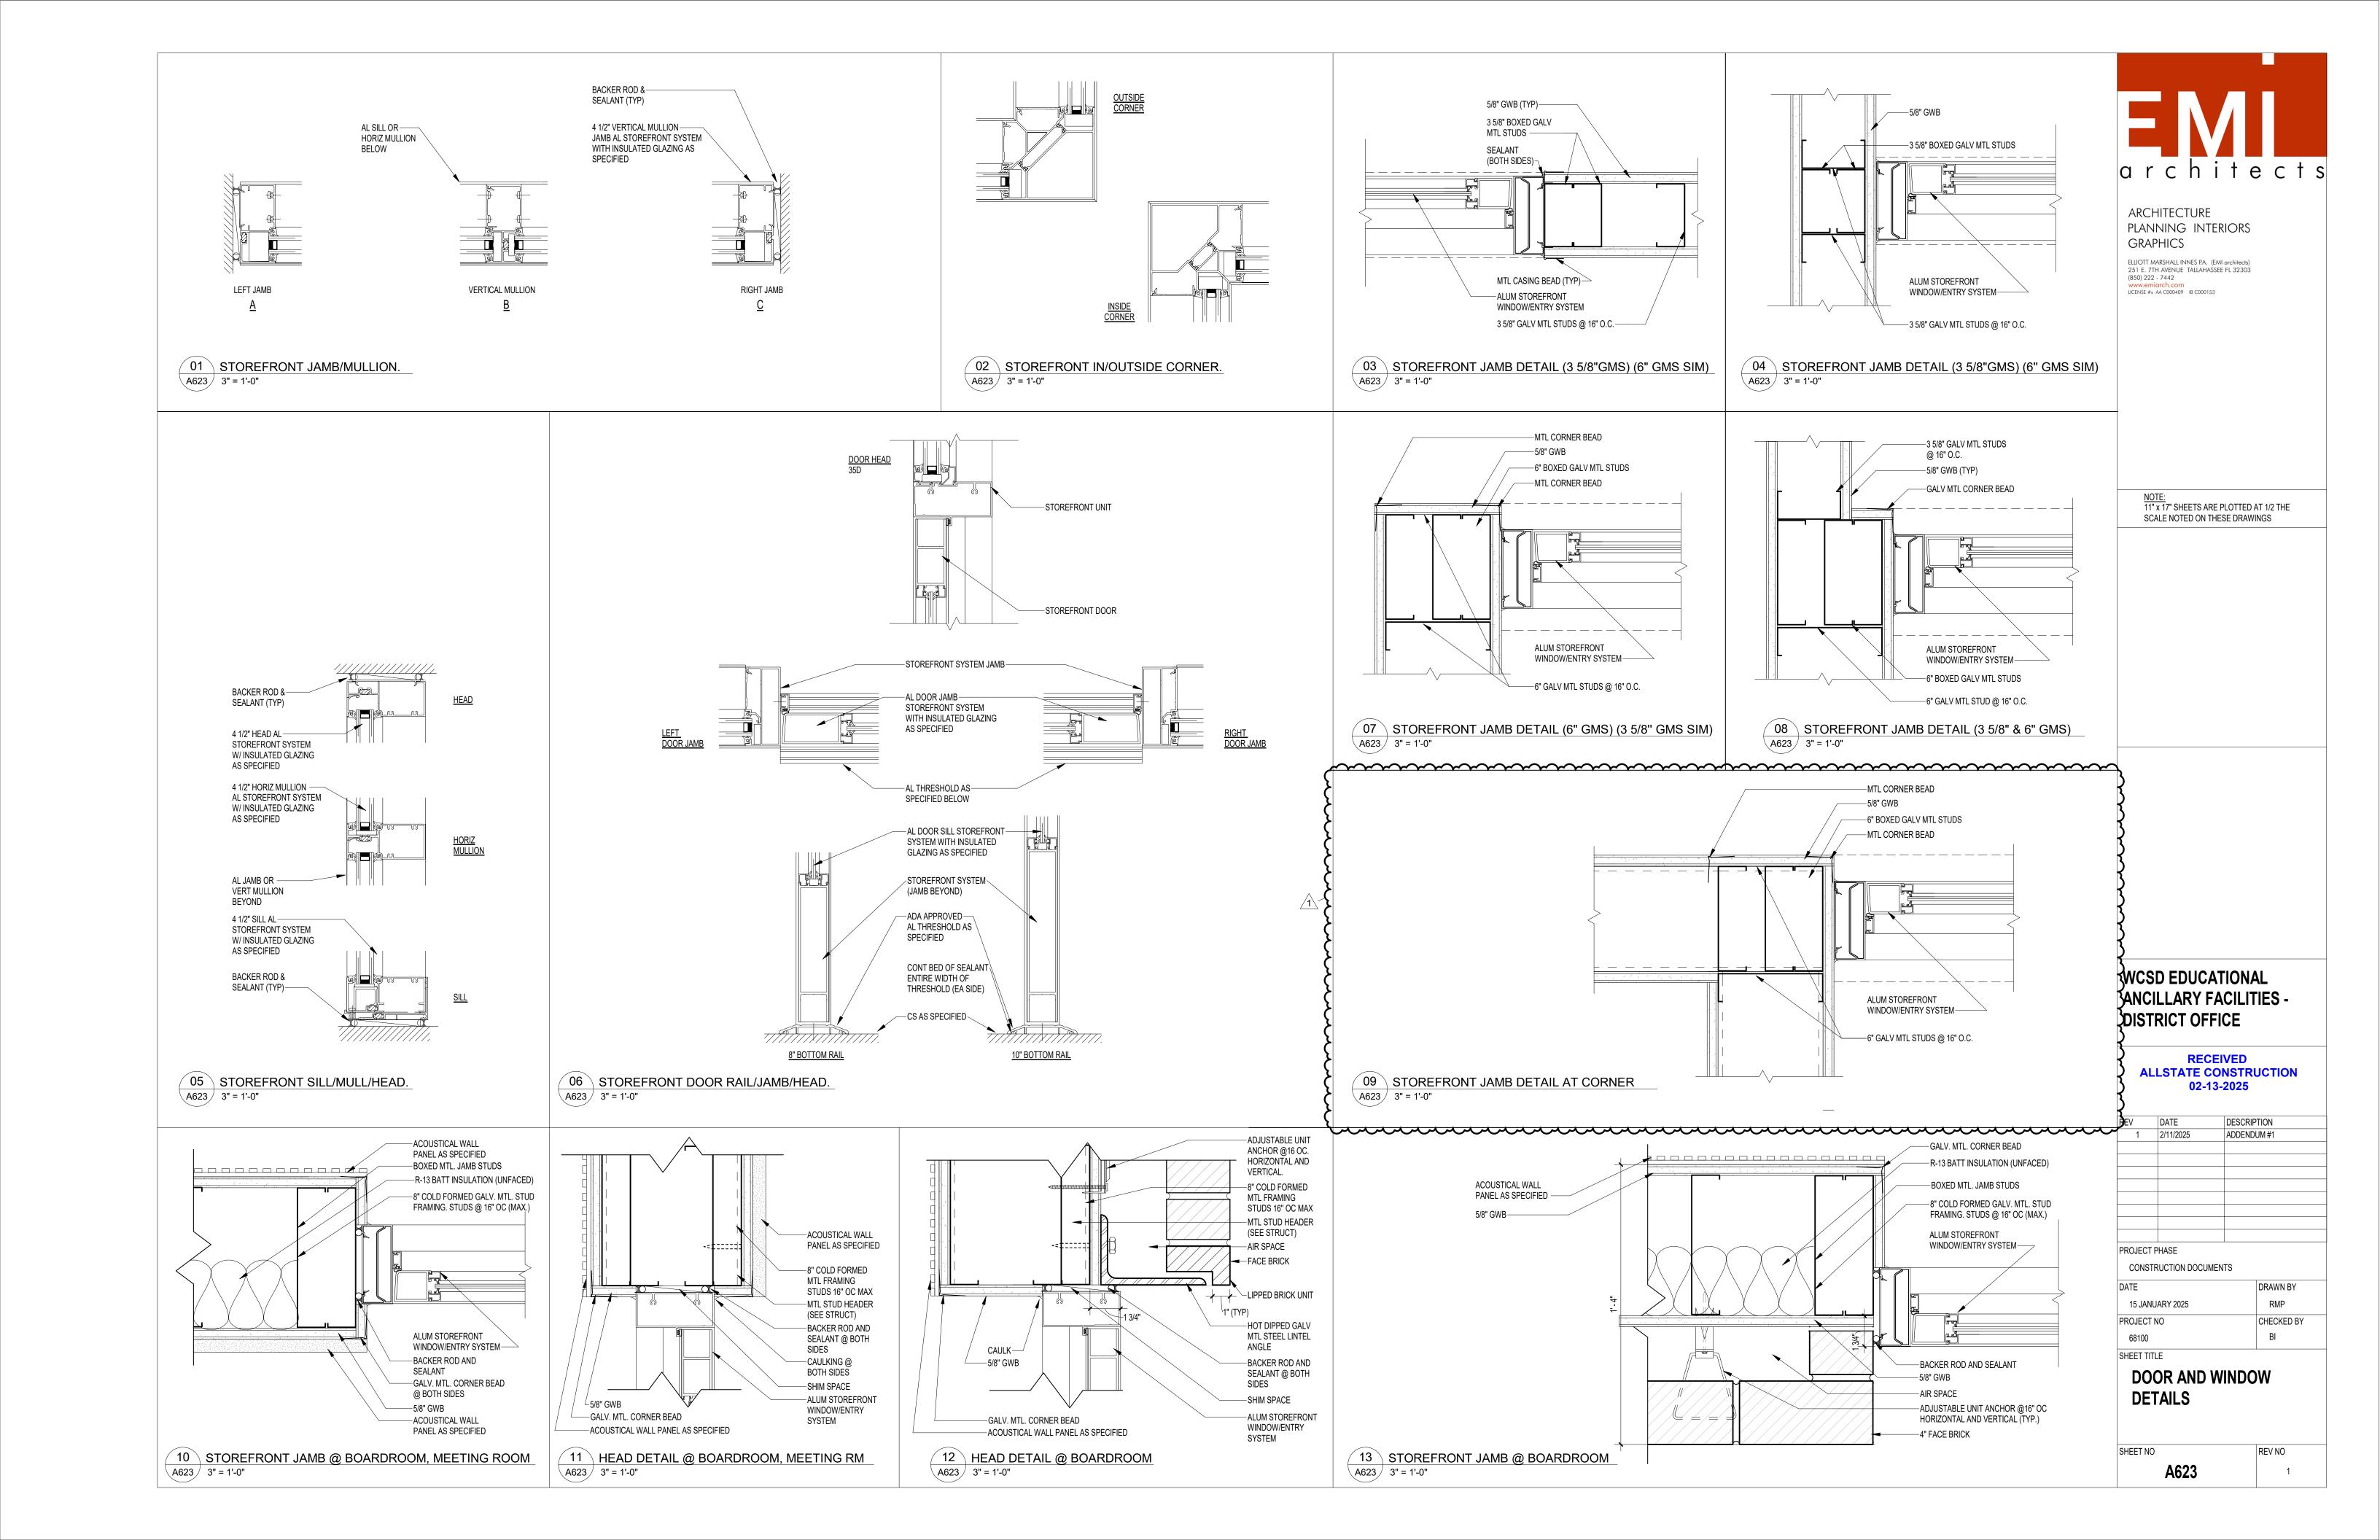


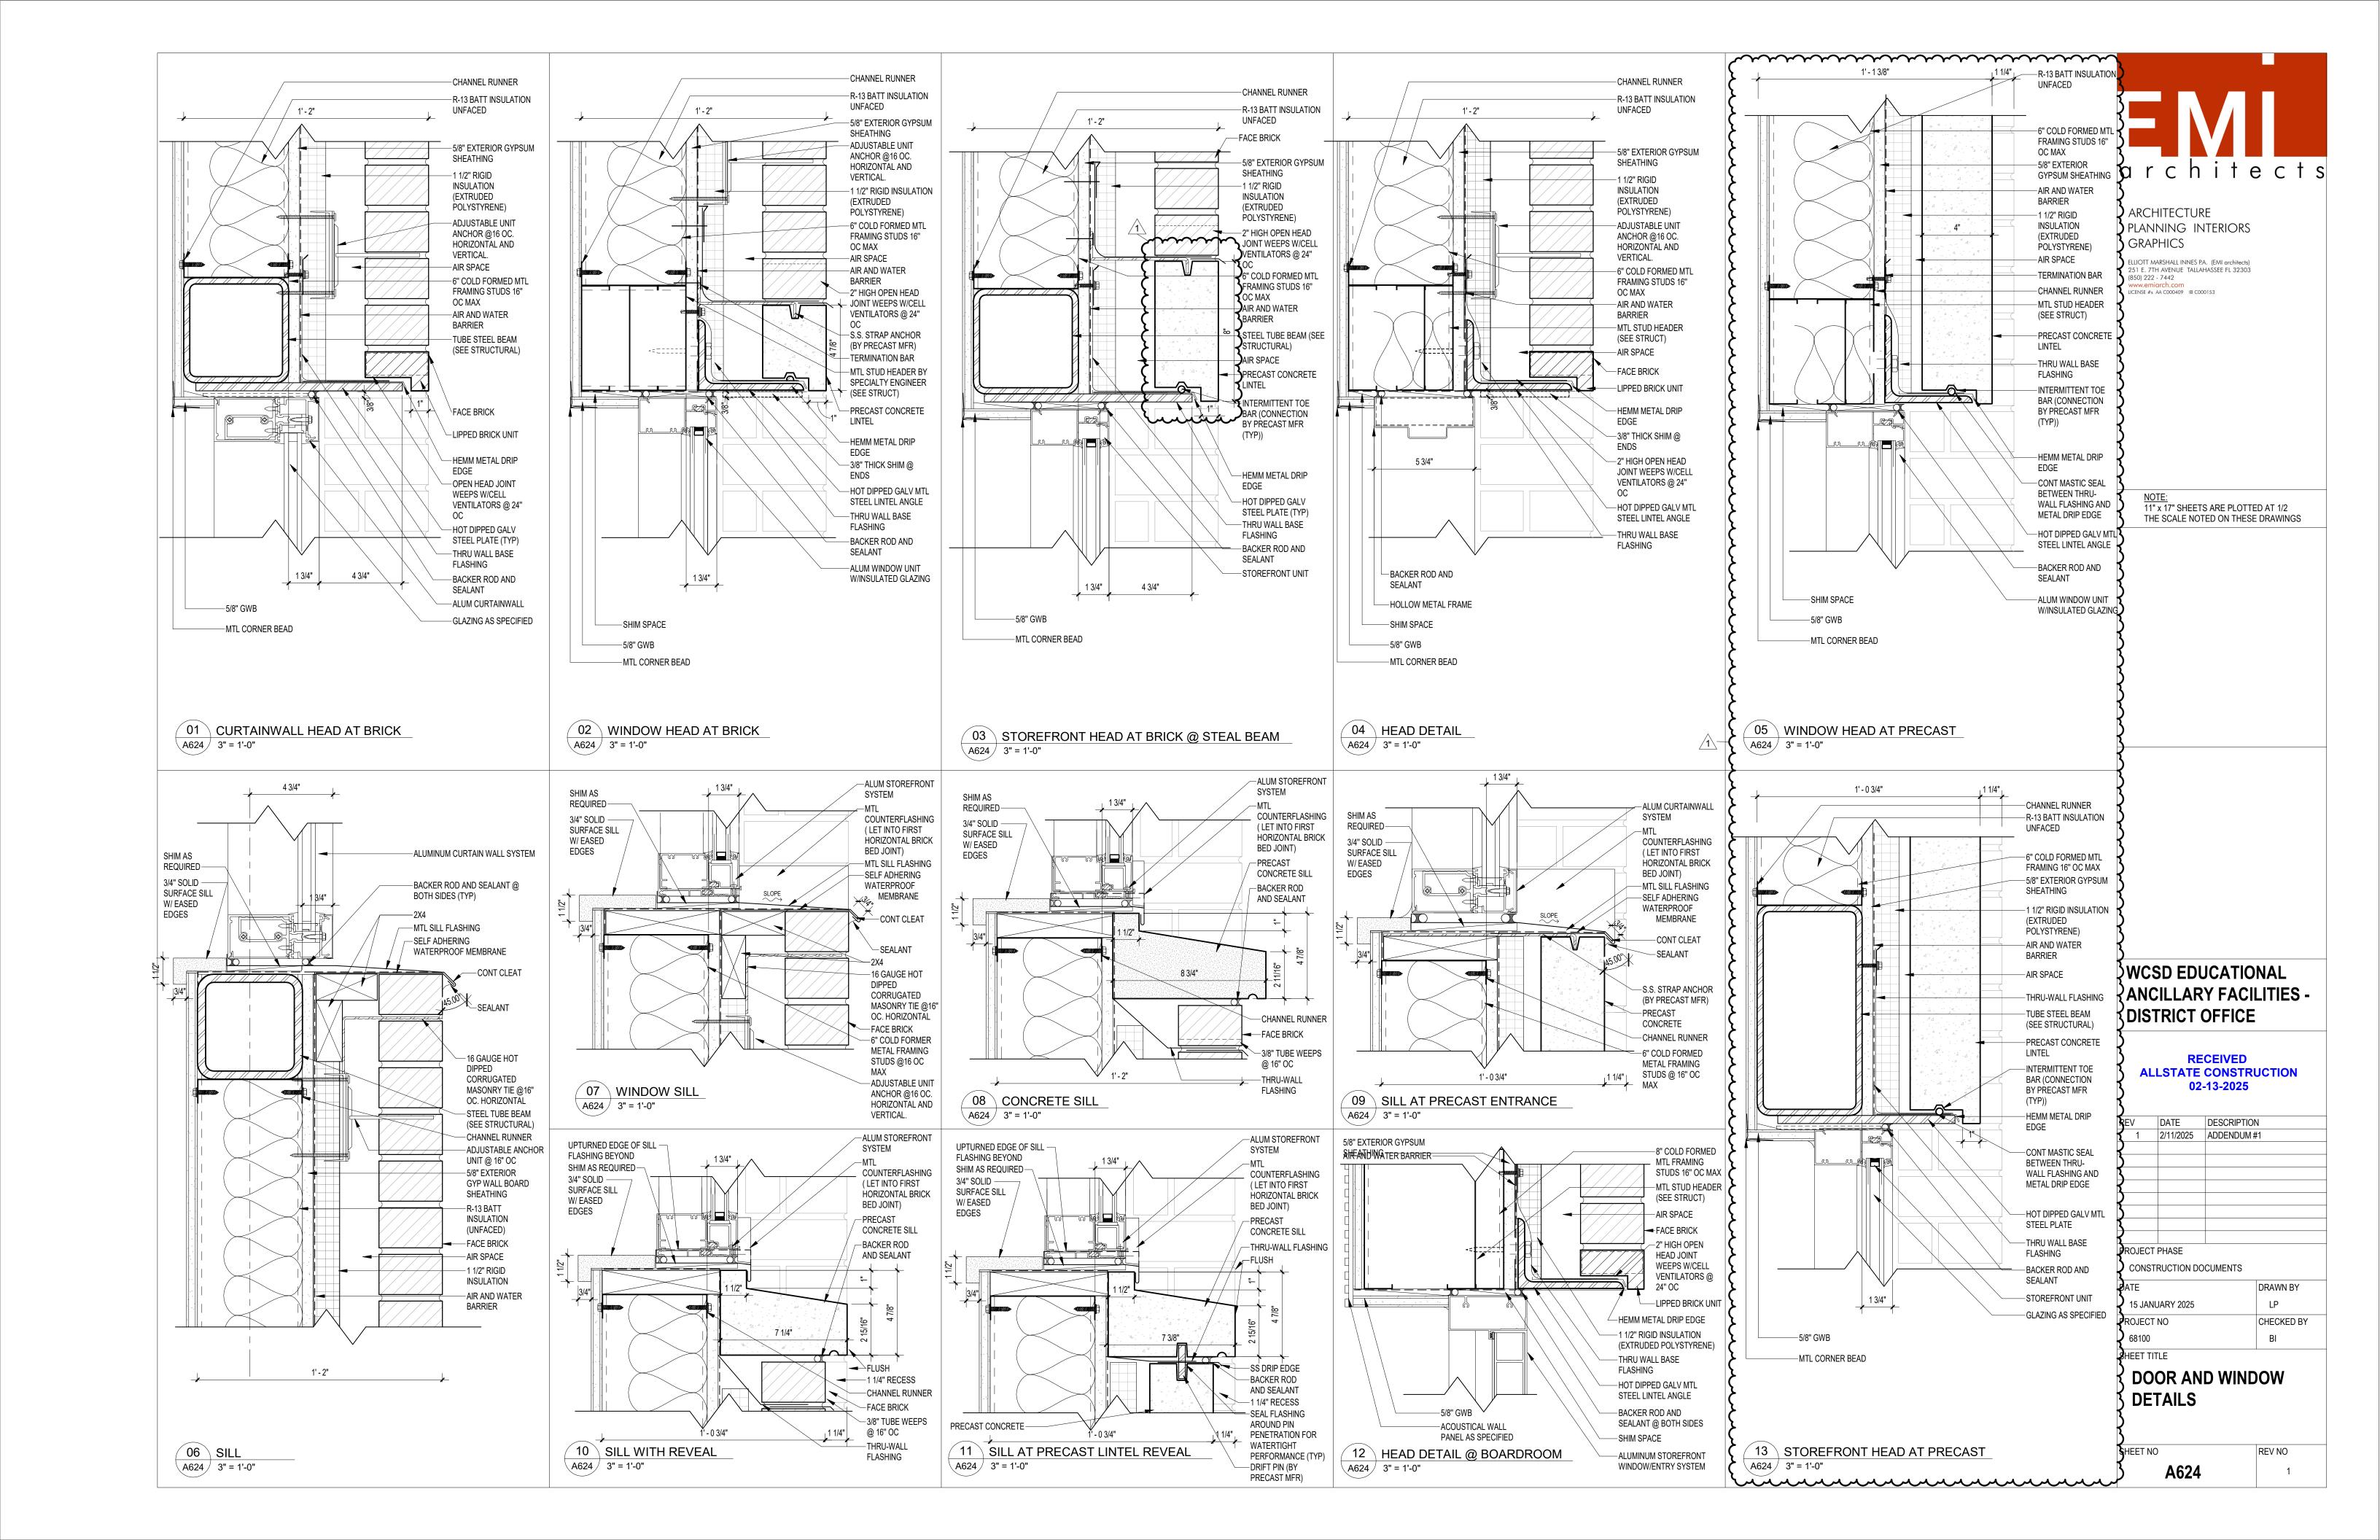


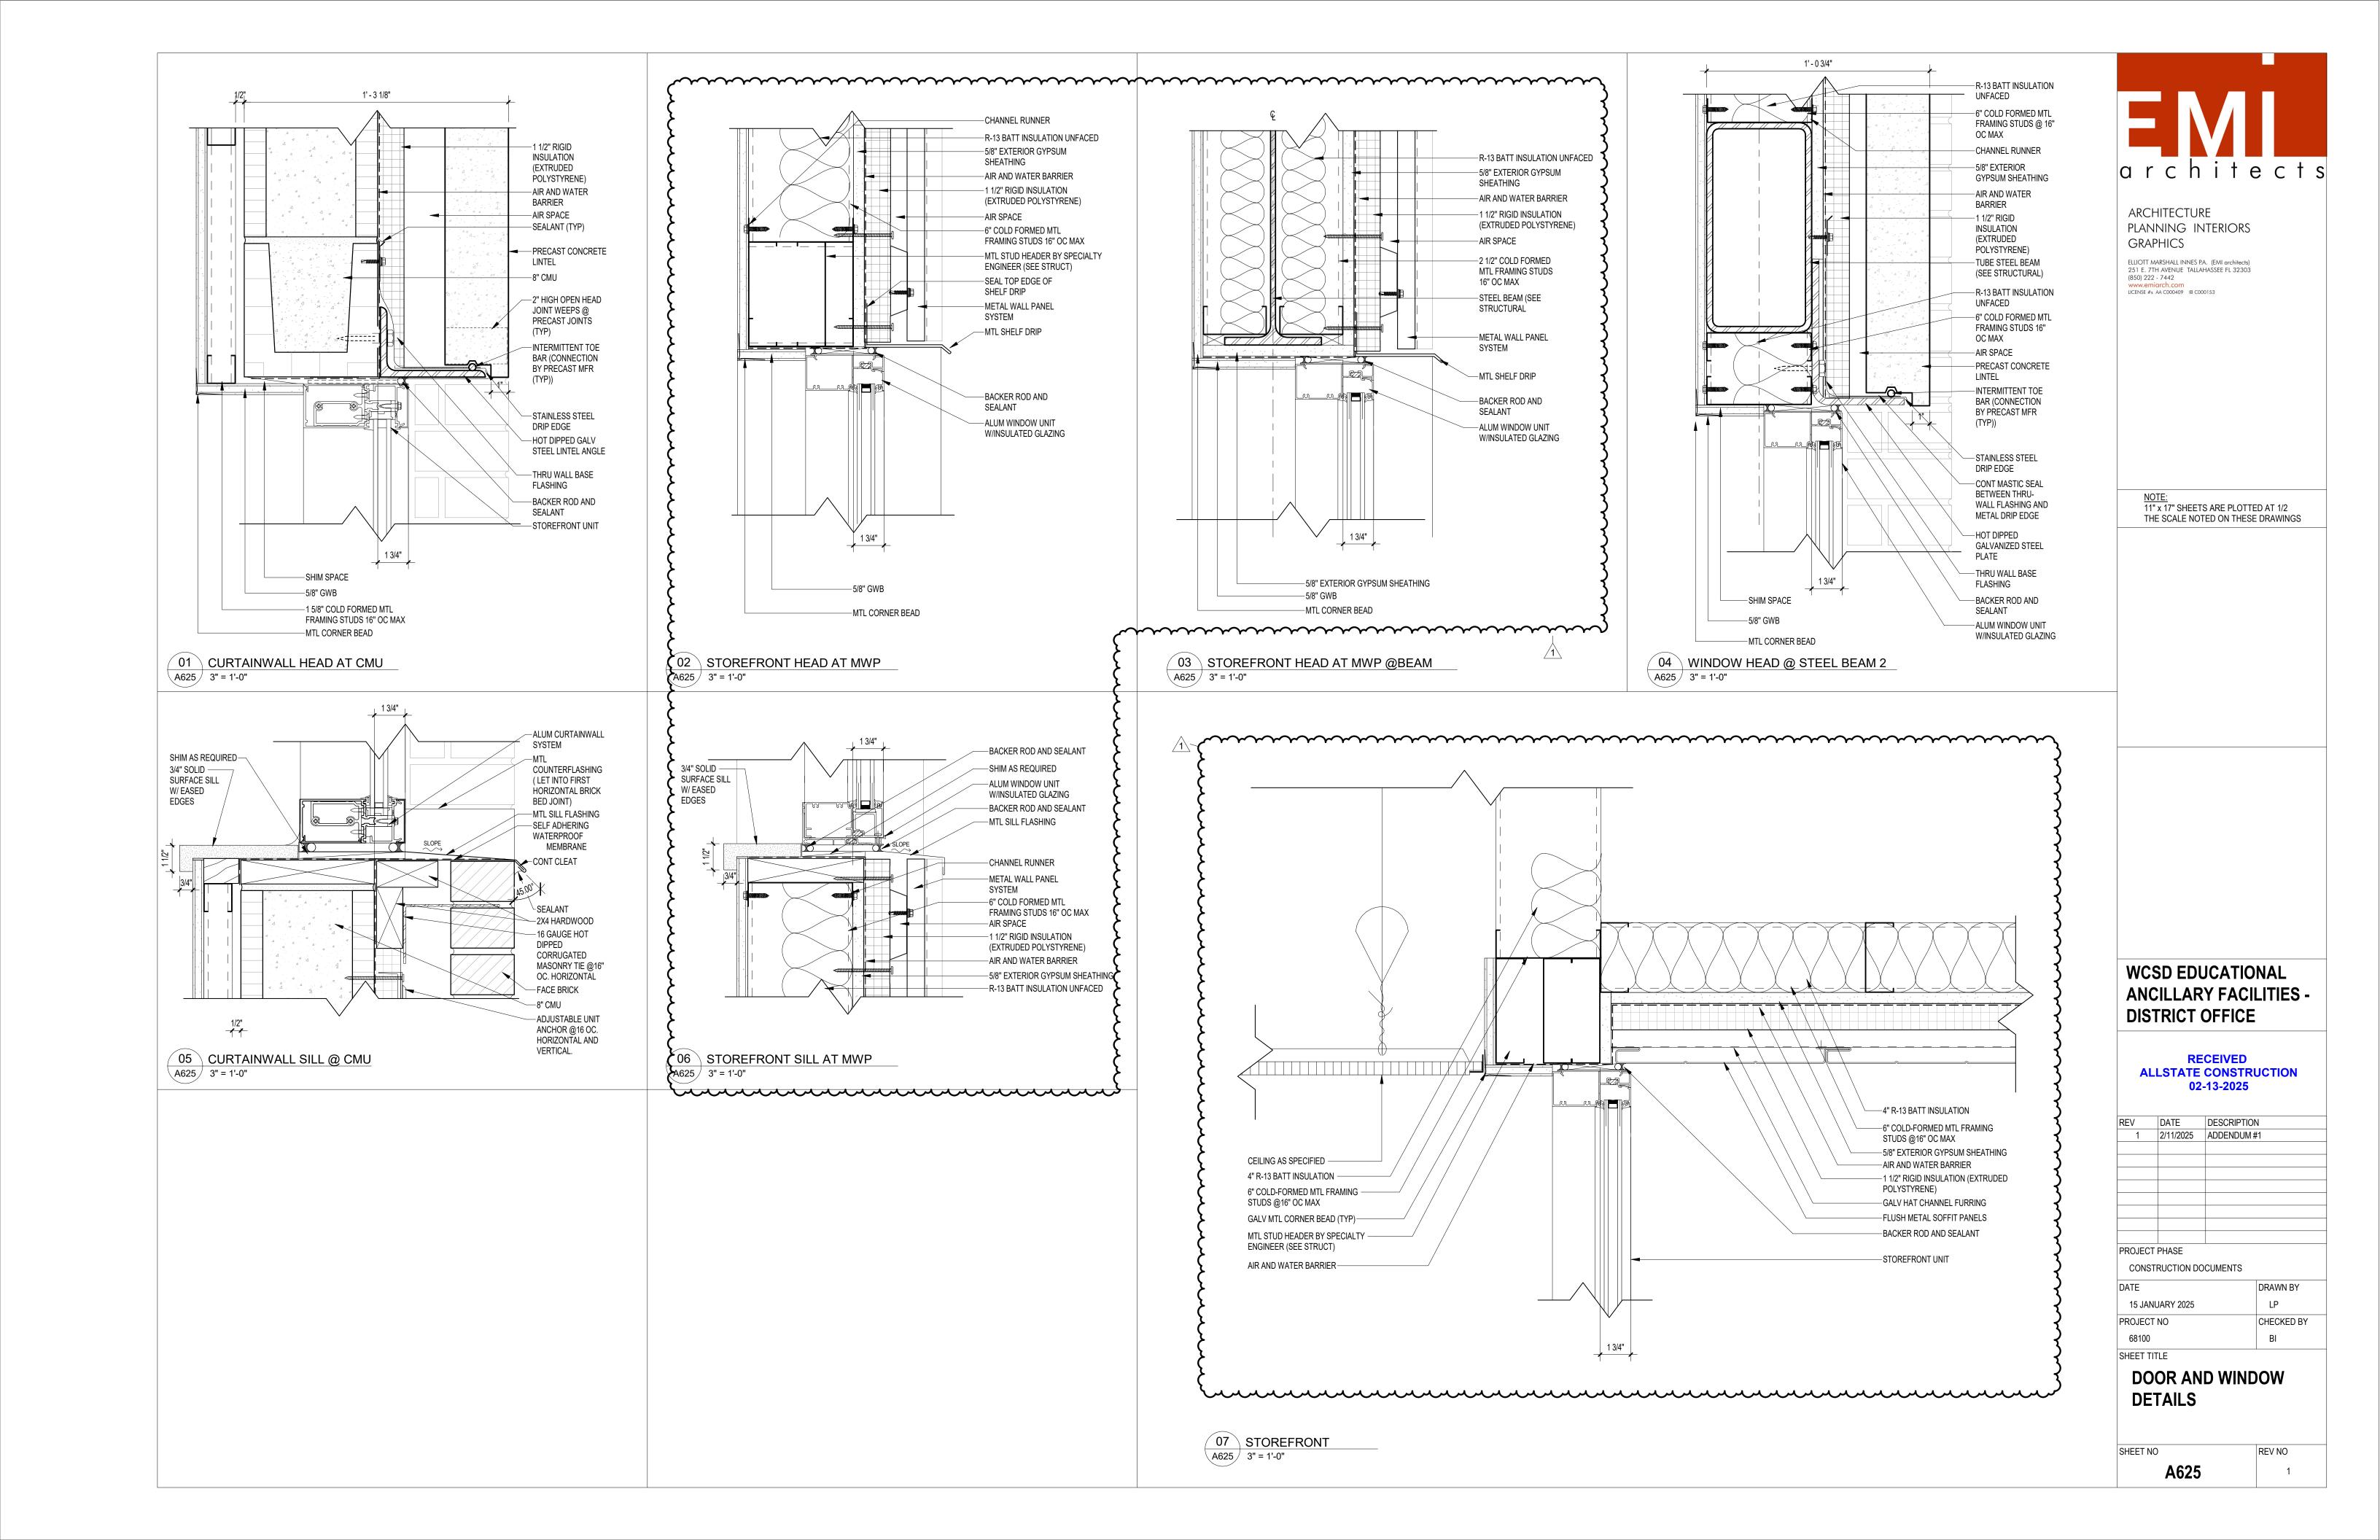


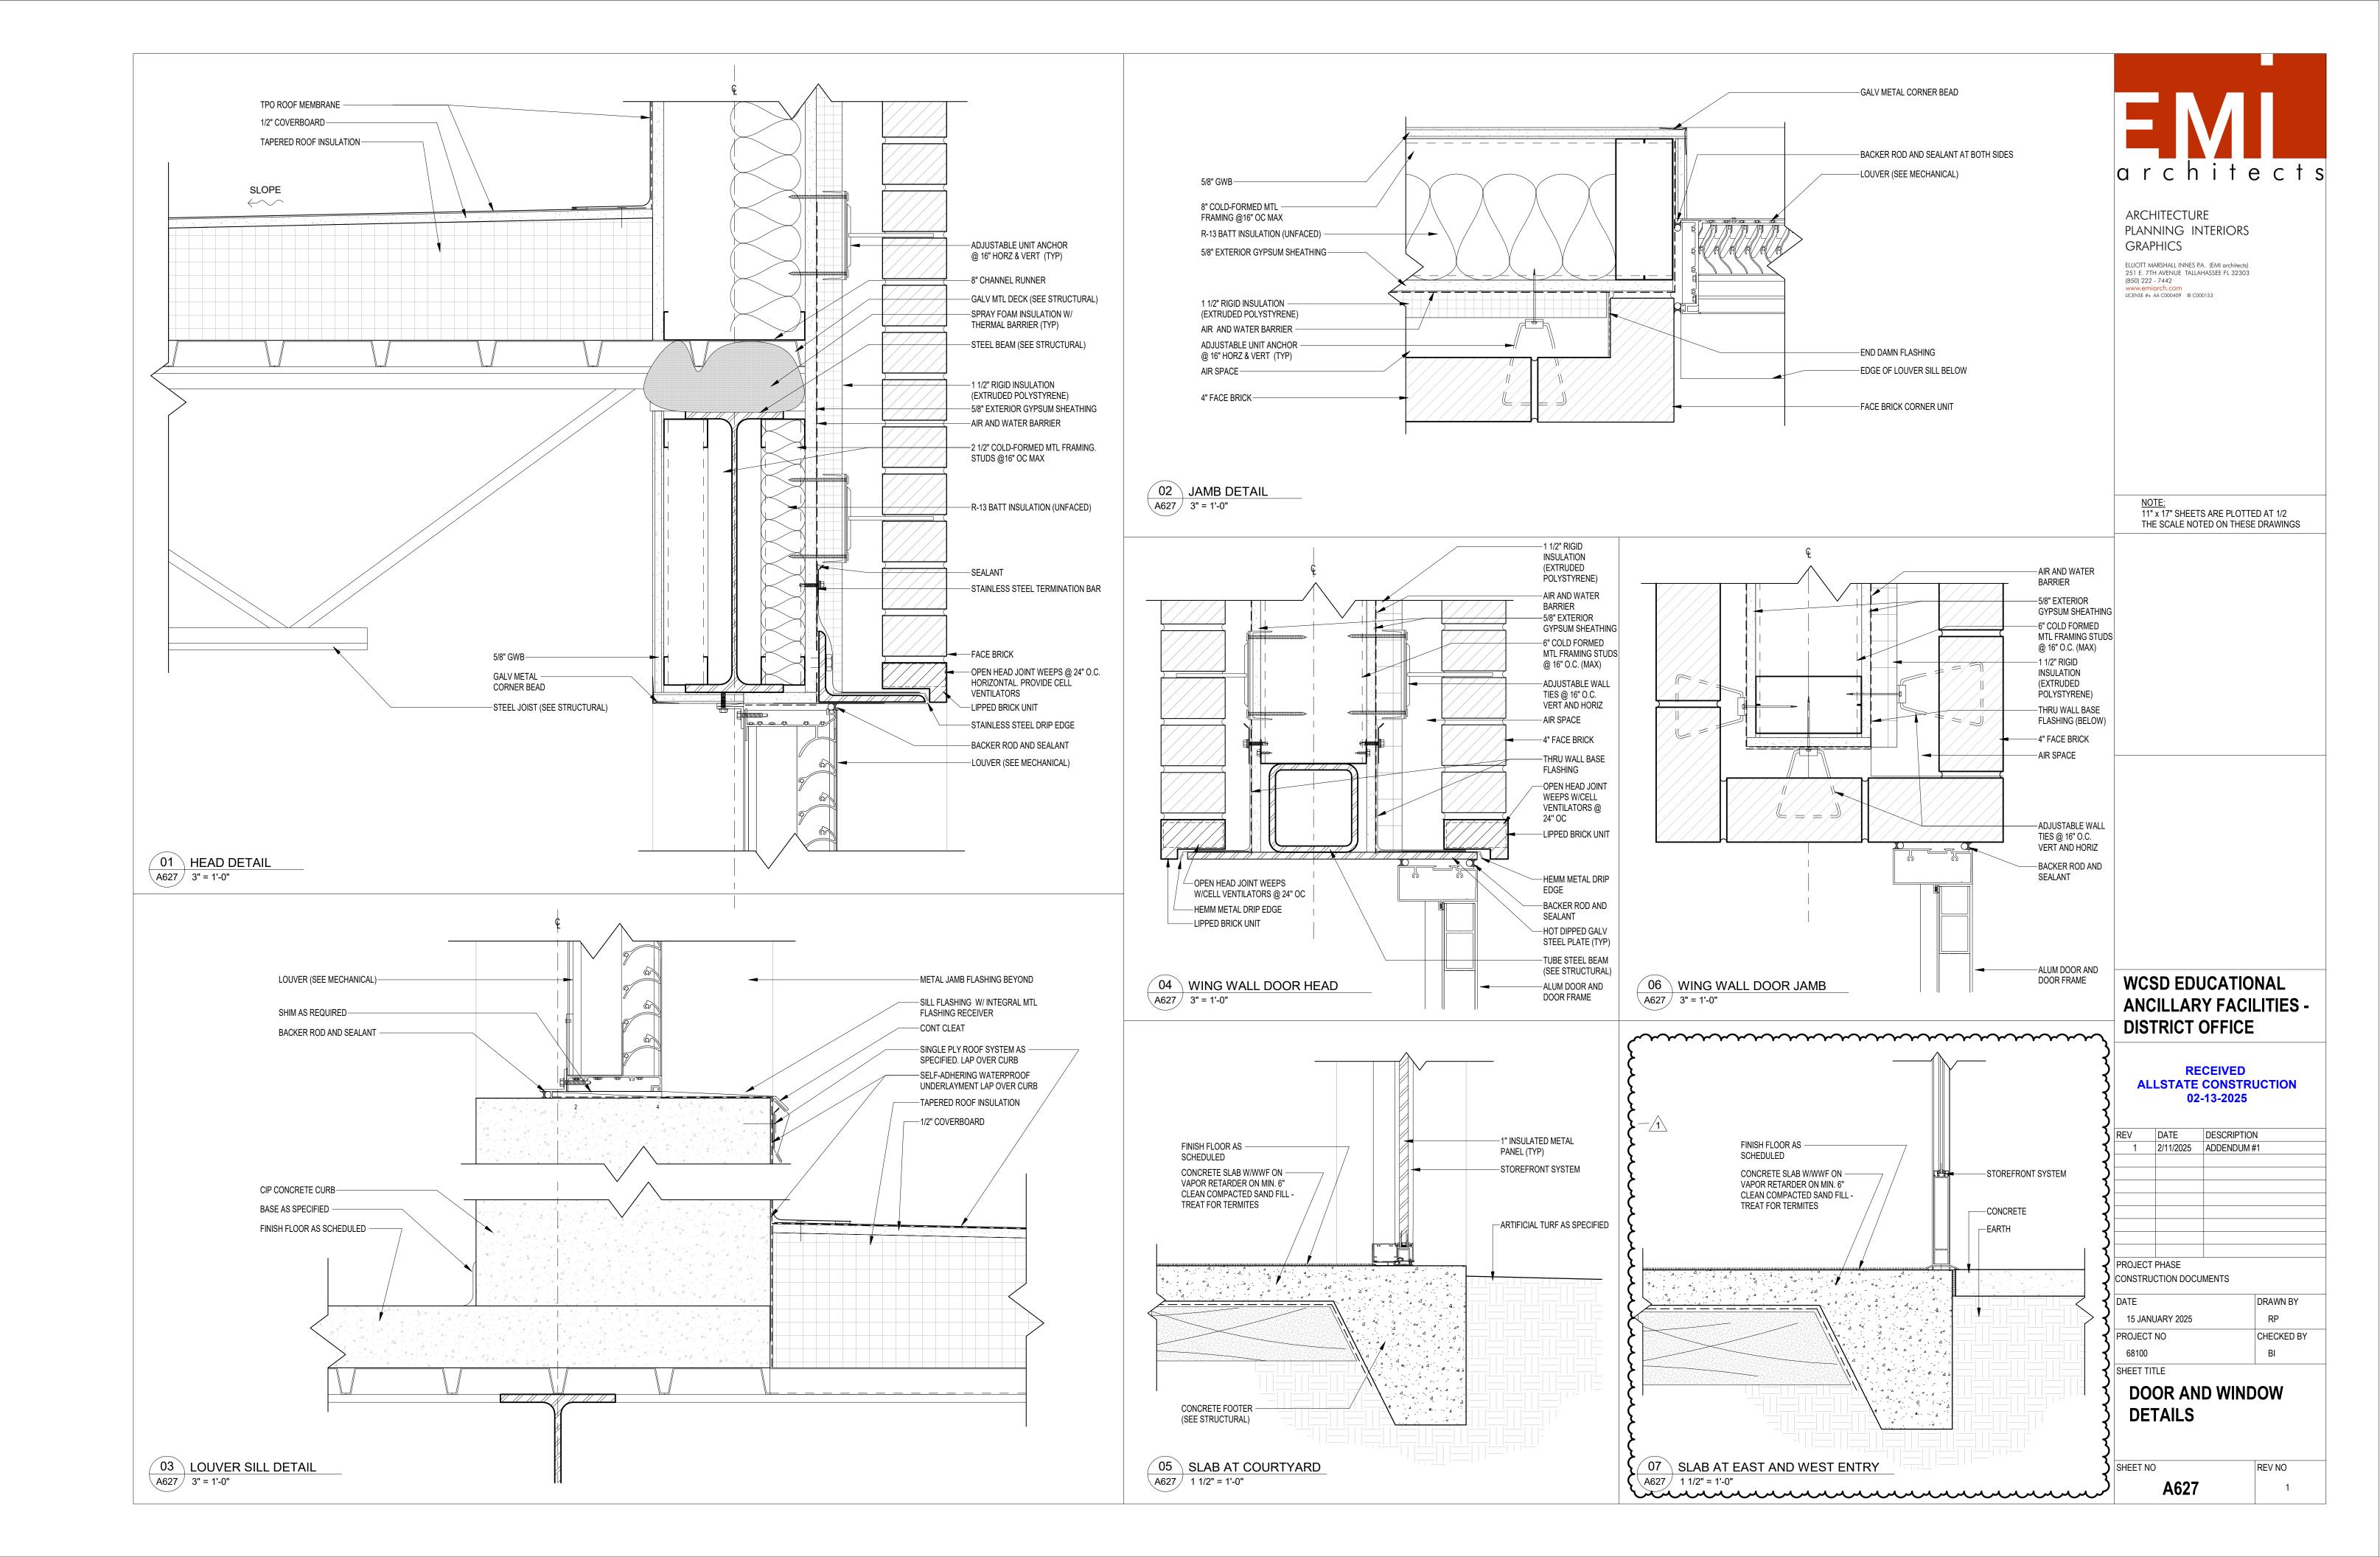


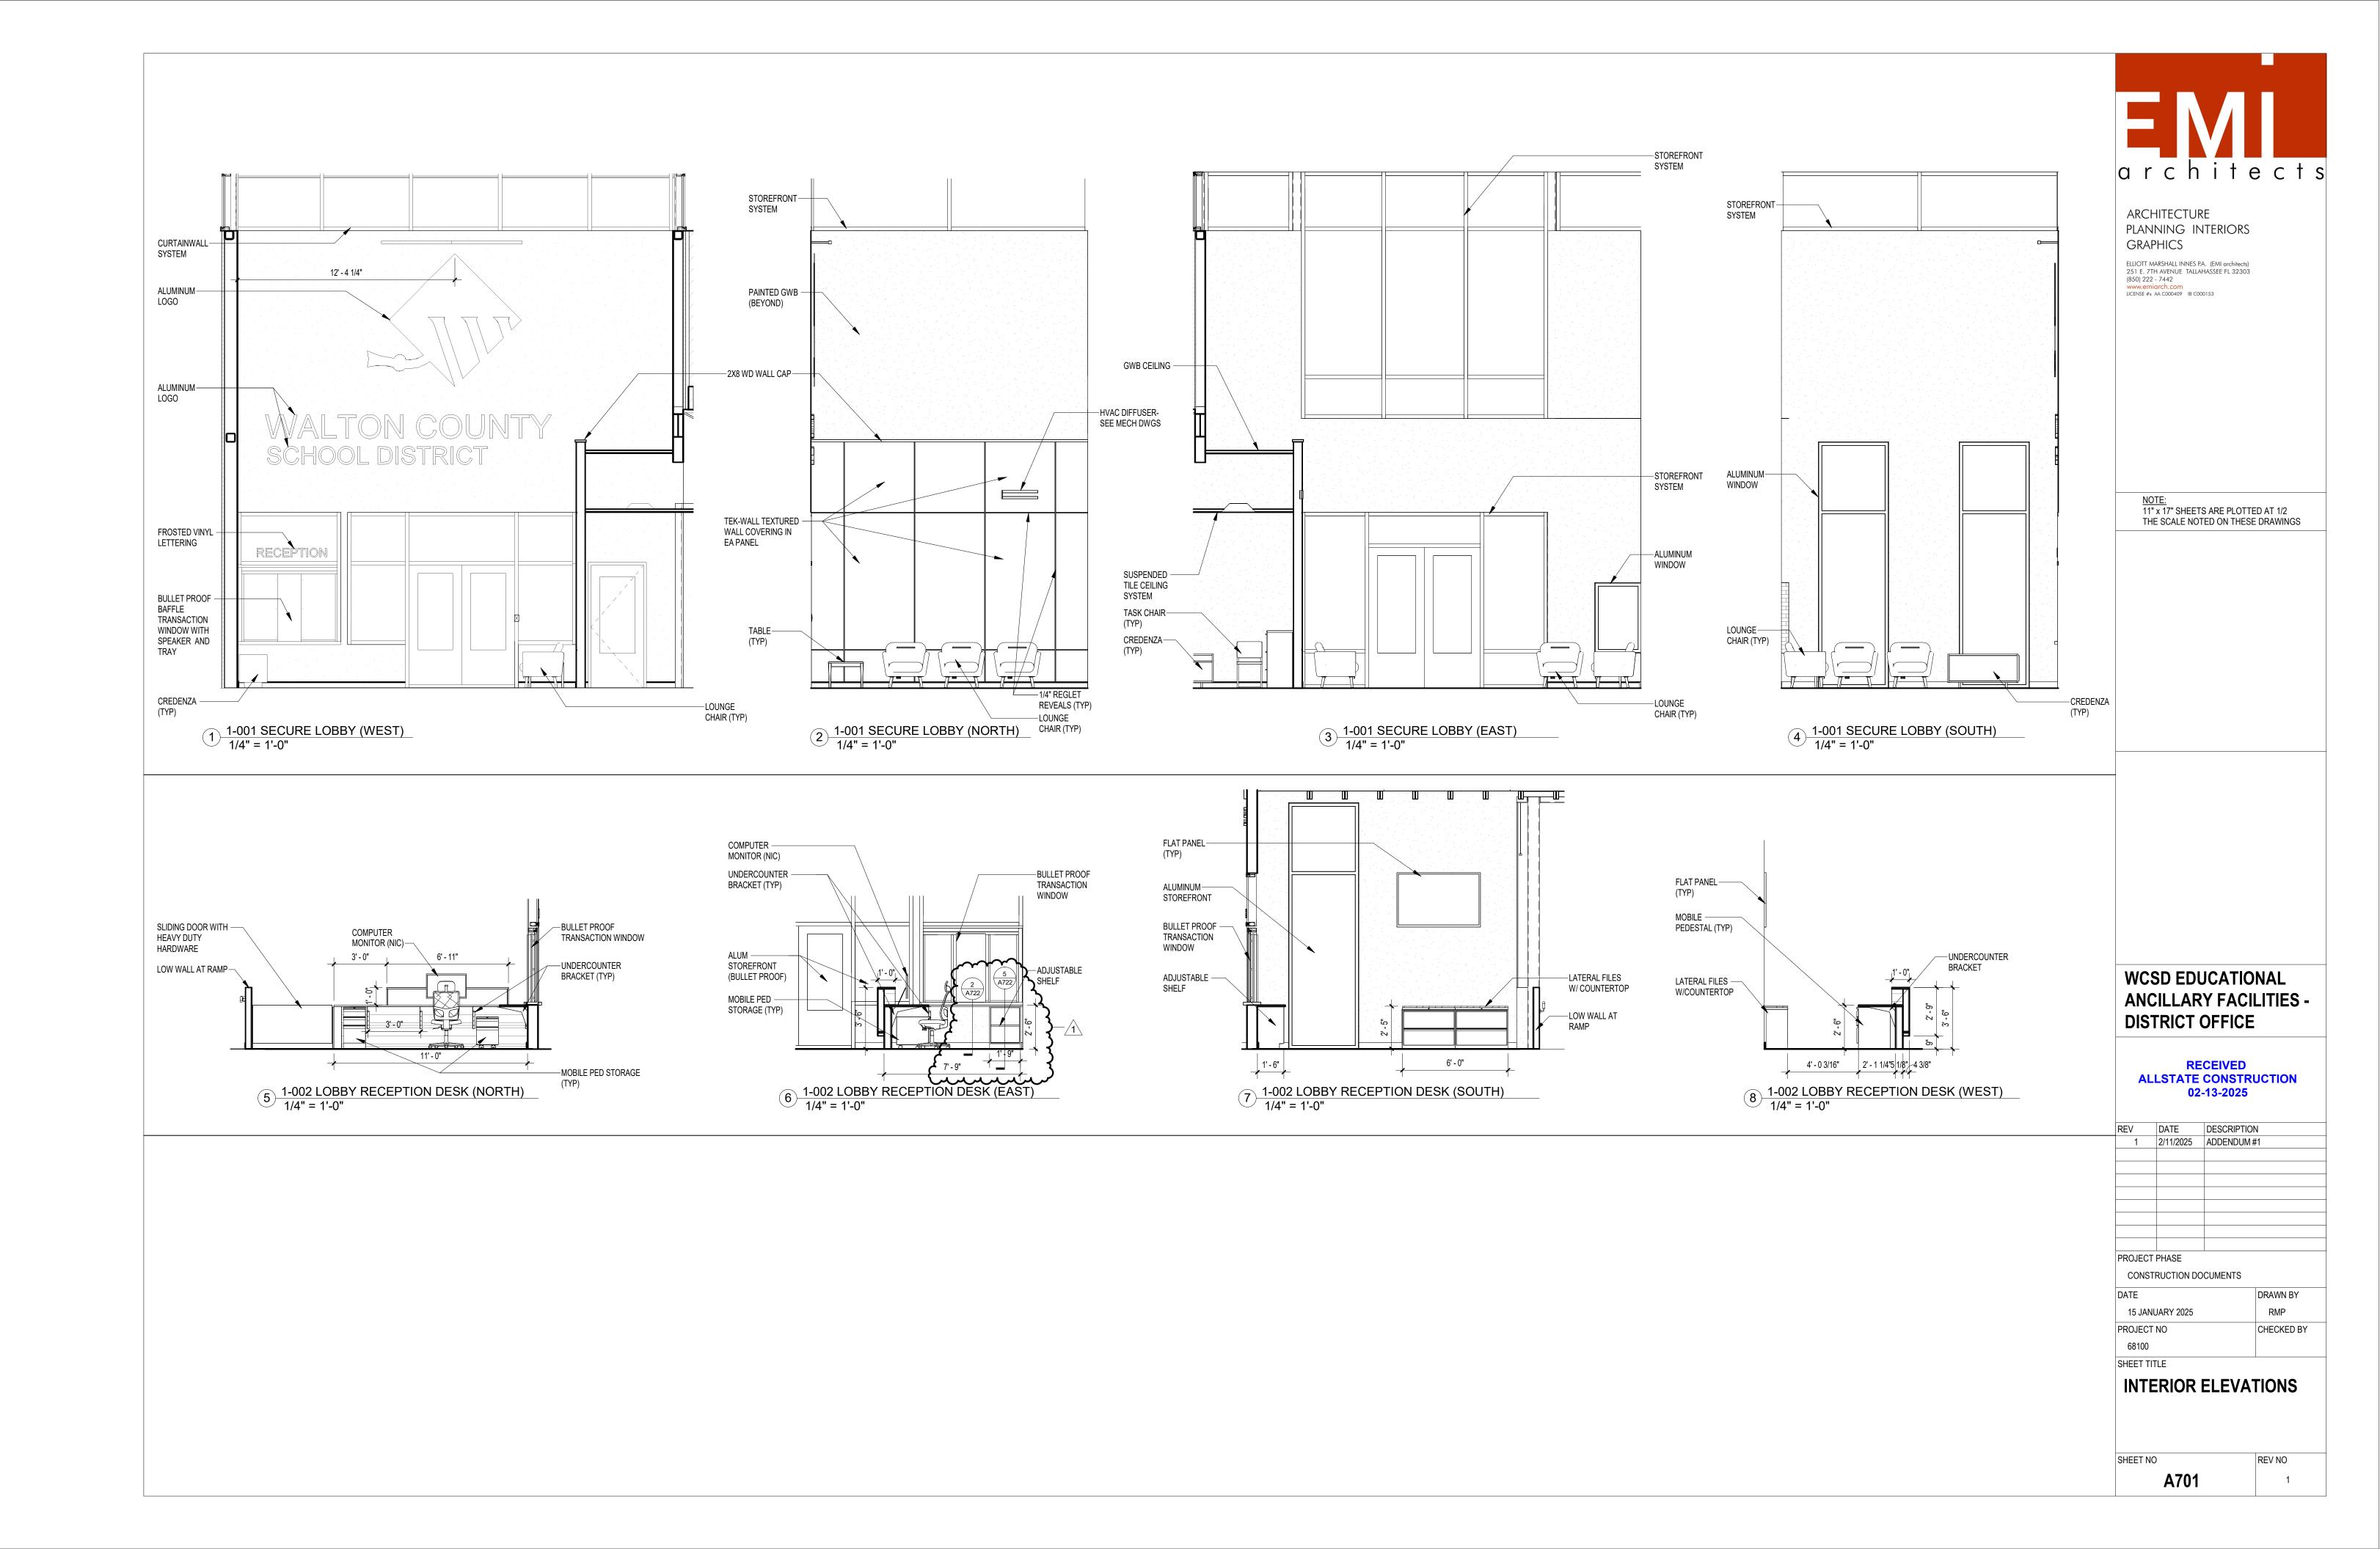


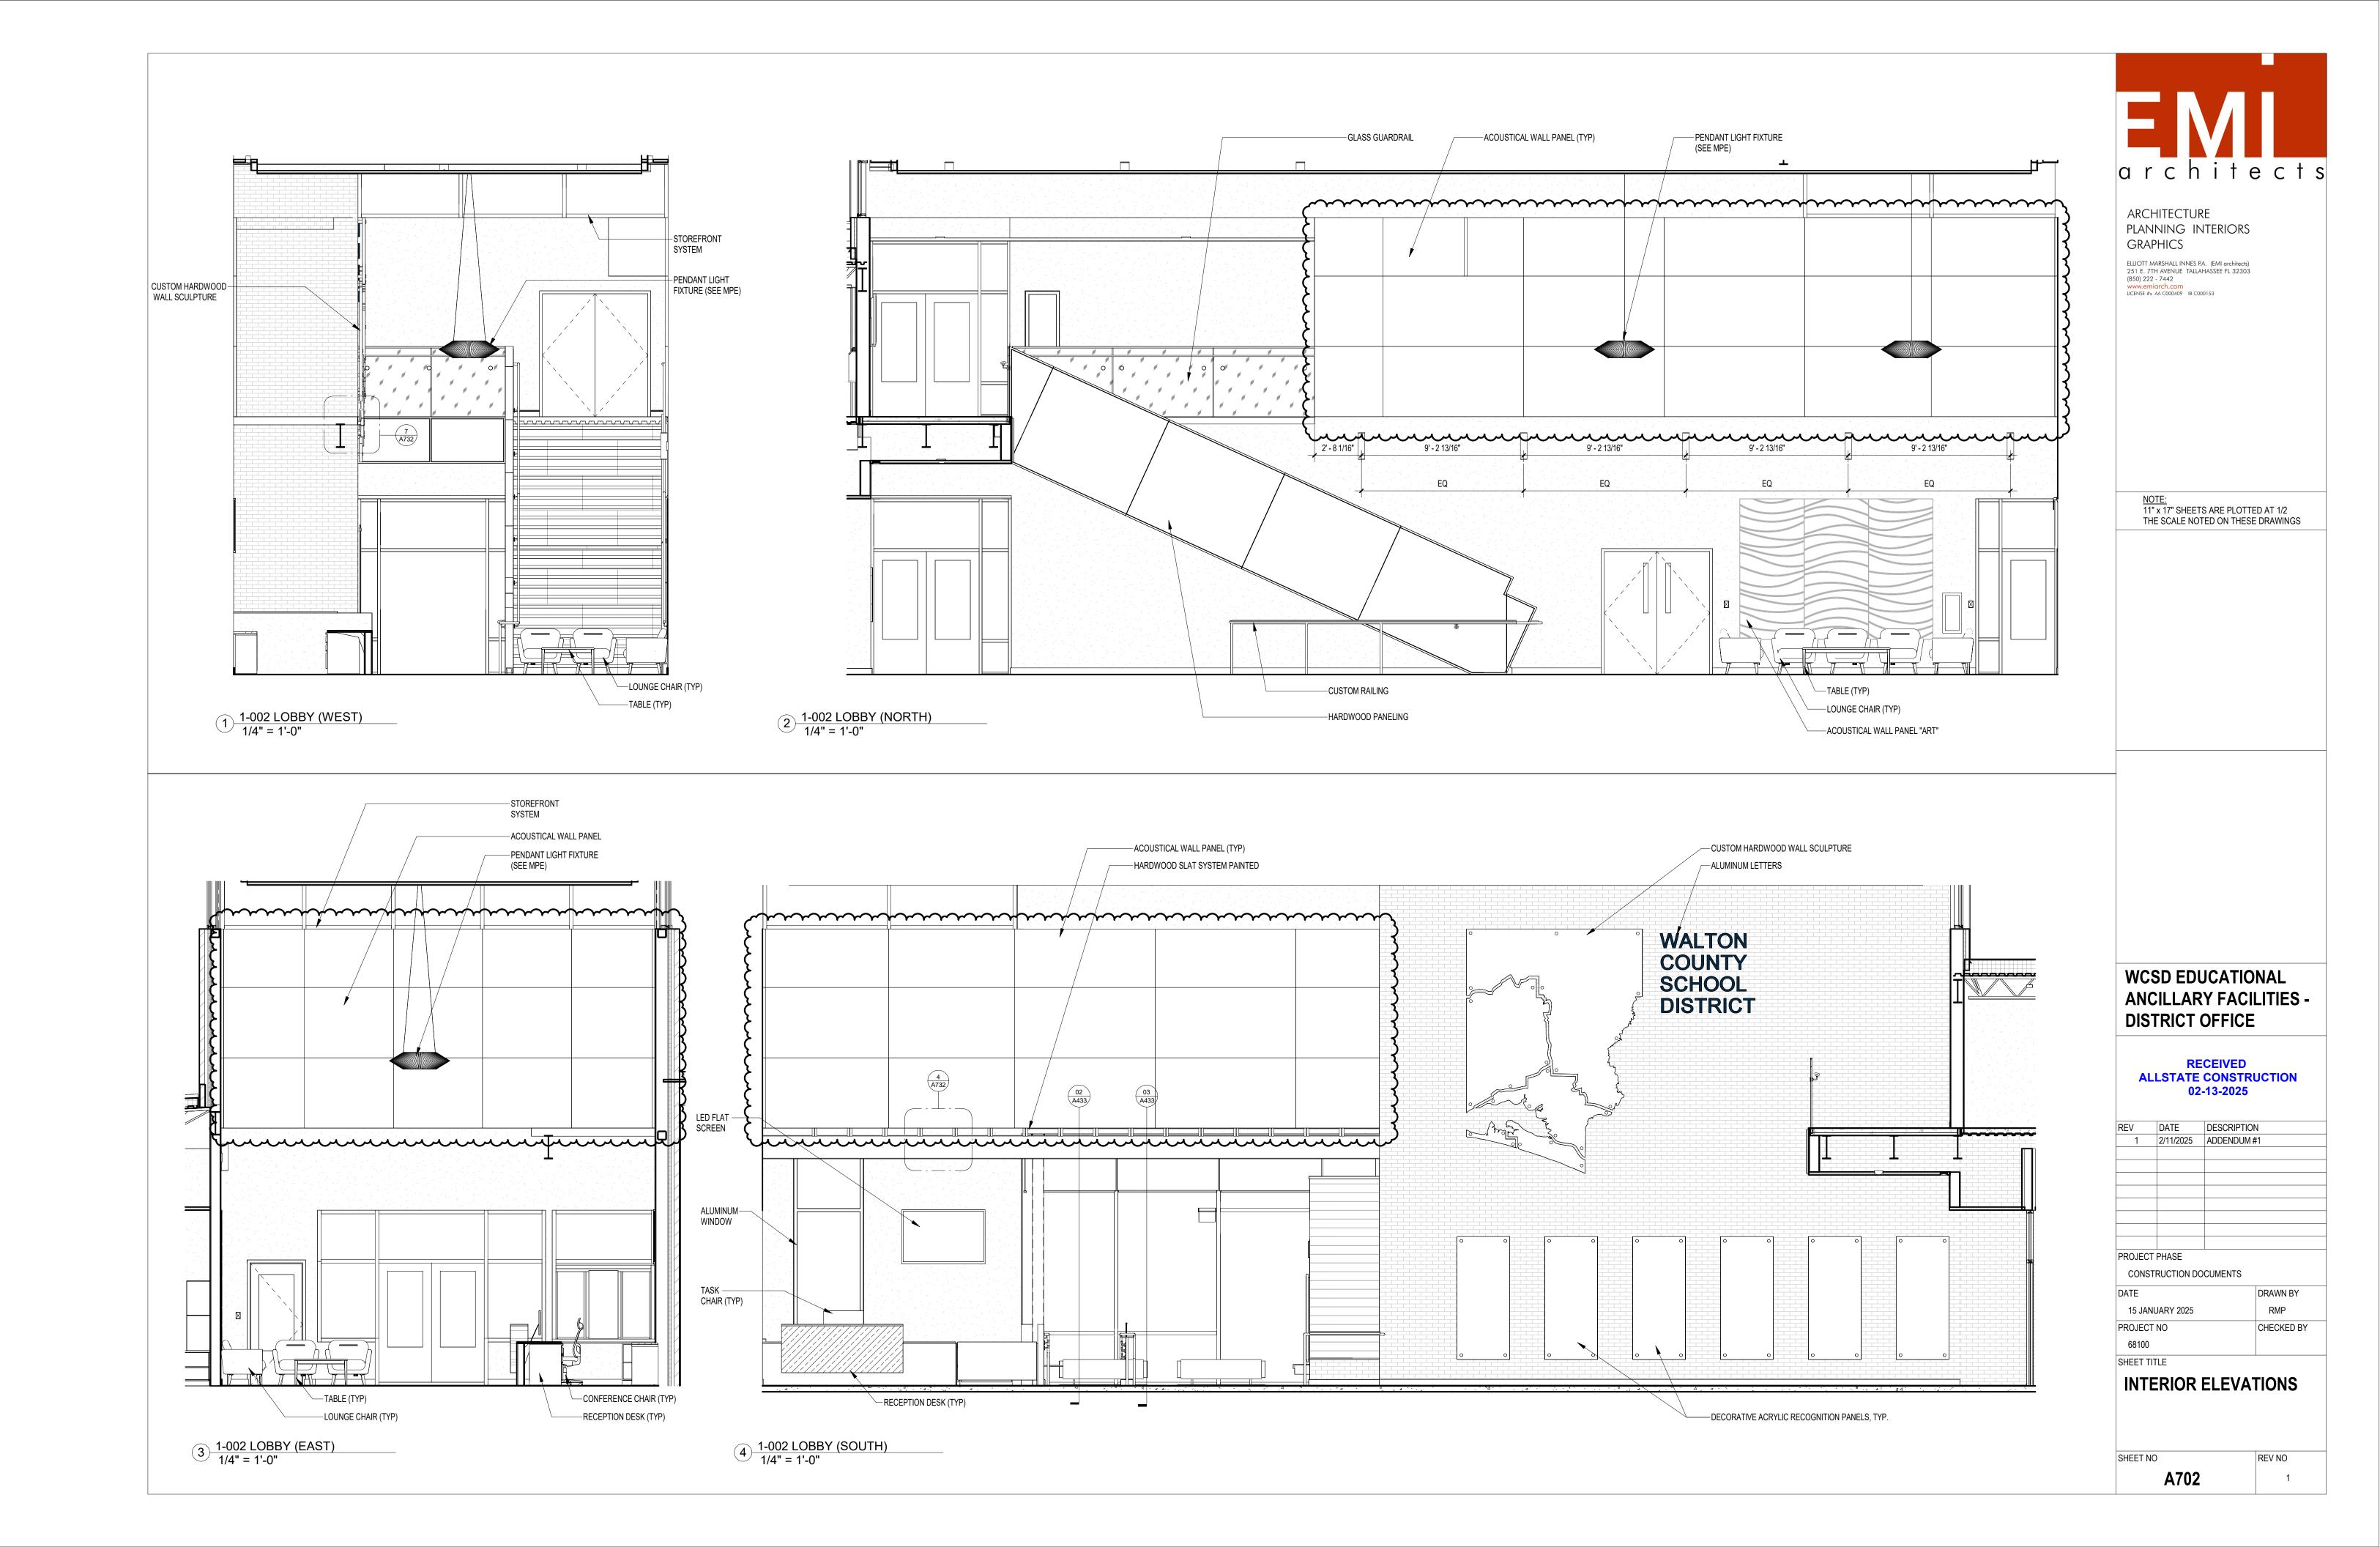


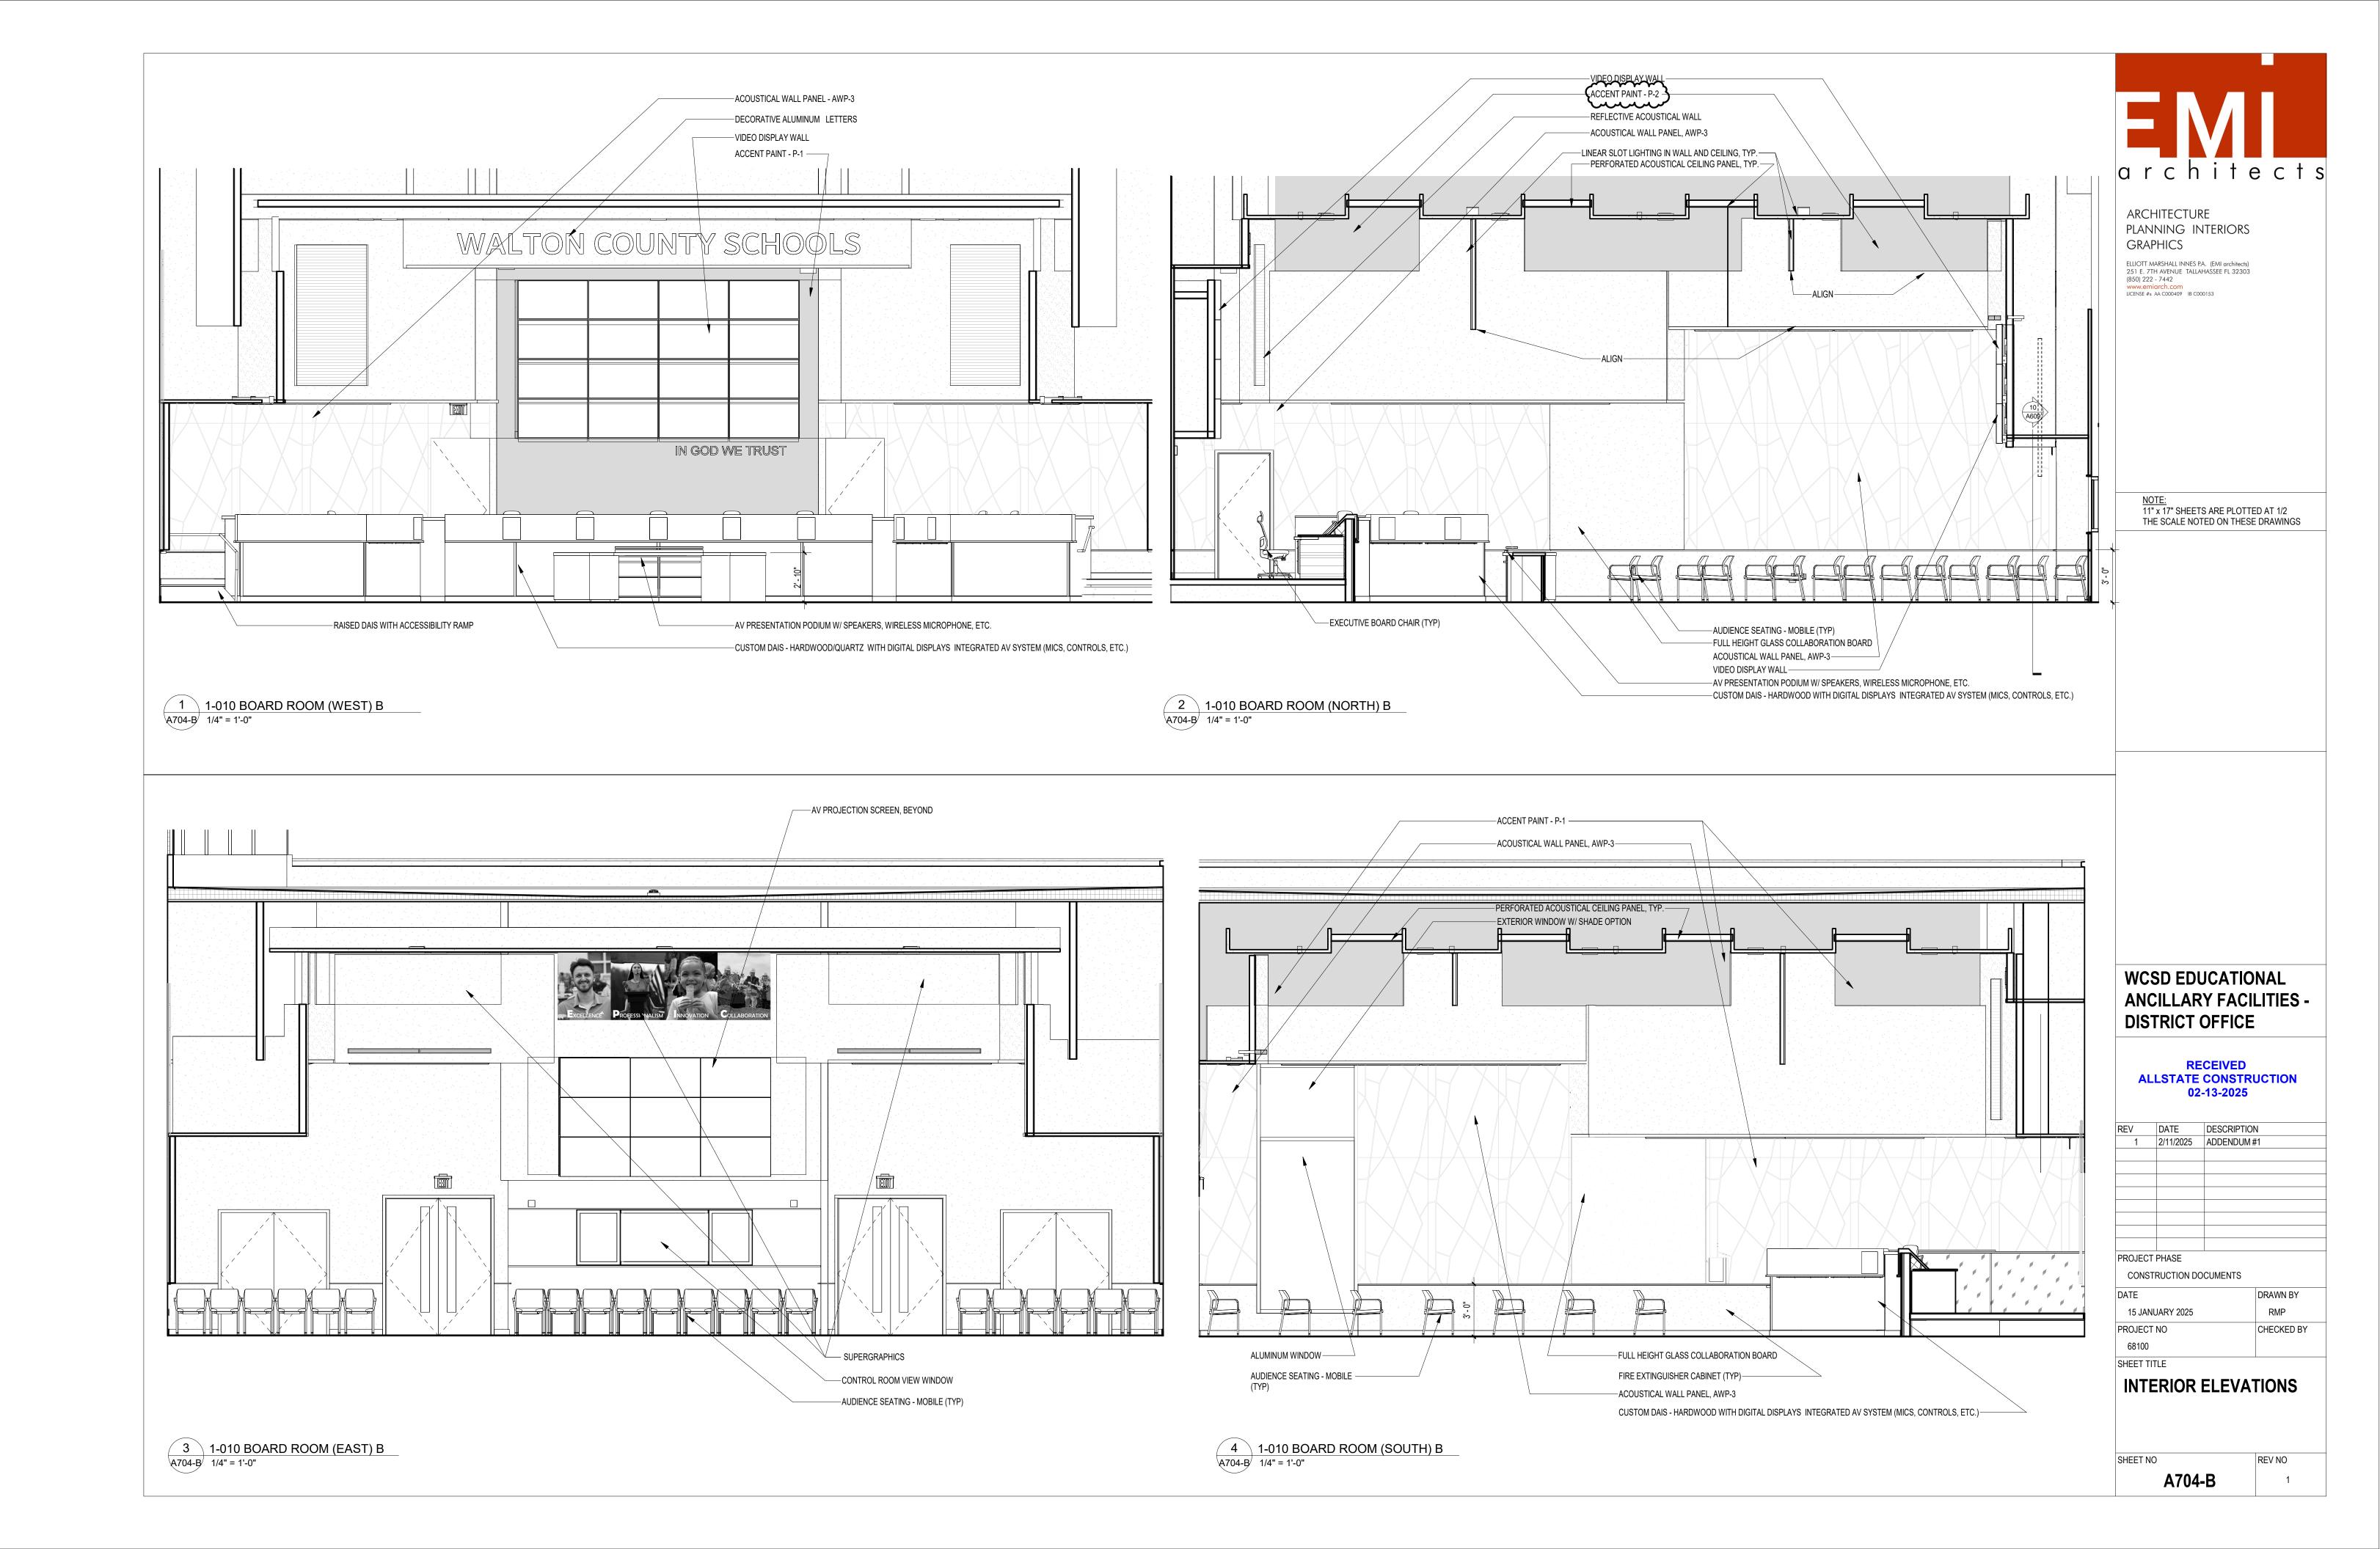

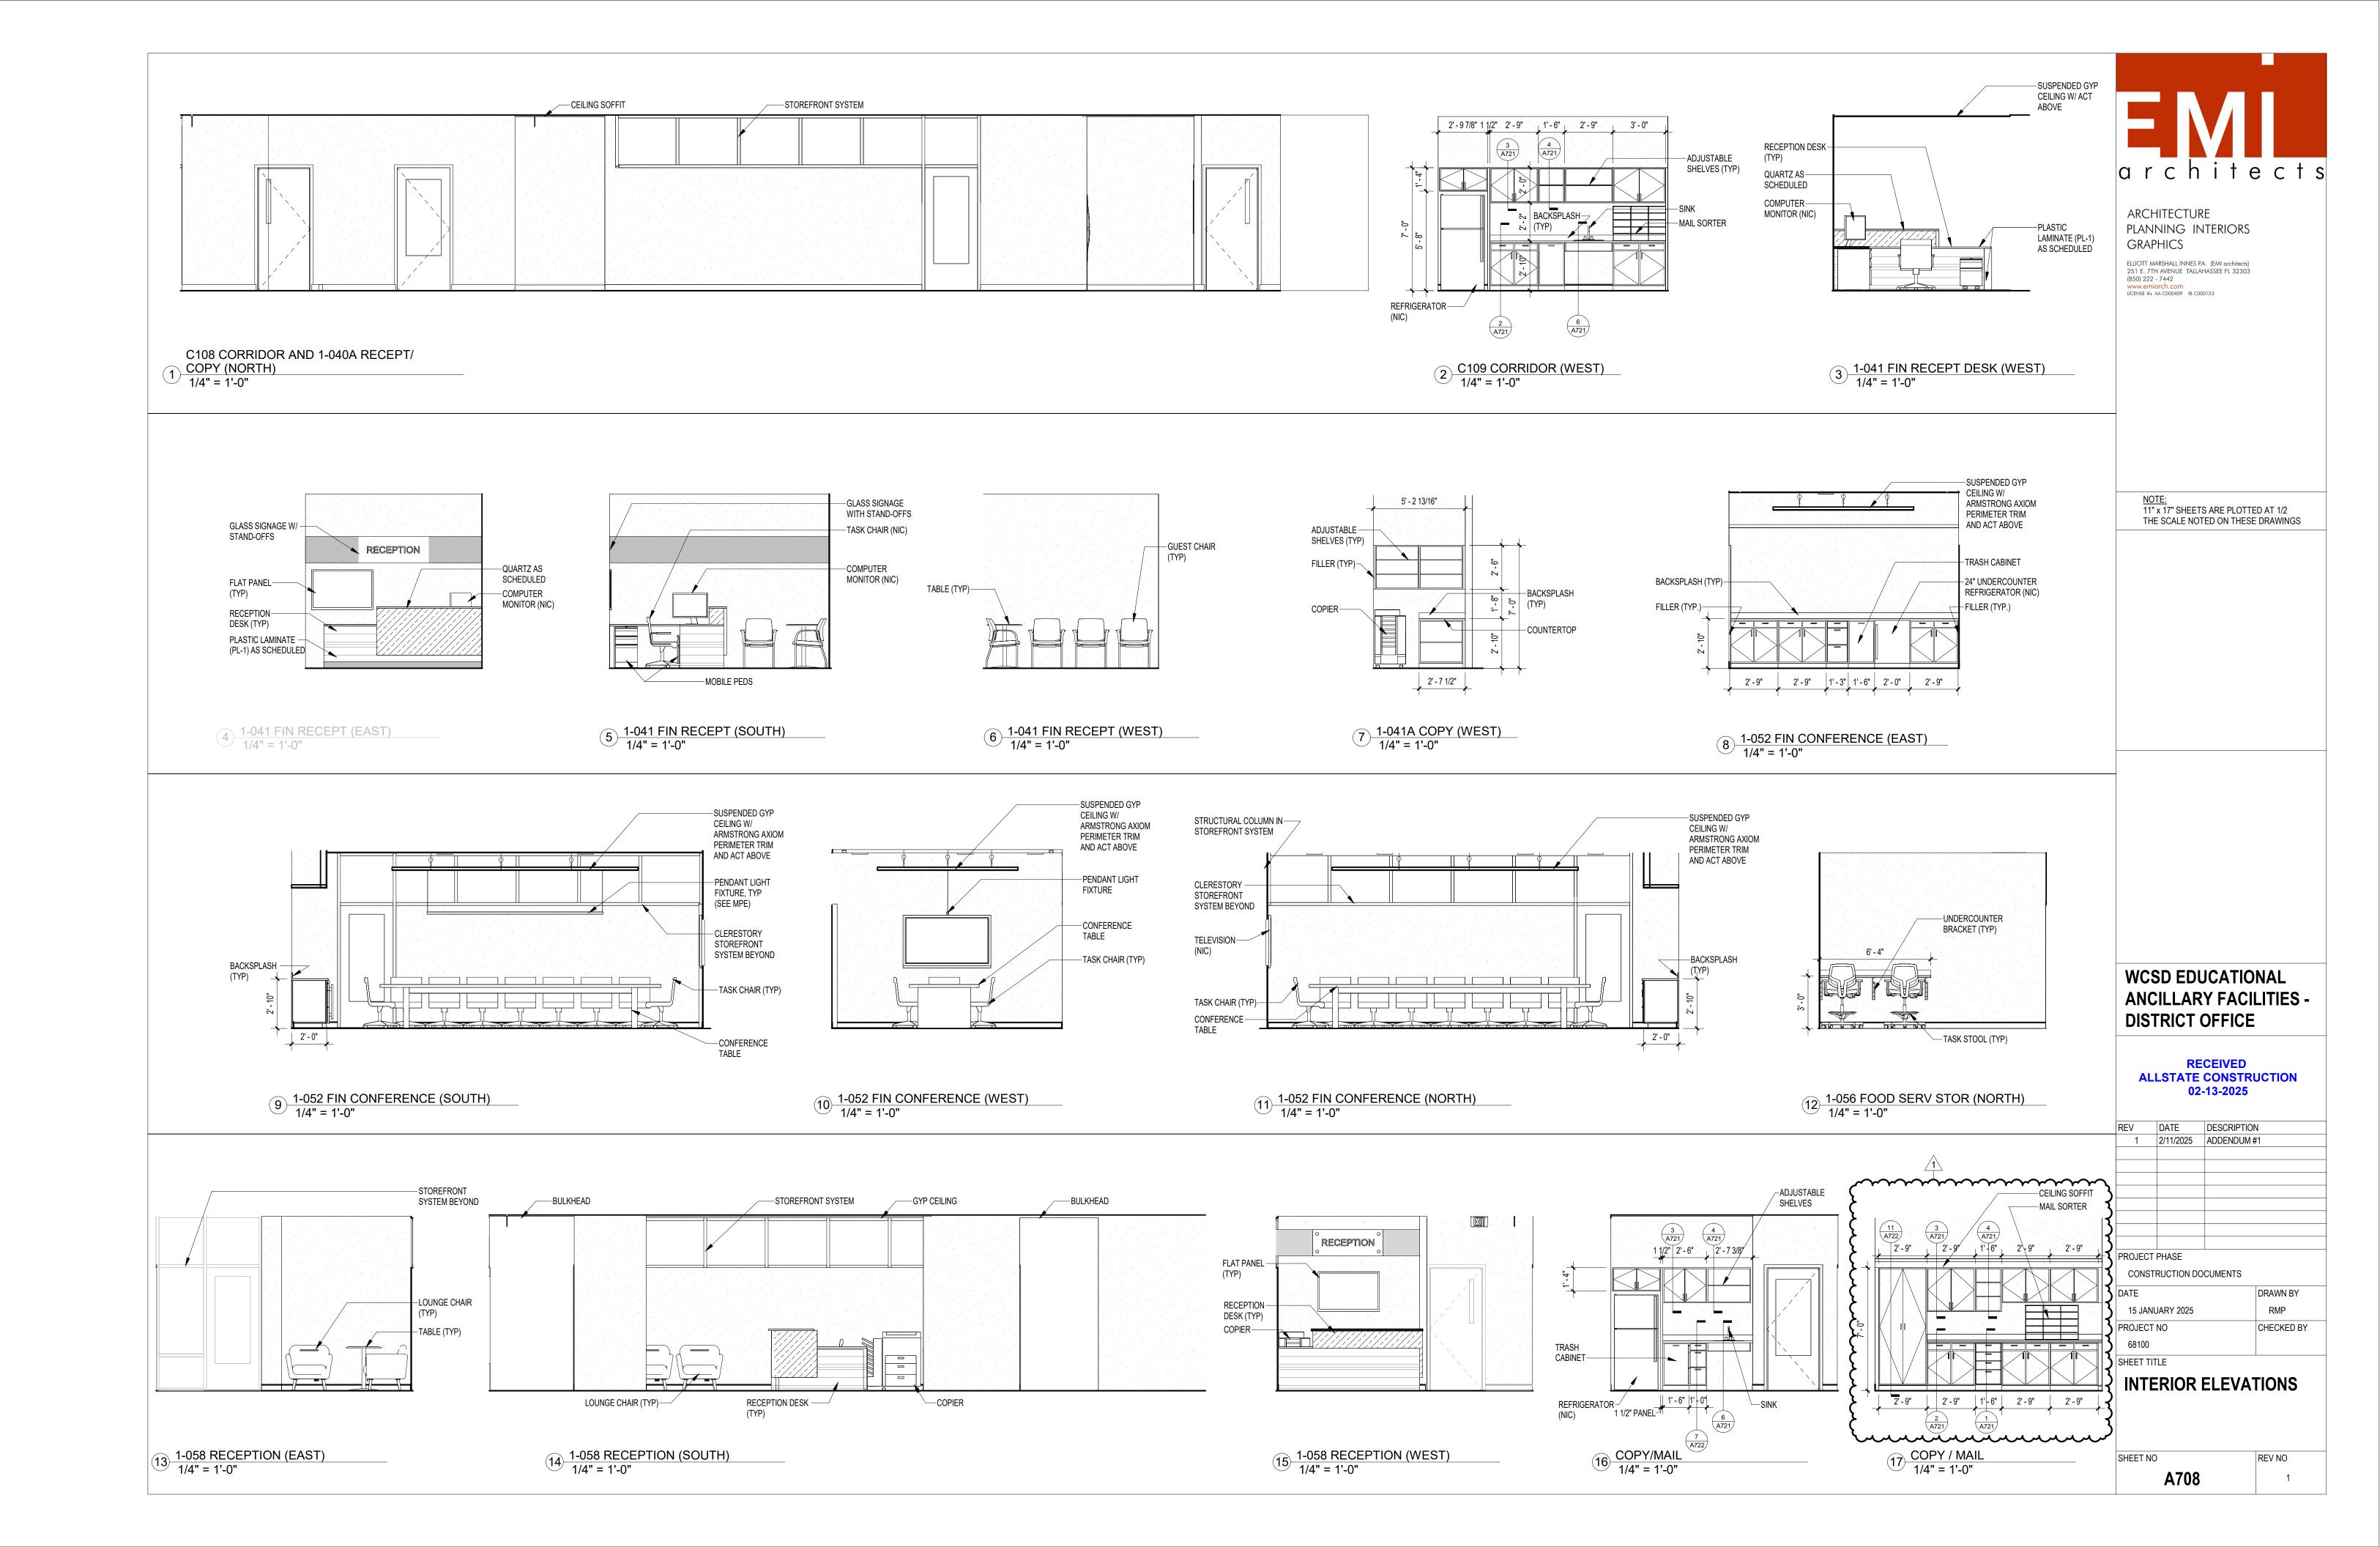

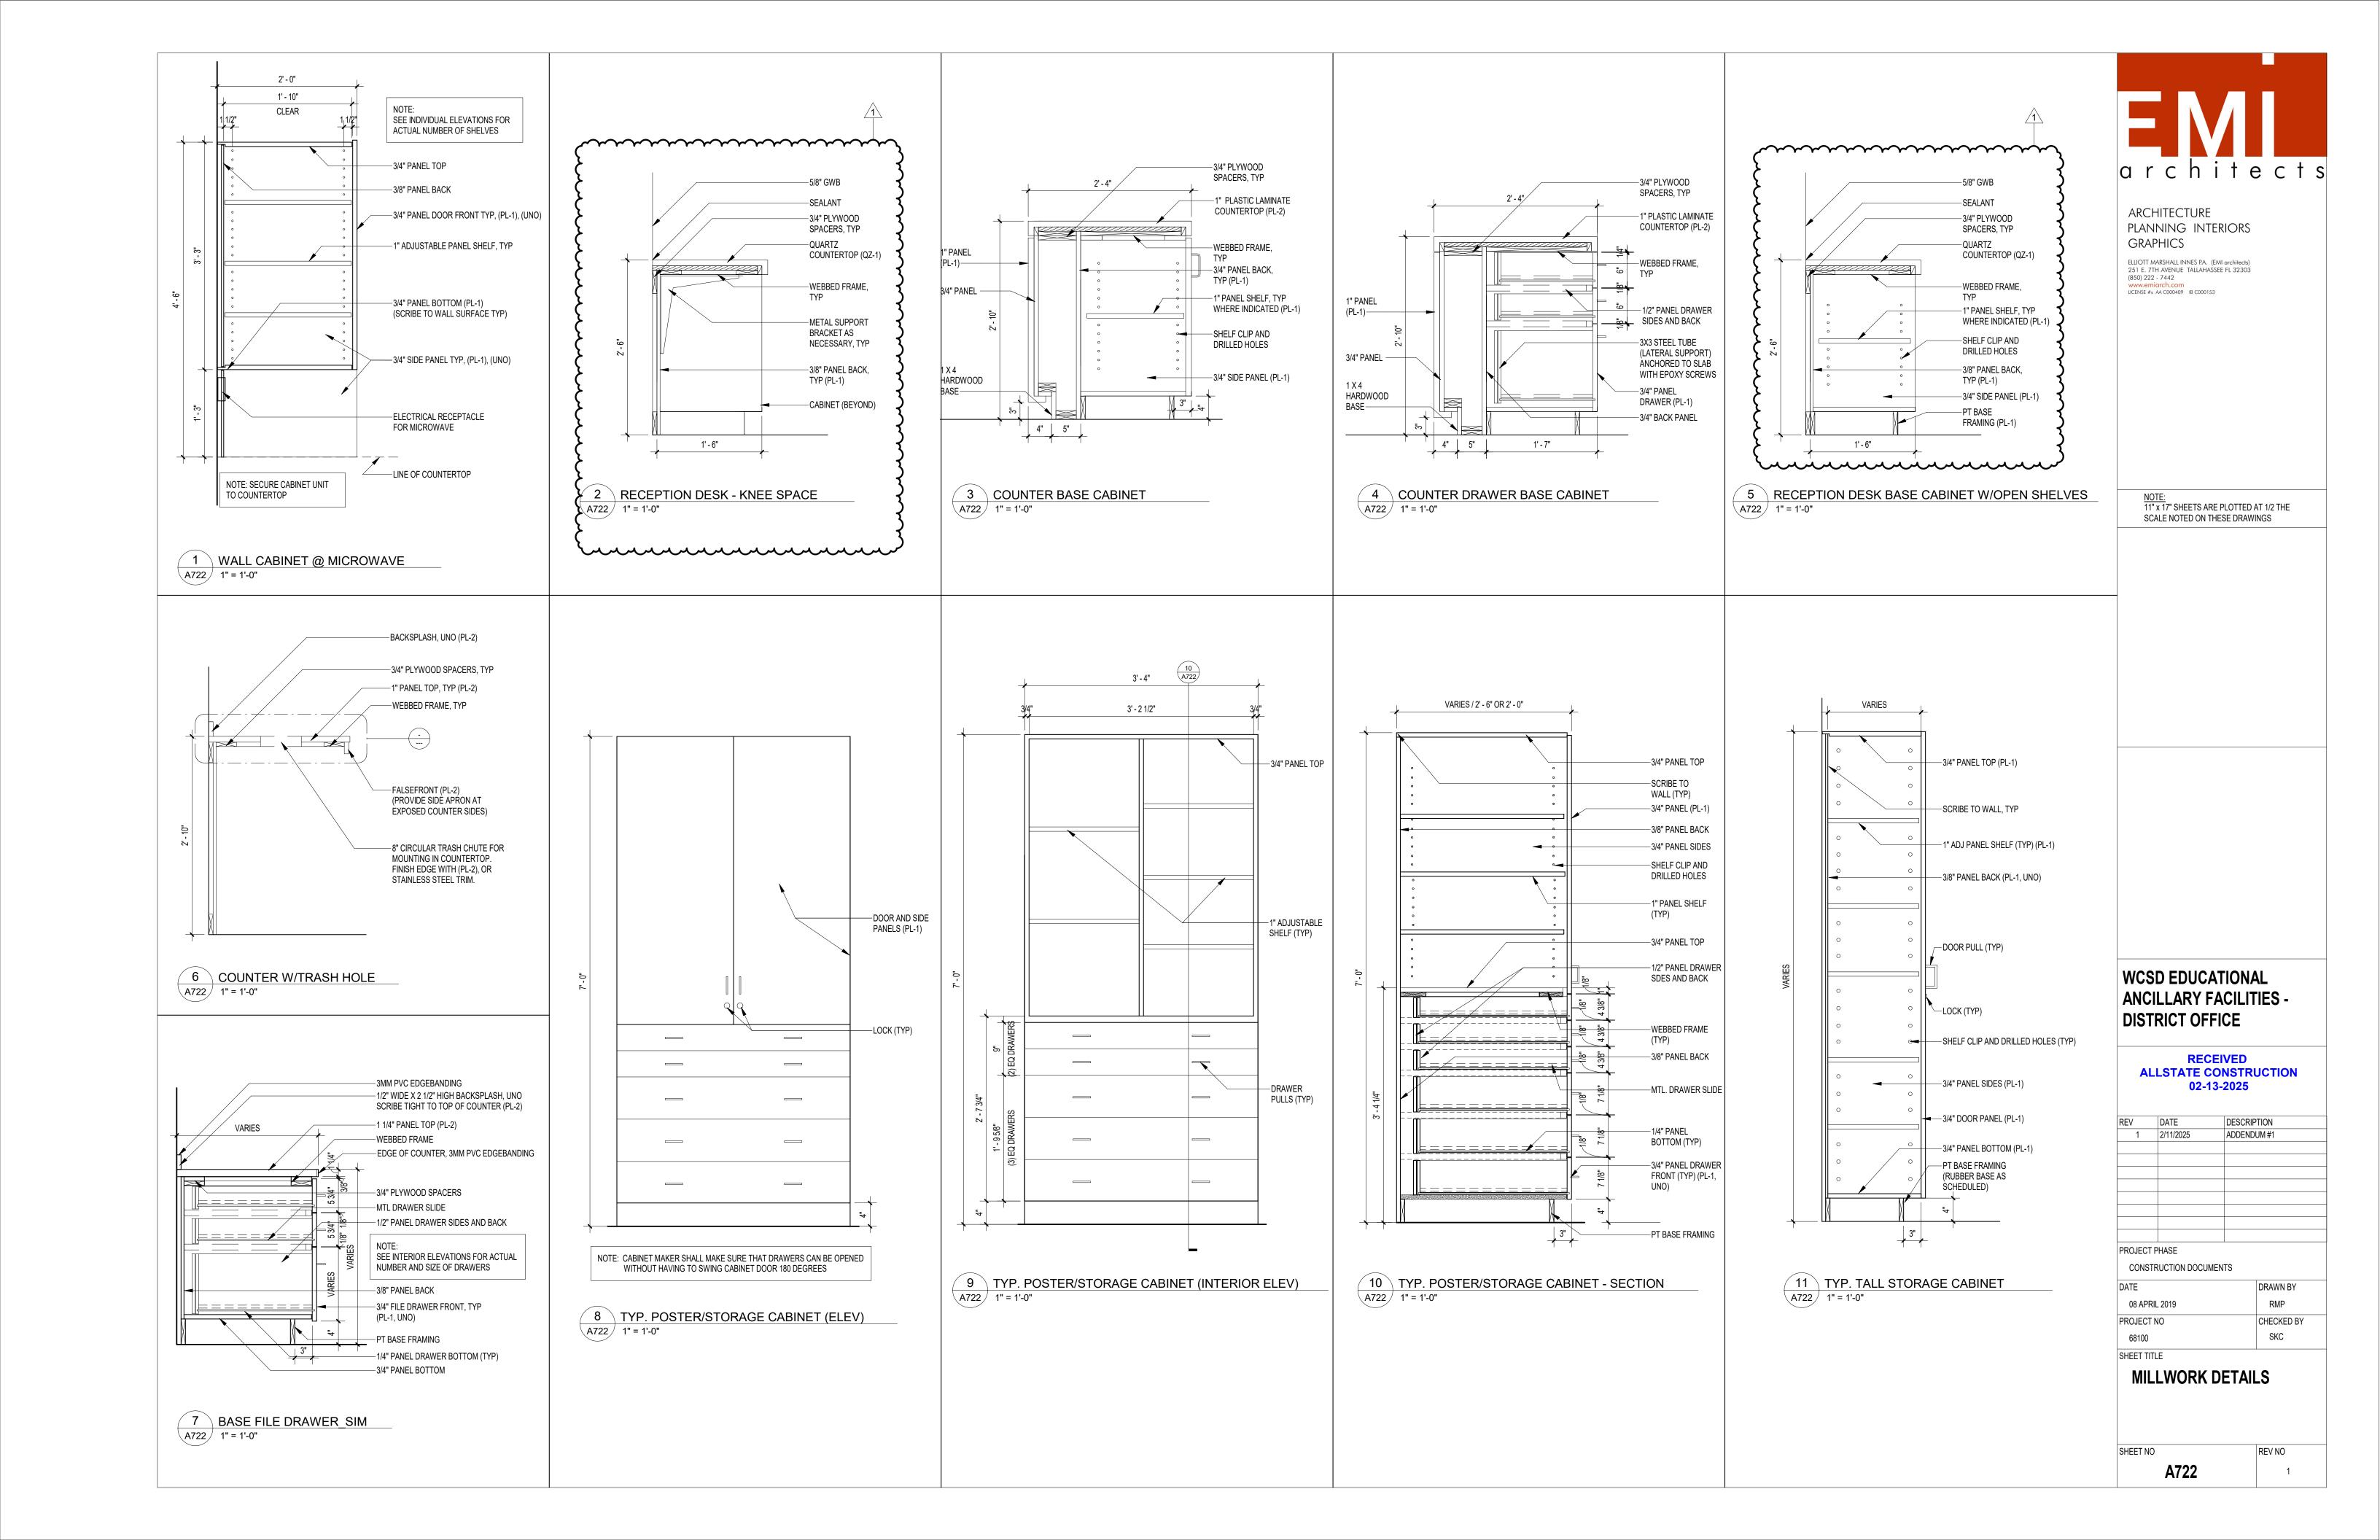

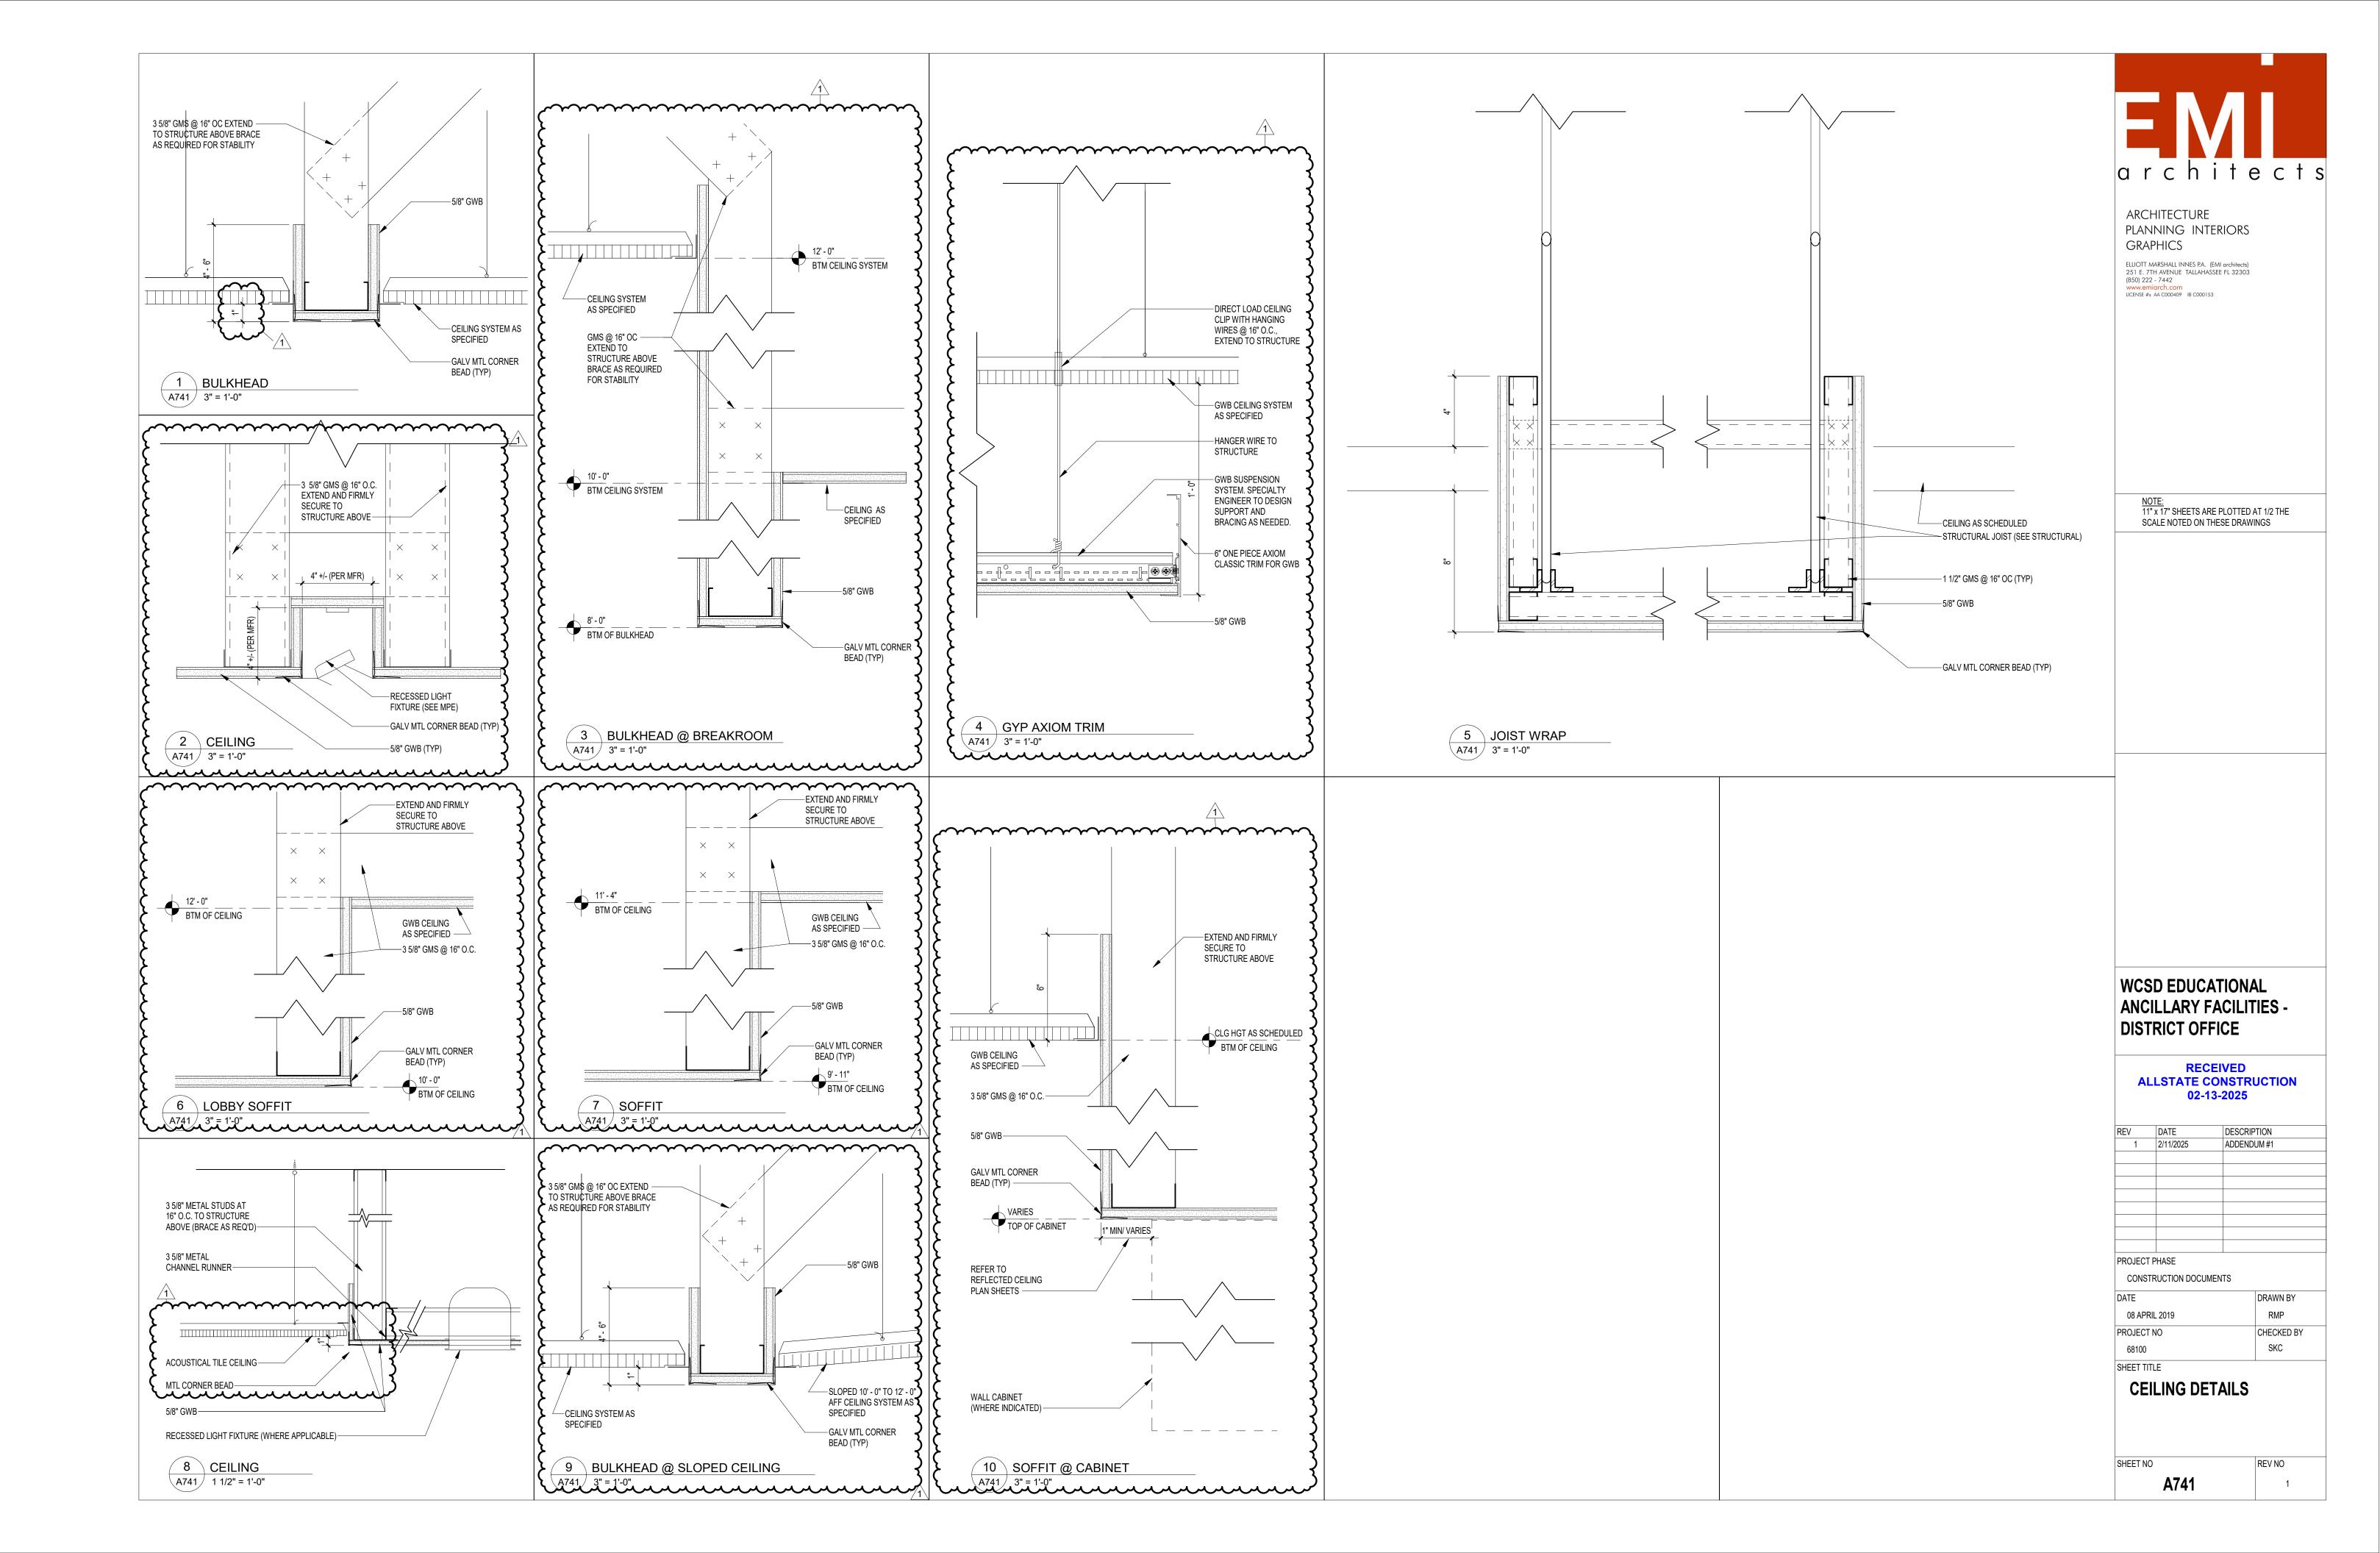

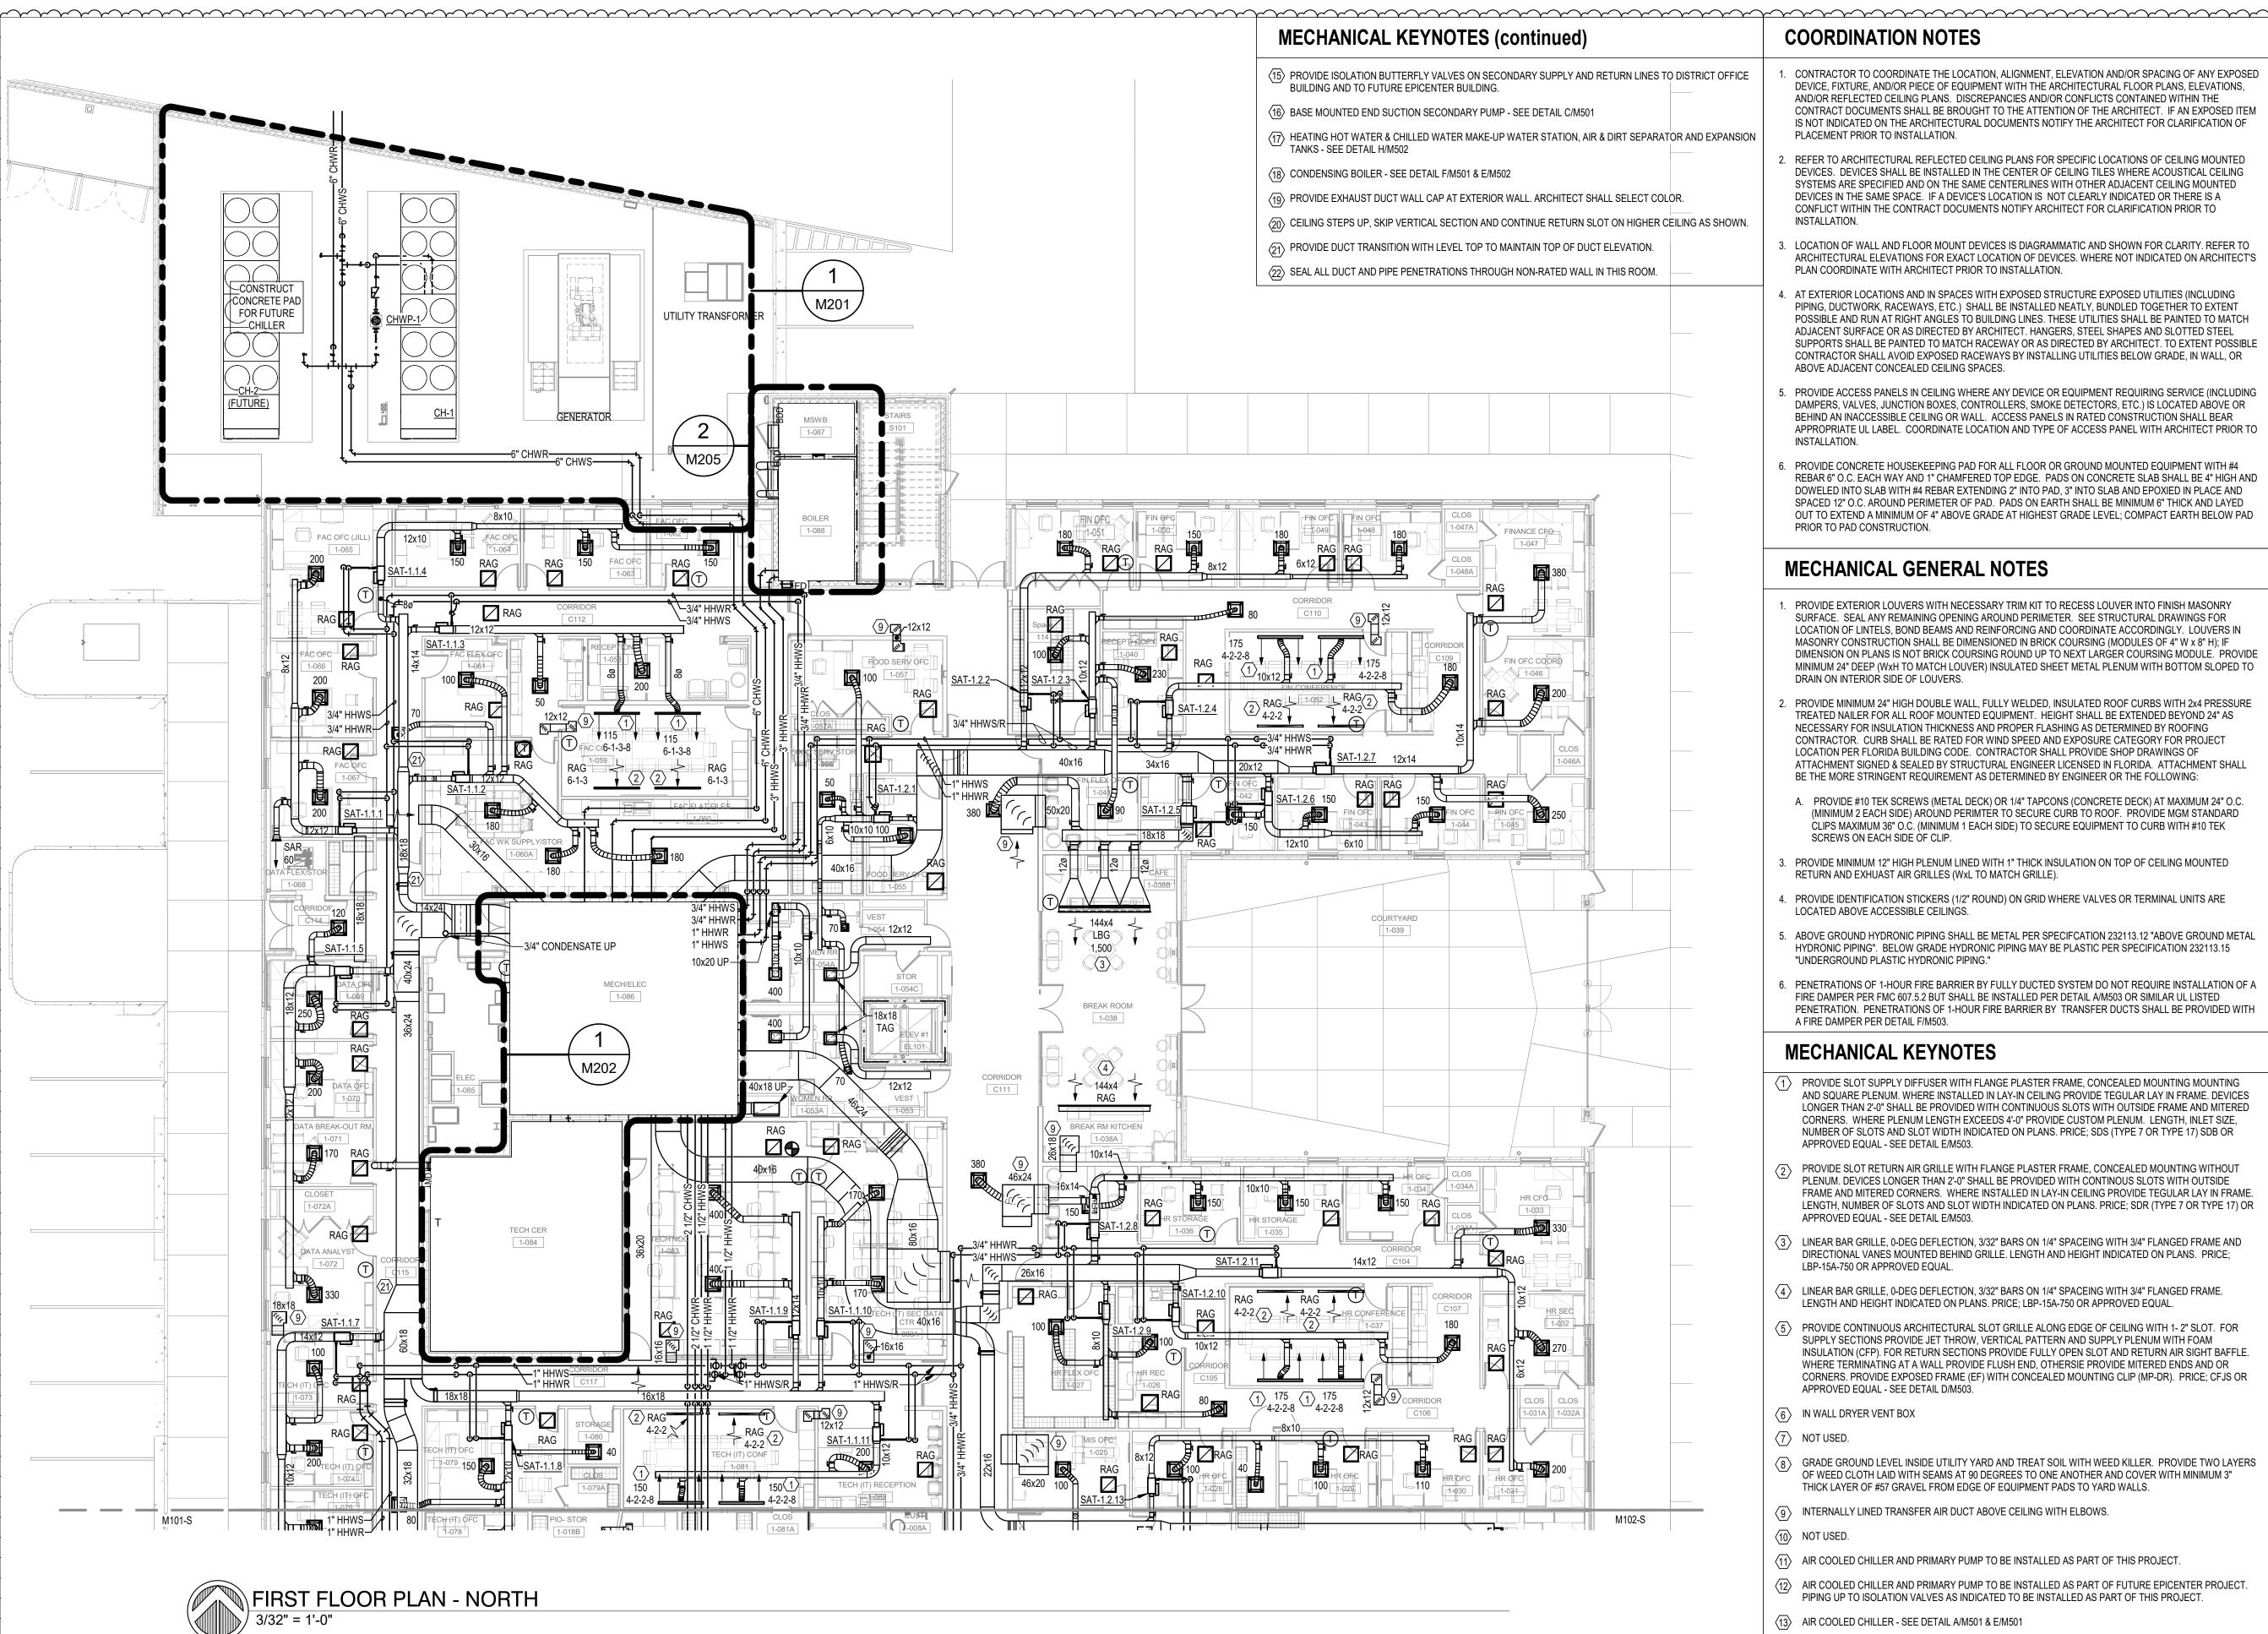

and the contraction of the contr

COORDINATION NOTES

- CONTRACTOR TO COORDINATE THE LOCATION, ALIGNMENT, ELEVATION AND/OR SPACING OF ANY EXPOSED DEVICE, FIXTURE, AND/OR PIECE OF EQUIPMENT WITH THE ARCHITECTURAL FLOOR PLANS, ELEVATIONS. AND/OR REFLECTED CEILING PLANS. DISCREPANCIES AND/OR CONFLICTS CONTAINED WITHIN THE CONTRACT DOCUMENTS SHALL BE BROUGHT TO THE ATTENTION OF THE ARCHITECT. IF AN EXPOSED ITEM IS NOT INDICATED ON THE ARCHITECTURAL DOCUMENTS NOTIFY THE ARCHITECT FOR CLARIFICATION OF PLACEMENT PRIOR TO INSTALLATION.
- REFER TO ARCHITECTURAL REFLECTED CEILING PLANS FOR SPECIFIC LOCATIONS OF CEILING MOUNTED DEVICES. DEVICES SHALL BE INSTALLED IN THE CENTER OF CEILING TILES WHERE ACOUSTICAL CEILING SYSTEMS ARE SPECIFIED AND ON THE SAME CENTERLINES WITH OTHER ADJACENT CEILING MOUNTED DEVICES IN THE SAME SPACE. IF A DEVICE'S LOCATION IS NOT CLEARLY INDICATED OR THERE IS A CONFLICT WITHIN THE CONTRACT DOCUMENTS NOTIFY ARCHITECT FOR CLARIFICATION PRIOR TO INSTALLATION.
- LOCATION OF WALL AND FLOOR MOUNT DEVICES IS DIAGRAMMATIC AND SHOWN FOR CLARITY. REFER TO ARCHITECTURAL ELEVATIONS FOR EXACT LOCATION OF DEVICES. WHERE NOT INDICATED ON ARCHITECT'S PLAN COORDINATE WITH ARCHITECT PRIOR TO INSTALLATION.
- AT EXTERIOR LOCATIONS AND IN SPACES WITH EXPOSED STRUCTURE EXPOSED UTILITIES (INCLUDING PIPING, DUCTWORK, RACEWAYS, ETC.) SHALL BE INSTALLED NEATLY, BUNDLED TOGETHER TO EXTENT POSSIBLE AND RUN AT RIGHT ANGLES TO BUILDING LINES. THESE UTILITIES SHALL BE PAINTED TO MATCH ADJACENT SURFACE OR AS DIRECTED BY ARCHITECT. HANGERS, STEEL SHAPES AND SLOTTED STEEL SUPPORTS SHALL BE PAINTED TO MATCH RACEWAY OR AS DIRECTED BY ARCHITECT. TO EXTENT POSSIBLE CONTRACTOR SHALL AVOID EXPOSED RACEWAYS BY INSTALLING UTILITIES BELOW GRADE, IN WALL, OR ABOVE ADJACENT CONCEALED CEILING SPACES.
- PROVIDE ACCESS PANELS IN CEILING WHERE ANY DEVICE OR EQUIPMENT REQUIRING SERVICE (INCLUDING DAMPERS, VALVES, JUNCTION BOXES, CONTROLLERS, SMOKE DETECTORS, ETC.) IS LOCATED ABOVE OR BEHIND AN INACCESSIBLE CEILING OR WALL. ACCESS PANELS IN RATED CONSTRUCTION SHALL BEAR APPROPRIATE UL LABEL. COORDINATE LOCATION AND TYPE OF ACCESS PANEL WITH ARCHITECT PRIOR TO INSTALLATION.
- PROVIDE CONCRETE HOUSEKEEPING PAD FOR ALL FLOOR OR GROUND MOUNTED EQUIPMENT WITH #4 REBAR 6" O.C. EACH WAY AND 1" CHAMFERED TOP EDGE. PADS ON CONCRETE SLAB SHALL BE 4" HIGH AND DOWELED INTO SLAB WITH #4 REBAR EXTENDING 2" INTO PAD. 3" INTO SLAB AND EPOXIED IN PLACE AND SPACED 12" O.C. AROUND PERIMETER OF PAD. PADS ON EARTH SHALL BE MINIMUM 6" THICK AND LAYED OUT TO EXTEND A MINIMUM OF 4" ABOVE GRADE AT HIGHEST GRADE LEVEL; COMPACT EARTH BELOW PAD PRIOR TO PAD CONSTRUCTION.

MECHANICAL GENERAL NOTES

- PROVIDE EXTERIOR LOUVERS WITH NECESSARY TRIM KIT TO RECESS LOUVER INTO FINISH MASONRY SURFACE. SEAL ANY REMAINING OPENING AROUND PERIMETER. SEE STRUCTURAL DRAWINGS FOR LOCATION OF LINTELS. BOND BEAMS AND REINFORCING AND COORDINATE ACCORDINGLY. LOUVERS IN MASONRY CONSTRUCTION SHALL BE DIMENSIONED IN BRICK COURSING (MODULES OF 4" W x 8" H); IF DIMENSION ON PLANS IS NOT BRICK COURSING ROUND UP TO NEXT LARGER COURSING MODULE. PROVIDE MINIMUM 24" DEEP (WxH TO MATCH LOUVER) INSULATED SHEET METAL PLENUM WITH BOTTOM SLOPED TO DRAIN ON INTERIOR SIDE OF LOUVERS.
- PROVIDE MINIMUM 24" HIGH DOUBLE WALL, FULLY WELDED, INSULATED ROOF CURBS WITH 2x4 PRESSURE TREATED NAILER FOR ALL ROOF MOUNTED EQUIPMENT. HEIGHT SHALL BE EXTENDED BEYOND 24" AS NECESSARY FOR INSULATION THICKNESS AND PROPER FLASHING AS DETERMINED BY ROOFING CONTRACTOR. CURB SHALL BE RATED FOR WIND SPEED AND EXPOSURE CATEGORY FOR PROJECT LOCATION PER FLORIDA BUILDING CODE. CONTRACTOR SHALL PROVIDE SHOP DRAWINGS OF ATTACHMENT SIGNED & SEALED BY STRUCTURAL ENGINEER LICENSED IN FLORIDA. ATTACHMENT SHALL BE THE MORE STRINGENT REQUIREMENT AS DETERMINED BY ENGINEER OR THE FOLLOWING
- PROVIDE #10 TEK SCREWS (METAL DECK) OR 1/4" TAPCONS (CONCRETE DECK) AT MAXIMUM 24" O.C. (MINIMUM 2 EACH SIDE) AROUND PERIMTER TO SECURE CURB TO ROOF. PROVIDE MGM STANDARD CLIPS MAXIMUM 36" O.C. (MINIMUM 1 EACH SIDE) TO SECURE EQUIPMENT TO CURB WITH #10 TEK SCREWS ON EACH SIDE OF CLIP.
- PROVIDE MINIMUM 12" HIGH PLENUM LINED WITH 1" THICK INSULATION ON TOP OF CEILING MOUNTED RETURN AND EXHUAST AIR GRILLES (WxL TO MATCH GRILLE).
- 4. PROVIDE IDENTIFICATION STICKERS (1/2" ROUND) ON GRID WHERE VALVES OR TERMINAL UNITS ARE LOCATED ABOVE ACCESSIBLE CEILINGS.
- ABOVE GROUND HYDRONIC PIPING SHALL BE METAL PER SPECIFCATION 232113.12 "ABOVE GROUND METAL HYDRONIC PIPING". BELOW GRADE HYDRONIC PIPING MAY BE PLASTIC PER SPECIFICATION 232113.15 "UNDERGROUND PLASTIC HYDRONIC PIPING."
- PENETRATIONS OF 1-HOUR FIRE BARRIER BY FULLY DUCTED SYSTEM DO NOT REQUIRE INSTALLATION OF A FIRE DAMPER PER FMC 607.5.2 BUT SHALL BE INSTALLED PER DETAIL A/M503 OR SIMILAR UL LISTED PENETRATION. PENETRATIONS OF 1-HOUR FIRE BARRIER BY TRANSFER DUCTS SHALL BE PROVIDED WITH A FIRE DAMPER PER DETAIL F/M503.

MECHANICAL KEYNOTES

- 1 PROVIDE SLOT SUPPLY DIFFUSER WITH FLANGE PLASTER FRAME, CONCEALED MOUNTING MOUNTING AND SQUARE PLENUM. WHERE INSTALLED IN LAY-IN CEILING PROVIDE TEGULAR LAY IN FRAME. DEVICES LONGER THAN 2'-0" SHALL BE PROVIDED WITH CONTINUOUS SLOTS WITH OUTSIDE FRAME AND MITERED CORNERS. WHERE PLENUM LENGTH EXCEEDS 4'-0" PROVIDE CUSTOM PLENUM. LENGTH, INLET SIZE, NUMBER OF SLOTS AND SLOT WIDTH INDICATED ON PLANS. PRICE; SDS (TYPE 7 OR TYPE 17) SDB OR APPROVED EQUAL - SEE DETAIL E/M503.
- 2 PROVIDE SLOT RETURN AIR GRILLE WITH FLANGE PLASTER FRAME, CONCEALED MOUNTING WITHOUT PLENUM. DEVICES LONGER THAN 2'-0" SHALL BE PROVIDED WITH CONTINOUS SLOTS WITH OUTSIDE FRAME AND MITERED CORNERS. WHERE INSTALLED IN LAY-IN CEILING PROVIDE TEGULAR LAY IN FRAME. LENGTH, NUMBER OF SLOTS AND SLOT WIDTH INDICATED ON PLANS. PRICE; SDR (TYPE 7 OR TYPE 17) OR APPROVED EQUAL - SEE DETAIL E/M503.
- (3) LINEAR BAR GRILLE, 0-DEG DEFLECTION, 3/32" BARS ON 1/4" SPACEING WITH 3/4" FLANGED FRAME AND DIRECTIONAL VANES MOUNTED BEHIND GRILLE. LENGTH AND HEIGHT INDICATED ON PLANS. PRICE; LBP-15A-750 OR APPROVED EQUAL.
- 4 LINEAR BAR GRILLE, 0-DEG DEFLECTION, 3/32" BARS ON 1/4" SPACEING WITH 3/4" FLANGED FRAME. LENGTH AND HEIGHT INDICATED ON PLANS. PRICE; LBP-15A-750 OR APPROVED EQUAL
- (5) PROVIDE CONTINUOUS ARCHITECTURAL SLOT GRILLE ALONG EDGE OF CEILING WITH 1- 2" SLOT. FOR SUPPLY SECTIONS PROVIDE JET THROW, VERTICAL PATTERN AND SUPPLY PLENUM WITH FOAM INSULATION (CFP). FOR RETURN SECTIONS PROVIDE FULLY OPEN SLOT AND RETURN AIR SIGHT BAFFLE. WHERE TERMINATING AT A WALL PROVIDE FLUSH END, OTHERSIE PROVIDE MITERED ENDS AND OR CORNERS. PROVIDE EXPOSED FRAME (EF) WITH CONCEALED MOUNTING CLIP (MP-DR). PRICE; CFJS OR APPROVED EQUAL - SEE DETAIL D/M503.
- (6) IN WALL DRYER VENT BOX
- $\langle 7 \rangle$ NOT USED.
- $\langle 8 \rangle$ GRADE GROUND LEVEL INSIDE UTILITY YARD AND TREAT SOIL WITH WEED KILLER. PROVIDE TWO LAYERS OF WEED CLOTH LAID WITH SEAMS AT 90 DEGREES TO ONE ANOTHER AND COVER WITH MINIMUM 3" THICK LAYER OF #57 GRAVEL FROM EDGE OF EQUIPMENT PADS TO YARD WALLS.
- (9) INTERNALLY LINED TRANSFER AIR DUCT ABOVE CEILING WITH ELBOWS
- (10) NOT USED.
- AIR COOLED CHILLER AND PRIMARY PUMP TO BE INSTALLED AS PART OF THIS PROJECT.
- (12) AIR COOLED CHILLER AND PRIMARY PUMP TO BE INSTALLED AS PART OF FUTURE EPICENTER PROJECT. PIPING UP TO ISOLATION VALVES AS INDICATED TO BE INSTALLED AS PART OF THIS PROJECT.
- AIR COOLED CHILLER SEE DETAIL A/M501 & E/M501
- (14) VERTICAL INLINE PRIMARY PUMP SEE DETAIL B/M501




ARCHITECTURE PLANNING INTERIORS GRAPHICS

LLIOTT MARSHALL INNES P.A. (EMI architects) 251 E. 7TH AVENUE TALLAHASSEE FL 32303

ICENSE #s AA C000409 IB C000153

1" x 17" SHEETS ARE PLOTTED AT 1/2 THE SCALE NOTED ON THESE DRAWINGS.

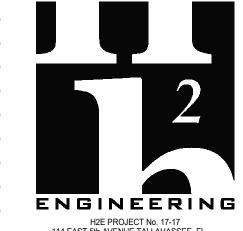

114 EAST 5th AVENUE TALLAHASSEE, FL 32303 PHONE 850.224.7922 THIS DOCUMENT IS THE PROPERTY OF H2Engineering AND IS PREPARED AS AN INSTRUMENT OF SERVICE. ITS

JSE. REUSE OR REPRODUCTION, EXCEPT BY WRITTEN AGREEMENT WITH H2Engineering, IS PROHIBITED. Florida Registry #2485 Jeffrey L. Tyler, P.E. #57093

Jeffrey Lee Tyler, State of Florida, ofessional Engineer, License No. **57093**

by Jeffrey Lee Tyler, P.E. on the date

This item has been digitally signed and sealed

Printed copies of this document are not considered signed and sealed, and the signature must be verified on any electronic

Date: 02/10/2025

WCSD EDUCATIONAL ANCILLARY FACILITIES -DISTRICT OFFICE

RECEIVED **ALLSTATE CONSTRUCTION** 02-13-2025

REV	DATE	DESCRIPTION		
∤ 1	2/11/2025	ADDENDUM #1		
)				
ß				
K				
2				
3				
ξ				
K				
\triangleright				
PROJECT PHASE				
CONSTRUCTION DOCUMENTS				

CONSTRUCTION DOCUMENTS

	4	
	PATE	DRAWN BY
')15 JANUARY 2025	JDR
ļ	PROJECT NO	CHECKED BY
-	68100	JLT

SHEET TITLE

FIRST FLOOR PLAN **NORTH**

REV NO M101-N

NORTH

MECHANICAL KEYNOTES (continued)

- $\langle \overline{15}
 angle$ PROVIDE ISOLATION BUTTERFLY VALVES ON SECONDARY SUPPLY AND RETURN LINES TO DISTRICT OFFICE BUILDING AND TO FUTURE EPICENTER BUILDING.
- (16) BASE MOUNTED END SUCTION SECONDARY PUMP SEE DETAIL C/M501
- (17) HEATING HOT WATER & CHILLED WATER MAKE-UP WATER STATION, AIR & DIRT SEPARATOR AND EXPANSION TANKS - SEE DETAIL H/M502

24x12

48x4

AHU-2.3

■11'-0" 48x4 JAFF LBG → 300

SECURE LOBBY 1-001

12'-0" 48x4 | 12'-0" 48x4

⊢AFF LBG ✔ AFF LBG ↓

ROTONDA / GALLERY

1-002A

10x10

RAG

4-3-3-10

4-3-3-10

1-011A RAG

14x14 (9)

4-3-3-10

-18x18 UP

TO EF-1.2 70

18x18

-40x24 UP 24x24-

28x24

AHU-2.2

─24x28 UP

1 1 3/4" HHWS

∕−18x18 UP

BOARD ROOM

1-010

SEE SHEET M102-S

FOR DUCTWORK

ABOVE

10" TAKEOFF AND DROP FROM

a a fille a fi

36x36 SA DUCT FROM AHU-2.2

⁻⁻⁻24x12

- (18) CONDENSING BOILER SEE DETAIL F/M501 & E/M502
- (19) PROVIDE EXHAUST DUCT WALL CAP AT EXTERIOR WALL. ARCHITECT SHALL SELECT COLOR.
- (20) CEILING STEPS UP, SKIP VERTICAL SECTION AND CONTINUE RETURN SLOT ON HIGHER CEILING AS SHOWN.
- $\langle 21 \rangle$ PROVIDE DUCT TRANSITION WITH LEVEL TOP TO MAINTAIN TOP OF DUCT ELEVATION.
- (22) SEAL ALL DUCT AND PIPE PENETRATIONS THROUGH NON-RATED WALL IN THIS ROOM.

COORDINATION NOTES

- CONTRACTOR TO COORDINATE THE LOCATION, ALIGNMENT, ELEVATION AND/OR SPACING OF ANY EXPOSED DEVICE, FIXTURE, AND/OR PIECE OF EQUIPMENT WITH THE ARCHITECTURAL FLOOR PLANS, ELEVATIONS. AND/OR REFLECTED CEILING PLANS. DISCREPANCIES AND/OR CONFLICTS CONTAINED WITHIN THE CONTRACT DOCUMENTS SHALL BE BROUGHT TO THE ATTENTION OF THE ARCHITECT. IF AN EXPOSED ITEM IS NOT INDICATED ON THE ARCHITECTURAL DOCUMENTS NOTIFY THE ARCHITECT FOR CLARIFICATION OF PLACEMENT PRIOR TO INSTALLATION.
- REFER TO ARCHITECTURAL REFLECTED CEILING PLANS FOR SPECIFIC LOCATIONS OF CEILING MOUNTED DEVICES. DEVICES SHALL BE INSTALLED IN THE CENTER OF CEILING TILES WHERE ACOUSTICAL CEILING SYSTEMS ARE SPECIFIED AND ON THE SAME CENTERLINES WITH OTHER ADJACENT CEILING MOUNTED DEVICES IN THE SAME SPACE. IF A DEVICE'S LOCATION IS NOT CLEARLY INDICATED OR THERE IS A CONFLICT WITHIN THE CONTRACT DOCUMENTS NOTIFY ARCHITECT FOR CLARIFICATION PRIOR TO INSTALLATION.
- LOCATION OF WALL AND FLOOR MOUNT DEVICES IS DIAGRAMMATIC AND SHOWN FOR CLARITY. REFER TO ARCHITECTURAL ELEVATIONS FOR EXACT LOCATION OF DEVICES. WHERE NOT INDICATED ON ARCHITECT'S PLAN COORDINATE WITH ARCHITECT PRIOR TO INSTALLATION.
- AT EXTERIOR LOCATIONS AND IN SPACES WITH EXPOSED STRUCTURE EXPOSED UTILITIES (INCLUDING PIPING, DUCTWORK, RACEWAYS, ETC.) SHALL BE INSTALLED NEATLY, BUNDLED TOGETHER TO EXTENT POSSIBLE AND RUN AT RIGHT ANGLES TO BUILDING LINES. THESE UTILITIES SHALL BE PAINTED TO MATCH ADJACENT SURFACE OR AS DIRECTED BY ARCHITECT. HANGERS, STEEL SHAPES AND SLOTTED STEEL SUPPORTS SHALL BE PAINTED TO MATCH RACEWAY OR AS DIRECTED BY ARCHITECT. TO EXTENT POSSIBLE CONTRACTOR SHALL AVOID EXPOSED RACEWAYS BY INSTALLING UTILITIES BELOW GRADE, IN WALL, OR ABOVE ADJACENT CONCEALED CEILING SPACES.
- PROVIDE ACCESS PANELS IN CEILING WHERE ANY DEVICE OR EQUIPMENT REQUIRING SERVICE (INCLUDING DAMPERS, VALVES, JUNCTION BOXES, CONTROLLERS, SMOKE DETECTORS, ETC.) IS LOCATED ABOVE OR BEHIND AN INACCESSIBLE CEILING OR WALL. ACCESS PANELS IN RATED CONSTRUCTION SHALL BEAR APPROPRIATE UL LABEL. COORDINATE LOCATION AND TYPE OF ACCESS PANEL WITH ARCHITECT PRIOR TO INSTALLATION.
- PROVIDE CONCRETE HOUSEKEEPING PAD FOR ALL FLOOR OR GROUND MOUNTED EQUIPMENT WITH #4 REBAR 6" O.C. EACH WAY AND 1" CHAMFERED TOP EDGE. PADS ON CONCRETE SLAB SHALL BE 4" HIGH AND DOWELED INTO SLAB WITH #4 REBAR EXTENDING 2" INTO PAD. 3" INTO SLAB AND EPOXIED IN PLACE AND SPACED 12" O.C. AROUND PERIMETER OF PAD. PADS ON EARTH SHALL BE MINIMUM 6" THICK AND LAYED OUT TO EXTEND A MINIMUM OF 4" ABOVE GRADE AT HIGHEST GRADE LEVEL; COMPACT EARTH BELOW PAD PRIOR TO PAD CONSTRUCTION.

MECHANICAL GENERAL NOTES

- PROVIDE EXTERIOR LOUVERS WITH NECESSARY TRIM KIT TO RECESS LOUVER INTO FINISH MASONRY SURFACE. SEAL ANY REMAINING OPENING AROUND PERIMETER. SEE STRUCTURAL DRAWINGS FOR LOCATION OF LINTELS. BOND BEAMS AND REINFORCING AND COORDINATE ACCORDINGLY. LOUVERS IN MASONRY CONSTRUCTION SHALL BE DIMENSIONED IN BRICK COURSING (MODULES OF 4" W x 8" H); IF DIMENSION ON PLANS IS NOT BRICK COURSING ROUND UP TO NEXT LARGER COURSING MODULE. PROVIDE MINIMUM 24" DEEP (WxH TO MATCH LOUVER) INSULATED SHEET METAL PLENUM WITH BOTTOM SLOPED TO DRAIN ON INTERIOR SIDE OF LOUVERS.
- PROVIDE MINIMUM 24" HIGH DOUBLE WALL, FULLY WELDED, INSULATED ROOF CURBS WITH 2x4 PRESSURE TREATED NAILER FOR ALL ROOF MOUNTED EQUIPMENT. HEIGHT SHALL BE EXTENDED BEYOND 24" AS NECESSARY FOR INSULATION THICKNESS AND PROPER FLASHING AS DETERMINED BY ROOFING CONTRACTOR. CURB SHALL BE RATED FOR WIND SPEED AND EXPOSURE CATEGORY FOR PROJECT LOCATION PER FLORIDA BUILDING CODE. CONTRACTOR SHALL PROVIDE SHOP DRAWINGS OF ATTACHMENT SIGNED & SEALED BY STRUCTURAL ENGINEER LICENSED IN FLORIDA. ATTACHMENT SHALL BE THE MORE STRINGENT REQUIREMENT AS DETERMINED BY ENGINEER OR THE FOLLOWING:
- PROVIDE #10 TEK SCREWS (METAL DECK) OR 1/4" TAPCONS (CONCRETE DECK) AT MAXIMUM 24" O.C. (MINIMUM 2 EACH SIDE) AROUND PERIMTER TO SECURE CURB TO ROOF. PROVIDE MGM STANDARD CLIPS MAXIMUM 36" O.C. (MINIMUM 1 EACH SIDE) TO SECURE EQUIPMENT TO CURB WITH #10 TEK SCREWS ON EACH SIDE OF CLIP.
- PROVIDE MINIMUM 12" HIGH PLENUM LINED WITH 1" THICK INSULATION ON TOP OF CEILING MOUNTED RETURN AND EXHUAST AIR GRILLES (WxL TO MATCH GRILLE).
- 4. PROVIDE IDENTIFICATION STICKERS (1/2" ROUND) ON GRID WHERE VALVES OR TERMINAL UNITS ARE LOCATED ABOVE ACCESSIBLE CEILINGS.
- ABOVE GROUND HYDRONIC PIPING SHALL BE METAL PER SPECIFCATION 232113.12 "ABOVE GROUND METAL HYDRONIC PIPING". BELOW GRADE HYDRONIC PIPING MAY BE PLASTIC PER SPECIFICATION 232113.15 "UNDERGROUND PLASTIC HYDRONIC PIPING."
- PENETRATIONS OF 1-HOUR FIRE BARRIER BY FULLY DUCTED SYSTEM DO NOT REQUIRE INSTALLATION OF A FIRE DAMPER PER FMC 607.5.2 BUT SHALL BE INSTALLED PER DETAIL A/M503 OR SIMILAR UL LISTED PENETRATION. PENETRATIONS OF 1-HOUR FIRE BARRIER BY TRANSFER DUCTS SHALL BE PROVIDED WITH A FIRE DAMPER PER DETAIL F/M503.

MECHANICAL KEYNOTES

- 1 PROVIDE SLOT SUPPLY DIFFUSER WITH FLANGE PLASTER FRAME, CONCEALED MOUNTING MOUNTING AND SQUARE PLENUM. WHERE INSTALLED IN LAY-IN CEILING PROVIDE TEGULAR LAY IN FRAME. DEVICES LONGER THAN 2'-0" SHALL BE PROVIDED WITH CONTINUOUS SLOTS WITH OUTSIDE FRAME AND MITERED CORNERS. WHERE PLENUM LENGTH EXCEEDS 4'-0" PROVIDE CUSTOM PLENUM. LENGTH, INLET SIZE, NUMBER OF SLOTS AND SLOT WIDTH INDICATED ON PLANS. PRICE; SDS (TYPE 7 OR TYPE 17) SDB OR APPROVED EQUAL - SEE DETAIL E/M503.
- PROVIDE SLOT RETURN AIR GRILLE WITH FLANGE PLASTER FRAME, CONCEALED MOUNTING WITHOUT PLENUM. DEVICES LONGER THAN 2'-0" SHALL BE PROVIDED WITH CONTINOUS SLOTS WITH OUTSIDE FRAME AND MITERED CORNERS. WHERE INSTALLED IN LAY-IN CEILING PROVIDE TEGULAR LAY IN FRAME. LENGTH, NUMBER OF SLOTS AND SLOT WIDTH INDICATED ON PLANS. PRICE; SDR (TYPE 7 OR TYPE 17) OR APPROVED EQUAL - SEE DETAIL E/M503.
- (3) LINEAR BAR GRILLE, 0-DEG DEFLECTION, 3/32" BARS ON 1/4" SPACEING WITH 3/4" FLANGED FRAME AND DIRECTIONAL VANES MOUNTED BEHIND GRILLE. LENGTH AND HEIGHT INDICATED ON PLANS. PRICE; LBP-15A-750 OR APPROVED EQUAL.
- (4) LINEAR BAR GRILLE, 0-DEG DEFLECTION, 3/32" BARS ON 1/4" SPACEING WITH 3/4" FLANGED FRAME. LENGTH AND HEIGHT INDICATED ON PLANS. PRICE; LBP-15A-750 OR APPROVED EQUAL
- \$\langle 5 \rangle\$ PROVIDE CONTINUOUS ARCHITECTURAL SLOT GRILLE ALONG EDGE OF CEILING WITH 1- 2" SLOT. FOR SUPPLY SECTIONS PROVIDE JET THROW, VERTICAL PATTERN AND SUPPLY PLENUM WITH FOAM INSULATION (CFP). FOR RETURN SECTIONS PROVIDE FULLY OPEN SLOT AND RETURN AIR SIGHT BAFFLE. WHERE TERMINATING AT A WALL PROVIDE FLUSH END, OTHERSIE PROVIDE MITERED ENDS AND OR CORNERS. PROVIDE EXPOSED FRAME (EF) WITH CONCEALED MOUNTING CLIP (MP-DR). PRICE; CFJS OR APPROVED EQUAL - SEE DETAIL D/M503.
- (6) IN WALL DRYER VENT BOX
- $\langle 7 \rangle$ NOT USED.
- (8) GRADE GROUND LEVEL INSIDE UTILITY YARD AND TREAT SOIL WITH WEED KILLER. PROVIDE TWO LAYERS OF WEED CLOTH LAID WITH SEAMS AT 90 DEGREES TO ONE ANOTHER AND COVER WITH MINIMUM 3" THICK LAYER OF #57 GRAVEL FROM EDGE OF EQUIPMENT PADS TO YARD WALLS.
- (9) INTERNALLY LINED TRANSFER AIR DUCT ABOVE CEILING WITH ELBOWS
- (10) NOT USED.
- AIR COOLED CHILLER AND PRIMARY PUMP TO BE INSTALLED AS PART OF THIS PROJECT.
- (12) AIR COOLED CHILLER AND PRIMARY PUMP TO BE INSTALLED AS PART OF FUTURE EPICENTER PROJECT.

PIPING UP TO ISOLATION VALVES AS INDICATED TO BE INSTALLED AS PART OF THIS PROJECT.


- AIR COOLED CHILLER SEE DETAIL A/M501 & E/M501
- (14) VERTICAL INLINE PRIMARY PUMP SEE DETAIL B/M501



ARCHITECTURE PLANNING INTERIORS GRAPHICS

ELLIOTT MARSHALL INNES P.A. (EMI architects) 251 E. 7TH AVENUE TALLAHASSEE FL 32303 ICENSE #s AA C000409 IB C000153

> 1" x 17" SHEETS ARE PLOTTED AT 1/2 THE SCALE NOTED ON THESE DRAWINGS.

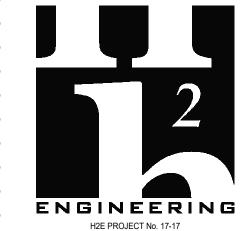

114 EAST 5th AVENUE TALLAHASSEE, FL 32303 PHONE 850.224.7922 THIS DOCUMENT IS THE PROPERTY OF H2Engineering AND IS PREPARED AS AN INSTRUMENT OF SERVICE. ITS

USE, REUSE OR REPRODUCTION, EXCEPT BY WRITTEN AGREEMENT WITH H2Engineering, IS PROHIBITED. Florida Registry #2485

Jeffrey L. Tyler, P.E. #57093

This item has been digitally signed and sealed by Jeffrey Lee Tyler, P.E. on the date

Jeffrey Lee Tyler, State of Florida, Professional Engineer, License No. 57093

Printed copies of this document are not considered signed and sealed, and the signature must be verified on any electronic

Date: 02/10/2025

WCSD EDUCATIONAL ANCILLARY FACILITIES -DISTRICT OFFICE

RECEIVED **ALLSTATE CONSTRUCTION** 02-13-2025

REV	DATE	DESCRIPTION
∤ 1	2/11/2025	ADDENDUM #1
)		
ß		
K		
\triangleright		
3		
Ĭ,		
R		
\triangleright		
PROJEC	T PHASE	

DRAWN BY 15 JANUARY 2025 JDR ROJECT NO **CHECKED BY**)68100 JLT SHEET TITLE

CONSTRUCTION DOCUMENTS

FIRST FLOOR PLAN SOUTH

REV NO M101-S



 $\langle 1 \rangle$ 240

4-3-3-8

M101-N

- $\langle \overline{15}
 angle$ PROVIDE ISOLATION BUTTERFLY VALVES ON SECONDARY SUPPLY AND RETURN LINES TO DISTRICT OFFICE BUILDING AND TO FUTURE EPICENTER BUILDING.
- (16) BASE MOUNTED END SUCTION SECONDARY PUMP SEE DETAIL C/M501
- (17) HEATING HOT WATER & CHILLED WATER MAKE-UP WATER STATION, AIR & DIRT SEPARATOR AND EXPANSION TANKS - SEE DETAIL H/M502
- (18) CONDENSING BOILER SEE DETAIL F/M501 & E/M502
- (19) PROVIDE EXHAUST DUCT WALL CAP AT EXTERIOR WALL. ARCHITECT SHALL SELECT COLOR.
- (20) CEILING STEPS UP, SKIP VERTICAL SECTION AND CONTINUE RETURN SLOT ON HIGHER CEILING AS SHOWN.
- $\langle 21 \rangle$ PROVIDE DUCT TRANSITION WITH LEVEL TOP TO MAINTAIN TOP OF DUCT ELEVATION.
- (22) SEAL ALL DUCT AND PIPE PENETRATIONS THROUGH NON-RATED WALL IN THIS ROOM.

- CONTRACTOR TO COORDINATE THE LOCATION, ALIGNMENT, ELEVATION AND/OR SPACING OF ANY EXPOSED DEVICE, FIXTURE, AND/OR PIECE OF EQUIPMENT WITH THE ARCHITECTURAL FLOOR PLANS, ELEVATIONS. AND/OR REFLECTED CEILING PLANS. DISCREPANCIES AND/OR CONFLICTS CONTAINED WITHIN THE CONTRACT DOCUMENTS SHALL BE BROUGHT TO THE ATTENTION OF THE ARCHITECT. IF AN EXPOSED ITEM IS NOT INDICATED ON THE ARCHITECTURAL DOCUMENTS NOTIFY THE ARCHITECT FOR CLARIFICATION OF
- REFER TO ARCHITECTURAL REFLECTED CEILING PLANS FOR SPECIFIC LOCATIONS OF CEILING MOUNTED DEVICES. DEVICES SHALL BE INSTALLED IN THE CENTER OF CEILING TILES WHERE ACOUSTICAL CEILING SYSTEMS ARE SPECIFIED AND ON THE SAME CENTERLINES WITH OTHER ADJACENT CEILING MOUNTED DEVICES IN THE SAME SPACE. IF A DEVICE'S LOCATION IS NOT CLEARLY INDICATED OR THERE IS A CONFLICT WITHIN THE CONTRACT DOCUMENTS NOTIFY ARCHITECT FOR CLARIFICATION PRIOR TO INSTALLATION.
- LOCATION OF WALL AND FLOOR MOUNT DEVICES IS DIAGRAMMATIC AND SHOWN FOR CLARITY. REFER TO ARCHITECTURAL ELEVATIONS FOR EXACT LOCATION OF DEVICES. WHERE NOT INDICATED ON ARCHITECT'S PLAN COORDINATE WITH ARCHITECT PRIOR TO INSTALLATION.
- AT EXTERIOR LOCATIONS AND IN SPACES WITH EXPOSED STRUCTURE EXPOSED UTILITIES (INCLUDING PIPING, DUCTWORK, RACEWAYS, ETC.) SHALL BE INSTALLED NEATLY, BUNDLED TOGETHER TO EXTENT POSSIBLE AND RUN AT RIGHT ANGLES TO BUILDING LINES. THESE UTILITIES SHALL BE PAINTED TO MATCH ADJACENT SURFACE OR AS DIRECTED BY ARCHITECT. HANGERS, STEEL SHAPES AND SLOTTED STEEL SUPPORTS SHALL BE PAINTED TO MATCH RACEWAY OR AS DIRECTED BY ARCHITECT. TO EXTENT POSSIBLE CONTRACTOR SHALL AVOID EXPOSED RACEWAYS BY INSTALLING UTILITIES BELOW GRADE, IN WALL, OR ABOVE ADJACENT CONCEALED CEILING SPACES.
- PROVIDE ACCESS PANELS IN CEILING WHERE ANY DEVICE OR EQUIPMENT REQUIRING SERVICE (INCLUDING DAMPERS, VALVES, JUNCTION BOXES, CONTROLLERS, SMOKE DETECTORS, ETC.) IS LOCATED ABOVE OR BEHIND AN INACCESSIBLE CEILING OR WALL. ACCESS PANELS IN RATED CONSTRUCTION SHALL BEAR APPROPRIATE UL LABEL. COORDINATE LOCATION AND TYPE OF ACCESS PANEL WITH ARCHITECT PRIOR TO INSTALLATION.
- PROVIDE CONCRETE HOUSEKEEPING PAD FOR ALL FLOOR OR GROUND MOUNTED EQUIPMENT WITH #4 REBAR 6" O.C. EACH WAY AND 1" CHAMFERED TOP EDGE. PADS ON CONCRETE SLAB SHALL BE 4" HIGH AND DOWELED INTO SLAB WITH #4 REBAR EXTENDING 2" INTO PAD, 3" INTO SLAB AND EPOXIED IN PLACE AND SPACED 12" O.C. AROUND PERIMETER OF PAD. PADS ON EARTH SHALL BE MINIMUM 6" THICK AND LAYED OUT TO EXTEND A MINIMUM OF 4" ABOVE GRADE AT HIGHEST GRADE LEVEL; COMPACT EARTH BELOW PAD PRIOR TO PAD CONSTRUCTION.

MECHANICAL GENERAL NOTES

- PROVIDE EXTERIOR LOUVERS WITH NECESSARY TRIM KIT TO RECESS LOUVER INTO FINISH MASONRY SURFACE. SEAL ANY REMAINING OPENING AROUND PERIMETER. SEE STRUCTURAL DRAWINGS FOR LOCATION OF LINTELS. BOND BEAMS AND REINFORCING AND COORDINATE ACCORDINGLY. LOUVERS IN MASONRY CONSTRUCTION SHALL BE DIMENSIONED IN BRICK COURSING (MODULES OF 4" W x 8" H); IF DIMENSION ON PLANS IS NOT BRICK COURSING ROUND UP TO NEXT LARGER COURSING MODULE. PROVIDE MINIMUM 24" DEEP (WxH TO MATCH LOUVER) INSULATED SHEET METAL PLENUM WITH BOTTOM SLOPED TO DRAIN ON INTERIOR SIDE OF LOUVERS.
- PROVIDE MINIMUM 24" HIGH DOUBLE WALL, FULLY WELDED, INSULATED ROOF CURBS WITH 2x4 PRESSURE TREATED NAILER FOR ALL ROOF MOUNTED EQUIPMENT. HEIGHT SHALL BE EXTENDED BEYOND 24" AS NECESSARY FOR INSULATION THICKNESS AND PROPER FLASHING AS DETERMINED BY ROOFING CONTRACTOR. CURB SHALL BE RATED FOR WIND SPEED AND EXPOSURE CATEGORY FOR PROJECT LOCATION PER FLORIDA BUILDING CODE. CONTRACTOR SHALL PROVIDE SHOP DRAWINGS OF ATTACHMENT SIGNED & SEALED BY STRUCTURAL ENGINEER LICENSED IN FLORIDA. ATTACHMENT SHALL BE THE MORE STRINGENT REQUIREMENT AS DETERMINED BY ENGINEER OR THE FOLLOWING:
- PROVIDE #10 TEK SCREWS (METAL DECK) OR 1/4" TAPCONS (CONCRETE DECK) AT MAXIMUM 24" O.C. (MINIMUM 2 EACH SIDE) AROUND PERIMTER TO SECURE CURB TO ROOF. PROVIDE MGM STANDARD CLIPS MAXIMUM 36" O.C. (MINIMUM 1 EACH SIDE) TO SECURE EQUIPMENT TO CURB WITH #10 TEK SCREWS ON EACH SIDE OF CLIP.
- PROVIDE MINIMUM 12" HIGH PLENUM LINED WITH 1" THICK INSULATION ON TOP OF CEILING MOUNTED RETURN AND EXHUAST AIR GRILLES (WxL TO MATCH GRILLE).
- 4. PROVIDE IDENTIFICATION STICKERS (1/2" ROUND) ON GRID WHERE VALVES OR TERMINAL UNITS ARE LOCATED ABOVE ACCESSIBLE CEILINGS.
- ABOVE GROUND HYDRONIC PIPING SHALL BE METAL PER SPECIFCATION 232113.12 "ABOVE GROUND METAL HYDRONIC PIPING". BELOW GRADE HYDRONIC PIPING MAY BE PLASTIC PER SPECIFICATION 232113.15 "UNDERGROUND PLASTIC HYDRONIC PIPING."
- 6. PENETRATIONS OF 1-HOUR FIRE BARRIER BY FULLY DUCTED SYSTEM DO NOT REQUIRE INSTALLATION OF A FIRE DAMPER PER FMC 607.5.2 BUT SHALL BE INSTALLED PER DETAIL A/M503 OR SIMILAR UL LISTED PENETRATION. PENETRATIONS OF 1-HOUR FIRE BARRIER BY TRANSFER DUCTS SHALL BE PROVIDED WITH A FIRE DAMPER PER DETAIL F/M503.


MECHANICAL KEYNOTES

- 1 PROVIDE SLOT SUPPLY DIFFUSER WITH FLANGE PLASTER FRAME, CONCEALED MOUNTING MOUNTING AND SQUARE PLENUM. WHERE INSTALLED IN LAY-IN CEILING PROVIDE TEGULAR LAY IN FRAME. DEVICES LONGER THAN 2'-0" SHALL BE PROVIDED WITH CONTINUOUS SLOTS WITH OUTSIDE FRAME AND MITERED CORNERS. WHERE PLENUM LENGTH EXCEEDS 4'-0" PROVIDE CUSTOM PLENUM. LENGTH, INLET SIZE, NUMBER OF SLOTS AND SLOT WIDTH INDICATED ON PLANS. PRICE; SDS (TYPE 7 OR TYPE 17) SDB OR APPROVED EQUAL - SEE DETAIL E/M503.
- PROVIDE SLOT RETURN AIR GRILLE WITH FLANGE PLASTER FRAME, CONCEALED MOUNTING WITHOUT PLENUM. DEVICES LONGER THAN 2'-0" SHALL BE PROVIDED WITH CONTINOUS SLOTS WITH OUTSIDE FRAME AND MITERED CORNERS. WHERE INSTALLED IN LAY-IN CEILING PROVIDE TEGULAR LAY IN FRAME. LENGTH, NUMBER OF SLOTS AND SLOT WIDTH INDICATED ON PLANS. PRICE; SDR (TYPE 7 OR TYPE 17) OR APPROVED EQUAL - SEE DETAIL E/M503.
- (3) LINEAR BAR GRILLE, 0-DEG DEFLECTION, 3/32" BARS ON 1/4" SPACEING WITH 3/4" FLANGED FRAME AND DIRECTIONAL VANES MOUNTED BEHIND GRILLE. LENGTH AND HEIGHT INDICATED ON PLANS. PRICE; LBP-15A-750 OR APPROVED EQUAL.
- \(4\) LINEAR BAR GRILLE, 0-DEG DEFLECTION, 3/32" BARS ON 1/4" SPACEING WITH 3/4" FLANGED FRAME. LENGTH AND HEIGHT INDICATED ON PLANS. PRICE; LBP-15A-750 OR APPROVED EQUAL.
- \$\langle 5 \rangle\$ PROVIDE CONTINUOUS ARCHITECTURAL SLOT GRILLE ALONG EDGE OF CEILING WITH 1- 2" SLOT. FOR SUPPLY SECTIONS PROVIDE JET THROW, VERTICAL PATTERN AND SUPPLY PLENUM WITH FOAM INSULATION (CFP). FOR RETURN SECTIONS PROVIDE FULLY OPEN SLOT AND RETURN AIR SIGHT BAFFLE. WHERE TERMINATING AT A WALL PROVIDE FLUSH END, OTHERSIE PROVIDE MITERED ENDS AND OR CORNERS. PROVIDE EXPOSED FRAME (EF) WITH CONCEALED MOUNTING CLIP (MP-DR). PRICE; CFJS OR APPROVED EQUAL - SEE DETAIL D/M503.
- (6) IN WALL DRYER VENT BOX
- (7) NOT USED.
- (8) GRADE GROUND LEVEL INSIDE UTILITY YARD AND TREAT SOIL WITH WEED KILLER. PROVIDE TWO LAYERS OF WEED CLOTH LAID WITH SEAMS AT 90 DEGREES TO ONE ANOTHER AND COVER WITH MINIMUM 3" THICK LAYER OF #57 GRAVEL FROM EDGE OF EQUIPMENT PADS TO YARD WALLS.
- (9) INTERNALLY LINED TRANSFER AIR DUCT ABOVE CEILING WITH ELBOWS
- (10) NOT USED.
- AIR COOLED CHILLER AND PRIMARY PUMP TO BE INSTALLED AS PART OF THIS PROJECT.
- (12) AIR COOLED CHILLER AND PRIMARY PUMP TO BE INSTALLED AS PART OF FUTURE EPICENTER PROJECT. PIPING UP TO ISOLATION VALVES AS INDICATED TO BE INSTALLED AS PART OF THIS PROJECT.
- AIR COOLED CHILLER SEE DETAIL A/M501 & E/M501
- (14) VERTICAL INLINE PRIMARY PUMP SEE DETAIL B/M501

ARCHITECTURE PLANNING INTERIORS GRAPHICS

LLIOTT MARSHALL INNES P.A. (EMI architects) 251 E. 7TH AVENUE TALLAHASSEE FL 32303 ICENSE #s AA C000409 IB C000153

1" x 17" SHEETS ARE PLOTTED AT 1/2 THE SCALE NOTED ON THESE DRAWINGS.

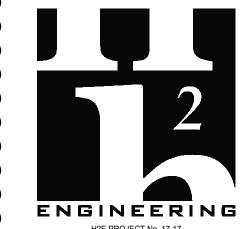

H2E PROJECT No. 17-17 114 EAST 5th AVENUE TALLAHASSEE, FL 32303 PHONE 850.224.7922 www.H2Engineering.com THIS DOCUMENT IS THE PROPERTY OF H2Engineering AND IS PREPARED AS AN INSTRUMENT OF SERVICE. ITS

JSE. REUSE OR REPRODUCTION, EXCEPT BY WRITTEN AGREEMENT WITH H2Engineering, IS PROHIBITED. Florida Registry #2485

Jeffrey L. Tyler, P.E. #57093 Jeffrey Lee Tyler, State of Florida, ofessional Engineer, License No. **57093**

This item has been digitally signed and sealed by Jeffrey Lee Tyler, P.E. on the date

Printed copies of this document are not considered signed and sealed, and the signature must be verified on any electronic

Date: 02/10/2025

WCSD EDUCATIONAL ANCILLARY FACILITIES -DISTRICT OFFICE

RECEIVED **ALLSTATE CONSTRUCTION** 02-13-2025


REV	DATE	DESCRIPTION		
∤ 1	2/11/2025	ADDENDUM #1		
)				
3				
K				
2				
3				
ζ				
R				
PROJECT PHASE				

CONSTRUCTION DOCUMENTS

DRAWN BY 15 JANUARY 2025 JDR ROJECT NO **CHECKED BY** JLT SHEET TITLE

SECOND FLOOR PLAN NORTH

REV NO M102-N

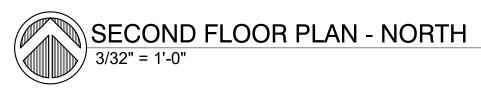

RAG

≤ 24x18

10x10 6-2-2-8 6-2<u>-2</u>-8

ROUTE 3/4" CONDENSATE

10x20 DN WITH FIRE

DAMPER AT FLOOR-

M203

MECH/ELEC

2-038


40x18 DN WITH FIRE DAMPER

26x18


and the contraction of the contr

AT SLAB PENETRATION—

M102-S

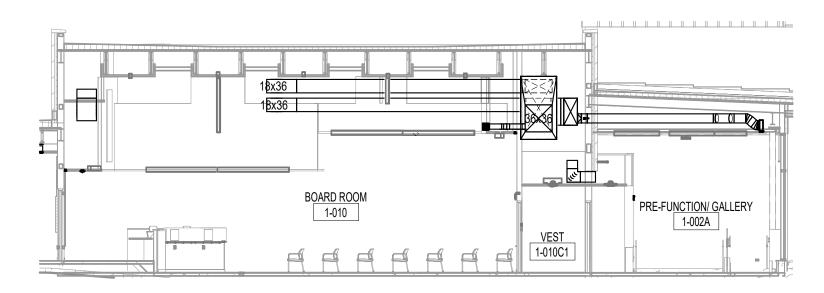

BOARDROOM 1-010

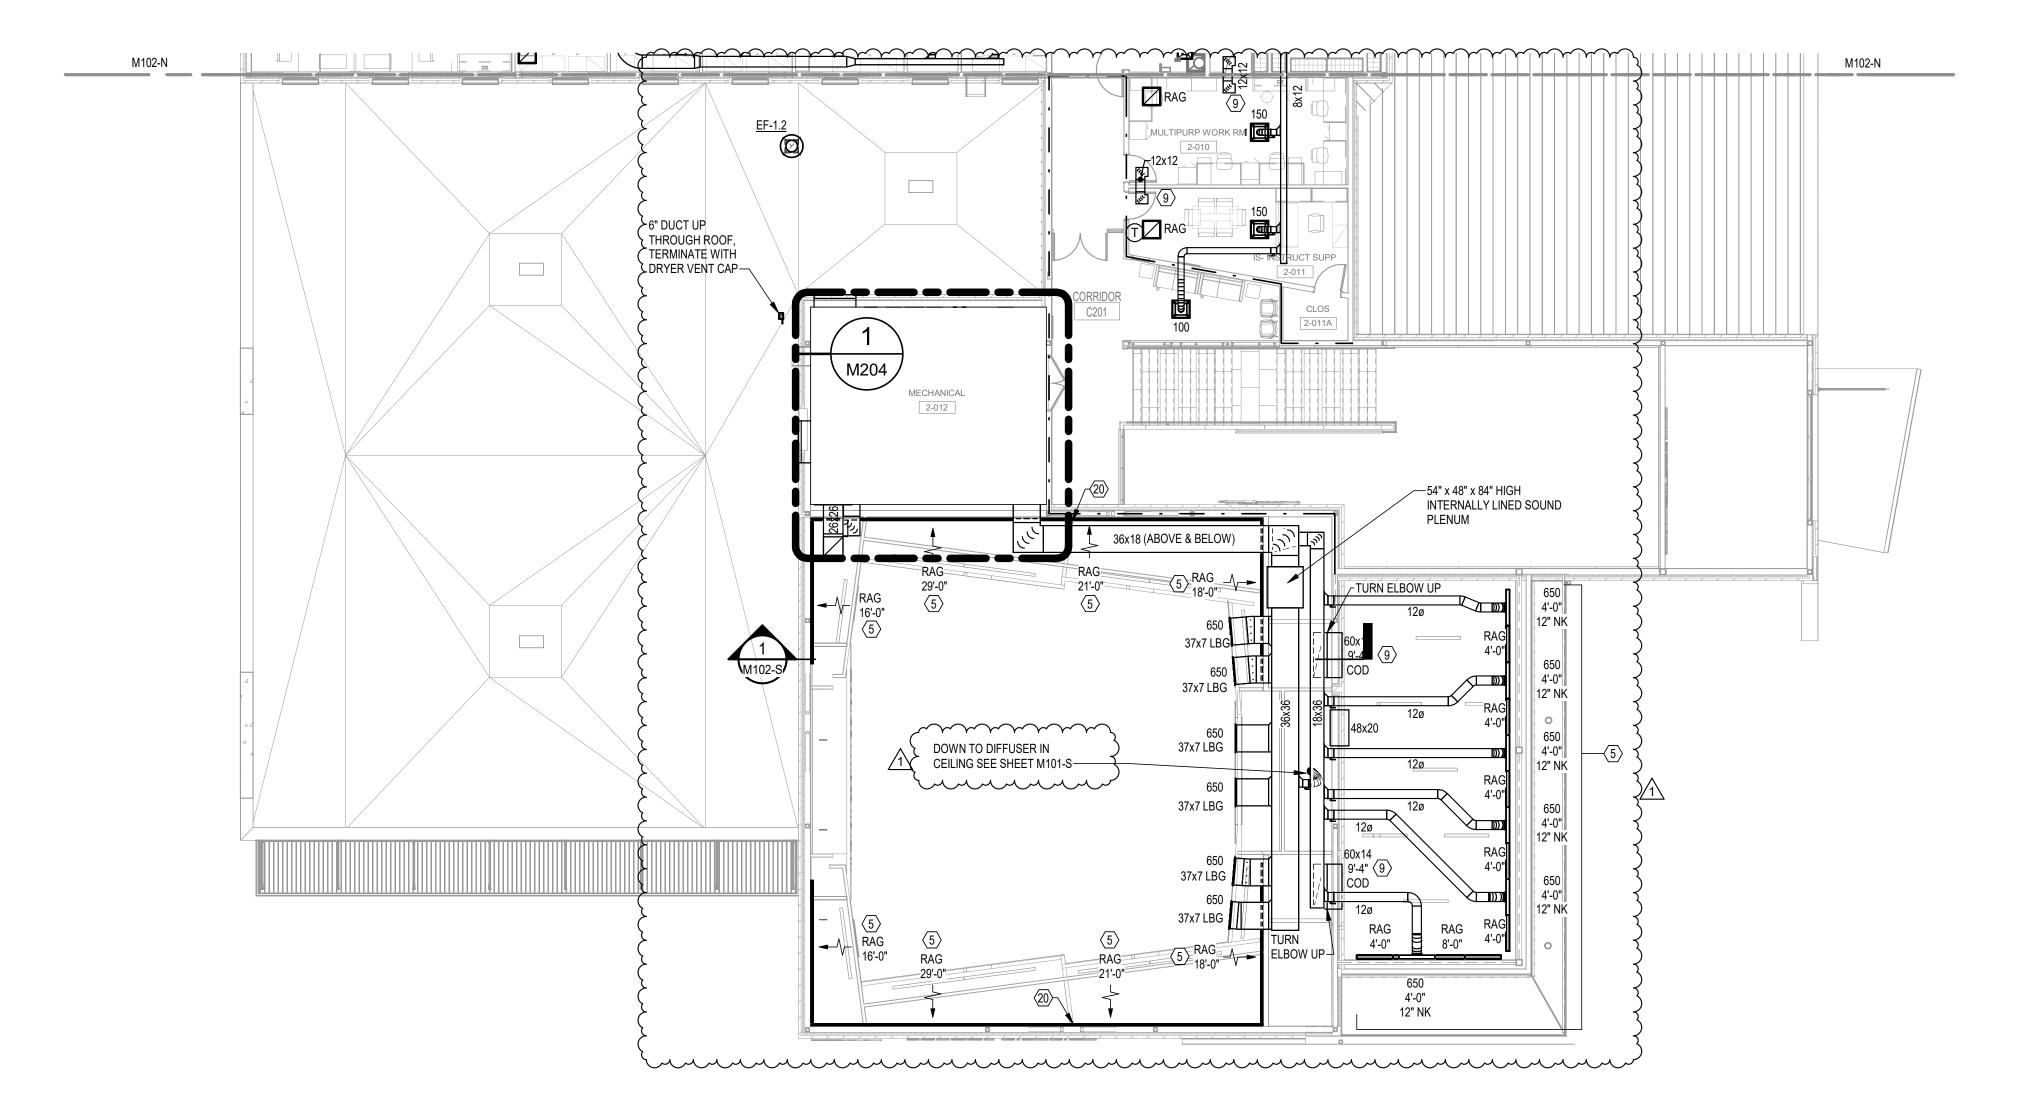

MECHANICAL KEYNOTES (continued)

- (15) PROVIDE ISOLATION BUTTERFLY VALVES ON SECONDARY SUPPLY AND RETURN LINES TO DISTRICT OFFICE BUILDING AND TO FUTURE EPICENTER BUILDING.
- (16) BASE MOUNTED END SUCTION SECONDARY PUMP SEE DETAIL C/M501
- (17) HEATING HOT WATER & CHILLED WATER MAKE-UP WATER STATION, AIR & DIRT SEPARATOR AND EXPANSION TANKS - SEE DETAIL H/M502
- (18) CONDENSING BOILER SEE DETAIL F/M501 & E/M502
- (19) PROVIDE EXHAUST DUCT WALL CAP AT EXTERIOR WALL. ARCHITECT SHALL SELECT COLOR.
- (20) CEILING STEPS UP, SKIP VERTICAL SECTION AND CONTINUE RETURN SLOT ON HIGHER CEILING AS SHOWN.
- $\langle 21 \rangle$ PROVIDE DUCT TRANSITION WITH LEVEL TOP TO MAINTAIN TOP OF DUCT ELEVATION.
- (22) SEAL ALL DUCT AND PIPE PENETRATIONS THROUGH NON-RATED WALL IN THIS ROOM.

COORDINATION NOTES

- CONTRACTOR TO COORDINATE THE LOCATION, ALIGNMENT, ELEVATION AND/OR SPACING OF ANY EXPOSED DEVICE, FIXTURE, AND/OR PIECE OF EQUIPMENT WITH THE ARCHITECTURAL FLOOR PLANS, ELEVATIONS. AND/OR REFLECTED CEILING PLANS. DISCREPANCIES AND/OR CONFLICTS CONTAINED WITHIN THE CONTRACT DOCUMENTS SHALL BE BROUGHT TO THE ATTENTION OF THE ARCHITECT. IF AN EXPOSED ITEM IS NOT INDICATED ON THE ARCHITECTURAL DOCUMENTS NOTIFY THE ARCHITECT FOR CLARIFICATION OF PLACEMENT PRIOR TO INSTALLATION.
- REFER TO ARCHITECTURAL REFLECTED CEILING PLANS FOR SPECIFIC LOCATIONS OF CEILING MOUNTED DEVICES. DEVICES SHALL BE INSTALLED IN THE CENTER OF CEILING TILES WHERE ACOUSTICAL CEILING SYSTEMS ARE SPECIFIED AND ON THE SAME CENTERLINES WITH OTHER ADJACENT CEILING MOUNTED DEVICES IN THE SAME SPACE. IF A DEVICE'S LOCATION IS NOT CLEARLY INDICATED OR THERE IS A CONFLICT WITHIN THE CONTRACT DOCUMENTS NOTIFY ARCHITECT FOR CLARIFICATION PRIOR TO INSTALLATION.
- LOCATION OF WALL AND FLOOR MOUNT DEVICES IS DIAGRAMMATIC AND SHOWN FOR CLARITY. REFER TO ARCHITECTURAL ELEVATIONS FOR EXACT LOCATION OF DEVICES. WHERE NOT INDICATED ON ARCHITECT'S PLAN COORDINATE WITH ARCHITECT PRIOR TO INSTALLATION.
- AT EXTERIOR LOCATIONS AND IN SPACES WITH EXPOSED STRUCTURE EXPOSED UTILITIES (INCLUDING PIPING, DUCTWORK, RACEWAYS, ETC.) SHALL BE INSTALLED NEATLY, BUNDLED TOGETHER TO EXTENT POSSIBLE AND RUN AT RIGHT ANGLES TO BUILDING LINES. THESE UTILITIES SHALL BE PAINTED TO MATCH ADJACENT SURFACE OR AS DIRECTED BY ARCHITECT. HANGERS, STEEL SHAPES AND SLOTTED STEEL SUPPORTS SHALL BE PAINTED TO MATCH RACEWAY OR AS DIRECTED BY ARCHITECT. TO EXTENT POSSIBLE CONTRACTOR SHALL AVOID EXPOSED RACEWAYS BY INSTALLING UTILITIES BELOW GRADE, IN WALL, OR ABOVE ADJACENT CONCEALED CEILING SPACES.
- PROVIDE ACCESS PANELS IN CEILING WHERE ANY DEVICE OR EQUIPMENT REQUIRING SERVICE (INCLUDING DAMPERS, VALVES, JUNCTION BOXES, CONTROLLERS, SMOKE DETECTORS, ETC.) IS LOCATED ABOVE OR BEHIND AN INACCESSIBLE CEILING OR WALL. ACCESS PANELS IN RATED CONSTRUCTION SHALL BEAR APPROPRIATE UL LABEL. COORDINATE LOCATION AND TYPE OF ACCESS PANEL WITH ARCHITECT PRIOR TO INSTALLATION.
- PROVIDE CONCRETE HOUSEKEEPING PAD FOR ALL FLOOR OR GROUND MOUNTED EQUIPMENT WITH #4 REBAR 6" O.C. EACH WAY AND 1" CHAMFERED TOP EDGE. PADS ON CONCRETE SLAB SHALL BE 4" HIGH AND DOWELED INTO SLAB WITH #4 REBAR EXTENDING 2" INTO PAD, 3" INTO SLAB AND EPOXIED IN PLACE AND SPACED 12" O.C. AROUND PERIMETER OF PAD. PADS ON EARTH SHALL BE MINIMUM 6" THICK AND LAYED OUT TO EXTEND A MINIMUM OF 4" ABOVE GRADE AT HIGHEST GRADE LEVEL; COMPACT EARTH BELOW PAD PRIOR TO PAD CONSTRUCTION.

ARCHITECTURE PLANNING INTERIORS GRAPHICS

ELLIOTT MARSHALL INNES P.A. (EMI architects) 251 E. 7TH AVENUE TALLAHASSEE FL 32303 (850) 222 - 7442 LICENSE #s AA C000409 IB C000153


MECHANICAL GENERAL NOTES

- PROVIDE EXTERIOR LOUVERS WITH NECESSARY TRIM KIT TO RECESS LOUVER INTO FINISH MASONRY SURFACE. SEAL ANY REMAINING OPENING AROUND PERIMETER. SEE STRUCTURAL DRAWINGS FOR LOCATION OF LINTELS. BOND BEAMS AND REINFORCING AND COORDINATE ACCORDINGLY. LOUVERS IN MASONRY CONSTRUCTION SHALL BE DIMENSIONED IN BRICK COURSING (MODULES OF 4" W x 8" H); IF DIMENSION ON PLANS IS NOT BRICK COURSING ROUND UP TO NEXT LARGER COURSING MODULE. PROVIDE MINIMUM 24" DEEP (WxH TO MATCH LOUVER) INSULATED SHEET METAL PLENUM WITH BOTTOM SLOPED TO DRAIN ON INTERIOR SIDE OF LOUVERS.
- PROVIDE MINIMUM 24" HIGH DOUBLE WALL, FULLY WELDED, INSULATED ROOF CURBS WITH 2x4 PRESSURE TREATED NAILER FOR ALL ROOF MOUNTED EQUIPMENT. HEIGHT SHALL BE EXTENDED BEYOND 24" AS NECESSARY FOR INSULATION THICKNESS AND PROPER FLASHING AS DETERMINED BY ROOFING CONTRACTOR. CURB SHALL BE RATED FOR WIND SPEED AND EXPOSURE CATEGORY FOR PROJECT LOCATION PER FLORIDA BUILDING CODE. CONTRACTOR SHALL PROVIDE SHOP DRAWINGS OF ATTACHMENT SIGNED & SEALED BY STRUCTURAL ENGINEER LICENSED IN FLORIDA. ATTACHMENT SHALL BE THE MORE STRINGENT REQUIREMENT AS DETERMINED BY ENGINEER OR THE FOLLOWING:
- A. PROVIDE #10 TEK SCREWS (METAL DECK) OR 1/4" TAPCONS (CONCRETE DECK) AT MAXIMUM 24" O.C. (MINIMUM 2 EACH SIDE) AROUND PERIMTER TO SECURE CURB TO ROOF. PROVIDE MGM STANDARD CLIPS MAXIMUM 36" O.C. (MINIMUM 1 EACH SIDE) TO SECURE EQUIPMENT TO CURB WITH #10 TEK SCREWS ON EACH SIDE OF CLIP.
- PROVIDE MINIMUM 12" HIGH PLENUM LINED WITH 1" THICK INSULATION ON TOP OF CEILING MOUNTED RETURN AND EXHUAST AIR GRILLES (WxL TO MATCH GRILLE).
- 4. PROVIDE IDENTIFICATION STICKERS (1/2" ROUND) ON GRID WHERE VALVES OR TERMINAL UNITS ARE LOCATED ABOVE ACCESSIBLE CEILINGS.
- ABOVE GROUND HYDRONIC PIPING SHALL BE METAL PER SPECIFCATION 232113.12 "ABOVE GROUND METAL HYDRONIC PIPING". BELOW GRADE HYDRONIC PIPING MAY BE PLASTIC PER SPECIFICATION 232113.15 "UNDERGROUND PLASTIC HYDRONIC PIPING."
- PENETRATIONS OF 1-HOUR FIRE BARRIER BY FULLY DUCTED SYSTEM DO NOT REQUIRE INSTALLATION OF A FIRE DAMPER PER FMC 607.5.2 BUT SHALL BE INSTALLED PER DETAIL A/M503 OR SIMILAR UL LISTED PENETRATION. PENETRATIONS OF 1-HOUR FIRE BARRIER BY TRANSFER DUCTS SHALL BE PROVIDED WITH A FIRE DAMPER PER DETAIL F/M503.

MECHANICAL KEYNOTES

- 7 PROVIDE SLOT SUPPLY DIFFUSER WITH FLANGE PLASTER FRAME, CONCEALED MOUNTING MOUNTING AND SQUARE PLENUM, WHERE INSTALLED IN LAY-IN CEILING PROVIDE TEGULAR LAY IN FRAME, DEVICES LONGER THAN 2'-0" SHALL BE PROVIDED WITH CONTINUOUS SLOTS WITH OUTSIDE FRAME AND MITERED CORNERS. WHERE PLENUM LENGTH EXCEEDS 4'-0" PROVIDE CUSTOM PLENUM. LENGTH, INLET SIZE, NUMBER OF SLOTS AND SLOT WIDTH INDICATED ON PLANS. PRICE; SDS (TYPE 7 OR TYPE 17) SDB OR APPROVED EQUAL - SEE DETAIL E/M503.
- PROVIDE SLOT RETURN AIR GRILLE WITH FLANGE PLASTER FRAME, CONCEALED MOUNTING WITHOUT PLENUM. DEVICES LONGER THAN 2'-0" SHALL BE PROVIDED WITH CONTINOUS SLOTS WITH OUTSIDE FRAME AND MITERED CORNERS. WHERE INSTALLED IN LAY-IN CEILING PROVIDE TEGULAR LAY IN FRAME. LENGTH, NUMBER OF SLOTS AND SLOT WIDTH INDICATED ON PLANS. PRICE; SDR (TYPE 7 OR TYPE 17) OR APPROVED EQUAL - SEE DETAIL E/M503.
- (3) LINEAR BAR GRILLE, 0-DEG DEFLECTION, 3/32" BARS ON 1/4" SPACEING WITH 3/4" FLANGED FRAME AND DIRECTIONAL VANES MOUNTED BEHIND GRILLE. LENGTH AND HEIGHT INDICATED ON PLANS. PRICE; LBP-15A-750 OR APPROVED EQUAL.
- 4 LINEAR BAR GRILLE, 0-DEG DEFLECTION, 3/32" BARS ON 1/4" SPACEING WITH 3/4" FLANGED FRAME. LENGTH AND HEIGHT INDICATED ON PLANS. PRICE; LBP-15A-750 OR APPROVED EQUAL.
- \$\langle 5 \rangle\$ PROVIDE CONTINUOUS ARCHITECTURAL SLOT GRILLE ALONG EDGE OF CEILING WITH 1- 2" SLOT. FOR SUPPLY SECTIONS PROVIDE JET THROW, VERTICAL PATTERN AND SUPPLY PLENUM WITH FOAM INSULATION (CFP). FOR RETURN SECTIONS PROVIDE FULLY OPEN SLOT AND RETURN AIR SIGHT BAFFLI WHERE TERMINATING AT A WALL PROVIDE FLUSH END, OTHERSIE PROVIDE MITERED ENDS AND OR CORNERS. PROVIDE EXPOSED FRAME (EF) WITH CONCEALED MOUNTING CLIP (MP-DR). PRICE; CFJS O APPROVED EQUAL - SEE DETAIL D/M503.
- (6) IN WALL DRYER VENT BOX
- $\langle 7 \rangle$ NOT USED.
- $\langle 8 \rangle$ GRADE GROUND LEVEL INSIDE UTILITY YARD AND TREAT SOIL WITH WEED KILLER. PROVIDE TWO LAYERS OF WEED CLOTH LAID WITH SEAMS AT 90 DEGREES TO ONE ANOTHER AND COVER WITH MINIMUM 3" THICK LAYER OF #57 GRAVEL FROM EDGE OF EQUIPMENT PADS TO YARD WALLS.
- (9) INTERNALLY LINED TRANSFER AIR DUCT ABOVE CEILING WITH ELBOWS
- (10) NOT USED.
- AIR COOLED CHILLER AND PRIMARY PUMP TO BE INSTALLED AS PART OF THIS PROJECT.
- (12) AIR COOLED CHILLER AND PRIMARY PUMP TO BE INSTALLED AS PART OF FUTURE EPICENTER PROJECT. PIPING UP TO ISOLATION VALVES AS INDICATED TO BE INSTALLED AS PART OF THIS PROJECT.
- AIR COOLED CHILLER SEE DETAIL A/M501 & E/M501
- VERTICAL INLINE PRIMARY PUMP SEE DETAIL B/M501

11" x 17" SHEETS ARE PLOTTED AT 1/2 THE SCALE NOTED ON THESE DRAWINGS.

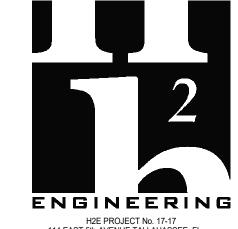

114 EAST 5th AVENUE TALLAHASSEE, FL 32303 PHONE 850.224.7922 www.H2Engineering.com THIS DOCUMENT IS THE PROPERTY OF H2Engineering AND IS PREPARED AS AN INSTRUMENT OF SERVICE. ITS

AGREEMENT WITH H2Engineering, IS PROHIBITED. Florida Registry #2485 Jeffrey L. Tyler, P.E. #57093

USE, REUSE OR REPRODUCTION, EXCEPT BY WRITTEN

Jeffrey Lee Tyler, State of Florida,

Professional Engineer, License No. 57093 This item has been digitally signed and sealed

by Jeffrey Lee Tyler, P.E. on the date

Printed copies of this document are not considered signed and sealed, and the

signature must be verified on any electronic

Date: 02/10/2025

WCSD EDUCATIONAL ANCILLARY FACILITIES -DISTRICT OFFICE

RECEIVED **ALLSTATE CONSTRUCTION** 02-13-2025


	REV	DATE	DESCRIPTION
	1	2/11/2025	ADDENDUM #1
_E.			
)R			
	PROJEC	T PHASE	
	CONST	RUCTION D	OCUMENTS

DATE	DRAWN BY
15 JANUARY 2025	JDR
PROJECT NO	CHECKED BY
68100	JLT
SHEET TITLE	

SECOND FLOOR PLAN SOUTH

SHEET NO REV NO M102-S

SECOND FLOOR PLAN - SOUTH

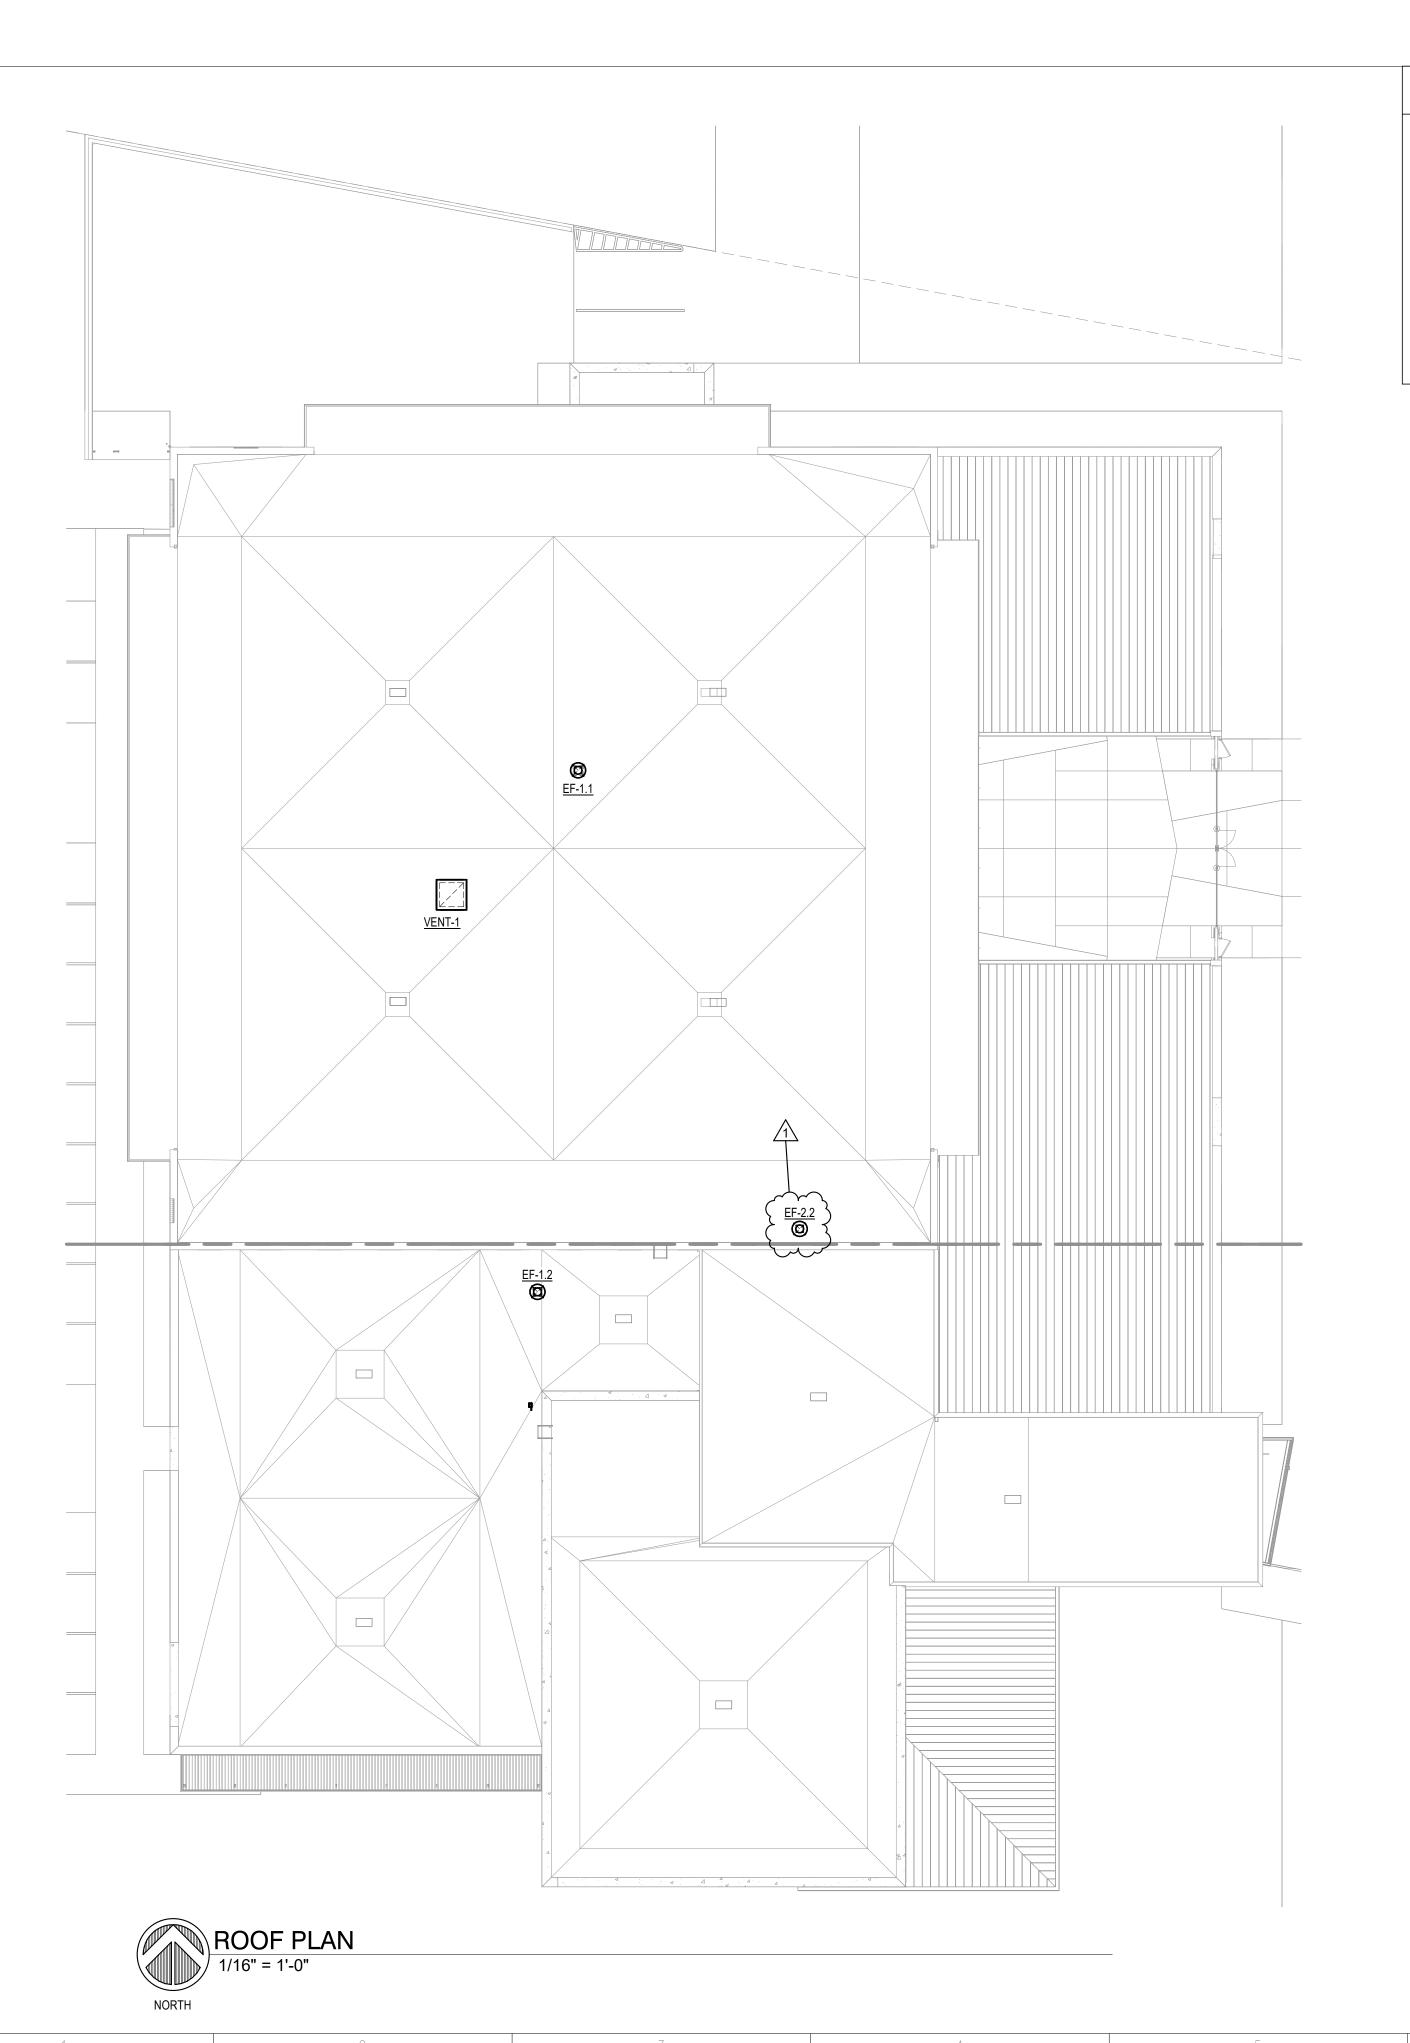

MECHANICAL KEYNOTES (continued)

- PROVIDE ISOLATION BUTTERFLY VALVES ON SECONDARY SUPPLY AND RETURN LINES TO DISTRICT OFFICE BUILDING AND TO FUTURE EPICENTER BUILDING.
- (16) BASE MOUNTED END SUCTION SECONDARY PUMP SEE DETAIL C/M501
- HEATING HOT WATER & CHILLED WATER MAKE-UP WATER STATION, AIR & DIRT SEPARATOR AND EXPANSION TANKS SEE DETAIL H/M502
- (18) CONDENSING BOILER SEE DETAIL F/M501 & E/M502
- (19) PROVIDE EXHAUST DUCT WALL CAP AT EXTERIOR WALL. ARCHITECT SHALL SELECT COLOR.
- (20) CEILING STEPS UP, SKIP VERTICAL SECTION AND CONTINUE RETURN SLOT ON HIGHER CEILING AS SHOWN.
- $\langle \overline{21} \rangle$ PROVIDE DUCT TRANSITION WITH LEVEL TOP TO MAINTAIN TOP OF DUCT ELEVATION.
- (22) SEAL ALL DUCT AND PIPE PENETRATIONS THROUGH NON-RATED WALL IN THIS ROOM.

MECHANICAL GENERAL NOTES

- 1. PROVIDE EXTERIOR LOUVERS WITH NECESSARY TRIM KIT TO RECESS LOUVER INTO FINISH MASONRY SURFACE. SEAL ANY REMAINING OPENING AROUND PERIMETER. SEE STRUCTURAL DRAWINGS FOR LOCATION OF LINTELS, BOND BEAMS AND REINFORCING AND COORDINATE ACCORDINGLY. LOUVERS IN MASONRY CONSTRUCTION SHALL BE DIMENSIONED IN BRICK COURSING (MODULES OF 4" W x 8" H); IF DIMENSION ON PLANS IS NOT BRICK COURSING ROUND UP TO NEXT LARGER COURSING MODULE. PROVIDE MINIMUM 24" DEEP (WXH TO MATCH LOUVER) INSULATED SHEET METAL PLENUM WITH BOTTOM SLOPED TO DRAIN ON INTERIOR SIDE OF LOUVERS.
 - PROVIDE MINIMUM 24" HIGH DOUBLE WALL, FULLY WELDED, INSULATED ROOF CURBS WITH 2x4 PRESSURE TREATED NAILER FOR ALL ROOF MOUNTED EQUIPMENT. HEIGHT SHALL BE EXTENDED BEYOND 24" AS NECESSARY FOR INSULATION THICKNESS AND PROPER FLASHING AS DETERMINED BY ROOFING CONTRACTOR. CURB SHALL BE RATED FOR WIND SPEED AND EXPOSURE CATEGORY FOR PROJECT LOCATION PER FLORIDA BUILDING CODE. CONTRACTOR SHALL PROVIDE SHOP DRAWINGS OF ATTACHMENT SIGNED & SEALED BY STRUCTURAL ENGINEER LICENSED IN FLORIDA. ATTACHMENT SHALL BE THE MORE STRINGENT REQUIREMENT AS DETERMINED BY ENGINEER OR THE FOLLOWING:
 - A. PROVIDE #10 TEK SCREWS (METAL DECK) OR 1/4" TAPCONS (CONCRETE DECK) AT MAXIMUM 24" O.C. (MINIMUM 2 EACH SIDE) AROUND PERIMTER TO SECURE CURB TO ROOF. PROVIDE MGM STANDARD CLIPS MAXIMUM 36" O.C. (MINIMUM 1 EACH SIDE) TO SECURE EQUIPMENT TO CURB WITH #10 TEK SCREWS ON EACH SIDE OF CLIP.
- 3. PROVIDE MINIMUM 12" HIGH PLENUM LINED WITH 1" THICK INSULATION ON TOP OF CEILING MOUNTED RETURN AND EXHUAST AIR GRILLES (WxL TO MATCH GRILLE).
- 4. PROVIDE IDENTIFICATION STICKERS (1/2" ROUND) ON GRID WHERE VALVES OR TERMINAL UNITS ARE LOCATED ABOVE ACCESSIBLE CEILINGS.
- 5. ABOVE GROUND HYDRONIC PIPING SHALL BE METAL PER SPECIFCATION 232113.12 "ABOVE GROUND METAL HYDRONIC PIPING". BELOW GRADE HYDRONIC PIPING MAY BE PLASTIC PER SPECIFICATION 232113.15 "UNDERGROUND PLASTIC HYDRONIC PIPING."
- 6. PENETRATIONS OF 1-HOUR FIRE BARRIER BY FULLY DUCTED SYSTEM DO NOT REQUIRE INSTALLATION OF A FIRE DAMPER PER FMC 607.5.2 BUT SHALL BE INSTALLED PER DETAIL A/M503 OR SIMILAR UL LISTED PENETRATION. PENETRATIONS OF 1-HOUR FIRE BARRIER BY TRANSFER DUCTS SHALL BE PROVIDED WITH A FIRE DAMPER PER DETAIL F/M503.

MECHANICAL KEYNOTES

- PROVIDE SLOT SUPPLY DIFFUSER WITH FLANGE PLASTER FRAME, CONCEALED MOUNTING MOUNTING AND SQUARE PLENUM. WHERE INSTALLED IN LAY-IN CEILING PROVIDE TEGULAR LAY IN FRAME. DEVICES LONGER THAN 2'-0" SHALL BE PROVIDED WITH CONTINUOUS SLOTS WITH OUTSIDE FRAME AND MITERED CORNERS. WHERE PLENUM LENGTH EXCEEDS 4'-0" PROVIDE CUSTOM PLENUM. LENGTH, INLET SIZE, NUMBER OF SLOTS AND SLOT WIDTH INDICATED ON PLANS. PRICE; SDS (TYPE 7 OR TYPE 17) SDB OR APPROVED EQUAL SEE DETAIL E/M503.
- PROVIDE SLOT RETURN AIR GRILLE WITH FLANGE PLASTER FRAME, CONCEALED MOUNTING WITHOUT PLENUM. DEVICES LONGER THAN 2'-0" SHALL BE PROVIDED WITH CONTINOUS SLOTS WITH OUTSIDE FRAME AND MITERED CORNERS. WHERE INSTALLED IN LAY-IN CEILING PROVIDE TEGULAR LAY IN FRAME. LENGTH, NUMBER OF SLOTS AND SLOT WIDTH INDICATED ON PLANS. PRICE; SDR (TYPE 7 OR TYPE 17) OR APPROVED EQUAL SEE DETAIL E/M503.
- LINEAR BAR GRILLE, 0-DEG DEFLECTION, 3/32" BARS ON 1/4" SPACEING WITH 3/4" FLANGED FRAME AND DIRECTIONAL VANES MOUNTED BEHIND GRILLE. LENGTH AND HEIGHT INDICATED ON PLANS. PRICE; LBP-15A-750 OR APPROVED EQUAL.
- LINEAR BAR GRILLE, 0-DEG DEFLECTION, 3/32" BARS ON 1/4" SPACEING WITH 3/4" FLANGED FRAME. LENGTH AND HEIGHT INDICATED ON PLANS. PRICE; LBP-15A-750 OR APPROVED EQUAL.
- PROVIDE CONTINUOUS ARCHITECTURAL SLOT GRILLE ALONG EDGE OF CEILING WITH 1- 2" SLOT. FOR SUPPLY SECTIONS PROVIDE JET THROW, VERTICAL PATTERN AND SUPPLY PLENUM WITH FOAM INSULATION (CFP). FOR RETURN SECTIONS PROVIDE FULLY OPEN SLOT AND RETURN AIR SIGHT BAFFLE. WHERE TERMINATING AT A WALL PROVIDE FLUSH END, OTHERSIE PROVIDE MITERED ENDS AND OR CORNERS. PROVIDE EXPOSED FRAME (EF) WITH CONCEALED MOUNTING CLIP (MP-DR). PRICE; CFJS OR APPROVED EQUAL SEE DETAIL D/M503.
- (6) IN WALL DRYER VENT BOX
- (7) NOT USED.
- GRADE GROUND LEVEL INSIDE UTILITY YARD AND TREAT SOIL WITH WEED KILLER. PROVIDE TWO LAYERS OF WEED CLOTH LAID WITH SEAMS AT 90 DEGREES TO ONE ANOTHER AND COVER WITH MINIMUM 3" THICK LAYER OF #57 GRAVEL FROM EDGE OF EQUIPMENT PADS TO YARD WALLS.
- (9) INTERNALLY LINED TRANSFER AIR DUCT ABOVE CEILING WITH ELBOWS.
- (10) NOT USED.
- AIR COOLED CHILLER AND PRIMARY PUMP TO BE INSTALLED AS PART OF THIS PROJECT.
- AIR COOLED CHILLER AND PRIMARY PUMP TO BE INSTALLED AS PART OF FUTURE EPICENTER PROJECT. PIPING UP TO ISOLATION VALVES AS INDICATED TO BE INSTALLED AS PART OF THIS PROJECT.
- (13) AIR COOLED CHILLER SEE DETAIL A/M501 & E/M501
- √14 VERTICAL INLINE PRIMARY PUMP SEE DETAIL B/M501

E Marchitects


ARCHITECTURE
PLANNING INTERIORS
GRAPHICS

ELLIOTT MARSHALL INNES P.A. (EMI architects)
251 E. 7TH AVENUE TALLAHASSEE FL 32303
(850) 222 - 7442
www.emiarch.com
LICENSE #s AA C000409 IB C000153

NOTE:

11" x 17" SHEETS ARE PLOTTED AT 1/2

THE SCALE NOTED ON THESE DRAWINGS.

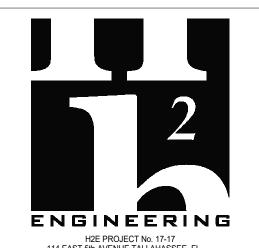

114 EAST 5th AVENUE TALLAHASSEE, FL
32303 PHONE 850.224.7922
www.HZEngineering.com

THIS DOCUMENT IS THE PROPERTY OF HZEngineering
AND IS PREPARED AS AN INSTRUMENT OF SERVICE. ITS
USE, REUSE OR REPRODUCTION, EXCEPT BY WRITTEN
AGREEMENT WITH HZEngineering, IS PROHIBITED.

Florida Registry #2485

Jeffrey L. Tyler, P.E. #57093 Jeffrey Lee Tyler, State of Florida,

Professional Engineer, License No. **57093**This item has been digitally signed and sealed

by **Jeffrey Lee Tyler**, **P.E**. on the date indicated here.

Printed copies of this document are not considered signed and sealed, and the

signature must be verified on any electronic copies.

Date: 02/10/2025

WCSD EDUCATIONAL ANCILLARY FACILITIES -DISTRICT OFFICE

RECEIVED
ALLSTATE CONSTRUCTION
02-13-2025

REV DATE DESCRIPTION

1	2/11/2025	ADDENDUM #1		
DD0 150	T DU A O F			
PROJEC	PROJECT PHASE			
CONSTRUCTION DOCUMENTS				
DATE DRAWN BY			DRAWN BY	
15 JANUARY 2025			JZB	
PROJECT NO CHECKED BY			CHECKED BY	


ROOF PLAN

MTS

SHEET NO REV NO

68100

SHEET TITLE

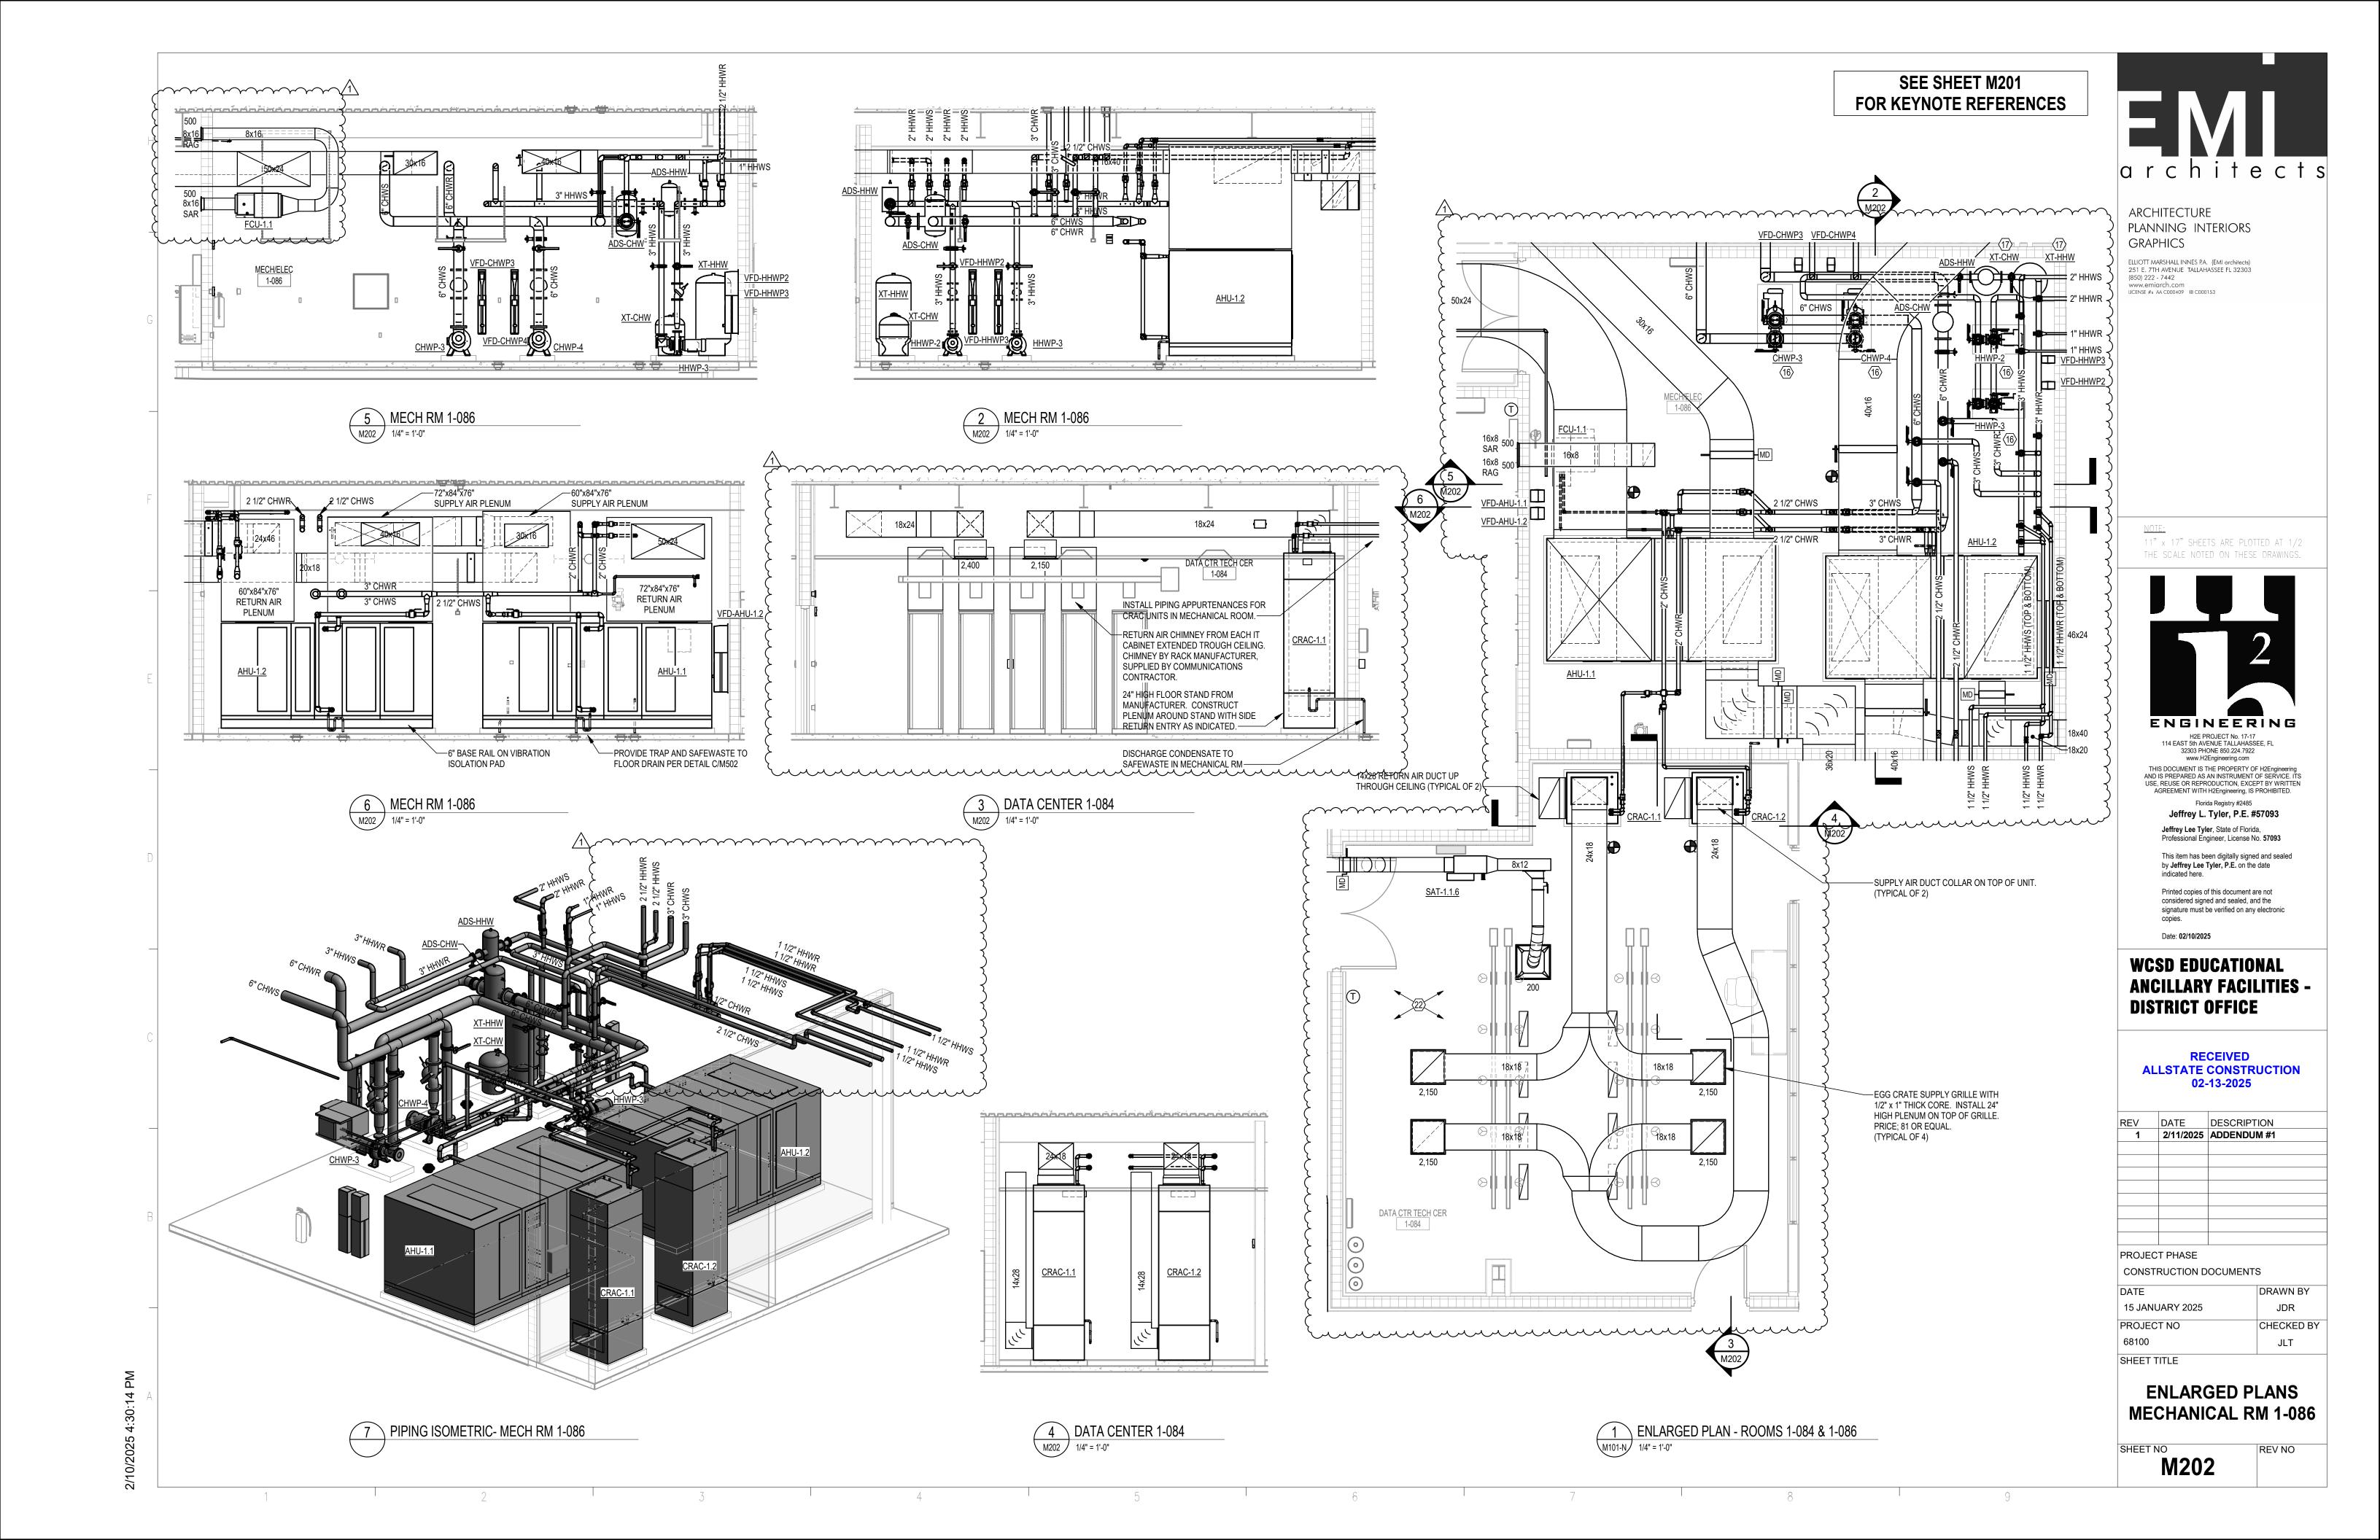

HEAT PIPE PIPING

MECHANICAL RM 2-038


VFD-AHU-2.1



ARCHITECTURE PLANNING INTERIORS **GRAPHICS**

ELLIOTT MARSHALL INNES P.A. (EMI architects)
251 E. 7TH AVENUE TALLAHASSEE FL 32303
(850) 222 - 7442
www.emiarch.com
ucense #s Aa C000409 IB C000153

11" x 17" SHEETS ARE PLOTTED AT 1/2 THE SCALE NOTED ON THESE DRAWINGS.

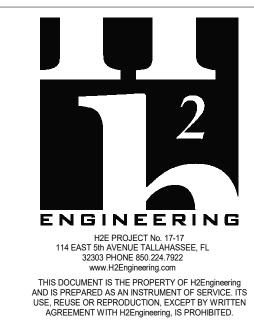

Florida Registry #2485 Jeffrey L. Tyler, P.E. #57093

Jeffrey Lee Tyler, State of Florida, Professional Engineer, License No. 57093 This item has been digitally signed and sealed by **Jeffrey Lee Tyler**, **P.E.** on the date

Printed copies of this document are not considered signed and sealed, and the

signature must be verified on any electronic Date: 02/10/2025

WCSD EDUCATIONAL ANCILLARY FACILITIES -DISTRICT OFFICE

RECEIVED ALLSTATE CONSTRUCTION 02-13-2025

REV	DATE	DESCRIPTION
1	2/11/2025	ADDENDUM #1


PROJECT PHASE


SHEET TITLE


CONSTRUCTION DOCUMENTS DRAWN BY 15 JANUARY 2025 JDR CHECKED BY PROJECT NO JLT


ENLARGED PLANS MECHANICAL RM 2-038


M203

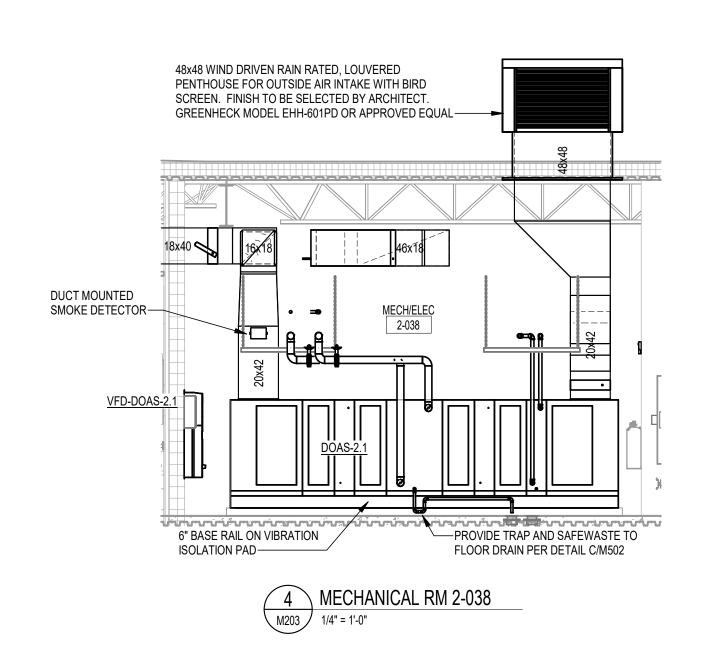

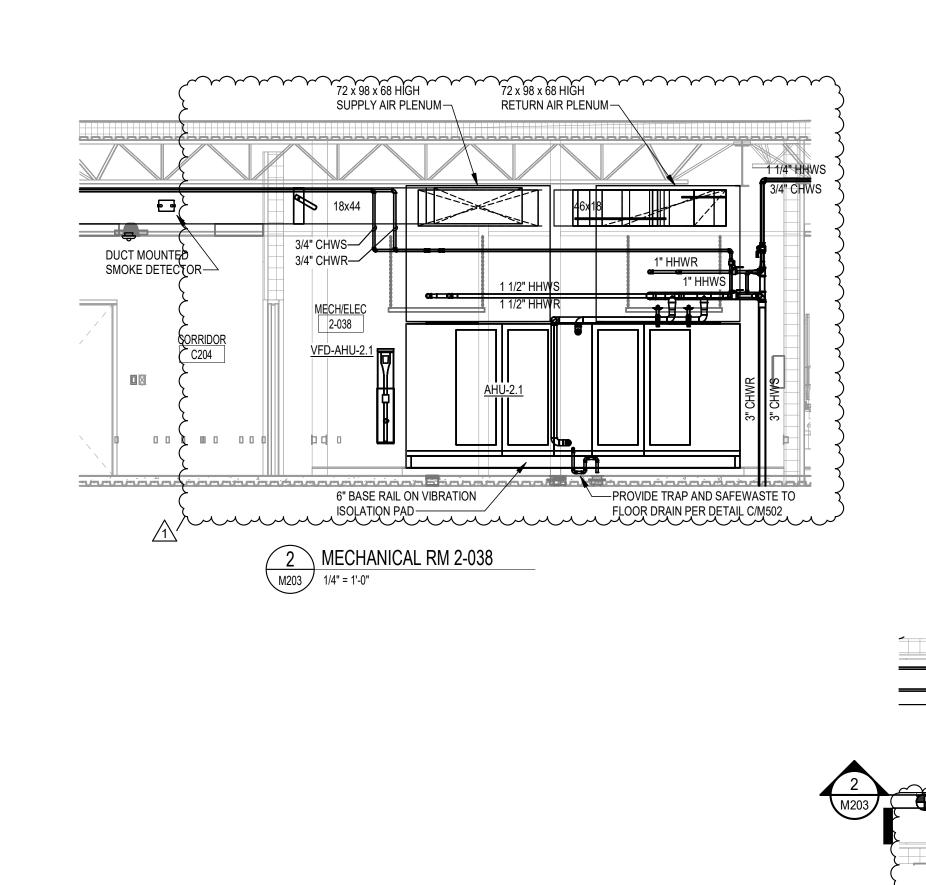

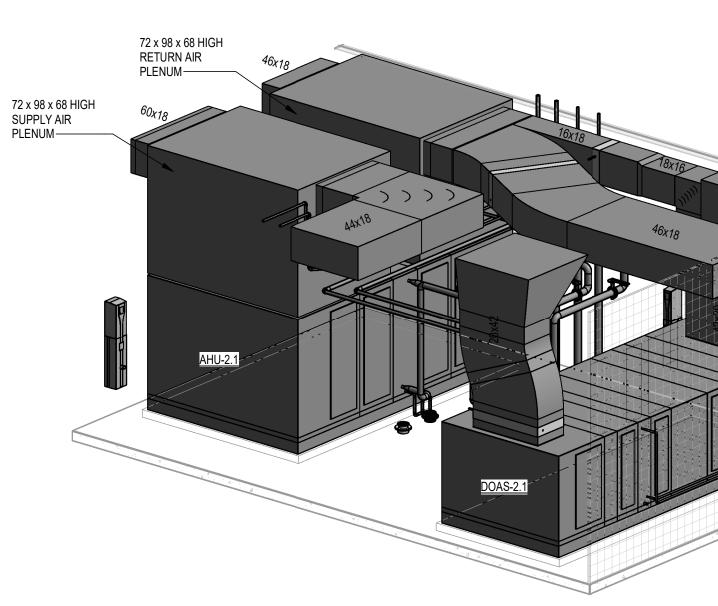

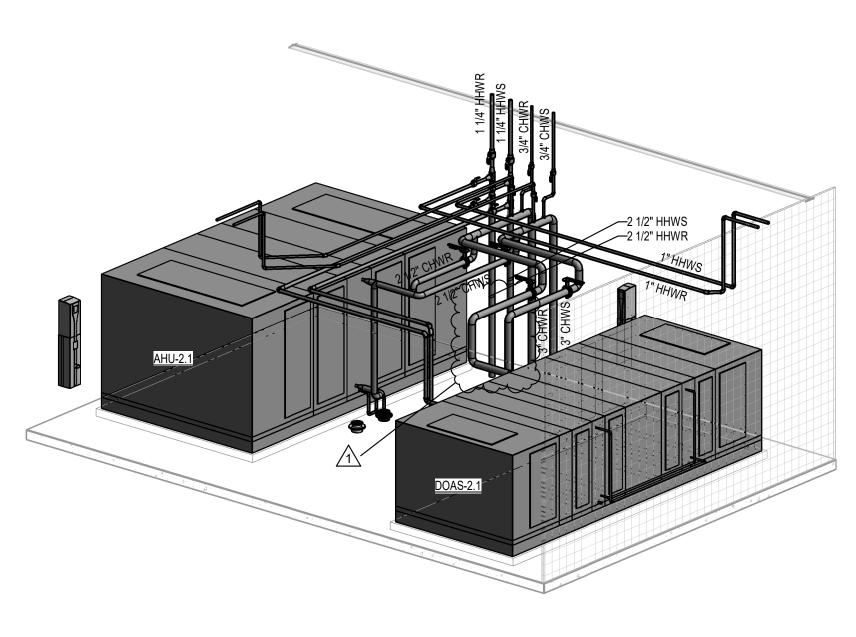

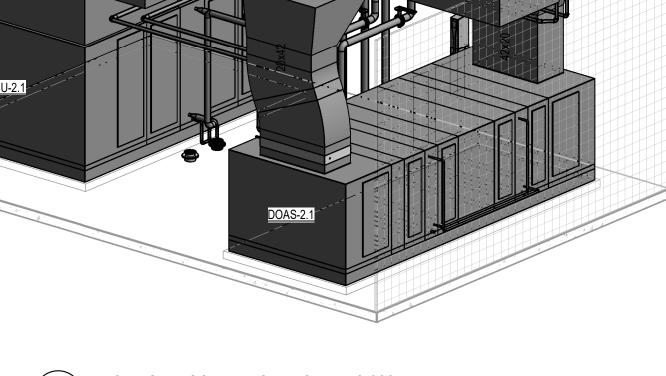

SEE SHEET M201 FOR KEYNOTE REFERENCES



ARCHITECTURE PLANNING INTERIORS

GRAPHICS ELLIOTT MARSHALL INNES P.A. (EMI architects)
251 E. 7TH AVENUE TALLAHASSEE FL 32303
(850) 222 - 7442
www.emiarch.com
ucense #s Aa C000409 IB C000153

> 11" x 17" SHEETS ARE PLOTTED AT 1/2 THE SCALE NOTED ON THESE DRAWINGS.



Florida Registry #2485 Jeffrey L. Tyler, P.E. #57093

Jeffrey Lee Tyler, State of Florida, Professional Engineer, License No. 57093 This item has been digitally signed and sealed by **Jeffrey Lee Tyler**, **P.E.** on the date

Printed copies of this document are not considered signed and sealed, and the signature must be verified on any electronic

Date: 02/10/2025

WCSD EDUCATIONAL ANCILLARY FACILITIES -DISTRICT OFFICE

RECEIVED ALLSTATE CONSTRUCTION 02-13-2025

REV	DATE	DESCRIPTION
1	2/11/2025	ADDENDUM #1

PROJECT PHASE

PROJECT NO

CONSTRUCTION DOCUMENTS DRAWN BY 15 JANUARY 2025


JLT SHEET TITLE

JDR

CHECKED BY

ENLARGED PLANS MECHANICAL RM 2-012

M204

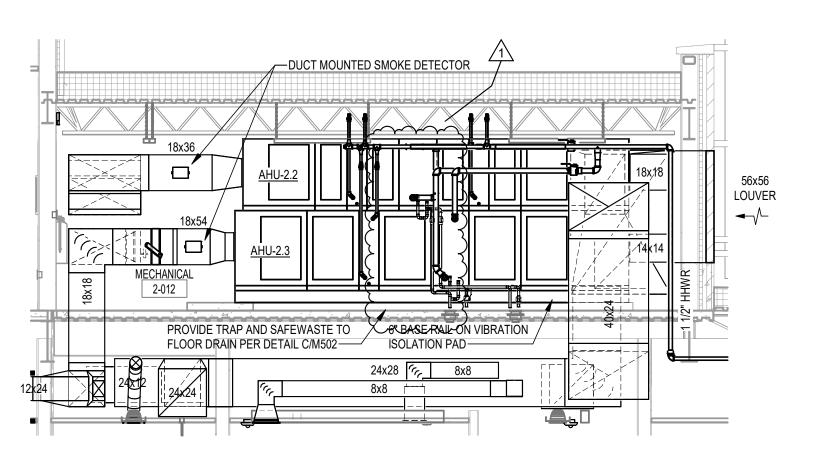



RA DUCT TO AHU-2.3


THROUGH FLOOR

\ <u>AHU-2.2</u> /

AHU-2.3

LINED RA PLENUM



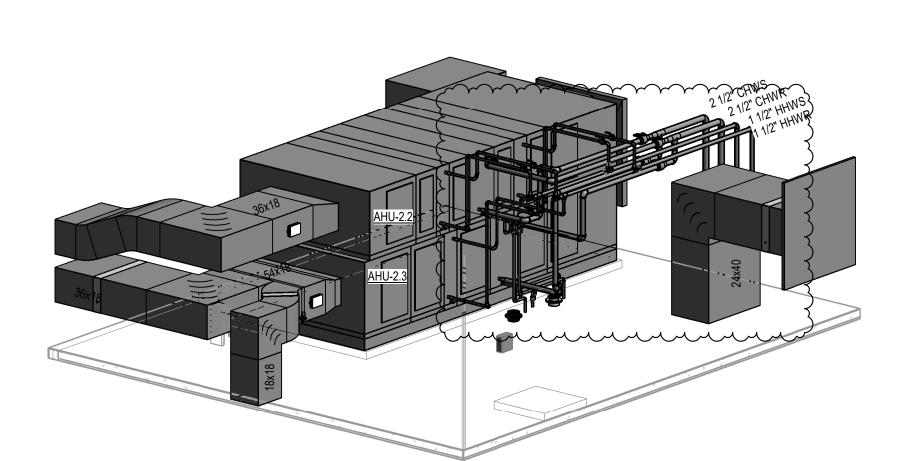




M<u>ECHANICA</u>L 2-012

56x56

LOUVER

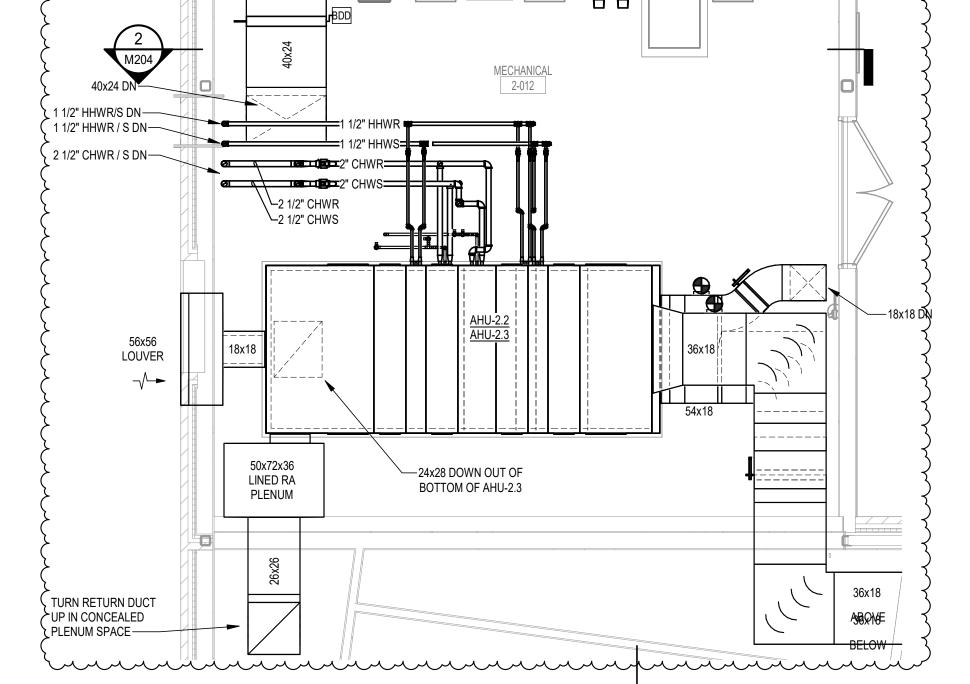





TURN ELBOW UP

IN PLENUM SPACE-


SEE SHEET M201 FOR KEYNOTE REFERENCES

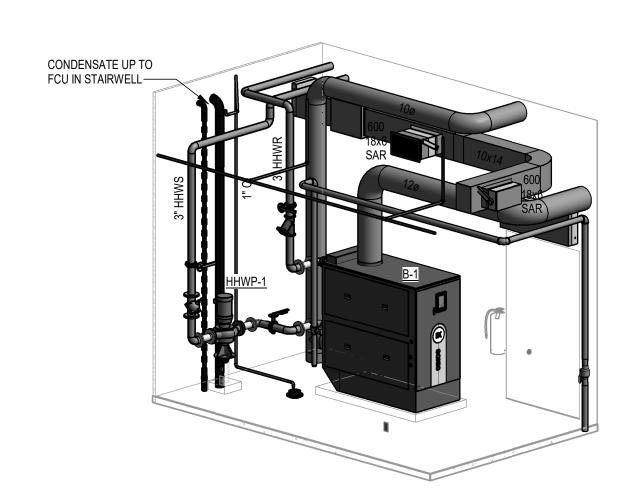


PIPING ISOMETRIC- BOILER RM 1-088

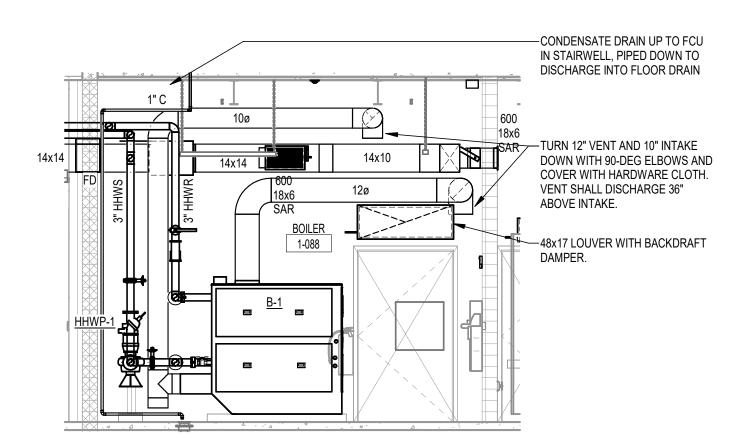




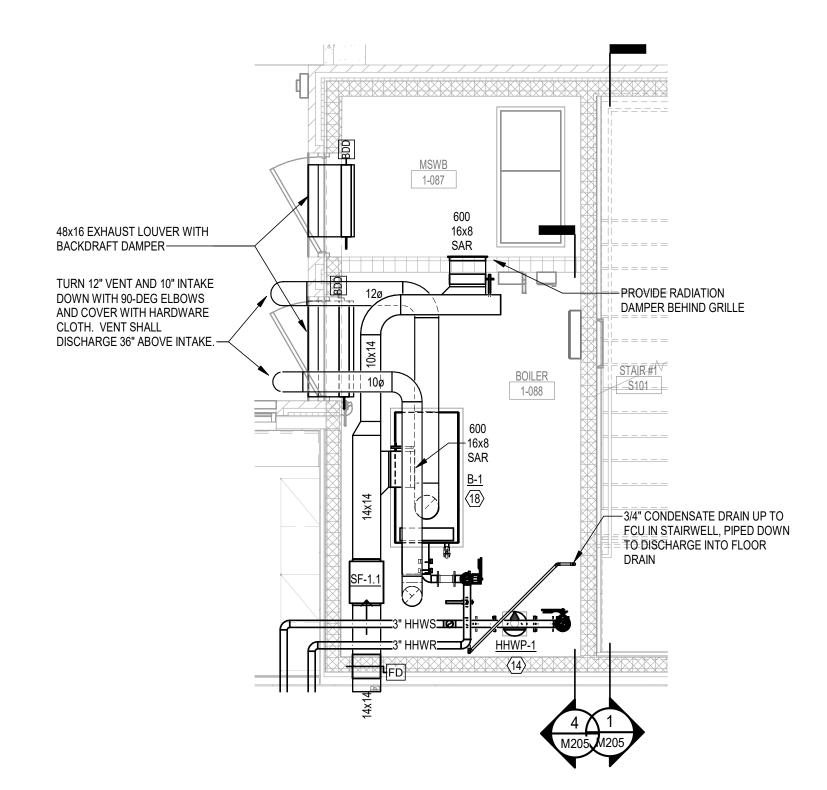



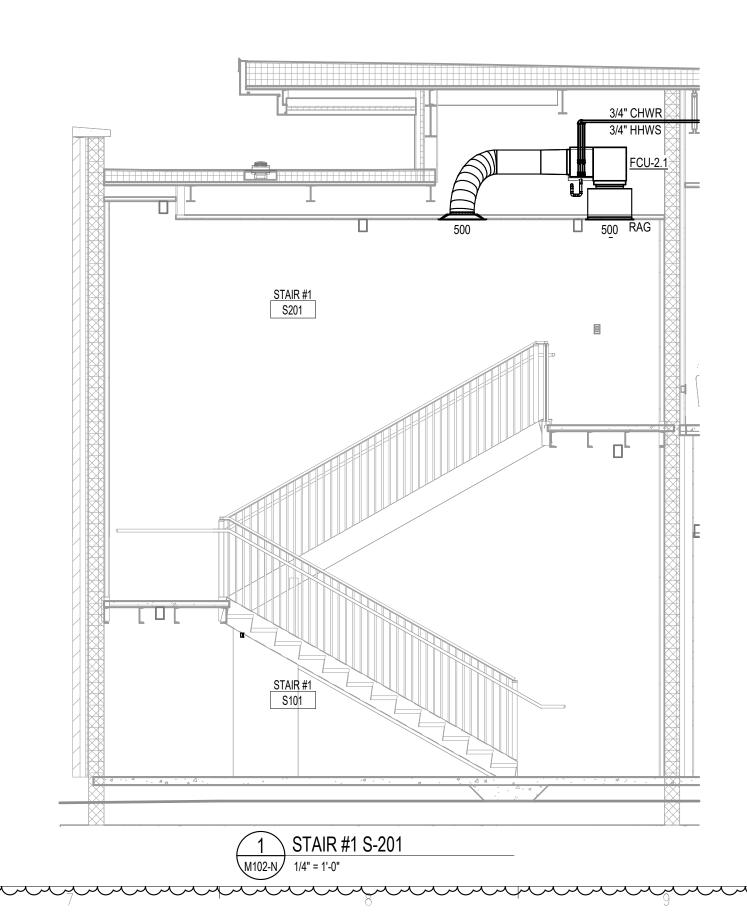


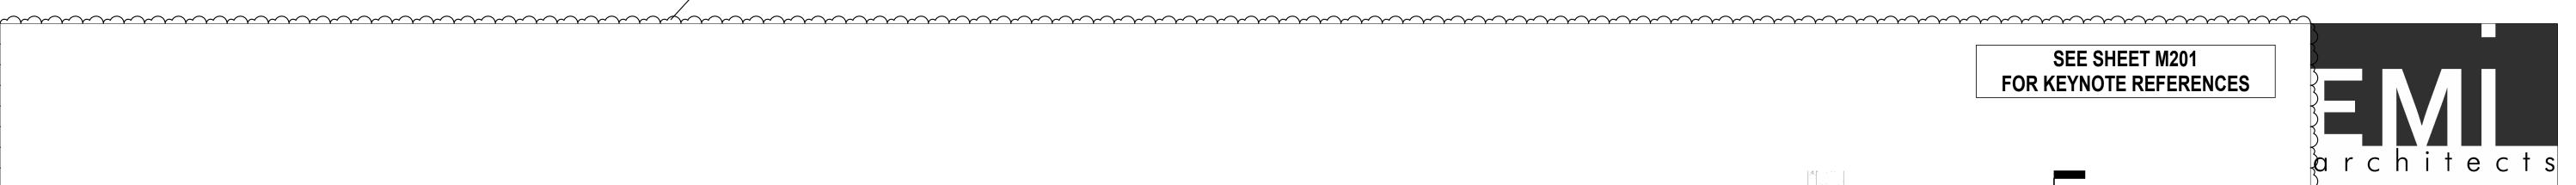

ARCHITECTURE PLANNING INTERIORS) GRAPHICS

ELLIOTT MARSHALL INNES P.A. (EMI orchitects)
251 E. 7TH AVENUE TALLAHASSEE FL 32303
(850) 222 - 7442
www.emiarch.com
ucense #s Aa C000409 IB C000153

11" x 17" SHEETS ARE PLOTTED AT 1/2 THE SCALE NOTED ON THESE DRAWINGS.

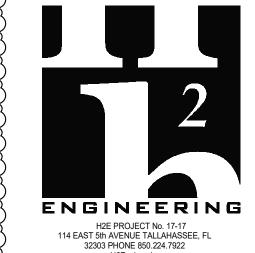

www.H2Engineering.com THIS DOCUMENT IS THE PROPERTY OF H2Engineering AND IS PREPARED AS AN INSTRUMENT OF SERVICE. ITS USE, REUSE OR REPRODUCTION, EXCEPT BY WRITTEN AGREEMENT WITH H2Engineering, IS PROHIBITED.

Florida Registry #2485

Jeffrey L. Tyler, P.E. #57093 Jeffrey Lee Tyler, State of Florida, Professional Engineer, License No. 57093

This item has been digitally signed and sealed by **Jeffrey Lee Tyler**, **P.E.** on the date

Printed copies of this document are not considered signed and sealed, and the

Date: 02/10/2025


WCSD EDUCATIONAL ANCILLARY FACILITIES -DISTRICT OFFICE

RECEIVED
ALLSTATE CONSTRUCTION
02-13-2025

٧	DATE	DESCRIPT	ION		
1	2/11/2025	ADDENDU	M #1		
ROJECT PHASE					
ONSTRUCTION DOCUMENTS					
CHOTHOUTION DOCOMENTO					
ATE			DRAWN BY		
5 JANUARY 2025			JDR		

CHECKED BY PROJECT NO JLT SHEET TITLE


ENLARGED PLANS

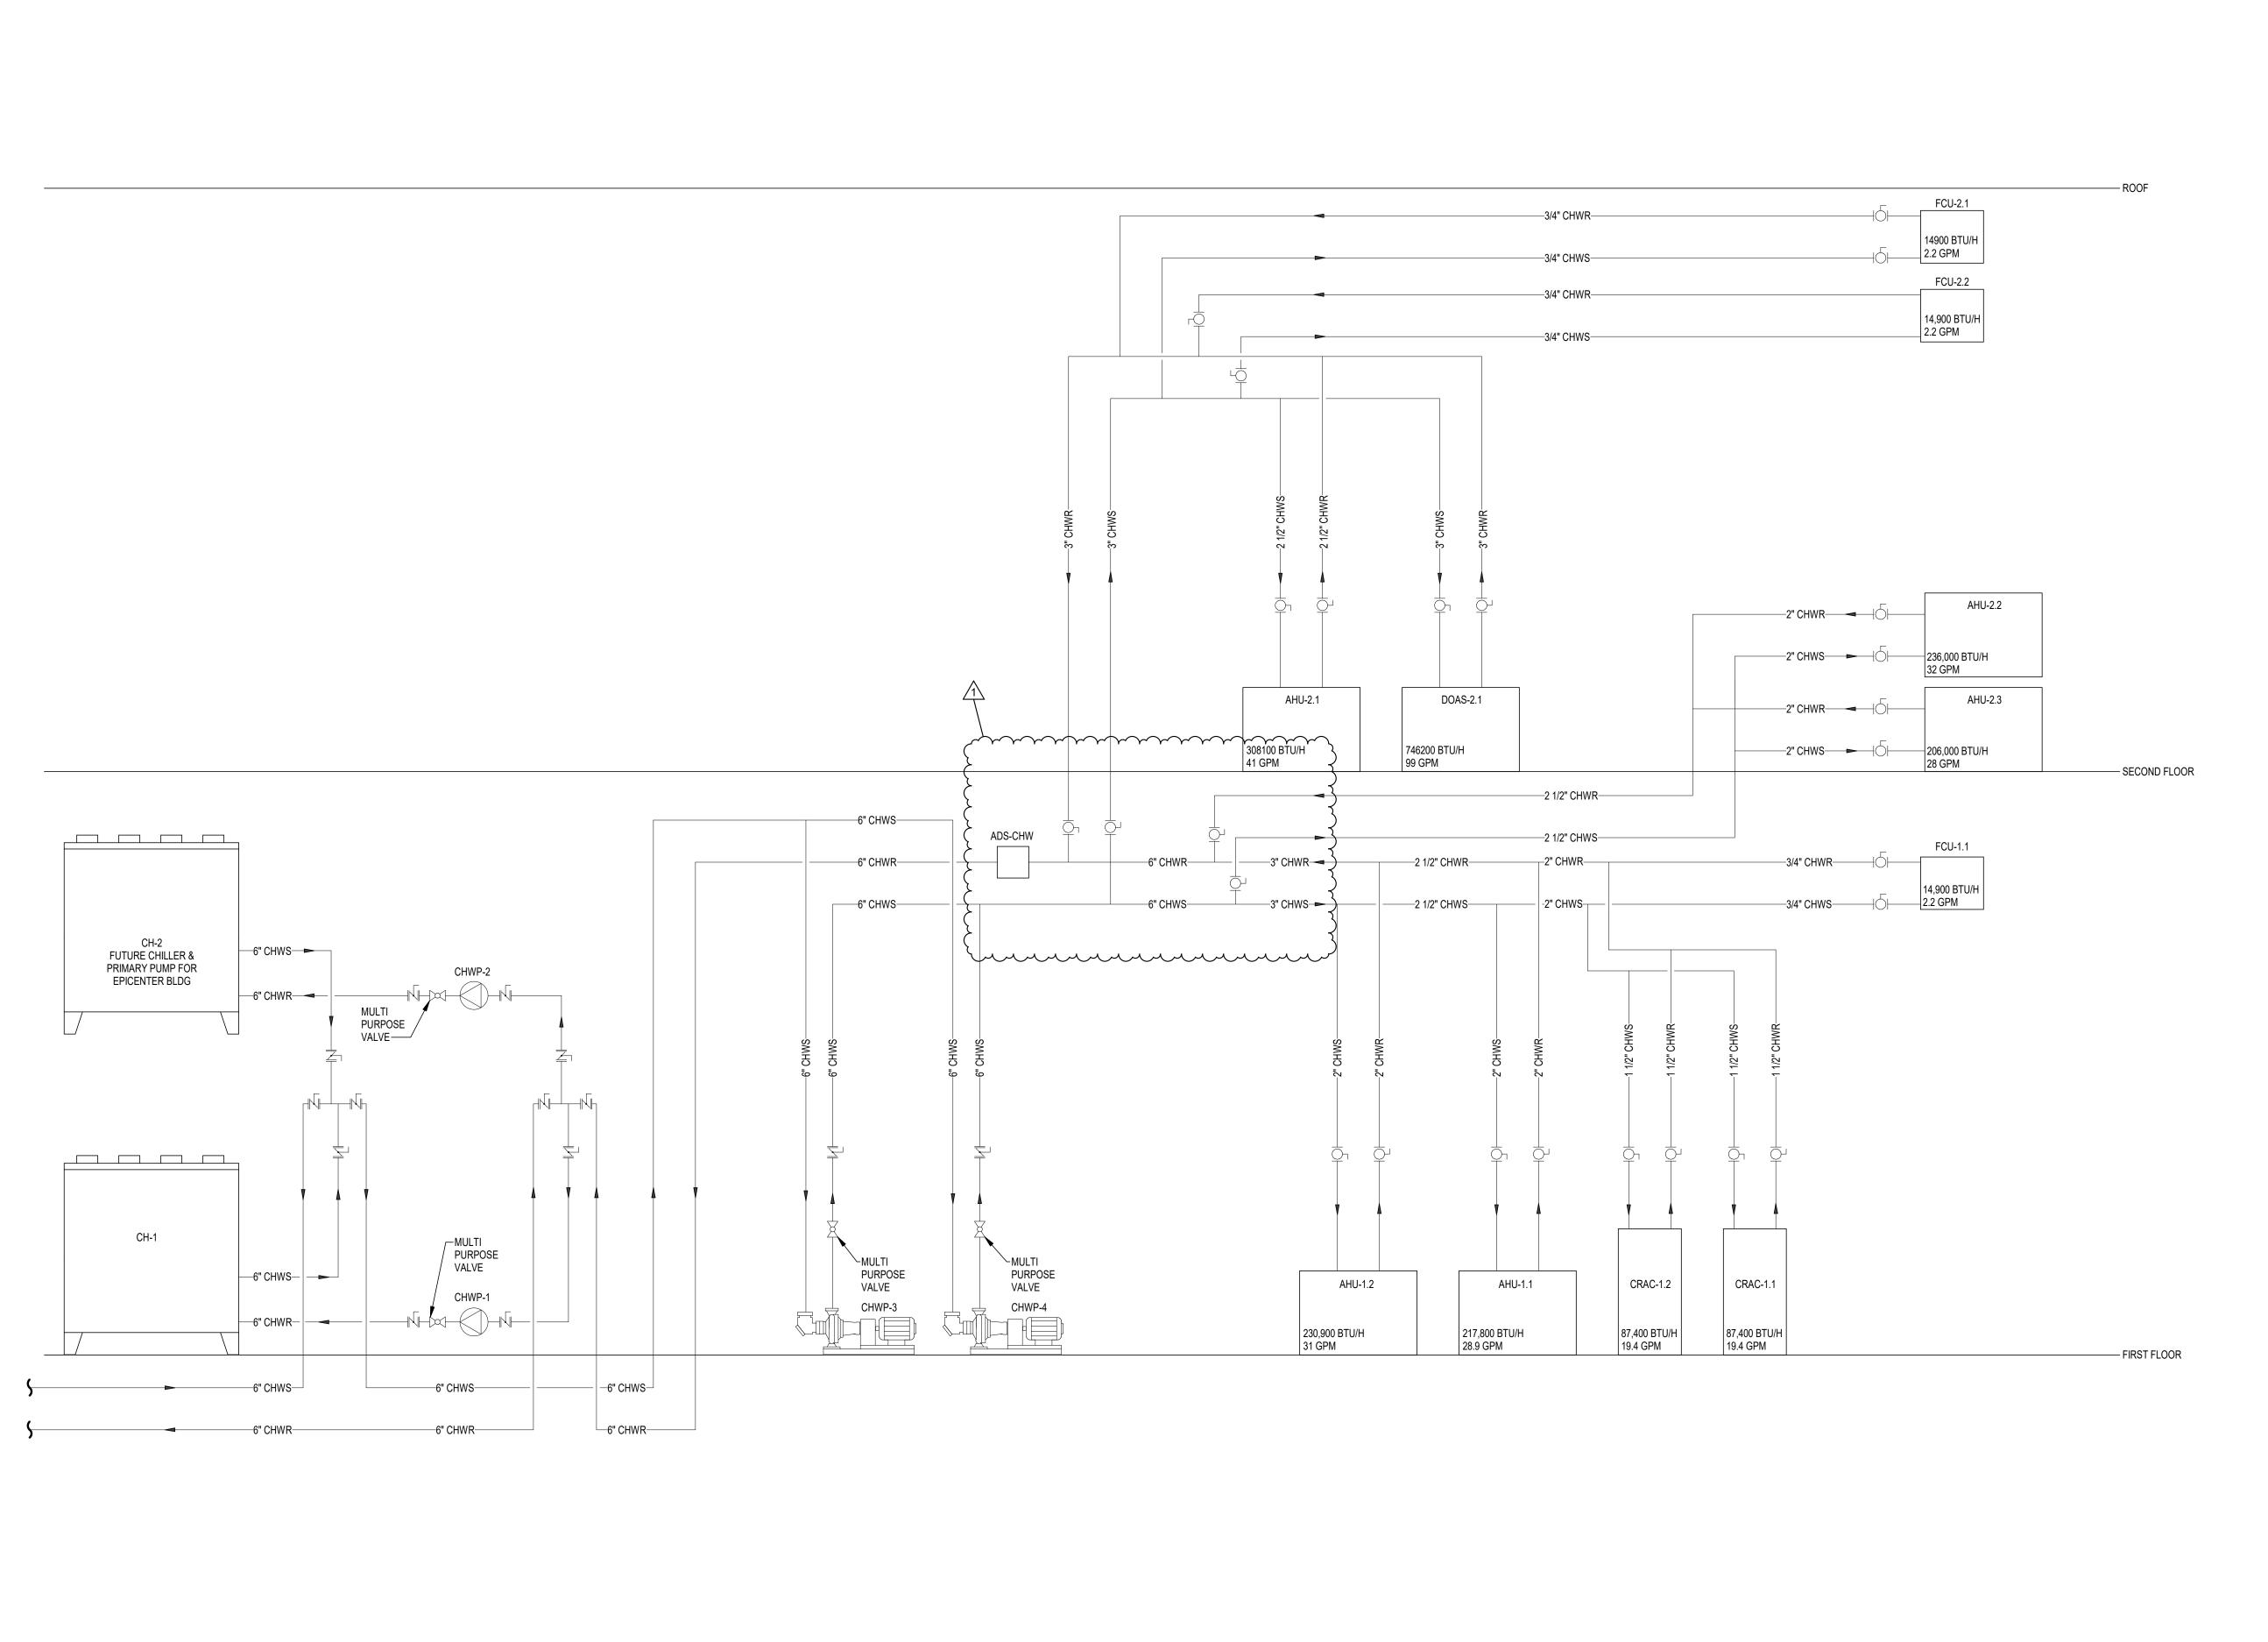



ELLIOTT MARSHALL INNES P.A. (EMI architects)
251 E. 7TH AVENUE TALLAHASSEE FL 32303
(850) 222 - 7442
www.emiarch.com
LICENSE #s AA C000409 IB C000153

NOTE: 11" x 17" SHEETS ARE PLOTTED AT 1/2 THE SCALE NOTED ON THESE DRAWINGS.

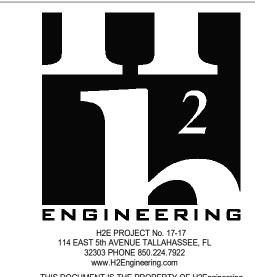

THIS DOCUMENT IS THE PROPERTY OF H2Engineering
AND IS PREPARED AS AN INSTRUMENT OF SERVICE. ITS
USE, REUSE OR REPRODUCTION, EXCEPT BY WRITTEN
AGREEMENT WITH H2Engineering, IS PROHIBITED.
Florida Registry #2485

Jeffrey Lee Tyler, State of Florida, Professional Engineer, License No. **57093**

Jeffrey L. Tyler, P.E. #57093

This item has been digitally signed and sealed by **Jeffrey Lee Tyler**, **P.E.** on the date indicated here.

Printed copies of this document are not considered signed and sealed, and the signature must be verified on any electronic

Date: **02/10/2025**

WCSD EDUCATIONAL ANCILLARY FACILITIES -DISTRICT OFFICE

RECEIVED
ALLSTATE CONSTRUCTION
02-13-2025

REV	DATE	DESCRIPTION
1	2/11/2025	ADDENDUM #1
PROJE	CT PHASE	ı

PROJECT PHASE

CONSTRUCTION DOCUMENTS

DATE
15 JANUARY 2025


PROJECT NO
68100

SHEET TITLE

DRAWN BY
JDR
CHECKED BY
JLT

CHW PIPING SCHEMATIC

EET NO REV NO

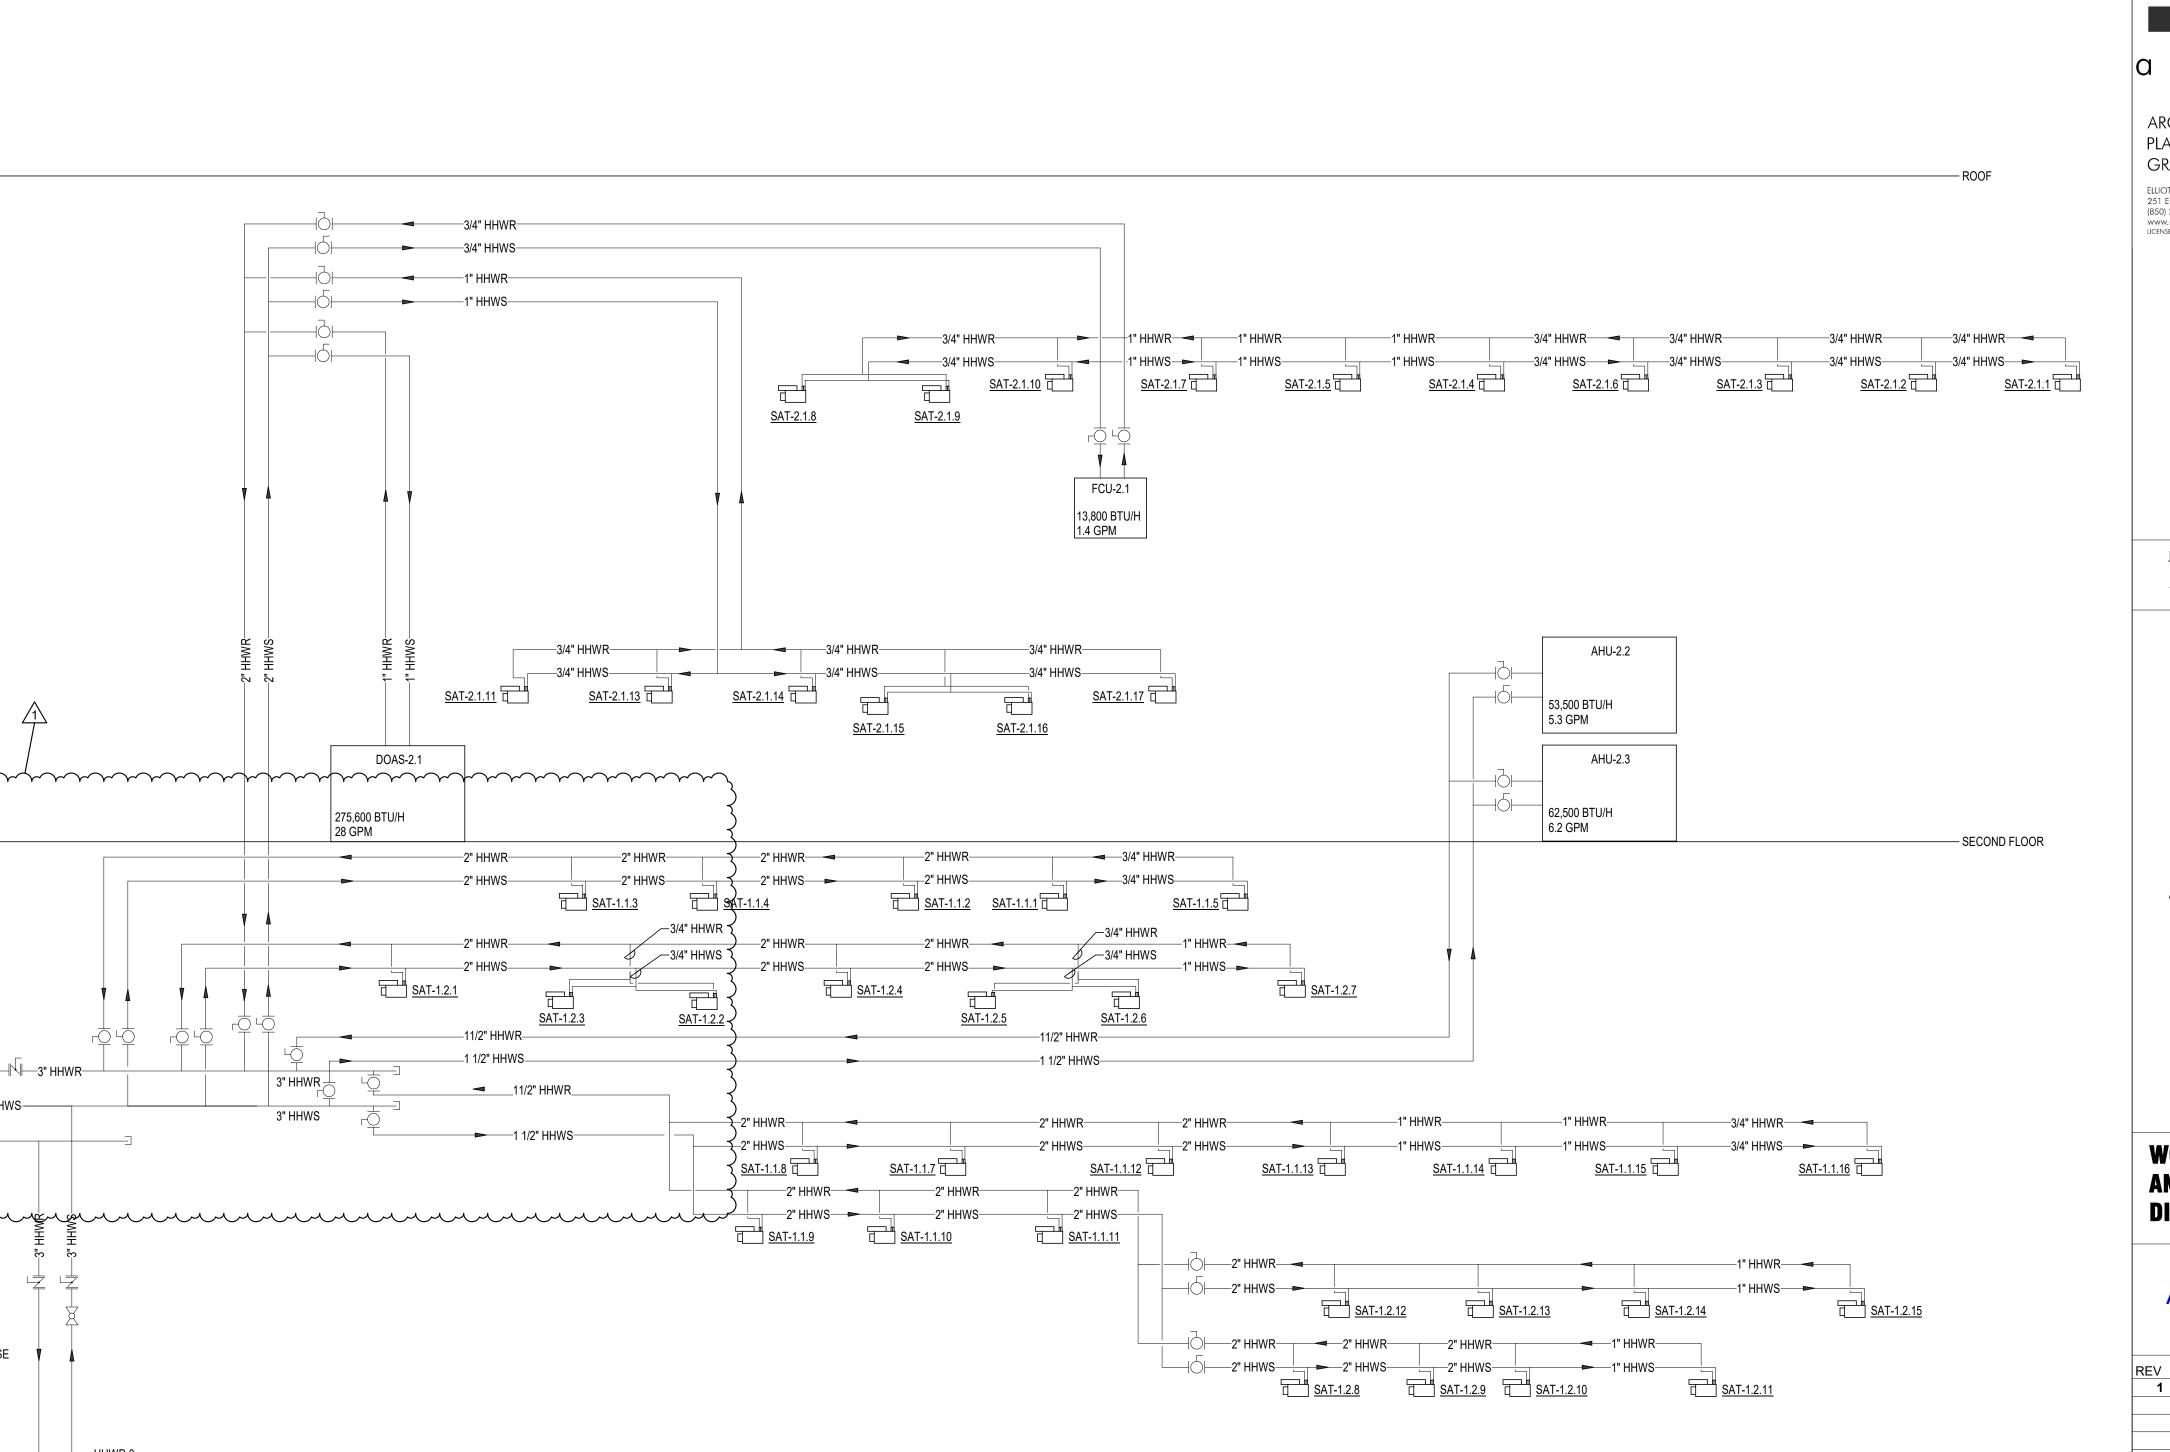

—1" HHWR—

—2" HHWR—

_1 1/2" HHWS___

____11/2" HHWR_

→ 1 1/2" HHWS—

—2" HHWR—

----2" HHWS--

SAT-1.1.3

SAT-1.2.3

→ 1" HHWS—

275,600 BTU/H

SAT-1.2.1

28 GPM

3" HHWR

3" HHWS

ADS-HHW

B-1

HHWP-1

PURPOSE

architects

ARCHITECTURE PLANNING INTERIORS GRAPHICS

ELLIOTT MARSHALL INNES P.A. (EMI architects)
251 E. 7TH AVENUE TALLAHASSEE FL 32303
(850) 222 - 7442
www.emiarch.com
ucense #s Aa C000409 IB C000153

11" x 17" SHEETS ARE PLOTTED AT 1/2 THE SCALE NOTED ON THESE DRAWINGS.



Florida Registry #2485 Jeffrey L. Tyler, P.E. #57093 Jeffrey Lee Tyler, State of Florida,

Professional Engineer, License No. 57093 This item has been digitally signed and sealed by **Jeffrey Lee Tyler**, **P.E.** on the date

Printed copies of this document are not considered signed and sealed, and the signature must be verified on any electronic

Date: 02/10/2025

WCSD EDUCATIONAL ANCILLARY FACILITIES -DISTRICT OFFICE


RECEIVED ALLSTATE CONSTRUCTION 02-13-2025

REV	DATE	DESCRIPT	ION	
1	2/11/2025	ADDENDU	M #1	
PROJECT PHASE				
CONSTRUCTION DOCUMENTS				
DATE DRAWN BY			DRAWN BY	

15 JANUARY 2025 JDR CHECKED BY PROJECT NO JLT

HHW PIPING SCHEMATIC

SHEET TITLE

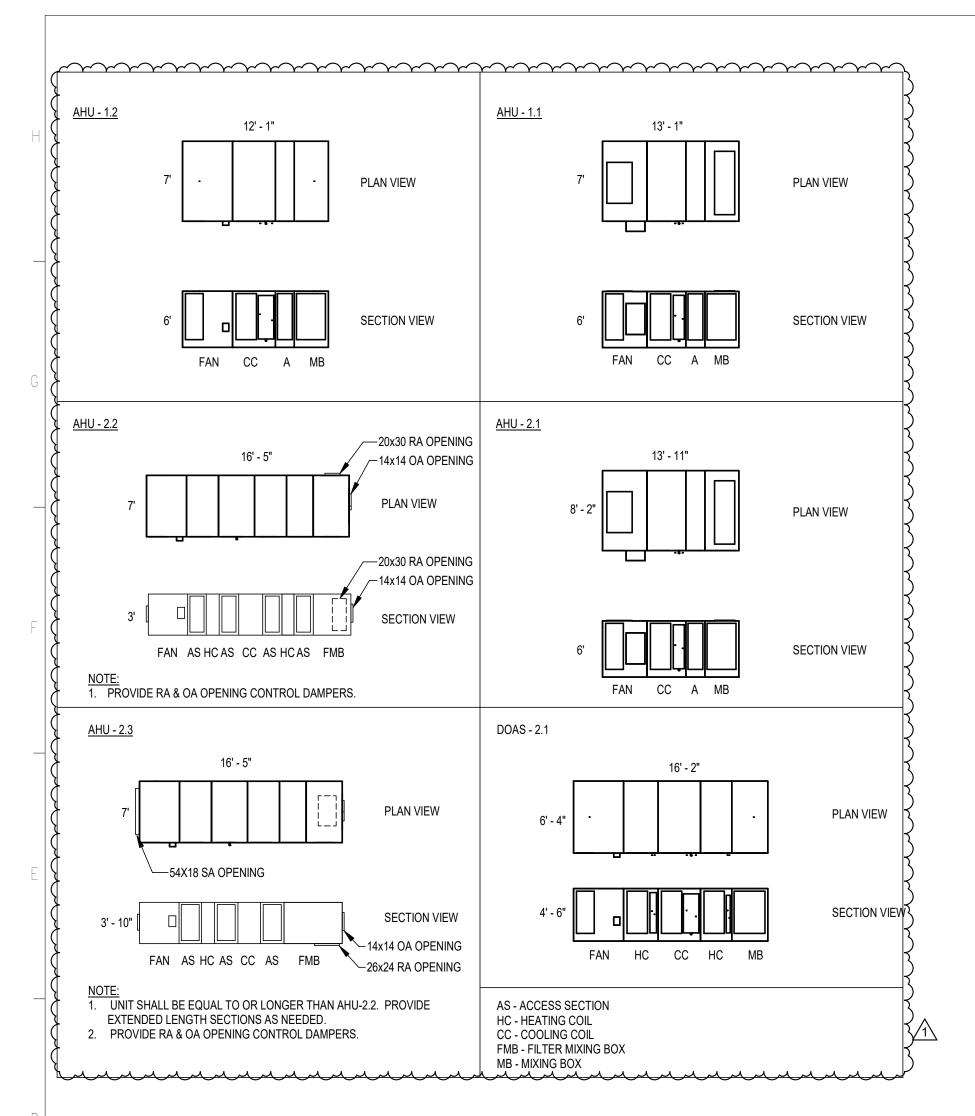

, t • •	OLED CHILLER SCHEDULE		
DESIGNATION			CH-1/2
CHILLER UNIT	DATA		
	NOMINAL CAPACITY	TONS	200
	REFRIGERATION CAPACITY TOTAL	TONS	196.8
	NO. OF COMPRESSORS & NO. OF CIRCUITS	#-#	2 –
	TYPE OF REFRIGERANT		R-134A
	REFRIGERANT CHARGE	LBS.	436
	OPERATING WEIGHT	LBS.	14,800
EVAPORATOR	R DATA		
	WATER SUPPLY TEMPERATURE	°F	44
	WATER RETURN TEMPERATURE	°F	59
	FLOW RATE	GPM	280
	PASSES	#	2
	PRESSURE DROP	FT.	6.6
	WORKING PRESSURE	PSIG	150
	FOULING FACTOR	HR*SF*DEG/BTU	0.00010
	PERCENT ETHYLENE GLYCOL	%	0
CONDENSER	DATA		
	AMBIENT AIR TEMPERATURE	°F	98
	NUMBER OF FANS	#	12
	FAN TYPE		VARIABLE SPEE
	CONDENSER COILS (TUBES / FINS)		MICROCHANNEI
	CONDENSER COATING		NONE
PERFORMANO	DE DATA	1	
	ENERGY EFFICIENCY RATIO (@ 100% LOAD)	BTU / (W*HR)	11.9
	NPLV	BTU / (W*HR)	21.2
	IPLV	BTU / (W*HR)	21.2
ELECTRICAL I	DATA	1	
	COMPRESSOR STARTER TYPE		VFD
	ELECTRICAL CHARACTERISTICS & NO. OF CIRCUITS	V/PH - #	460 / 3 –
	MCA	AMPS	330.0
	MOCP	AMPS	450.0
	TOTAL POWER	kW	198.3
MANUFACTUE	RER		TRANE
MODEL			ACRB200
DETAIL REFER	RENCE		A/M503
NOTES: 1 2 3 4	PROVIDE SEPARATE 115V/1Ø POWER CONNECTION FOR EVAPOR PROVIDE CONTROL POWER TRANSFORMER. PROVIDE VARIABLE FREQUENCY DRIVE AND UNIT CONTROLS HO CONDENSER ENVIRONMENT GUARD PREMIUM: PROVIDE ELECTE FLEXIBLE EPOXY COATING, 6,000 HOUR SALT SPRAY RESISTANCE	DUSED IN AN OUTDOOR RATED W RO-MECHANICALLY BONDED	/EATHER TIGHT ENCLO

DESIGNATION	N		B - 1					
	FUEL TYPE		NATURAL GAS					
	INSTALLATION RATING		INDOOR					
	ТҮРЕ		CONDENSING					
	HEAT EXCHANGER TYPE		WATERTUBE					
	HEAT EXCHANGER MATERIAL		STAINLESS STEEL					
	INPUT CAPACITY	MBTUH	1,500					
	OUTPUT CAPACITY	MBTUH	1,456					
	EFFICIENCY	%	97					
	TURN DOWN	RATIO	5:1					
	WATER SUPPLY TEMPERATURE	°F	180					
	WATER RETURN TEMPERATURE	°F	160					
	WATER FLOW	GPM	146					
	ELECTRICAL CHARACTERISTICS	V / PH	208 / 1					
MANUFACTU	RER	,	PATTERSON-KELLEY					
MODEL NUME	BER		SC-1500					
DETAIL REFE	RENCE		E/M502					
NOTES:								
1	PROVIDE SEALED DIRECT VENT KIT.							
2	PROVIDE LOW WATER CUT-OFF - REMOVE PROBE.							
3	PROVIDE MANUAL HIGH AND LOW GAS PRESSURE SWITCH.							
4	PROVIDE HIGH LIMIT CONTROL - MANUAL RESET.							
5	PROVIDE CONDENSATE NEUTRALIZATION KIT.							
6	PROVIDE DOCUMENTATION OF ALL START-UP INTERNAL CONFIGURATIONS AND SET-POINTS TO ENGINEER PRIOR TO SUBSTANTIAL COMPLETION							
7	PROVIDE MOTORIZED DAMPERS ON [FLUE AND] COMBUSTION	VID V/ENTS						

PROVIDE HOT GAS BYPASS

PROVIDE ULTRA QUIET FANS VARIABLE SPEED FANS

PROVIDE EVAPORATOR NOZZLE EXTENSION KIT PROVIDE VARIABLE SPEED CONDENSER FANS PROVIDE WIRE, LOUVERED ENCLOSURE PANELS

PROVIDE COMPRESSOR ACOUSTIC SOUND BLANKET

ILTER SECTION	TOTAL SUPPLY AIR OUTSIDE AIR					-	
ILTER SECTION							
ILTER SECTION	OUTSIDE AIR	CFM	10,580	9,900	13,100	3,900	5,600
ILTER SECTION		CFM	2,000	2,400	1,600	1,800	900
ILTER SECTION	MINIMUM SUPPLY FAN SPEED SETTING	%	30	30	30	50	30
	MINIMUM OUTSIDE AIR FLOW SETTING	CFM	2,000	2,400	1,600	300	900
-		·					
	DAMPERS		NONE	NONE	NONE (- TOA & RA V	OAR RAV
	FILTER ORIENTATION		ANGLED	ANGLED	ANGLED (ANGLED	ANGLED 1
	TYPE OF FILTER		2" THICK PLEATED	2" THICK PLEATED	2" THICK PLEATED	2"THICK PLEATED	2"THICK PLEATED
REHEAT COIL DATA	A - HYDRONIC	·					
	HEATING CAPACITY	MBTUH				32.6	
	AIR ENTERING HEATING COIL	°F				39.6	
	AIR LEAVING HEATING COIL	°F				55	
	HHW ENTERING & LEAVING TEMPERATURE	°F - °F				160 – 140	
	WATER FLOW	GPM				3.3	
ļ	RUNOUT PIPE SIZE	IN.				3/4	
	CONTROL VALVE (TYPE)					3-WAY	
COOLING COIL DATA	A - HYDRONIC	1					1
	TOTAL COOLING CAPACITY	MBTUH	223.0	203.0	298.0	236.0	206.0
	SENSIBLE COOLING CAPACITY	MBTUH	198.0	174.0	268.0	115.0	141.0
	AIR ENTERING COOLING COIL	°Fdb - °Fwb	71.2 – 60.9	70.1 – 60.8	72.9 – 61.4	80.6 – 72.1	77.0 – 65.8
	AIR LEAVING COOLING COIL	°Fdb - °Fwb	54.0 - 53.5	54.0 – 53.5	54.0 – 53.5	54.0 – 53.5	54.0 – 53.5
	CHW ENTERING & LEAVING TEMPERATURE	°F - °F	44 – 59	44 – 59	44 – 59	44 – 59	44 – 59
	WATER FLOW	GPM	30	27	40	32	28
	MINIMUM FACE AREA (@ 450 FPM)	SQ. FT.	23.5	22.0	29.1	8.7	12.4
-	GLYCOL CONCENTRATION	%	0	0	0	0	0
-	RUNOUT PIPE SIZE	IN.	2	2	2 1/2	2	2
-	CONDENSATE DRAIN SIZE	IN.	1	1	1	1	1
-	CONTROL VALVE (TYPE)		2-WAY	2-WAY	2-WAY	2-WAY	2-WAY
 				2	2 777.1		2 777.1
	HEATING AIRFLOW (% OF TOTAL SUPPLY AIR)	%				50	30
	HEATING CAPACITY	MBTUH				62.2	53.6
-	AIR ENTERING HEATING COIL	°F				55	55
-	AIR LEAVING HEATING COIL	°F				84	84
-	HHW ENTERING & LEAVING TEMPERATURE	°F - °F				160 – 140	160 – 140
-	WATER FLOW	GPM				6.2	5.4
-	RUNOUT PIPE SIZE	IN.				1	
-		IIV.					3-WAY
	CONTROL VALVE (TYPE)					3-WAY	3-WAY
SUPPLY FAN SECTIO			DIENIM	DI FAILIM	DI FAILIM	DIENLIM	DIFNIIM
-	FAN TYPE		PLENUM	PLENUM	PLENUM	PLENUM	PLENUM
-	DRIVE TYPE		DIRECT	DIRECT	DIRECT	DIRECT	DIRECT
-	FAN CHARTEL (INC. LIDING DEPLINDANCE)		FEG 85	FEG 85	FEG 85	FEG 85	FEG 85
-	FAN QUANTITY (INCLUDING REDUNDANCY)	#	1	1	1	1	1
-	REDUNDANCY		NONE	NONE	NONE	NONE	NONE
-	EXTERNAL STATIC PRESSURE	IN. WG	2.5	2.5	2.5	2	2.3
-	MAXIMUM TOTAL STATIC PRESSURE (INCLUDING DIRTY FILTER)	IN. WG	3.85	4.04	4.04	4.5	4.8
	DIRTY FILTER ALLOWANCE	IN. WG	0.7	0.7	0.7	0.7	0.7
	FAN MOTOR HORSEPOWER (PER FAN)	HP - BHP	15 – 12.5	15 – 12.7	20 – 17.5	7 1/2 – 5.6	10 – 7
	ELECTRICAL CHARACTERISTICS & NO. OF CIRCUITS	V/PH - #	460 / 3 – 1	460/3 – 1	460/3 – 1	460/3 – 1	460/3 – 1
	MCA / MOCP (PER CIRCUIT)	AMPS - AMPS	26.3 – 45	26.3 – 45	33.8 – 60	13.8 – 20	17.5 – 30
	VARIABLE FREQUENCY DRIVE		1 PER UNIT	1 PER UNIT	1 PER UNIT	1 PER UNIT	1 PER UNIT
OUND CRITERIA			LEVEL LP-1	LEVEL LP-1	LEVEL LP-1	LEVEL LP-1	LEVEL LP-1
MANUFACTURER			TRANE	TRANE	TRANE	TRANE	TRANE

MAXIMUM ALLOWABLE DIMENSIONS FOR EQUIPMENT SHOWN IN AIR HANDLING UNIT LAYOUTS THIS PAGE. SUBMITTAL DATA SHALL INCLUDE INFORMATION DEMONSTRATING COMPLIANCE WITH

PROVIDE FANS WITH A MINIMUM DIAMETER OF 16 INCHES AND FAN EFFICIENCY GRADE AS

REFER TO OTHER EQUIPMENT SCHEDULES FOR PERFORMANCE REQUIREMENTS OF SPECIAL

SUPPLY AIR OPENING SHALL BE OF SUFFICIENT SIZE TO MINIMIZE SYSTEM EFFECT FOR

REFER TO SOUND CRITERIA SCHEDULE FOR SOUND PRESSURE LEVELS.

MAXIMUM ALLOWABLE WIDTH INCLUDING COIL PULL.


DISCHARGE INTO SUPPLY PLENUM.



ARCHITECTURE PLANNING INTERIORS **GRAPHICS**

ELLIOTT MARSHALL INNES P.A. (EMI architects)
251 E. 7TH AVENUE TALLAHASSEE FL 32303
(850) 222 - 7442
www.emiarch.com
UCENSE #s AA C000409 IB C000153

11" x 17" SHEETS ARE PLOTTED AT 1/2 THE SCALE NOTED ON THESE DRAWINGS.

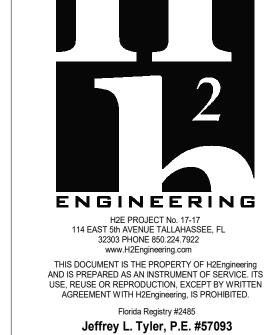

Jeffrey Lee Tyler, State of Florida, Professional Engineer, License No. 57093 This item has been digitally signed and sealed by **Jeffrey Lee Tyler**, **P.E.** on the date

Printed copies of this document are not considered signed and sealed, and the signature must be verified on any electronic

Date: 02/10/2025

WCSD EDUCATIONAL ANCILLARY FACILITIES -DISTRICT OFFICE

RECEIVED ALLSTATE CONSTRUCTION 02-13-2025

REV	DATE	DESCRIPTION
1	2/11/2025	ADDENDUM #1
PROJEC	T PHASE	
CONST	RUCTION D	OCUMENTS

CONSTRUCTION DOCUMENTS

DATE DRAWN BY 15 JANUARY 2025 JDR PROJECT NO CHECKED BY 68100 JLT SHEET TITLE

SCHEDULES

PUMP	S		Pump CHWP-2 is	future		
DESIGNATIO	DN		CHWP-1 / 2	CHWP-3 / 4	HHWP-1	HHWP-2 / 3
APPLICATIO	N					
	SERVICE		CHW	CHW	HHW	HHW
	DISTRIBUTION TYPE		PRIMARY	SECONDARY	SECONDARY	SECONDARY
	LOCATION TYPE		EXTERIOR	INTERIOR	INTERIOR	INTERIOR
ESIGN CRI	TERIA	,				
	TOTAL SYSTEM DESIGN FLOW	GPM	300	300	150	150
	PUMP SEQUENCING		DUTY	DUTY / STANDBY	DUTY	DUTY / STANDBY
	PUMP QUANTITY (INCLUDING REDUNDANCY)	#	1	2	1	2
ERFORMAN	NCE	,		,		
	PUMP TYPE		SPLIT-COUPLED END SUCTION	CLOSE-COUPLED END SUCTION	CLOSE-COUPLED END SUCTION	CLOSE-COUPLED END SUCTION
	PERCENT OF DESIGN FLOW	%	100	100	100	100
	CAPACITY	GPM	300	300	150	150
	TOTAL DYNAMIC HEAD	FT.	35	60	35	60
	EFFICIENCY	%	83	77	77	73
	SHUT-OFF HEAD	FT.	45	70	46	72
	IMPELLER DIAMETER	IN.	6.2	8.25	6.35	8.0
	PUMP SEAL		MECHANICAL	MECHANICAL	MECHANICAL	MECHANICAL
	MOTOR SPEED	RPM	1,760	1,760	1,760	1,760
	MOTOR HORSEPOWER	HP - BHP	5 - 3.2	10 - 5.9	3 - 2	5 - 3.5
	MOTOR ENCLOSURE		TEFC	ODP	ODP	ODP
	MOTOR WINDING		FULL	FULL	FULL	FULL
	ELECTRICAL CHARACTERISTICS	V / PH	460 / 3	460 / 3	460 / 3	460 / 3
	MCA / MOCP	AMPS - AMPS	9.5 – 15	17.5 – 30	6.0 – 15	9.5 – 15
	VARIABLE FREQUENCY DRIVE		NO	YES	NO	YES
	NOTES		N/A	N/A	N/A	N/A
ANUFACTU	JRER		TACO	TACO	TACO	TACO
ODEL NUM	IBER		FI 3007D	CI 3009D	CI 2007D	CI 2009D
ETAIL REF	ERENCE		B/M501	B/M501	C/M501	C/M501

PROVIDE BRONZE WEAR RING

PROVIDE FROM FACTORY SECOND COAT OF PAINT OR CORROSIVE RESISTANT FINISH FOR EXTERIOR PUMP.

COMPUTER ROOM AIR CONDITIONING UNITS UNIT DESIGNATION CRAC-1.1 / 1.2 BLOWER CONFIGURATION UPFLOW SUPPLY AIR DISCHARGE LOCATION TOP RETURN AIR LOCATION BOTTOM FILTER TYPE 2" THICK PLEATED UNIT WEIGHT LBS. 675 SUPPLY FAN DATA 4,300 SUPPLY AIR CFM EXTERNAL STATIC PRESSURE 0.2 IN. WG HP - QTY BLOWER (ECM) 4.2 – 1 COOLING COIL DATA - HYDRONIC TOTAL COOLING CAPACITY MBTUH 87.4 82.2 SENSIBLE COOLING CAPACITY °Fdb - °Fwb AIR ENTERING COOLING COIL 75.0 – 61.0 CHW ENTERING & LEAVING TEMPERATURE °F - °F 44 – 54 WATER FLOW GPM 19.4 PRESSURE DROP FT. 13.1 FACE VELOCITY FPM 490 0 GLYCOL CONCENTRATION RUNOUT PIPE SIZE 1 1/2 CONDENSATE DRAIN SIZE 3/4 2-WAY CONTROL VALVE (TYPE) ELECTRICAL DATA ELECTRICAL CHARACTERISTICS V / PH 460 / 3 AMPS FULL LOAD AMPS 5 MAXIMUM OVERCURRENT PROTECTION AMPS 15 MANUFACTURER LIEBERT PCW029 MODEL NUMBER DETAIL REFERENCE H/M501 www.

PROVIDE ADJUSTABLE HEIGHT FLOOR STAND

PROVIDE FLOW SWITCH TO ACTIVATE WARNING SYSTEM PROVIDE FLOAT SWITCH IN PRIMARY DRAIN PAN 6 PROVIDE UNIT MOUNTED ELECTRICAL DISCONNECT SWITCH

PROVIDE ECM FANS PROVIDE CONDENSATE PUMP

PRE-JFILTER SECTI	DAMPERS FILTER ORIENTATION TYPE OF FILTER	CFM CFM % CFM MBTUH °F °F		6,000 6,000 100 6,000 OA ANGLED 2" THICK PLEATED
PRE-JFILTER SECTI	OUTSIDE AIR MINIMUM SUPPLY FAN SPEED SETTING MINIMUM OUTSIDE AIR FLOW SETTING ION DAMPERS FILTER ORIENTATION TYPE OF FILTER A - HYDRONIC HEATING CAPACITY AIR ENTERING HEATING COIL HHW ENTERING & LEAVING TEMPERATURE WATER FLOW	CFM % CFM MBTUH °F °F		6,000 100 6,000 OA ANGLED 2" THICK PLEATED
PRE-JFILTER SECTION	MINIMUM SUPPLY FAN SPEED SETTING MINIMUM OUTSIDE AIR FLOW SETTING ION DAMPERS FILTER ORIENTATION TYPE OF FILTER A - HYDRONIC HEATING CAPACITY AIR ENTERING HEATING COIL AIR LEAVING HEATING COIL HHW ENTERING & LEAVING TEMPERATURE WATER FLOW	% CFM MBTUH °F °F		100 6,000 OA ANGLED 2" THICK PLEATED
PRE-JFILTER SECTI	MINIMUM OUTSIDE AIR FLOW SETTING ION DAMPERS FILTER ORIENTATION TYPE OF FILTER TA - HYDRONIC HEATING CAPACITY AIR ENTERING HEATING COIL AIR LEAVING HEATING COIL HHW ENTERING & LEAVING TEMPERATURE WATER FLOW	MBTUH °F °F		6,000 OA ANGLED 2" THICK PLEATED
PREHEAT COIL DAT	DAMPERS FILTER ORIENTATION TYPE OF FILTER A - HYDRONIC HEATING CAPACITY AIR ENTERING HEATING COIL AIR LEAVING HEATING COIL HHW ENTERING & LEAVING TEMPERATURE WATER FLOW	MBTUH °F °F		OA ANGLED 2" THICK PLEATED
PREHEAT COIL DAT	DAMPERS FILTER ORIENTATION TYPE OF FILTER TA - HYDRONIC HEATING CAPACITY AIR ENTERING HEATING COIL AIR LEAVING HEATING COIL HHW ENTERING & LEAVING TEMPERATURE WATER FLOW	°F		ANGLED 2" THICK PLEATED
PREHEAT COIL DAT	FILTER ORIENTATION TYPE OF FILTER A - HYDRONIC HEATING CAPACITY AIR ENTERING HEATING COIL AIR LEAVING HEATING COIL HHW ENTERING & LEAVING TEMPERATURE WATER FLOW	°F		ANGLED 2" THICK PLEATED
PREHEAT COIL DAT	TYPE OF FILTER TA - HYDRONIC HEATING CAPACITY AIR ENTERING HEATING COIL AIR LEAVING HEATING COIL HHW ENTERING & LEAVING TEMPERATURE WATER FLOW	°F		2" THICK PLEATED
PREHEAT COIL DAT	A - HYDRONIC HEATING CAPACITY AIR ENTERING HEATING COIL AIR LEAVING HEATING COIL HHW ENTERING & LEAVING TEMPERATURE WATER FLOW	°F		
-	HEATING CAPACITY AIR ENTERING HEATING COIL AIR LEAVING HEATING COIL HHW ENTERING & LEAVING TEMPERATURE WATER FLOW	°F		275.6
	AIR ENTERING HEATING COIL AIR LEAVING HEATING COIL HHW ENTERING & LEAVING TEMPERATURE WATER FLOW	°F	}	275.6
-	AIR LEAVING HEATING COIL HHW ENTERING & LEAVING TEMPERATURE WATER FLOW	°F	}	
	HHW ENTERING & LEAVING TEMPERATURE WATER FLOW		$\overline{}$	37
-	WATER FLOW	°F - °F	े।	55
-		- I	(180 – 160
-	RUNOLIT PIPE SIZE	GPM	(28
	NONOUT III E UIZE	IN.	(2
	CONTROL VALVE (TYPE)		(2-WAY
COOLING COIL DAT			4	
	TOTAL COOLING CAPACITY	MBTUH	(449.0
-	SENSIBLE COOLING CAPACITY	MBTUH	\exists	259.0
	AIR ENTERING COOLING COIL	°Fdb - °Fwb	\exists	94.0 – 76.0
-	AIR LEAVING COOLING COIL AIR LEAVING COOLING COIL	°Fdb - °Fwb	\rightarrow	54.0 - 53.5
	CHW ENTERING & LEAVING TEMPERATURE	°F - °F	\dashv	44 – 59
-		· · ·	+	
-	WATER FLOW	GPM SO ET	\rightarrow	60
-	MINIMUM FACE AREA (@ 450 FPM)	SQ. FT.	\rightarrow	13.3
-	GLYCOL CONCENTRATION	%	\rightarrow	0
-	RUNOUT PIPE SIZE	IN.	\downarrow	2 1/2
-	CONDENSATE DRAIN SIZE	IN.	\downarrow	1 1/4
	CONTROL VALVE (TYPE)		\perp	2-WAY
SUPPLY FAN SECTI	ON		}	
	FAN TYPE		$\left\{\right.$	FAN ARRAY
_	DRIVE TYPE		{	DIRECT
	FAN EFFICIENCY GRADE		{	FEG 85
	FAN QUANTITY (INCLUDING REDUNDANCY)	#	{	1
	REDUNDANCY		{	NONE
	EXTERNAL STATIC PRESSURE	IN. WG	(1.5
-	MAXIMUM TOTAL STATIC PRESSURE (INCLUDING DIRTY FILTER)	IN. WG	(3.75
-	DIRTY FILTER ALLOWANCE	IN. WG	(0.7
-	FAN MOTOR HORSEPOWER (PER FAN)	HP - BHP	(7 1/2 – 4.6
	FAN MOTOR HORSEPOWER (UNIT TOTAL @ DESIGN)	HP - BHP	(7 1/2 – 4.6
-	ELECTRICAL CHARACTERISTICS & NO. OF CIRCUITS	V/PH - #		460/3 – 1
	MCA / MOCP (PER CIRCUIT)	AMPS - AMPS	1	13.8 – 20
	VARIABLE FREQUENCY DRIVE			1 PER UNIT
SOUND CRITERIA			}	LEVEL LP-1
SPECIAL FEATURES			لخ	
1	HEAT PIPE		7	YES
-	RUN-AROUND LOOP		}	N/A
-	HUMIDIFIER		+	N/A N/A
-			X	
	ENERGY RECOVERY [WHEEL] [CUBE]		+	N/A
-	DESICCANT WHEEL		\downarrow	N/A
-	CONDENSING UNIT		\downarrow	N/A
-	FACE-AND-BYPASS		\downarrow	N/A
F	RETURN AIR BYPASS		\setminus	N/A
	OUTSIDE AIR BYPASS		_{}	N/A
MANUFACTURER			{	TRANE
NOTES:			7	
·	BRAKE HORSEPOWER INDICATED IS MAXIMUM ALLOWED.	NTIDEL VANTURE		
	INSTALL ALL UNITS LOCATED ABOVE GROUND LEVEL FINISHED FLOOR E AUXILIARY DRAIN PAN. PROVIDE SWITCH INTERLOCKED WITH SUPPLY F			
	MAXIMUM ALLOWABLE DIMENSIONS FOR EQUIPMENT SHOWN IN AIR HAN THIS PAGE. SUBMITTAL DATA SHALL INCLUDE INFORMATION DEMONSTR WITH MAXIMUM ALLOWABLE WIDTH INCLUDING COIL PULL.			
	PROVIDE FANS WITH A MINIMUM DIAMETER OF 16 INCHES AND FAN EFFI INDICATED ABOVE.	CIENCY GRADE AS		
	REFER TO OTHER EQUIPMENT SCHEDULES FOR PERFORMANCE REQUIP	REMENTS OF SPECIAL		
	FEATURES.			
	SUPPLY AIR OPENING SHALL BE OF SUFFICIENT SIZE TO MINIMIZE SYSTI DISCHARGE INTO SUPPLY PLENUM/DUCT.	EM EFFECT FOR		



ARCHITECTURE PLANNING INTERIORS **GRAPHICS**

ELLIOTT MARSHALL INNES P.A. (EMI architects)
251 E. 7TH AVENUE TALLAHASSEE FL 32303
(850) 222 - 7442
www.emiarch.com
UCENSE #s AA C000409 IB C000153

11" x 17" SHEETS ARE PLOTTED AT 1/2 THE SCALE NOTED ON THESE DRAWINGS.



Florida Registry #2485 Jeffrey L. Tyler, P.E. #57093 Jeffrey Lee Tyler, State of Florida,

This item has been digitally signed and sealed by **Jeffrey Lee Tyler**, **P.E.** on the date

Professional Engineer, License No. 57093

Printed copies of this document are not considered signed and sealed, and the signature must be verified on any electronic

Date: 02/10/2025

WCSD EDUCATIONAL ANCILLARY FACILITIES -DISTRICT OFFICE

RECEIVED ALLSTATE CONSTRUCTION 02-13-2025

REV	DATE	DESCRIPTION
1	2/11/2025	ADDENDUM #1
PROJEC	T PHASE	

SHEET TITLE

CONSTRUCTION DOCUMENTS

DRAWN BY 15 JANUARY 2025 JDR PROJECT NO CHECKED BY JLT

SCHEDULES


IGNATION (SAT-)			SAT-1.1.1	SAT-1.1.2	SAT-1.1.3	SAT-1.1.4	SAT-1.1.5	SAT-1.1.6	SAT-1.1.7	SAT-1.1.8	SAT-1.1.9	SAT-1.1.10	SAT-1.1.11	SAT-1.1.12	SAT-1.1.13	SAT-1.1.14	SAT-1.1.15	SAT-1.1.16
VALVE						1											I	
NOMII	MINAL DIAMETER	IN.	8	8	8	8	10	6	8	8	8	6	8	8	8	14	8	8
MAX 1	TOTAL UNIT PRESSURE DROP	IN. WG	0.25	0.25	0.25	0.25	0.40		0.25	0.25	0.25	0.25	0.25	0.25	0.25	0.25	0.25	0.25
LOW RATES		,		1)		•			,		1			1				
MAXIN	XIMUM COOLING	CFM	660	700	580	450	1,170	200	770	470	680	340	500	610	440	1,710	640	720
MINIM	MUM COOLING	CFM	200	210	180	150	360	200	240 (150	210	110	150	190	150	600	200	220
MAXIN	KIMUM HEATING	CFM	210	240	210	180	400		280	185	250	140	175	220	300	750	230	250
MINIM	MUM HEATING	CFM	200	210	180	150	360	_	240	150	210	110	150	190	150	600	200	220
NG COIL DATA - HYD	DRONIC	·	·															
HEAT	TING CAPACITY	MBTUH	8.1	9.2	8.1	6.9	15.4		10.8	7.1	9.6	5.4	6.7	8.5	11.6	28.9	8.9	9.6
AIR EI	ENTERING HEATING COIL	°F	55	55	55	55	55		55	55	55	55	55	55	55	55	55	55
AIR LE	LEAVING HEATING COIL	°F	90	90	90	90	90		90	90	90	90	90	90	90	90	90	90
HHW	VENTERING & LEAVING TEMPERATURE	°F - °F	180 – 16	60 180 – 160	180 – 160	180 – 160	180 – 160		180 – 160	180 – 160	180 – 160	180 – 160	180 – 160	180 – 160	180 – 160	180 – 160	180 – 160	180 –
WATE	TER FLOW	GPM	0.8	0.9	0.8	0.7	1.5		1.1	0.7	1	0.5	0.7	0.8	1.2	2.9	0.9	1
RUNC	IOUT PIPE SIZE	IN.	3/4	3/4	3/4	3/4	3/4		3/4	3/4	3/4	3/4	3/4	3/4	3/4	3/4	3/4	3/4
MINIM	MUM#OF ROWS	#	1	1	1	1	1	_	1	1	1	1	1	1	1	1	1	1
CONT	ITROL VALVE (TYPE)		2-WAY	2-WAY	2-WAY	2-WAY	2-WAY		2-WAY	2-WAY	2-WAY	2-WAY	2-WAY	2-WAY	2-WAY	2-WAY	2-WAY	2-WAY
D CRITERIA - (NOTE	E 1)	<u>'</u>		'		•												
INTEG	EGRAL SILENCER		NO	NO	NO	NO	NO	NO	NO	NO	NO	NO	NO	NO	NO	NO	NO	NO
MAX [DISCHARGE SOUND RATING	NC	30	30	30	30	30	30	30	30	30	30	30	30	30	20	30	30
MAX F	(RADIATED SOUND RATING	NC	25	25	25	25	30	25	25	25	25	25	25	25	25	30	25	25

SIGNATION (SAT-)		SAT-1.2.1	SAT-1.2.2	SAT-1.2.3	SAT-1.2.4	SAT-1.2.5	SAT-1.2.6	SAT-1.2.7	SAT-1.2.8	SAT-1.2.9	SAT-1.2.10	SAT-1.2.11	SAT-1.2.12	SAT-1.2.13	SAT-1.2.14	SAT-1.2.15
VALVE			I													
NOMINAL DIAMETER	IN.	6	8	8	8	14	8	10	10	6	8	10	8	6	8	8
MAX TOTAL UNIT PRESSURE DROP	IN. WG	0.25	0.25	0.25	0.25	0.25	0.25	0.40	0.40	0.25	0.25	0.40	0.25	0.25	0.25	0.25
FLOW RATES											Am					•
MAXIMUM COOLING	CFM	390	690	500	530	1,880	450	830	980	280	530	850	520	350	590	600
MINIMUM COOLING	CFM	120	210	150	160	600	150	250	300	90	160	260	160	110	180	180
MAXIMUM HEATING	CFM	150	230	180	190	660	180	320	350	110	230	325	200	110	220	210
MINIMUM HEATING	CFM	120	210	150	160	600	150	250	300	90	160	260	160	110	180	180
TING COIL DATA - HYDRONIC	,	,			1			1	1			1	1		1	1
HEATING CAPACITY	MBTUH	5.8	8.9	6.9	7.3	25.4	6.9	12.3	13.5	4.2	8.9	12.5	7.7	4.2	8.5	8.1
AIR ENTERING HEATING COIL	°F	55	55	55	55	55	55	55	55	55	55	55	55	55	55	55
AIR LEAVING HEATING COIL	°F	90	90	90	90	90	90	90	90	90	90	90	90	90	90	90
HHW ENTERING & LEAVING TEMPERATURE	°F - °F	180 – 160	180 – 160	180 – 160	180 – 160	180 – 160	180 – 160	180 – 160	180 – 160	180 – 160	180 – 160	180 – 160	180 – 160	180 – 160	180 – 160	180 – 16
WATER FLOW	GPM	0.6	0.9	0.7	0.7	2.5	0.7	1.2	1.3	0.5	0.9	1.3	0.8	0.5	0.8	0.8
RUNOUT PIPE SIZE	IN.	3/4	3/4	3/4	3/4	3/4	3/4	3/4	3/4	3/4	3/4	3/4	3/4	3/4	3/4	3/4
MINIMUM # OF ROWS	#	1	1	1	1	1	1	1	1	1	1	1	1	1	1	1
CONTROL VALVE (TYPE)		2-WAY	2-WAY	2-WAY	2-WAY	2-WAY	2-WAY									
JND CRITERIA - (NOTE 1)																•
INTEGRAL SILENCER		NO	NO	NO	NO	NO	NO									
MAX DISCHARGE SOUND RATING	NC	30	30	30	30	20	30	30	30	30	30	30	30	30	30	30
MAX RADIATED SOUND RATING	NC	25	25	25	25	30	25	30	30	25	25	30	25	25	25	25



ELLIOTT MARSHALL INNES P.A. (EMI architects)
251 E. 7TH AVENUE TALLAHASSEE FL 32303
(850) 222 - 7442
www.emiarch.com
ucense #s Aa C000409 | IB C000153

NOTE: 11" x 17" SHEETS ARE PLOTTED AT 1/2 THE SCALE NOTED ON THESE DRAWINGS.

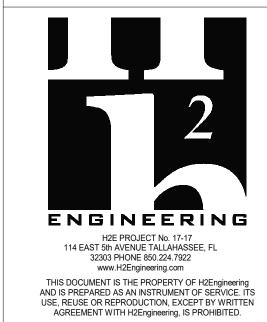

Florida Registry #2485 Jeffrey L. Tyler, P.E. #57093

Jeffrey Lee Tyler, State of Florida, Professional Engineer, License No. **57093** This item has been digitally signed and sealed by **Jeffrey Lee Tyler**, **P.E.** on the date

Printed copies of this document are not considered signed and sealed, and the signature must be verified on any electronic

Date: 02/10/2025

WCSD EDUCATIONAL **ANCILLARY FACILITIES -**DISTRICT OFFICE

RECEIVED
ALLSTATE CONSTRUCTION
02-13-2025

REV	DATE	DESCRIPT	ION
1	2/11/2025	ADDENDU	M #1
PROJEC	T PHASE		
CONCT		OCUMENT.	-
CONST	RUCTION D	OCUMENT	5
DATE			DRAWN BY
15 IANII	IADV 2025		IDD

15 JANUARY 2025 JDR CHECKED BY PROJECT NO JLT SHEET TITLE

SCHEDULES

GNATION (SAT-)		SAT-2.1.1	SAT-2.1.2	SAT-2.1.3	SAT-2.1.4	SAT-2.1.5	SAT-2.1.6	SAT-2.1.7	SAT-2.1.8	SAT-2.1.9	SAT-2.1.10	SAT-2.1.11	SAT-2.1.12	SAT-2.1.13	SAT-2.1.14	SAT-2.1.15	SAT-2.1.16	SAT-2.1.17	SAT-2.1.
/ALVE					1			1											
NOMINAL DIAMETER	IN.	8	10	10	8	10	6	10	8	10	8	8	10	10	8	10	10	8	6
MAX TOTAL UNIT PRESSURE DROP	IN. WG	0.25	0.40	0.40	0.25	0.40	0.25	0.40	0.25	0.40	0.25	0.25	0.40	0.40	0.25	0.40	0.40	0.25	0.15
FLOW RATES	<u>'</u>	,		,	1			1	'						1		•		1
MAXIMUM COOLING	CFM	480	1,300	1,080	420	1,120	400	840	670	840	450	480	1,030	1,080	450	850	1,050	660	300
MINIMUM COOLING	CFM	150	390	330	150	340	120	260	210	240	150	150	310	330	150	260	320	200	90
MAXIMUM HEATING	CFM	175	420	425	175	380	160	300	230	330	180	180	355	420	180	310	380	250	}
MINIMUM HEATING	CFM	150	390	330	150	340	120	260	210	240	150	150	310	330	150	260	320	200	}
FING COIL DATA - HYDRONIC									·								•	·····	
HEATING CAPACITY	MBTUH	6.7	16.2	16.4	6.7	14.6	6.2	11.6	8.9	12.7	6.9	6.9	13.7	16.2	6.9	11.9	14.6	9.6	
AIR ENTERING HEATING COIL	°F	55	55	55	55	55	55	55	55	55	55	55	55	55	55	55	55	55	
AIR LEAVING HEATING COIL	°F	90	90	90	90	90	90	90	90	90	90	90	90	90	90	90	90	90	
HHW ENTERING & LEAVING TEMPERATURE	°F - °F	180 – 160	180 – 160	180 – 160	180 – 160	180 – 160	180 – 160	180 – 160	180 – 160	180 – 160	180 – 160	180 – 160	180 – 160	180 – 160	180 – 160	180 – 160	180 – 160	180 – 160	
WATER FLOW	GPM	0.7	1.6	1.6	0.7	1.5	0.6	1.2	0.9	1.3	0.7	0.7	1.4	1.6	0.7	1.2	1.5	1	
RUNOUT PIPE SIZE	IN.	3/4	3/4	3/4	3/4	3/4	3/4	3/4	3/4	3/4	3/4	3/4	3/4	3/4	3/4	3/4	3/4	3/4	
MINIMUM # OF ROWS	#	1	1	1	1	1	1	1	1	1	1	1	1	1	1	1	1	1	
CONTROL VALVE (TYPE)		2-WAY	2-WAY	2-WAY	2-WAY	2-WAY	2-WAY	2-WAY	2-WAY										
ND CRITERIA - (NOTE 1)		•							·										
INTEGRAL SILENCER		NO	NO	NO	NO	NO	NO	NO	NO	NO									
MAX DISCHARGE SOUND RATING	NC	30	30	30	30	30	30	30	30	30	30	30	30	30	30	30	30	30	30
MAX RADIATED SOUND RATING	NC	25	30	30	25	30	25	30	25	30	25	25	30	30	25	30	30	25	25

DESIGNATION			EF-1.1	EF-1.2	SF-1.1	EF-2.1 Ç	EF-2.2
	SERVICE		CLASS 1 OR 2 EXHAUST	CLASS 1 OR 2 EXHAUST	CLASS 1 OR 2 EXHAUST	CLASS 1 OR 2 EXHAUST	CLASS 1 OR 2 EXHAUST
	MOUNTING METHOD		ROOF	ROOF	SUSPENDED	CEILING	ROOF
	FAN TYPE		CENTRIFUGAL	CENTRIFUGAL VPBLAST	CENTRIFUGAL SQUARE IN LINE	CENTRIFUGAL	CENTRIFUGAL UPBLAST
	AIR FLOW	CFM {	1,600	1,600	1,200	120	100
	STATIC PRESSURE	IN. {	0.50	0.50	0.40	0.25	0.25
	AIRSTREAM TEMPERATURE	DEG F	70	70	70	70	70
	FAN SPEED	RPM {	1,725	1,725	1,725	1,100	1,725
	FAN DRIVE	(DIRECT	DIRECT	DIRECT	DIRECT	DIRECT
	MOTOR SPEED	RPM {	1,725	1,725	1,725	1,100	1,725
	MOTOR POWER	HP or W	1/2 HP	1/2 HP	1/4 HP	22 W	1/4 HP
	MOTOR BRAKE HORSEPOWER	BHP	0.44	0.44	0.24	0.01	0.24
	ELECTRONICALLY COMMUTATED MOTOR	(NO	NO	NO	NO	NO
	ELECTRICAL CHARACTERISTICS	V/PH {	120 / 1	120 / 1	277 / 1	120 / 1	277 / 1
	WEIGHT	LBS.	80	80	35	17	35
	NOISE LEVEL (RADIATED)	SONES or LwA	18.1 SONES	18.1 SONES	11.4 SONES	0.4 SONES	7.6 SON
	STANDARD NOTES		1, 2, 3, 4, 7, 9	1, 2, 3, 4, 7, 9	1, 2, 4, 10, 14, 15, 16, 17, 18	1, 2, 4, 11, 20, 21	1,2,4,10,14,15, 16,17,18
	SPECIAL NOTES		19	19	19	20	19
MANUFACTURER			GREENHECK	GREENHECK	GREENHECK	GREENHECK	GREENHECK
MODEL NUMBER			CUE-120-A	CUE-120-A	SQ-100	SP-A125	SQ-100
DETAIL REFERENCE	CE		H/M504	H/M504	G/M504	ζ	G/M504
2 3 4 7 9 10 11 12 13 14 15 16	PROVIDE PRE-WIRED DISCONNECT SWITCH, FACTORY MOUNTED. PROVIDE SOLID STATE SPEED CONTROLLER, FACTORY MOUNTED. PROVIDE BIRD SCREEN. PROVIDE BACKDRAFT DAMPER, GRAVITY OPERATED. PROVIDE PRE-FABRICATED INSULATED ROOF CURB, 12-INCH HIGH WITH DAMP PROVIDE TIE-DOWN EYELETS. PROVIDE SPRING ISOLATORS. PROVIDE RUBBER-IN-SHEAR ISOLATORS. PROVIDE WALL COLLAR. PROVIDE VIBRATION ISOLATION RAILS WITH HOUSED SPRINGS. PROVIDE INSULATED HOUSING. PROVIDE SIDE DISCHARGE ARRANGEMENT (WHERE INDICATED ON PLANS). PROVIDE INLET COMPANION FLANGE (WHERE CONNECTED TO DUCTWORK). PROVIDE OUTLET COMPANION FLANGE (WHERE CONNECTED TO DUCTWORK).		O MATCH ROOF SLOF	PE.			

DESIGNATION	N		LPV-1	
	SERVICE		INTAKE	
	AIRFLOW	CFM (6,000	
	THROAT SIZE	IN. x IN.	48 x 48	
	HEIGHT	IN. (23	
	WEIGHT	LBS. (213	
MANUFACTUR	GREENHECK			
MODEL NUME	EHH-601PD			
DETAIL REFE	RENCE	(J/M504	
NOTES:				
1	PROVIDE PREFABRICATED ROOF CURB WITH WELDED CAP CORN	IERS AND DAMPER TRAY.		
2	PROVIDE BACKDRAFT DAMPER (ONLY FOR RELIEF SERVICE)			
3	PROVIDE ALUMINUM BIRD SCREEN.			
4	PROVIDE MIAMI-DADE COMPLIANT.			

DESIGNATION FCU-1.1					2.1	F	CU-2.2	2
AIR FLOW R	ATES							
	TOTAL SUPPLY AIR	CFM	500	500)		500	
COOLING CO	DIL DATA	1						
	TOTAL COOLING CAPACITY	MBTUH	14.9	14.9	9		14.9	
	SENSIBLE COOLING CAPACITY	MBTUH	12.0	12.0)		12.0	
	AIR ENTERING COOLING COIL	°Fdb - °Fwb	76.8 – 64.0	76.8 –	64.0	76.8	-	64.
	AIR LEAVING COOLING COIL	°Fdb - °Fwb	54.5 – 54.0	54.5 –	54.0	54.5	-	54.
	CHW ENTERING & LEAVING TEMPERATURE	°F - °F	44.5 – 58.0	44.5 –	58.0	44.5	-	58.
	WATER FLOW	GPM	2.2	2.2			2.2	
	GLYCOL CONCENTRATION	%	0	0			0	
	RUNOUT PIPE SIZE	IN.	3/4	3/4	ļ	3/4		
	CONDENSATE DRAIN SIZE IN		3/4	3/4		3/4		
	CONTROL VALVE (TYPE)		3-WAY	3-WAY 3-WAY		3-WAY		
HEATING CC	DIL DATA - HYDRONIC							
	HEATING CAPACITY	MBTUH		13.8	3			
	AIR ENTERING HEATING COIL	°F		60				
	AIR LEAVING HEATING COIL	°F		85				
	HHW ENTERING & LEAVING TEMPERATURE	°F - °F		180.0 –	160.0			
	WATER FLOW	GPM		1.4				
	RUNOUT PIPE SIZE	IN.		3/4	ļ			
	CONTROL VALVE (TYPE)			3-W/	ΥY			
SUPPLY FAN	N DATA							
	FAN TYPE		TANGENTAL	TANGE	NTAL	TAI	NGENT	AL
	DRIVE TYPE		DIRECT	DIRE	СТ		DIRECT	
	FAN MOTOR HORSEPOWER	HP	1/4	1/4	ļ		1/4	
	ELECTRICAL CHARACTERISTICS	V / PH	208 / 1	208	1		208 / 1	
UNIT DATA								
	ORIENTATION		HORIZONTAL	HORIZO	NTAL	НОЕ	RIZONT	ΓAL
	WEIGHT	LBS	62	62			62	
	FILTER		1" THICK PLEATED	1" THICK P	LEATED	1" THI	CK PLE	:ATE
MANUFACTURER			ENVIRO-TEC ENVIRO-TEC			ENVIRO-TEC		

PROVIDE WALL MOUNTED THERMOSTAT. UNIT TO BE CONTROLLED ON/OFF BASED ON ROOM TEMPERATURE (SET POINT 75 DEG ADJ.)

INSTALL ALL UNITS LOCATED ABOVE GROUND LEVEL FINISHED FLOOR ENTIRELY WITHIN AN AUXILIARY DRAIN PAN. PROVIDE SWITCH INTERLOCKED WITH SUPPLY FAN IN DRAIN PAN.

UNIT FCU-2.1 SHALL BE MOUNTED ABOVE CEILING WITH CEILING ACCESS PANEL, BOTTOM RETURN AND TELESCOPING RETURN CONNECTION.

4 UNIT FCU-1.1 AND FCU-2.2 SHALL BE HORIZONTALLY MOUNTED WITH A REAR RETURN.

ARCHITECTURE PLANNING INTERIORS GRAPHICS

ELLIOTT MARSHALL INNES P.A. (EMI architects)
251 E. 7TH AVENUE TALLAHASSEE FL 32303
(850) 222 - 7442
www.emiarch.com
UCENSE #s AA C000409 IB C000153

<u>NOTE:</u> 11" x 17" SHEETS ARE PLOTTED AT 1/2 THE SCALE NOTED ON THESE DRAWINGS.



Jeffrey L. Tyler, P.E. #57093 **Jeffrey Lee Tyler**, State of Florida, Professional Engineer, License No. **57093**

This item has been digitally signed and sealed by **Jeffrey Lee Tyler**, **P.E.** on the date

Printed copies of this document are not considered signed and sealed, and the signature must be verified on any electronic

Date: 02/10/2025

WCSD EDUCATIONAL ANCILLARY FACILITIES -DISTRICT OFFICE

RECEIVED ALLSTATE CONSTRUCTION 02-13-2025


REV	DATE	DESCRIPTION
1	2/11/2025	ADDENDUM #1
PROJEC	T PHASE	


CONSTRUCTION DOCUMENTS

SHEET TITLE


DRAWN BY 15 JANUARY 2025 JDR PROJECT NO CHECKED BY JLT


SCHEDULES

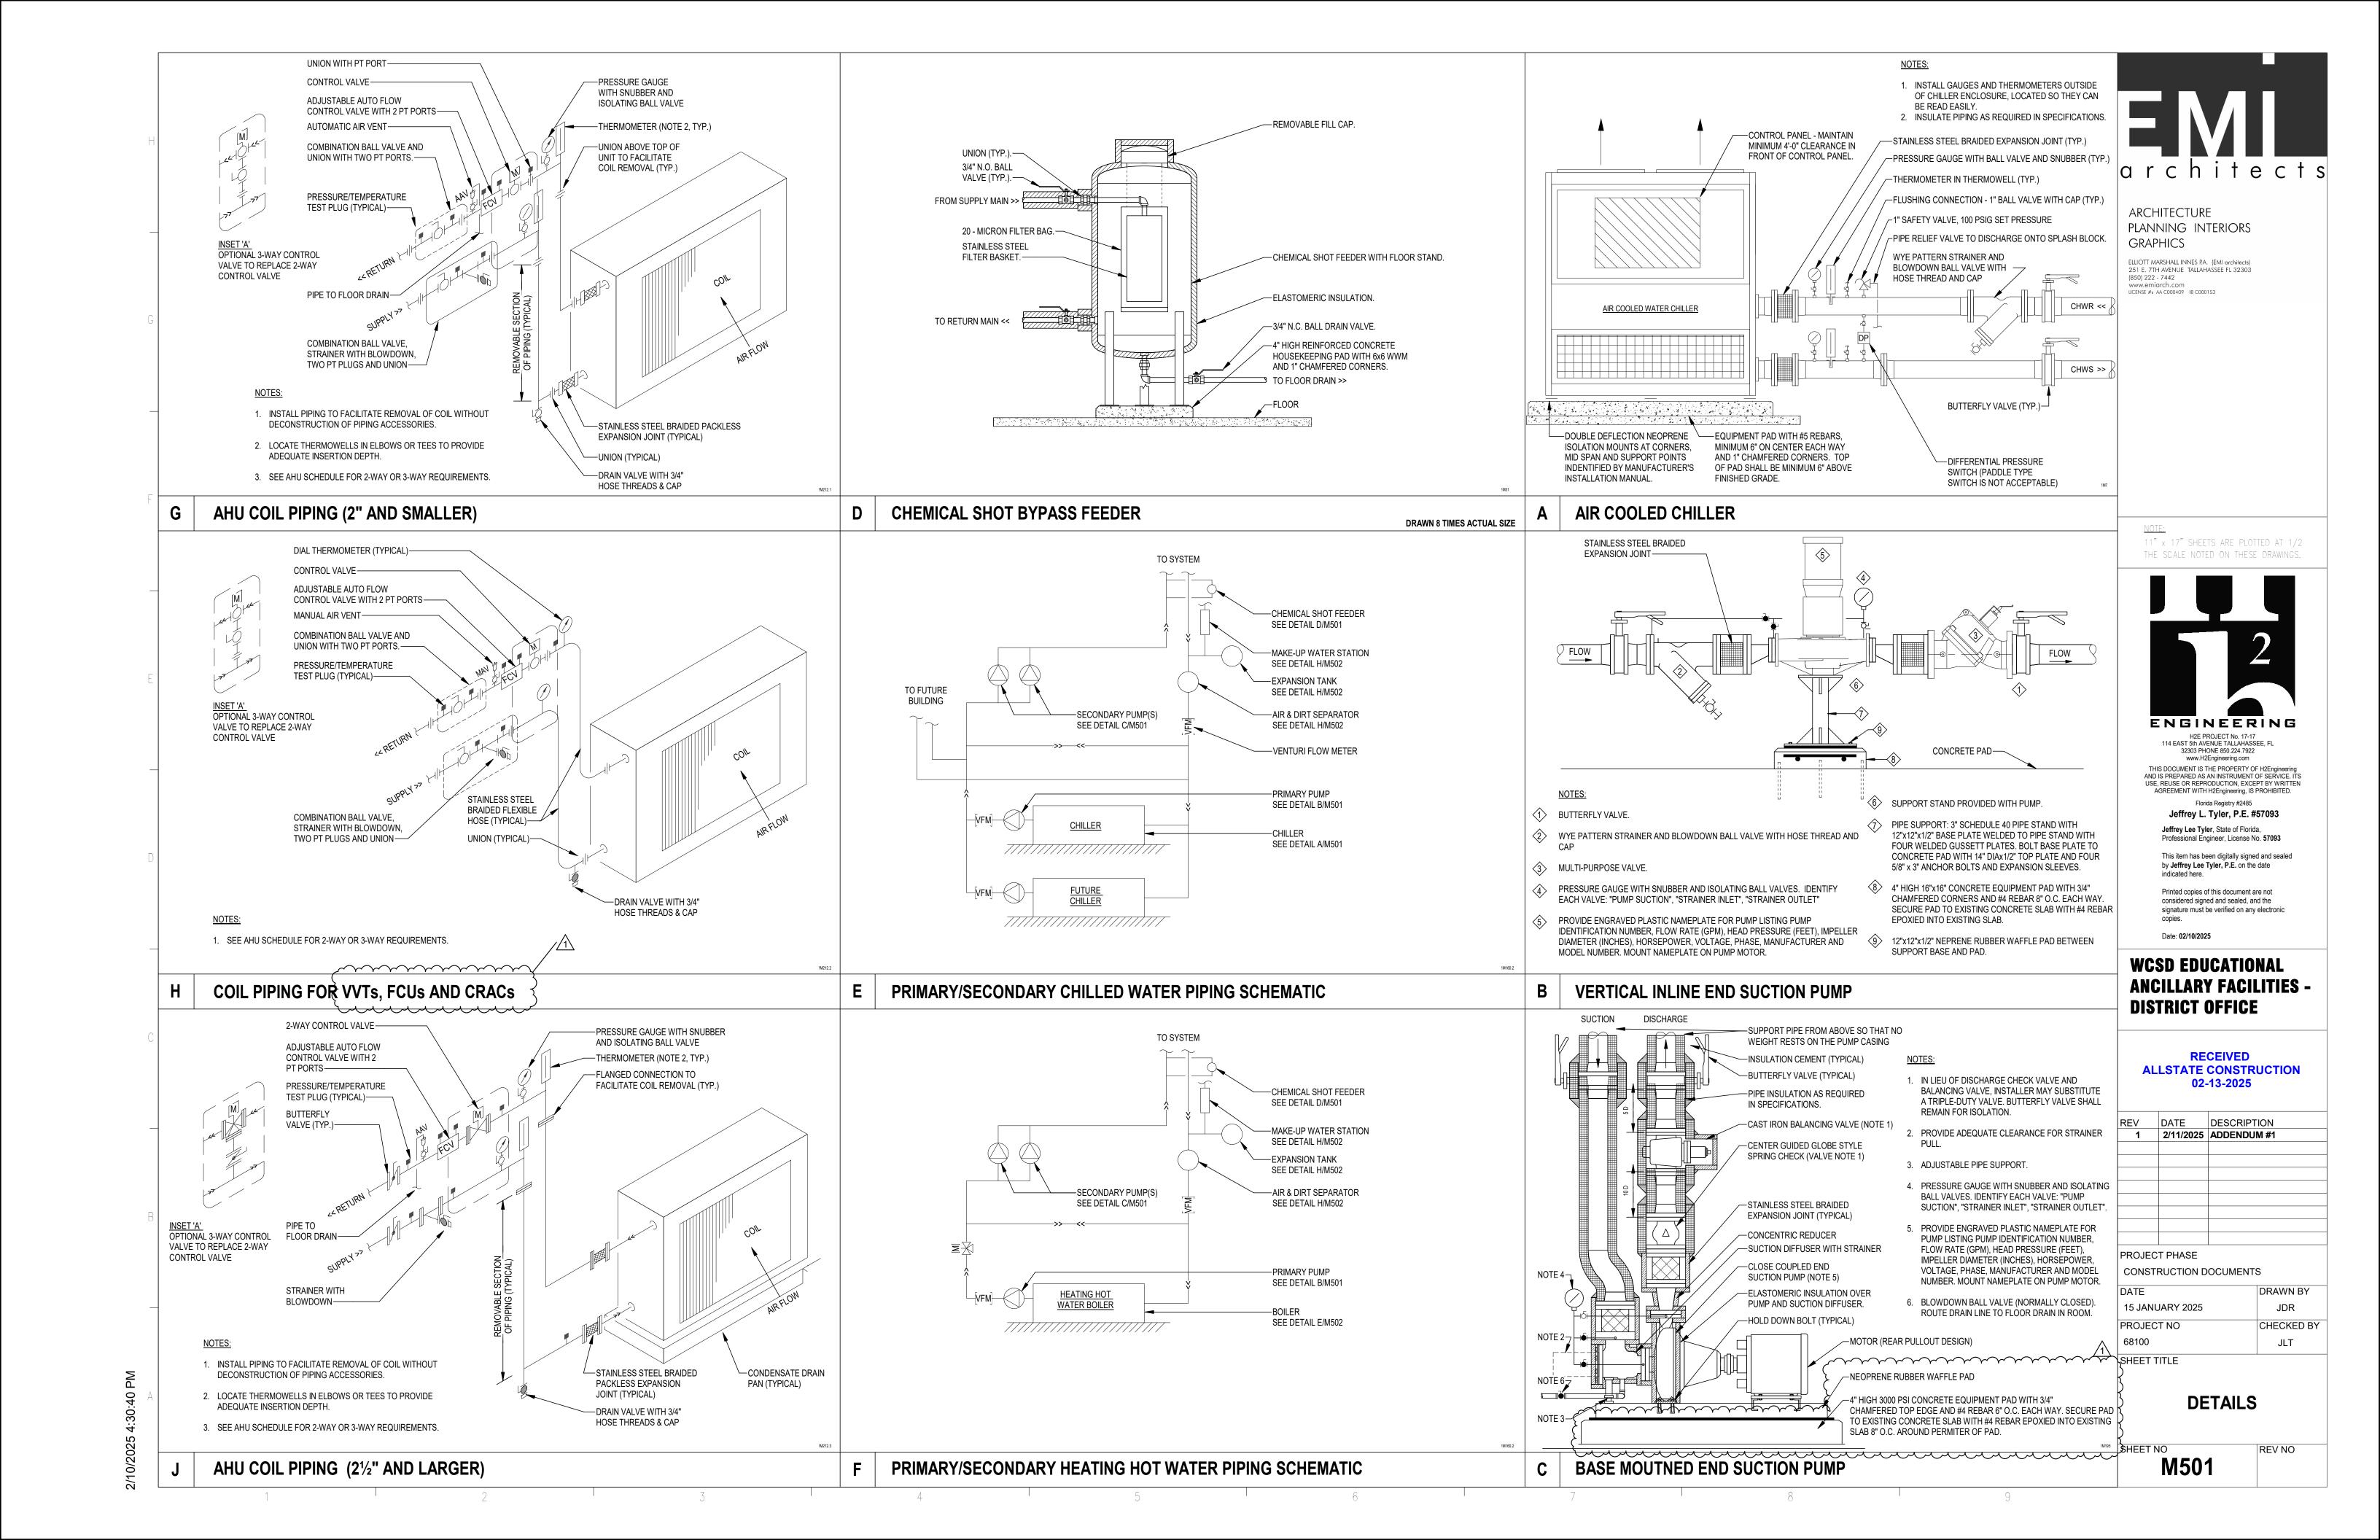

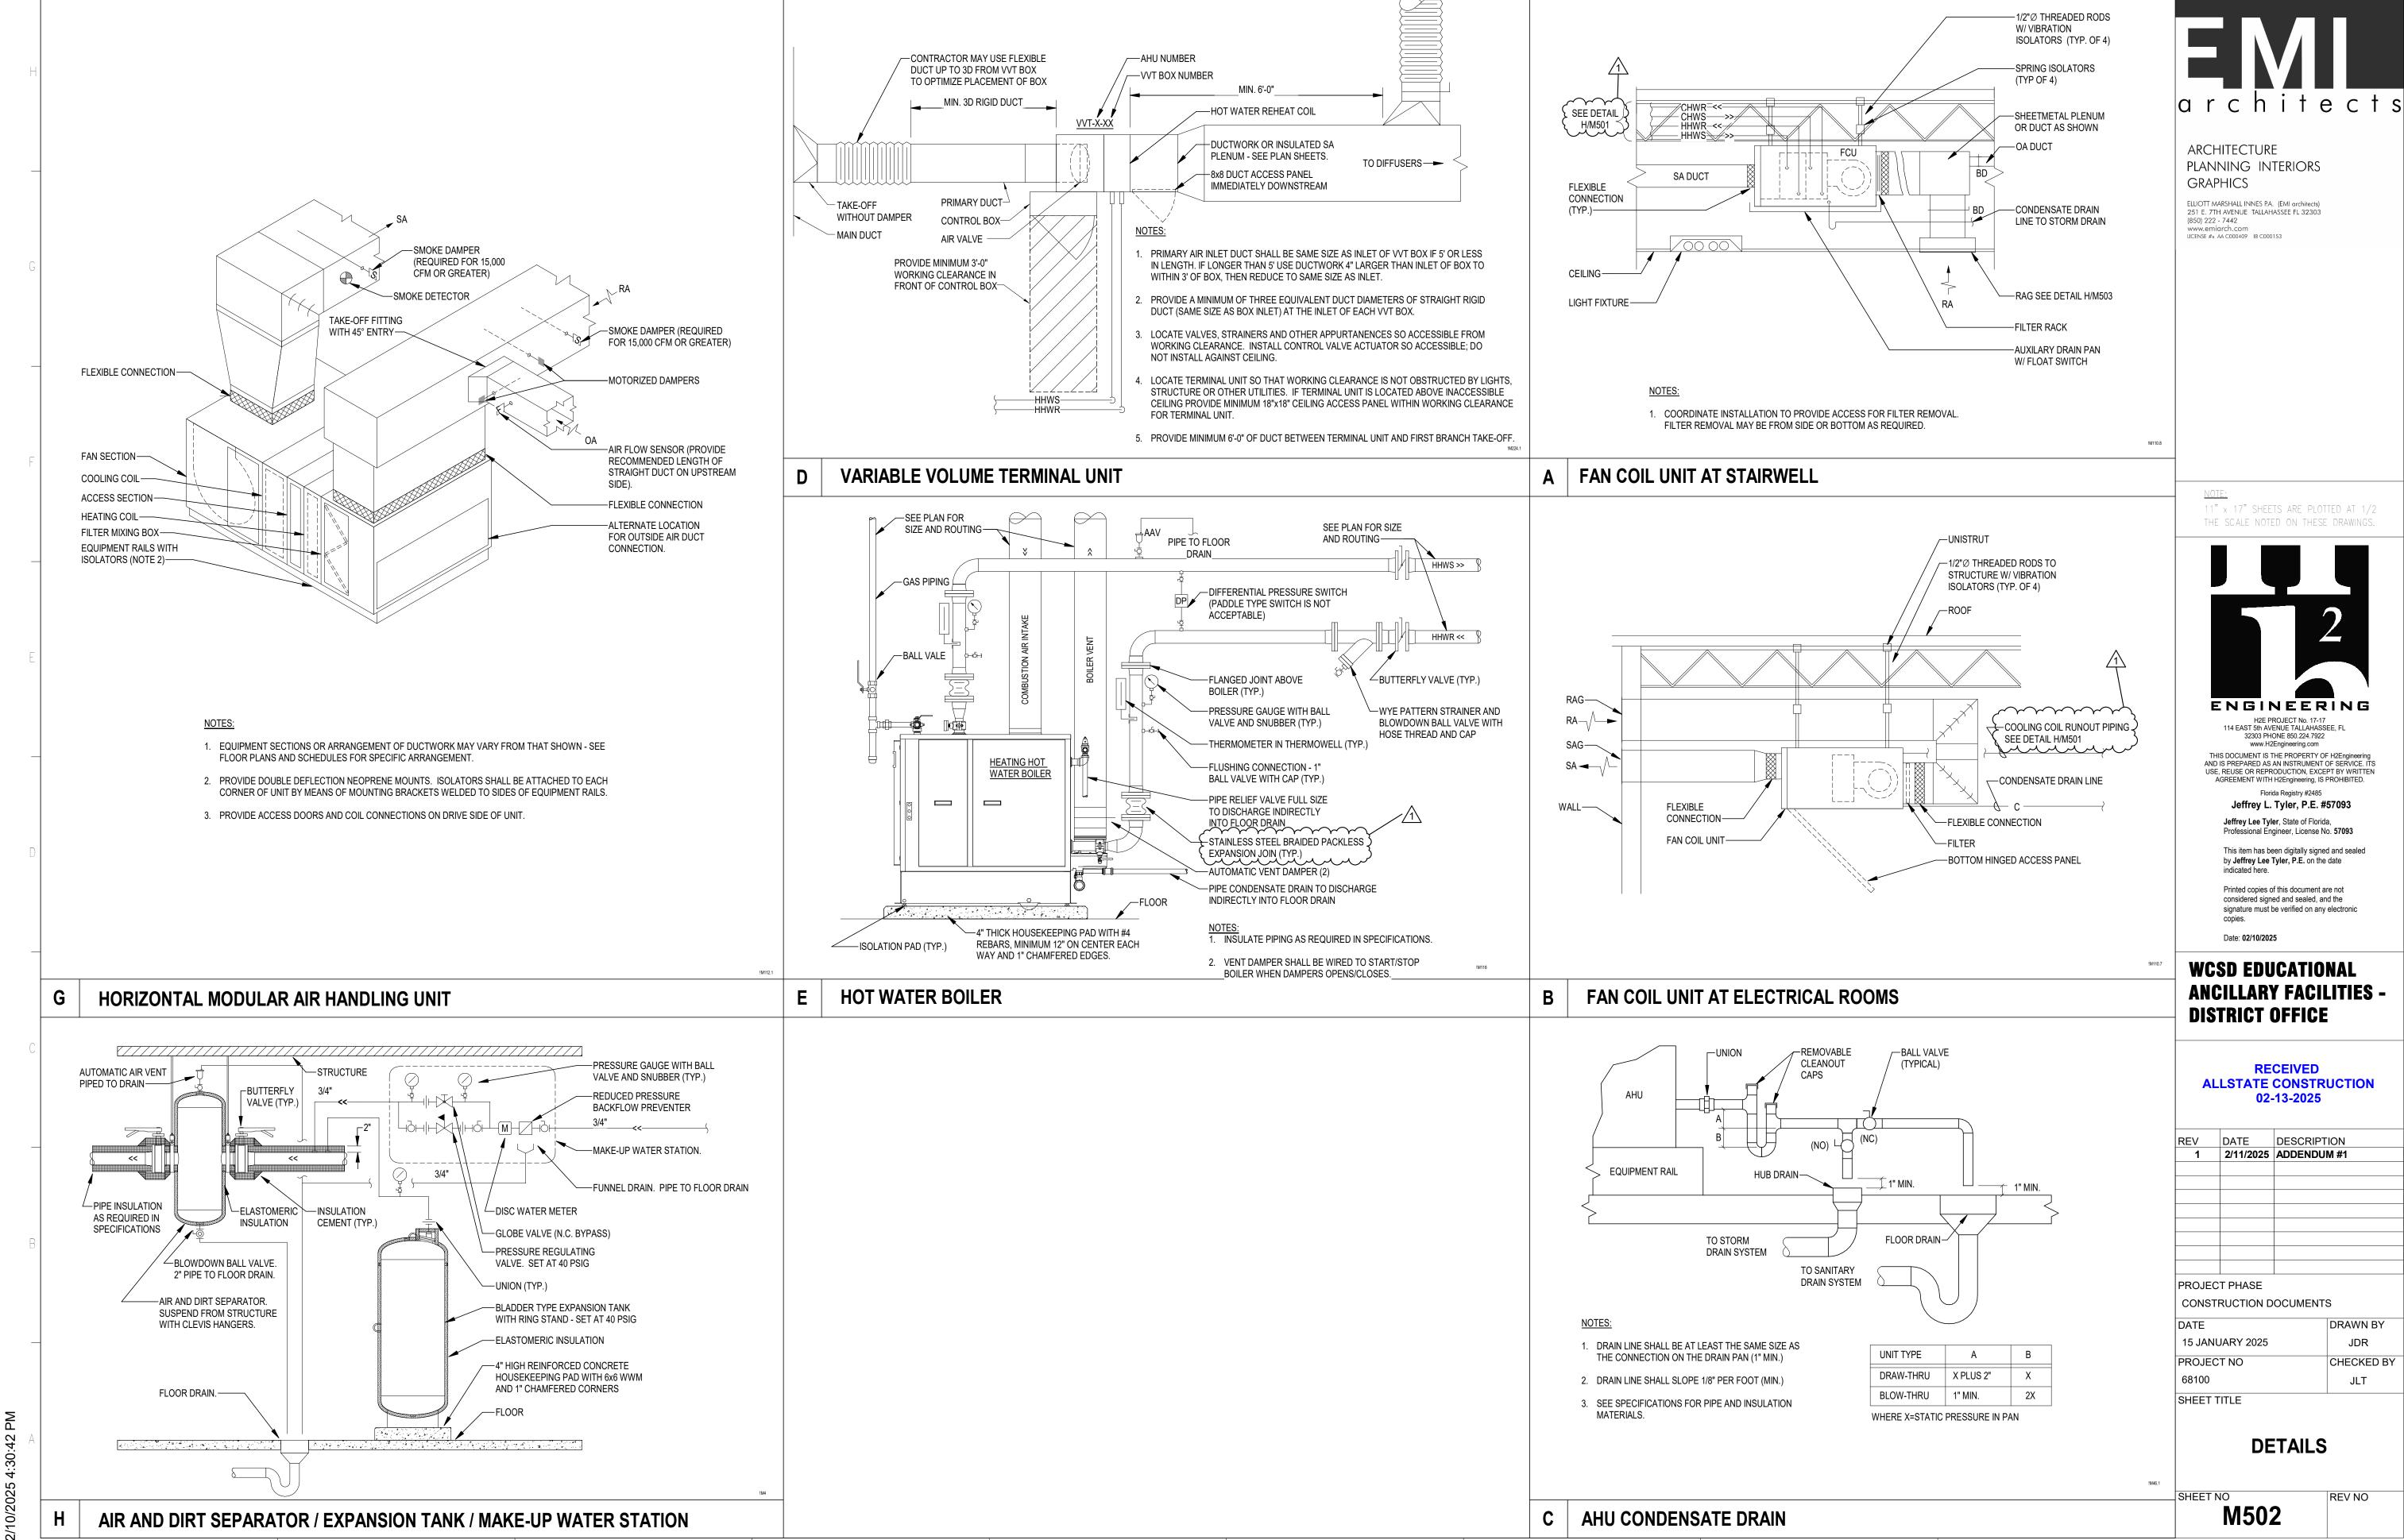

7000,070

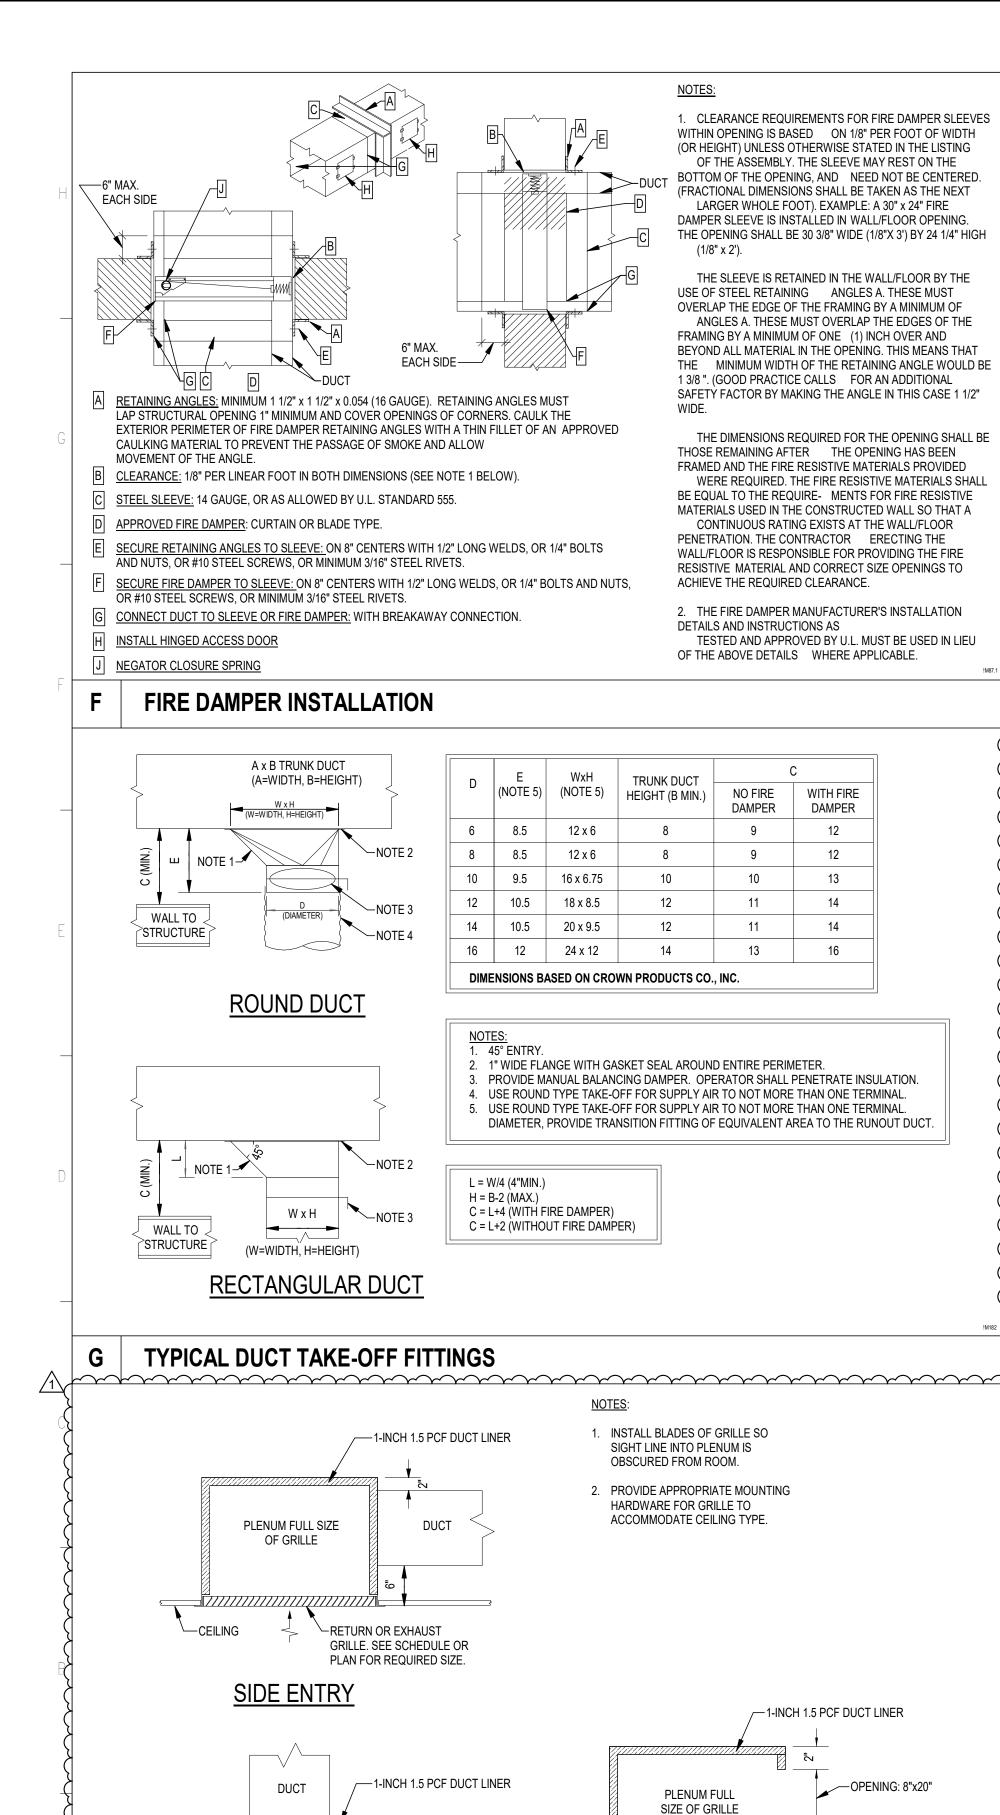

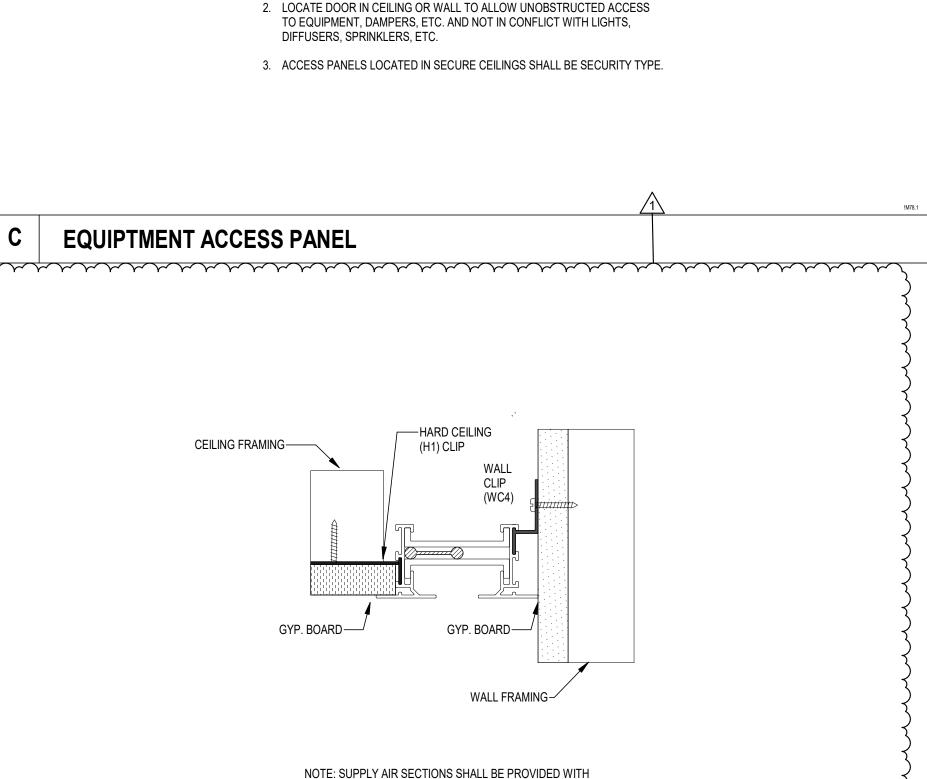

WALL OR CEILING OPENING

-14 GA DOOR. PAINT TO MATCH

-CONTINUOUS CONCEALED HINGE

ACCESS DOOR SHALL BE NOMINAL 24"x24" UNLESS NOTED OTHERWISE.

SURROUNDING SURFACE

1/4 TURN SLOTTED

SCREWDRIVED LATCH-

-14 GA FRAME


METAL STUD —

—ATTACH FRAME TO STUDS

WITH SHEET METAL SCREWS

GALVANIZED STEEL DRYWALL

TAPING BEAD FLANGE

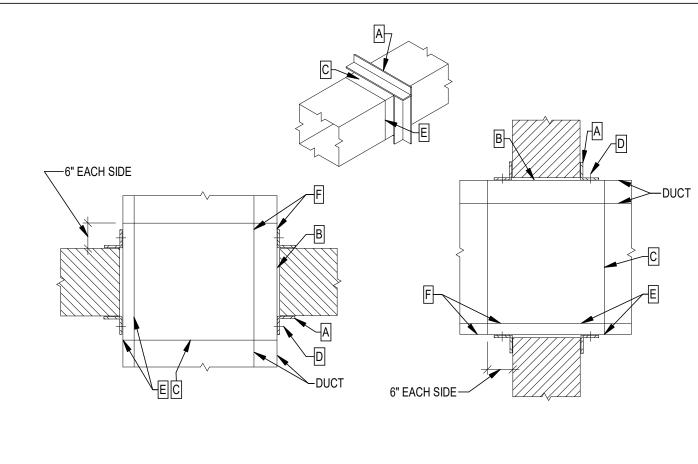

RETAINING ANGLES: MINIMUM 1 1/2" x 1 1/2" x 0.060 (16 GAUGE). RETAINING ANGLES MUST LAP STRUCTURAL OPENING 1" MINIMUM AND COVER OPENINGS OF CORNERS. CAULK THE EXTERIOR PERIMETER OF FIRE DAMPER RETAINING ANGLES WITH A THIN FILLET OF AN APPROVED CAULKING MATERIAL TO PREVENT THE PASSAGE OF SMOKE AND ALLOW MOVEMENT OF THE ANGLE.

CLEARANCE: 1/8" PER LINEAR FOOT IN BOTH DIMENSIONS <u>STEEL SLEEVE:</u> 16 GAUGE, OR AS ALLOWED BY U.L STANDARD 555

SECURE RETAINING ANGLES TO SLEEVE: ON 8" CENTERS WITH 1/2" LONG WELDS, OR 1/4" BOLTS AND NUTS, OR #10 STEEL SCREWS, OR MINIMUM 3/16" STEEL RIVETS.

CONNECT DUCT TO SLEEVE: WITH BREAKAWAY FILL ANNUAL SPACE: WITH MINERAL WOOL BATTING ON ALL

- CLEARANCE REQUIREMENTS FOR FIRE DAMPER SLEEVES WITHIN OPENING IS BASED ON 1/8" PER FOOT OF WIDTH (OR HEIGHT) UNLESS OTHERWISE STATED IN THE LISTING OF THE ASSEMBLY. THE SLEEVE MAY REST ON THE BOTTOM OF THE OPENING, AND NEED NOT BE CENTERED. (FRACTIONAL DIMENSIONS SHALL BE TAKEN AS THE NEXT LARGER WHOLE FOOT). EXAMPLE: A 30" x 24" FIRE DAMPER SLEEVE IS INSTALLED IN A WALL/FLOOR OPENING. THE OPENING SHALL BE 30 3/8" WIDE (1/8" x 3') BY 24 1/4" HIGH (1/8" x 2').
- THE SLEEVE IS RETAINED IN THE WALL/FLOOR BY THE USE OF STEEL REATINING ANGLES (A). THESE MUST OVERLAP THE EDGES OF THE FRAMING BY A MINIMUM OF ONE (1) INCH AND BEYOND ALL MATERIAL IN THE OPENING.
- THE DIMENSIONS REQUIRED FOR THE OPENING SHALL BE THOSE REMAINING AFTER THE OPENING HAS BEEN FRAMED AND THE FIRE RESISTIVE MATERIALS PROVIDED WHERE REQUIRED. THE FIRE RESISTIVE MATERIALS SHALL BE EQUAL TO THE REQUIREMENTS FOR FIRE RESISTIVE MATERIALS USED IN THE CONSTRUCTED WALL SO THAT A REQUIREMENT 3.6. CONTINUOUS RATING EXISTS AT THE WALL/FLOOR PENETRATION. THE CONTRACTOR ERECTING THE WALL/FLOOR IS RESPONSIBLE FOR PROVIDING THE FIRE RESISTIVE MATERIAL AND CORRECT SIZE OPENINGS TO ACHIEVE THE REQUIRED CLEARANCE.

FLEXIBLE DUCT (SAME AS DIFFUSER NECK SIZE). MIN LENGTH 3'-0" / MAX LENGTH = 5'-0"-

STAINLESS STEEL DRAW BAND

(1/2" MIN. WIDTH). FORM AIRTIGHT

SEAL WITH FABRIC AND MASTIC

BALANCING DAMPER - LOCATE

AT BRANCH TAKE-OFF-

PROVIDE FLEXIBLE DUCT

DEGREE ELBOW (NOTE 5)-

ELBOW SUPPORT TO FORM 90°

SEALANT.-

CODE REFERENCE: FBC 708.14.1: "PENETRATIONS OF THE ELEVATOR LOBBY ENCLOSURE BY DUCTS AND AIR TRANSFER OPENINGS SHALL BE PROTECTED AS REQUIRED FOR CORRIDORS IN ACCORDANCE WITH SECTION 716.5.4.1"

<u>PROJECT COMPLIANCE:</u> FIRE DAMPERS ARE NOT PROVIDED AT PENETRATION OF ELEVATOR LOBBY WALL PER FBC716.5.4 EXCEPTION 1.

OPENINGS THAT PENETRATE FIRE PARTITIONS SHALL BE PROTECTED WITH LISTED FIRE DAMPERS INSTALLED INACCORDANCE WITH THEIR LISTING.

CODE REFERENCE: FBC 716.5.4 FIRE PARTITIONS: DUCTS AND AIR TRANSFER

EXCEPTIONS: IN OCCUPANCIES OTHER THAN GROUP H, FIRE DAMPERS ARE NOT REQUIRED WHERE ANY OF THE FOLLOWING APPLY:

1: "CORRIDOR WALLS IN BUILDINGS EQUIPPED THROUGHOUT WITH AN AUTOMATIC SPRINKLER SYSTEM IN ACCORDANCE WITH SECTION 903.3.1.1 OR 903.3.1.2 AND THE DUCT IS PROTECTED AS A THROUGH PENETRATION IN ACCORDANCE WITH

PROJECT COMPLIANCE: FIRE DAMPERS ARE NOT PROVIDED AT PENETRATION OF CORRIDOR WALL FIRE PARTITIONS.

- 3. THE DUCT SYSTEM IS CONSTRUCTED OF APPROVED MATERIALS IN ACCORDANCE WITH THE FLORIDA BUILDING CODE, MECHANICAL AND THE DUCT PENETRATING THE WALL COMPLIES WITH ALL OF THE FOLLOWING
- 1.1 THE DUCT SHALL NOT EXCEED 100 SQUARE INCHES (O.O6 M²).
- 1.2 THE DUCT SHALL BE CONSTRUCTED OF STEEL A MINIMUM OF 0.0217 INCH (0.55 MM) IN THICKNESS.
- 1.3 THE DUCT SHALL NOT HAVE OPENINGS THAT COMMUNICATE THE CORRIDOR WITH ADJACENT SPACES OR ROOMS.
- 1.4 THE DUCT SHALL BE INSTALLED ABOVE A CEILING. 1.5 THE DUCT SHALL NOT TERMINATE AT A WALL REGISTER IN THE FIRE-
- RESISTANCE-RATED WALL.
- 1.6 A MINIMUM 12-INCH-LONG (305 MM) BY 0.060-INCH-THICK (1.52 MM) STEEL SLEEVE SHALL BE CENTERED IN EACH DUCT OPENING. THE SLEEVE SHALL BE SECURED TO BOTH SIDES OF THE WALL AND ALL FOUR SIDS OF THE SLEEVE WITH MINIMUM 1 1/2-INCH BY 1 1/2-INCH BY 0.060-INCH (38 MM BY 38 MM BY 1.52 MM) STEEL RETAINING ANGLES. THE RETAINING ANGLES SHALL BE SECURED TO THE SLEEVE AND THE WALL WITH NO 10. (M5) SCREWS. THE ANNULAR SPACE BETWEEN THE STEEL SLEEVE AND THE WALL OPENING SHALL BE FILLED WITH MINERAL WOOL BATTLEING ON ALL SIDES

PROJECT COMPLIANCE: AT PENETRATIONS OF FIRE PARTITIONS THAT ARE LESS THAN O SQUARE INCHES; A FIRE SLEEVE SHALL BE PROVIDED PER EXCEPTION

11" x 17" SHEETS ARE PLOTTED AT 1/2

THE SCALE NOTED ON THESE DRAWINGS.

ARCHITECTURE

www.emiarch.com LICENSE #s AA C000409 IB C000153

GRAPHICS

(850) 222 - 7442

PLANNING INTERIORS

ELLIOTT MARSHALL INNES P.A. (EMI architects)

251 E. 7TH AVENUE TALLAHASSEE FL 32303



32303 PHONE 850.224.7922 www.H2Engineering.com THIS DOCUMENT IS THE PROPERTY OF H2Engineering AND IS PREPARED AS AN INSTRUMENT OF SERVICE. ITS USE, REUSE OR REPRODUCTION, EXCEPT BY WRITTEN

AGREEMENT WITH H2Engineering, IS PROHIBITED. Florida Registry #2485 Jeffrey L. Tyler, P.E. #57093

Jeffrey Lee Tyler, State of Florida,

rofessional Engineer, License No. **57093**

This item has been digitally signed and sealed by **Jeffrey Lee Tyler**, **P.E.** on the date

Printed copies of this document are not considered signed and sealed, and the signature must be verified on any electronic

Date: 02/10/2025

WCSD EDUCATIONAL ANCILLARY FACILITIES -DISTRICT OFFICE

RECEIVED ALLSTATE CONSTRUCTION 02-13-2025

DATE DESCRIPTION

2/11/2025 ADDENDUM #1

PROJECT PHASE

CONSTRUCTION DOCUMENTS DATE DRAWN BY 15 JANUARY 2025

PROJECT NO CHECKED BY 68100 JLT SHEET TITLE

JDR

DETAILS

REV NO M503

PENETRATION OF FIRE RATED PARTITION NOT REQUIRING FIRE DAMPER

-PLENUM WITH HEMMED -PLENUM WITH HEMMED EDGE, SUSPENDED EDGE, SUSPENDED FROM STRUCTURE FROM STRUCTURE CONCEALED MOUNTING CONCEALED MOUNTING BRACKET (SUPPLIED BRACKET (SUPPLIED WITH SLOT DIFFUSER) WITH SLOT DIFFUSER) -SCREW (SUPPLIED -SCREW (SUPPLIED WITH SLOT DIFFUSER) WITH SLOT DIFFUSER) -SLOT DIFFUSER -SLOT DIFFUSER -GYP. BOARD CEILING —LAY-IN CEILING TILE FLANGED FRAME, CONCEALED MOUNTING T-BAR LAY-IN STYLE

PLENUM AND ROUND TAKEOFF

CONTINUOUS SUPPLY AND RETURN AIR SLOTS

NOTE: RETURN AIR SLOT SIMILAR WITHOUT PLENUM AND DIRECTIONAL BAFFLES.

-OPENING: 8"x20"

-RETURN OR EXHAUST

PLENUM RETURN GRILLES

GRILLE. SEE SCHEDULE OR

PLAN FOR REQUIRED SIZE.

FLEXIBLE DUCT SHALL NOT HAVE MORE THAN 1/2" SAG PER FOOT.

5. MAINTAIN MINIMUM RADIUS (R) OF 1.5 TIMES THE DUCT DIAMETER.

RETURN OR ECHAUST CEILING GRILLE

-RETURN OR EXHAUST

GRILLE. SEE SCHEDULE OR

PLAN FOR REQUIRED SIZE.

PLENUM FULL SIZE OF GRILLE

TOP ENTRY

SLOT DIFFUSER DETAIL

B | FLEXIBLE DUCT CONNECTION TO SUPPLY DIFFUSER

SECURE FLEXIBLE DUCT INSULATION AND OUTER JACKET WITH DRAW BAND.

SUPPLY DIFFUSER

PROVIDE INSULATION ON BACK OF DIFFUSERS (SEE SPECIFICATIONS). SEAL VAPOR TIGHT WITH FABRIC AND MASTIC.

PULL INNER LINER OF FLEXIBLE DUCT OVER DIFFUSER COLLAR AND SECURE WITH DRAW BAND.

-SECURE FLEXIBLE DUCT SUPPORT

NYLON CABLE TIES ON BOTH ENDS

ELBOW TO FLEXIBLE DUCT WITH

-DRAW BAND WITH CABLE SUPPORT

ATTACHED TO STRUCTURE (NOTE 1)

-STAINLESS STEEL DRAW BAND (1/2" MIN. WIDTH). FORM AIRTIGHT


SEAL WITH FABRIC AND MASTIC

SEALANT. (NOTES 3 & 4)

-INSULATION (NOTE 2)

-CEILING TILE

-CEILING GRID

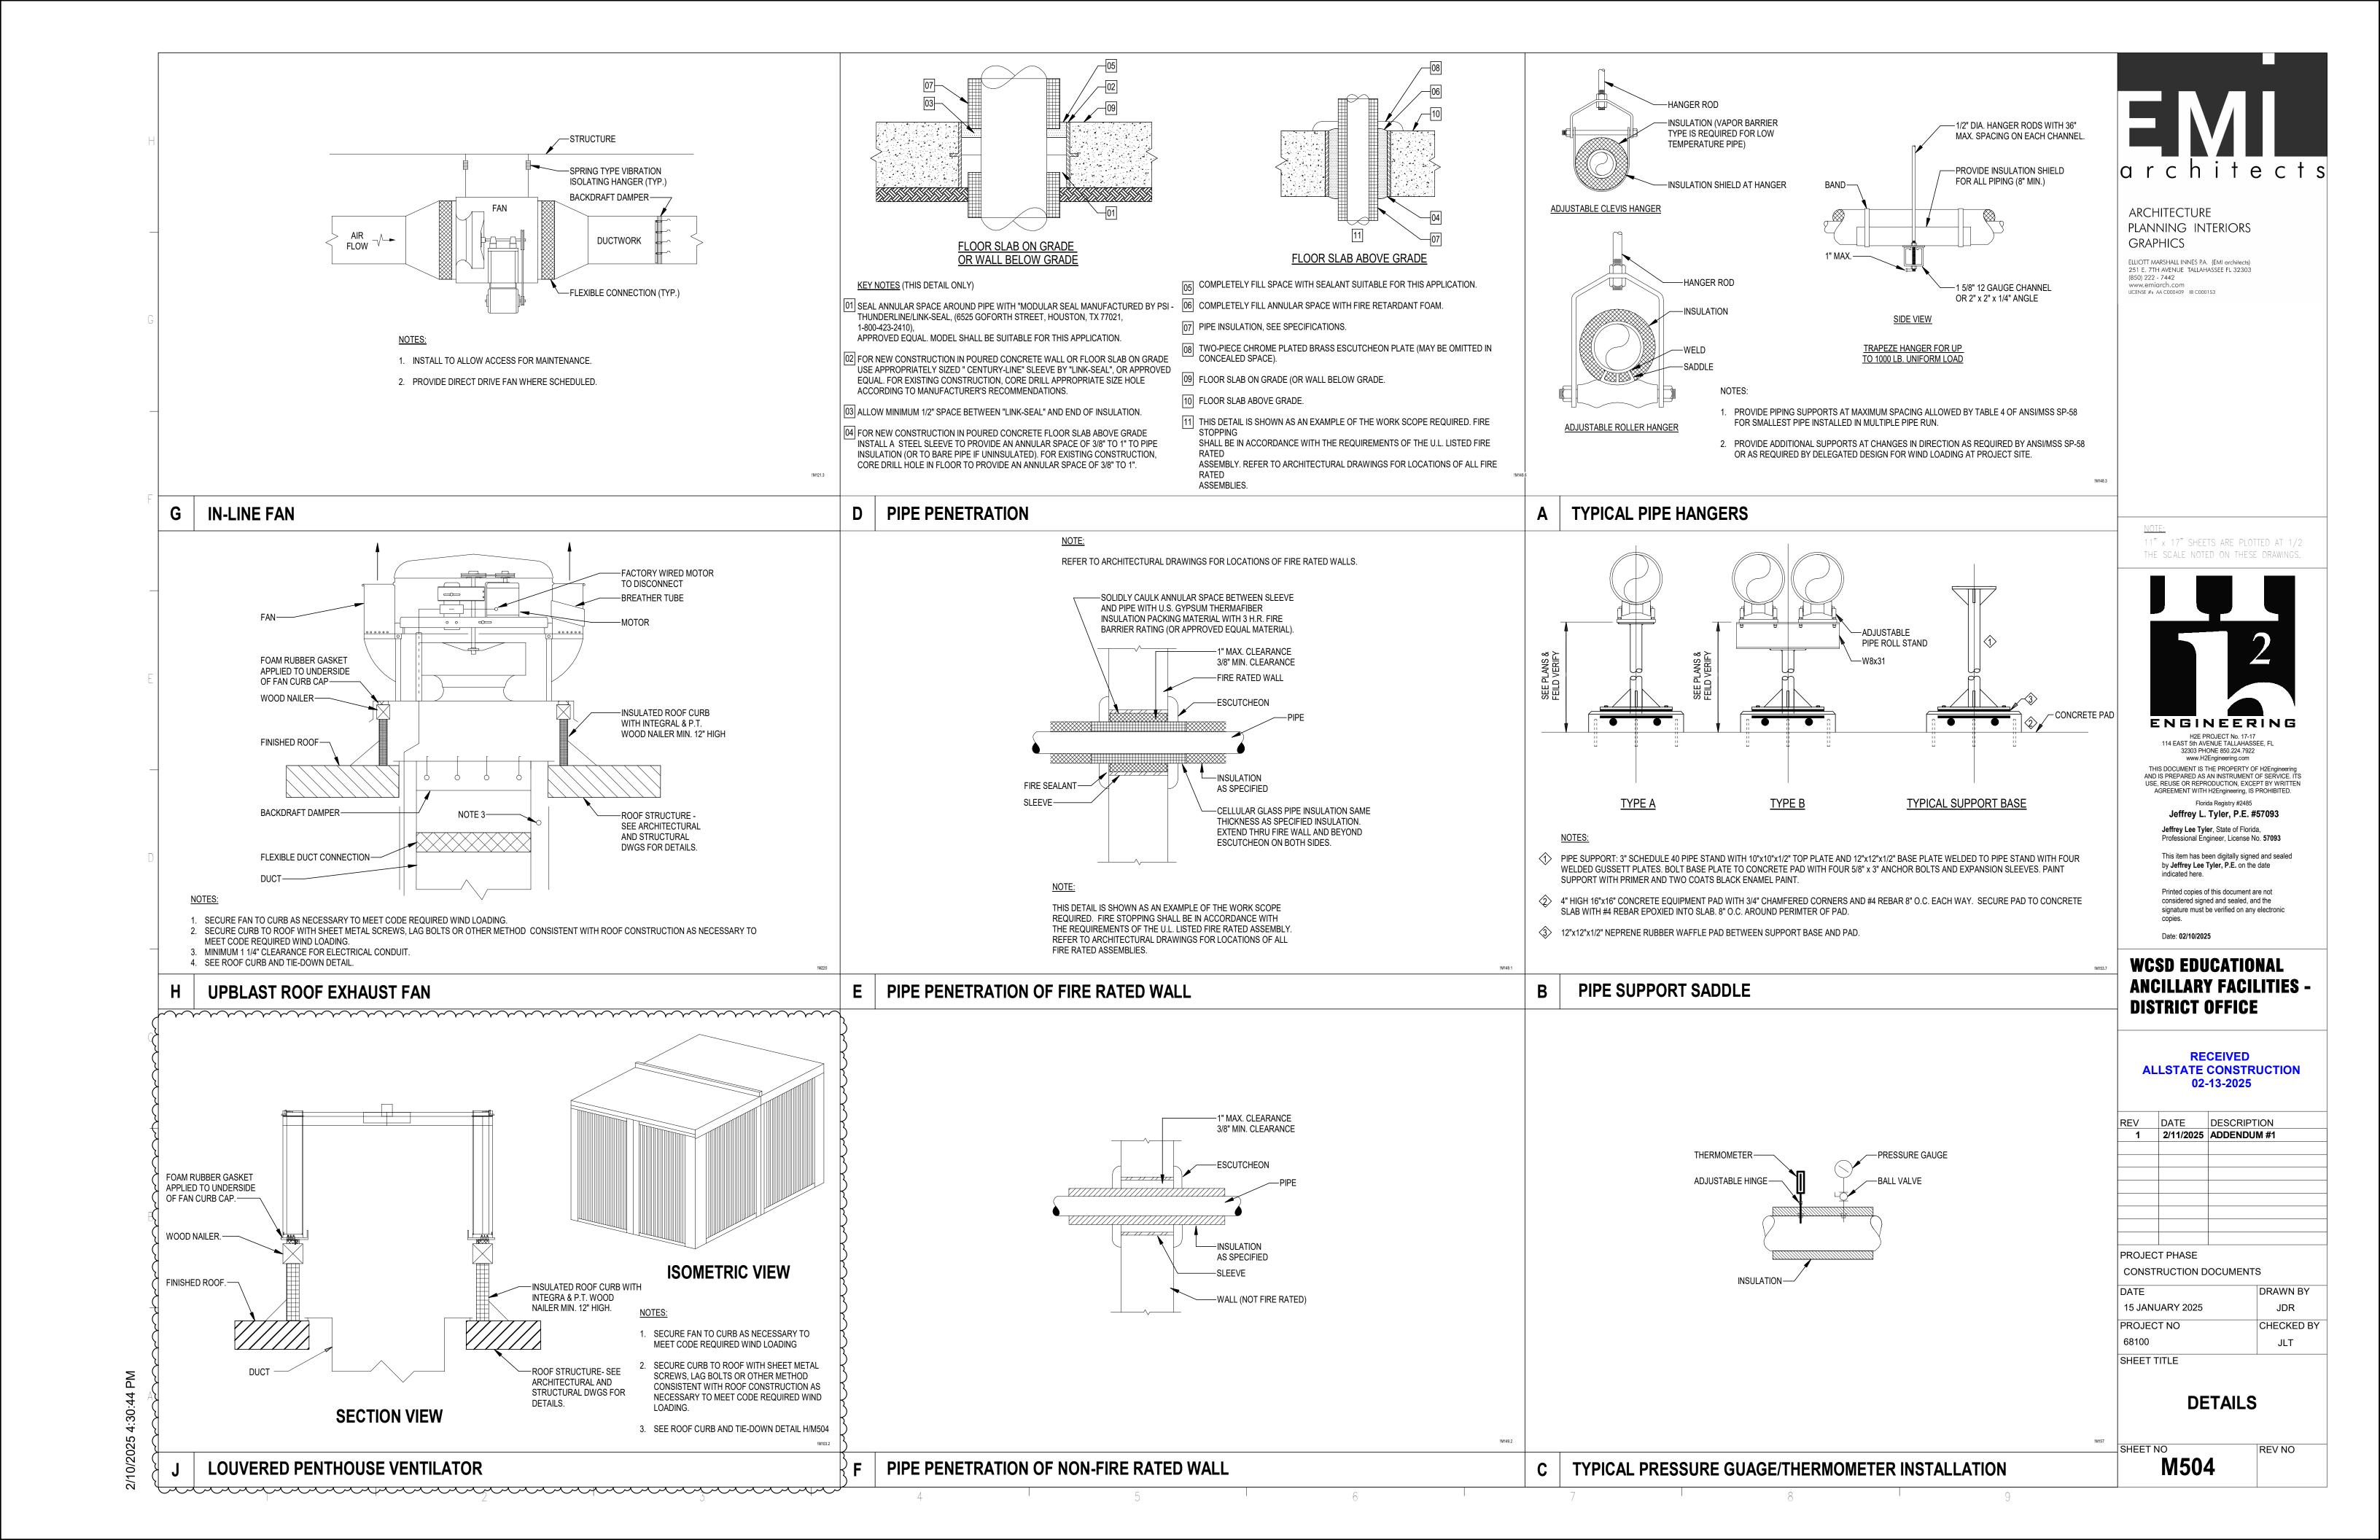

PIPING AND FITTINGS	APPLICABLE CODES	PLUMBING NOTES	GENERAL NOTES
CAP CAP CEBOW TURNED UP ELBOW TURNED DOWN TEC. OUTLET UP TEC. OUTLET UP TEC. OUTLET DOWN NEW PIPE PSAN. SANITARY, SOIL OR WASTE PIPING COLD WATER SUPPLY PIPING HOT WATER RECIRCULATION PIPING PRIMARY RAIN LEADER SRI. SECONDARY RAIN LEADER SSI. SECONDARY RAIN LEADER SD. STORM DRAIN PIPING HB L. HOSE BIBB WH L. WALL HYDRANT W & WATER HAMMER ARRESTER FLOOR SIRK'S SEE DETAIL DIPEGG RD COMBINATION ROOF DRAIN - SEE DETAIL DIPEGG RD COLOR DRAIN -	PERFORM WORK IN ACCORDANCE WITH THE FOLLOWING CODES AND ANY APPLICABLE STATUTES, ORDINANCES, CODES, AND REGULATIONS OF GOVERNMENTAL AUTHORITIES HAVING JURISDICTION. 1. ASHRAE 2. STANDARD 5. SAFETY STANDARD FOR REFRIGERATION SYSTEMS - 2019 2. D. STANDARD 90.1 ENERGY STANDARD FOR BUILDINGS EXCEPT LOW RISE RESIDENTIAL BUILDINGS - 2019 2. ASME 2. ASME A17.1 SAFETY CODE FOR ELEVATORS AND ESCALATORS - 2019 3. OCCUPATIONAL SAFETY AND HEALTH REGULATIONS (OSHA). 4. MATIONAL FIRE CODES 2. A. NFPA 1 UNIFORM FIRE CODE - 2021 (FLORIDA EDITION) 4. NFPA 54 NATIONAL FUEL GAS CODE - 2021 5. NFPA 70 NATIONAL ELECTRICAL CODE - 2020 6. NFPA 70 NATIONAL ELECTRICAL CODE - 2020 6. NFPA 90A STANDARD FOR THE INSTALLATION OF AIR CONDITIONING AND VENTILATION SYSTEMS - 2021 6. NFPA 90B STANDARD FOR THE INSTALLATION OF WARM AIR HEATING AND AIR CONDITIONING SYSTEMS - 2021 7. NFPA 101 LIFE SAFETY CODE - 2021 (FLORIDA EDITION) 5. FLORIDA BUILDING CODE, 2023 BM EDITION 6. BUILDING CODE 7. ENERGY CONSERVATION CODE 8. ENERGY CONSERVATION CODE 9. ENERGY CONSERVATION CODE 9. ENERGY CONSERVATION CODE 9. ENERGY CONSERVATION CODE 9. CHAPTER 810-15 FLORIDA BUILDING COMMISSION HANDICAPPED ACCESSIBILITY STANDARDS 9. CHAPTER 810-15 FLORIDA BUILDING COMMISSION HANDICAPPED ACCESSIBILITY STANDARDS 9. CHAPTER 810-15 FLORIDA BUILDING COMMISSION HANDICAPPED ACCESSIBILITY STANDARDS 9. CHAPTER 89-47 FLORIDA ELEVATOR SAFETY CODE 9. CHAPTER 89-47 FLORIDA ELEVATOR SAFETY CODE 9. CHAPTER 89-47 FLORIDA ELEVATOR SAFETY CODE 9. CHAPTER 89-47 FLORIDA ELEVATOR SAFETY STANDARDS FOR ELEVATORS 9. CHAPTER 89-47 FLORIDA FIRE PREVENTION CODE 1. CHAPTER 89-40 THE FLORIDA FIRE PREVENTION CODE 2. CHAPTER 89-47 FLORIDA FIRE PREVENTION CODE 3. ADA ACCESSIBILITY GUIDELINES FOR BUILDINGS (ADAAG) 3. ESCOLVE, IN WRITING, ANY CODE VOLCATION	PLUMBING NOTES 1. ALL MISCELLANEOUS EQUIPMENT TO BE FURNISHED UNDER OTHER SECTIC SPECIFICATIONS THAT REQUIRE PIPING OR DUCT CONNECTIONS SHALL BE I ROUGH-IN AND FINAL CONNECTIONS MANDE UNDER THESE SECTIONS. 2. PRESSURE TEST ALL WATER PIPING SYSTEMS AT 150% OF NORMAL WORKIN. 3. ALL COPPER PRESSURE PIES HALL BE SOLDERED ENTRIELY WITH LEAD-FF. 4. INSTALLATION OF EQUIPMENT AND PIPING SHALL PROVIDE CONVENIENT AS. 5. ALL FLOOR DRAINS AND FLOOR SINKS SHALL HAVE MINIMUM 3" DRAIN LINES AUTOMATIC TRAP PRIMERS. 6. WATER HAMMER ARRESTERS SHALL BE INSTALLED IN ACCORDANCE WITH IT. 7. ALL HOSE BIBBS. WALL HYDRANTS, SILL COCKS AND/OR FAUCETS WITH HOSE HAVE A VACUUM BREAKER. 8. GRAVITY FLOW SYSTEMS HAVE SPACE PRIORITY FOR SLOPING PIPES, HOW STARTED AT HIGHEST POINT POSSIBLE. 9. ALL WATER PIPING SUBJECT TO REEZING SHALL BE FREEZE PROTECTED. IN UNHEATED SPACES SUCH AS EXTERIOR EQUIPMENT COORDINATE. EDRAINS/SINKS WITH EARD OF GADE WATER PIPING WITH CELLULAR GLASS. 11. DO NOT LOCATE FLOOR DRAINS/SINKS UNDER EQUIPMENT. COORDINATE EDRAINS/SINKS WITH EARD OF GADE WATER PIPING WALL. 12. ALL PLUMBING VENTS SHALL BE 2" MINIMUM, UNLESS NOTED OTHERWISE. 13. PROVIDE ACCESS PAREL AT EACH LOCATION WHERE A VALVE OR OTHERWISE. 14. ACLEANOUT SHALL BE PROVIDED AT THE BASE OF EACH WASTE, SOIL STAKE WHEN THE PIPING HAVE AND A SHALL ACCESS IR RATED INSTALLED IN A FIRE RATED CELING OR WALL. 14. A CLEANOUT SHALL BE PROVIDED AT THE BASE OF EACH WASTE, SOIL STAKE WHETHER SHOWN ON THE DRAWINGS OR NOT. 15. ANY PIPE THAT PASSES UNDER A FOOTING OR THROUGH A FOUNDATION WITH A RELIEVING ARCH, OR A PIPE SLEEVE. SHEEVE SHALL BE BUILT INTO THE SLEEVE SHALD BY THE DRAWN OS TO ARREST AND THE PIPING AS FORCEDURE SPESCRIBED BY AUTURN ON THE PIPING AND PARTS OF EXISTING PIPING THAT HAVE BEE REPAIRED BEFORE USING. 2. USE PURCING AND DISINFECTING PROCEDURES PRESCRIBED BY AUTURN SOIL OF THE PIPING AND PARTS OF EXISTING PIPING THAT HAVE BEE REPAIRED BEFORE DISTON. 2. FILL SYSTEM OR PART THEREOF WITH WALVES AND ALLOW TO STAND POOR THE PIPING AND PARTS OF P	INS OF THE RECEIVED AND SET WITH NO PRESSURE. REE SOLDER COSES FOR MAINTENANCE SE, DEEP SEAL TRAPS AND PDI-WH201. SE CONNECTIONS SHALL EVER SLOPE MUST BE THIS INCLUDES ALL PIPING XERRIOR WALLS, ETC. PER SPECIFICATIONS. CXACCT LOCATION OF PER SPECIFICATIONS. CXACCT LOCATION OF PER SPECIFICATIONS. ALL SHALL BE FIRE CK OR RAIN LEADER, ALL SHALL BE FIRE CK OR RAIN LEADER, ALL SHALL BE FROUDED THE FOUNDATION WALL. THROUGH THE WALL. NATERED, EXTENDED, OR THORITIES HAVING SE DESCRIBED IN EITHER BELOW. THE CONTRACTOR SHALL BE RESTRICTED TO AREAS SPE STORAGE OF CONSTRUCTION NATIONAL DETAILS. SECONSCRIBED IN EITHER BELOW. THE CONTRACTOR SHALL BE RESTRICTED TO AREAS SPE STORAGE OF CONSTRUCTION WHICH AND SCHOLLE PRING TO PERF SPECIALITIONS. CONSTRUCTION VEHICLE ACCESS AND EGRESS LOCATION OF THE CONTRACTOR SHALL BE RESTRICTED TO AREAS SPE STORAGE OF CONSTRUCTION MAINGAGERICENEER ALL CLEANING AND CONSTRUCTION WHICH AND SCHOLLE PRING TO PERF OWNER. ALL SHALL BE FIRE CK OR RAIN LEADER, ALL SHALL BE FIRE CK OR RAIN LEADER, ALL WORK SHALL COMPLY WITH APPLICABLE O. S. H.A. AND EXPERIMENT OF THE WORK, LONG SCHOOL THE WALL. 1. THE CONTRACTOR SHALL PAY FOR ALL INSPECTION PER SYSTEM DEBAND CHARGES AND LICENSE FEES IN COMING CONSTRUCTION VEHICLE ACCESS AND EGRESS LOCATION OF THE CONTRACTOR SHALL PAY FOR ALL INSPECTION PER SYSTEM DEBAND CHARGE AND LICENSE FEES IN COMING CONSTRUCTION VEHICLE ACCESS AND EGRESS LOCATION OF THE CONTRACTOR SHALL BRAINS AND CONTRACTOR SHALL SHALL BE FIRE THE CONTRACTOR SHALL MAINTAIN A CLEAN WORK ENVI CONSTRUCTION AND SECURITY OF ALL DEBRIS AT COMPLETION OF MADE 1. THE CONTRACTOR SHALL MAINTAIN A CLEAN WORK ENVI CONSTRUCTION AND SECURITY OF ALL DEBRIS AT COMPLETION OF MADE 1. THE CONTRACTOR SHALL MAINTAIN A CLEAN WORK ENVI CONSTRUCTION AND SECURITY OF ALL DEBRIS AT COMPLETION OF MADE 1. THE CONTRACTOR SHALL MAINTAIN A CLEAN WORK ENVI CONSTRUCTION AND SECURITY OF ALL DEBRIS AT COMPLETION OF MADE 1. THE CONTRACTOR SHALL MAINTAIN A CLEAN WORK ENVI CONSTRUCTION AND SECURITY OF ALL DEBRIS AT COMPLETANT OR
THERMOMETER GAS REGULATOR M METER (WATER OR GAS) MISCELLANEOUS	TYPE OF PENETRANT F-RATING	SYSTEMS. BASIS OF DESIGN: HILTI, INC. CRETE OR BLOCK WALLS GOF DESIGN UL SYSTEM	AC ABOVE CEILING AD AREA DRAIN AF ABOVE FLOOR AFF ABOVE FINISHED FLOOR AHAP AS HIGH AS POSSIBLE BF BELOW FLOOR BG BELOW GRADE CWS COLD WATER SUPPLY DN DOWN EWC ELECTRIC WATER COOLER
HINGED CEILING ACCESS PANEL - SEE DETAIL G/P501	SIRCULAR BLANK OPENINGS 1 F-A-0006, C-AJ-0055, C-AJ-0090	C-AJ-0055, C-AJ-0090	FD FLOOR DRAIN CP 618 FS-ONE MAX CES- BI HB HOSE BIBB
HINGED CEILING ACCESS PANEL - SEE DETAIL G/P501 MIN. I.E. = MINIMUM INVERT ELEVATION BELOW REFERENCE ELEVATION POINT OF CONNECTION, PLUMBING TO CIVIL SMOKE RATED WALL 1 HOUR FIRE RATED WALL 2 HOUR FIRE RATED WALL	(0000-0999) 2 F-A-0006, C-AJ-0055, C-AJ-0090 METAL PIPES OR CONDUIT (1000-1999) 2 C-AJ-1226, F-A-1028, F-A-1017 C-AJ-1226 NON-METALLIC PIPE OR CONDUIT (I.E. PVC, CPVC, ABS, FRP, ENT) (2000-2999) 2 F-A 2053, F-A 2025, C-AJ-2109, C-AJ-2098, C-AJ-271, C-AJ-2167, C-BJ-2021, C-AJ-2342 C-AJ-2167, C-BJ-2021, C-AJ-2342 C-AJ-2167, C-BJ-2021, C-AJ-2342 C-AJ-2167, C-BJ-2021, C-AJ-2342 C-AJ-2167, C-BJ-2021, C-AJ-2371, C-AJ-2342 C-AJ-2167, C-BJ-2021, C-AJ-2371, C-AJ-2342 C-AJ-2167, C-BJ-2021, C-AJ-2371, C-AJ-2342 C-AJ-2167, C-BJ-2021, C-AJ-2098, C-AJ-2098	C-AJ-0055, C-AJ-0090 CP 680, CP 680	HD HUB DRAIN HP HORSEPOWER HWS HOT WATER SUPPLY HWR HOT WATER RECIRCULATION IE INVERT ELEVATION IMB ICE MAKER HOOK-UP BOX LAUNDRY HOOK-UP BOX LAUNDRY HOOK-UP BOX DRAWING INDEX
	INSULATED PIPES (5000-5999) 2 F-A 5015, F-A 5017, C-AJ-5090, C-AJ-5090, C-AJ-5090, C-AJ-5090, C-AJ-5090, C-AJ-5090, C-AJ-5090, C-AJ-5090, C-AJ-8099, C-AJ	C-AJ-5091, C-AJ-5061, W-J-5042 W-L-5028, W-L-5029, W-L-5047 C-AJ-8056, W-J-8007, C-AJ-8143 W-L-1095, W-L-8013	P001 GENERAL NOTES & LEGENDS P101-N FIRST FLOOR PLAN NORTH P101-S FIRST FLOOR PLAN SOUTH P102-N SECOND FLOOR PLAN NORTH P102-S SECOND FLOOR PLAN NORTH P102-S SECOND FLOOR PLAN SOUTH P103 ROOF PLAN
	NOTES: 1. JOBSITE CONDITIONS OF EACH THROUGH-PENETRATION FIRESTOP SYSTEM MUST MEET ALL DETAILS OF CONDITIONS DO NOT MATCH ANY UL-CLASSIFIED SYSTEMS IN THE SCHEDULES ABOVE, CONDITIONS DO NOT MATCH ANY UL-CLASSIFIED SYSTEM IS LISTED IN THE SCHEDULES, CHOOSE OF CONDITIONS DO NOT MATCH ANY UL-CLASSIFIED SYSTEM IS LISTED IN THE SCHEDULES, CHOOSE OF CONDITIONS OF CONDI	F THE UL-CLASSIFIED SYSTEM SELECTED. TACT FIRESTOP MANUFACTURER FOR ALTERNATIVE SYSTEMS OR ENGINEER JUDGME THE UL SYSTEM WHICH IS MOST ECONOMICAL FOR EACH THROUGH-PENETRATION FIRI	P201 ENLARGED PLANS P300 GAS SUPPLY RISER P301-E WASTE AND VENT RISER P301-N WASTE AND VENT RISER P301-S WASTE AND VENT RISER P302-N SUPPLY RISER P302-S SUPPLY RISER

NOTES

RK IN ACCORDANCE WITH THE FLORIDA PLUMBING CODE AND LOCAL PLUMBING CONFLICTS OCCUR BETWEEN CODES AND BETWEEN THE CONSTRUCTION O CODES, THE MOST RESTRICTIVE REQUIREMENTS SHALL GOVERN. DIAGRAMMATIC, INDICATIVE OF WORK TO BE FURNISHED AND INSTALLED UNDER

. REFER TO ARCHITECTURAL AND STRUCTURAL DRAWINGS FOR ALL DIMENSIONS. L DIMENSIONS AND ALL CONDITIONS. IF THE CONTRACTOR IS UNABLE TO CONTRACT DOCUMENTS, HE IS RESPONSIBLE TO REQUEST CLARIFICATION IN ARCHITECT. IF HE PROCEEDS WITH ANY WORK BEFORE OBTAINING CLARIFICATION, D RESPONSIBLE FOR ALL DEFICIENCIES ASSOCIATED THEREWITH.

TING FOR THE WORK, EACH BIDDER WILL BE RESPONSIBLE TO EXAMINE THE SATISFY HIMSELF AS TO THE EXISTING CONDITIONS UNDER WHICH HE WILL BE PERATE AND COMPLETE THE WORK UNDER THIS CONTRACT. NO ALLOWANCE WILL BE MADE IN THIS CONNECTION ON BEHALF OF THE CONTRACTOR FOR ANY ERROR I HIS PART.

OR SHALL PAY FOR ALL INSPECTION PERMITS, CERTIFICATES, CONNECTION FEES,

D CHARGES AND LICENSE FEES IN CONNECTION WITH HIS WORK. MANAGER/GENERAL CONTRACTOR SHALL BE RESPONSIBLE FOR COORDINATING JBCONTRACTORS TO AVOID INTERFERENCES.

L COMPLY WITH APPLICABLE O.S.H.A. AND E.P.A. REGULATIONS AND GUIDELINES. ITAIN ALL REASONABLE PRECAUTIONS FOR SAFETY AND HEALTH INCLUDING R SIGNS AND OTHER WARNINGS AGAINST HAZARDS INCLUDING PROMULGATING ATIONS. PROVIDE SAFETY PRECAUTIONS AND BARRICADES FOR PEDESTRIANS AT VEHICLE ACCESS AND EGRESS LOCATIONS.

SEQUENCE ALL CLEANING AND CONSTRUCTION WORK. SUBMIT A COMPLETELY FRUCTION SCHEDULE PRIOR TO PRE-CONSTRUCTION CONFERENCE.

OR SHALL STRICTLY BE HELD TO THE PROJECT SCHEDULE. HE SHALL PROVIDE POWER AND EQUIPMENT TO FULLY MOBILIZE, PROCEED WITH AND COMPLETE THE

OR SHALL BE RESTRICTED TO AREAS SPECIFIED BY THE OWNER FOR ON-SITE NSTRUCTION MATERIALS. THE CONTRACTOR IS RESPONSIBLE FOR THE

D SECURITY OF ALL EQUIPMENT AND MATERIALS. OR SHALL MAINTAIN A CLEAN WORK ENVIRONMENT AT ALL TIMES AND SHALL CLEAN SITE OF ALL DEBRIS AT COMPLETION OF THE JOB AND BEFORE FINAL PAYMENT IS

OR SHALL FURNISH "AS-BUILT" DRAWINGS TO THE OWNER AT COMPLETION OF

USE OF AN APPROVAL STAMP ON DOCUMENTS SUBMITTED AS SHOP DRAWINGS, SAMPLES AND SIMILAR SUBMITTALS CERTIFIES THAT THE CONTRACTOR HAS THE CONTRACT DOCUMENT REQUIREMENTS RELATED TO "SHOP DRAWINGS,

AND SAMPLES". OR SHALL NOT BE RELIEVED OF RESPONSIBILITY FOR DEVIATIONS FROM OF THE CONTRACT DOCUMENTS BY THE ARCHITECT/ ENGINEER'S APPROVAL OF S, PRODUCT DATA, SAMPLES OR SIMILAR SUBMITTALS UNLESS THE CONTRACTOR LY INFORMED THE ARCHITECT/ENGINEER IN WRITING OF SUCH DEVIATION AT THE TAL AND THE ARCHITECT/ENGINEER HAS GIVEN WRITTEN APPROVAL TO THE TION. THE CONTRACTOR SHALL NOT BE RELIEVED OF RESPONSIBILITY FOR ERRORS N SHOP DRAWINGS, PRODUCT DATA, SAMPLES OR SIMILAR SUBMITTALS BY THE SINEER'S APPROVAL THEREOF.

LATION, COORDINATE AND ADJUST THE FINAL LOCATION OF ALL WALL MOUNTED UIPMENT WITH ALL CASEWORK, SHELVING, MARKER BOARDS, BULLETIN BOARDS MOUNTED FURNISHINGS.

AL REQUIREMENTS INVOLVED IN INSTALLING THE EQUIPMENT IN THE BUILDING. ID REASSEMBLING OF ANY EQUIPMENT SHALL BE DONE AS REQUIRED FOR ENTRY NG AND EQUIPMENT ROOMS.

OOF FROM DAMAGE WHENEVER ANY WORK ON THE ROOF IS REQUIRED. HANGERS SHALL PRESENT A NEAT, ORDERLY APPEARANCE. ATTACHMENTS SHALL

RAL SYSTEMS ONLY. HALL MAINTAIN THE INTEGRITY OF ALL FIRE, SMOKE, AND ACOUSTICAL WALL

PENETRATIONS SHALL BE APPROVED BY THE STRUCTURAL ENGINEER. BEAM EAM REINFORCING APPROVED BY STRUCTURAL ENGINEER SHALL BE FURNISHED BY THIS CONTRACTOR.

HALL FURNISH U.L. APPROVED DRAWINGS FOR EACH TYPE OF FIRE RATED ETRATION BY DUCTS, PIPES OR CONDUITS. THESE DRAWINGS SHALL BE DISPLAYED

E AT ALL TIMES DURING CONSTRUCTION. SEE SPECIFICATIONS. HALL GUARANTEE THE WORK AND MATERIALS FOR A PERIOD OF ONE YEAR FROM ANTIAL COMPLETION. THIS GUARANTEE SHALL BE IN ADDITION TO THE WARRANTIES TERIAL SUPPLIERS AND MANUFACTURERS.

HALL COMPLY WITH "TRENCH SAFETY ACT" (FLORIDA STATUTE 553 PART III) AND D 29 CFR 1926.650 SUBPART P FOR ALL UTILITY TRENCHES IN EXCESS OF 5 FEET TOR SHALL INDICATE WITHIN HIS BID RESPONSE A REFERENCE TO THE TRENCH ARD AND A SEPARATE LINE ITEM COST OF COMPLIANCE WITH STANDARD.

EVIATIONS

AD	AREA DRAIN	MSB	MOP SERVICE BASIN
	· · · · — · · – · · · · · ·		
AF	ABOVE FLOOR	N/A	NOT APPLICABLE
AFF	ABOVE FINISHED FLOOR	NIS	NOT IN SCOPE
AHAP	AS HIGH AS POSSIBLE	OD	OVERFLOW DRAIN
BF	BELOW FLOOR	OS	OIL SEPARATOR
BG	BELOW GRADE	PSAN	SANITARY
CWS	COLD WATER SUPPLY	PVENT	VENT
DN	DOWN	RD	ROOF DRAIN
EWC	ELECTRIC WATER COOLER	RL	RAIN LEADER
FD	FLOOR DRAIN	SH	SHOWER
HB	HOSE BIBB	SK	SINK
HD	HUB DRAIN	TYP	TYPICAL
HP	HORSEPOWER	UR	URINAL
HWS	HOT WATER SUPPLY	VTR	VENT THROUGH ROOF
HWR	HOT WATER RECIRCULATION	WC	WATER CLOSET
ΙE	INVERT ELEVATION	WCO	WALL CLEANOUT
IMB	ICE MAKER HOOK-UP BOX	WH	WALL HYDRANT
LHB	LAUNDRY HOOK-UP BOX	WHA	WATER HAMMER ARRESTER

LV

LAVATORY

ENGINEERING H2E PROJECT No. 17-17 114 EAST 5th AVENUE TALLAHASSEE, FL

11" x 17" SHEETS ARE PLOTTED AT 1/2

architects

ARCHITECTURE

www.emiarch.com LICENSE #s AA C000409 IB C000153

GRAPHICS

(850) 222 - 7442

PLANNING INTERIORS

ELLIOTT MARSHALL INNES P.A. (EMI architects)

251 E. 7TH AVENUE TALLAHASSEE FL 32303

32303 PHONE 850.224.7922 www.H2Engineering.com THIS DOCUMENT IS THE PROPERTY OF H2Engineering AND IS PREPARED AS AN INSTRUMENT OF SERVICE. ITS USE, REUSE OR REPRODUCTION, EXCEPT BY WRITTEN AGREEMENT WITH H2Engineering, IS PROHIBITED.

> Florida Registry #2485 Jeffrey L. Tyler, P.E. #57093

Jeffrey Lee Tyler, State of Florida, Professional Engineer, License No. 57093

This item has been digitally signed and sealed by Jeffrey Lee Tyler, P.E. on the date

Printed copies of this document are not considered signed and sealed, and the signature must be verified on any electronic

Date: 02/10/2025


WCSD EDUCATIONAL ANCILLARY FACILITIES -DISTRICT OFFICE

ALLSTATE CONSTRUCTION 02-13-2025

REV	DATE	DESCRIPT	ION
1		ADDENDU	
PRO IEC	T PHASE		
		OOUNTENIT	2
CONST	RUCTION D	OCUMENT	5
DATE			DRAWN BY
15 JANL	JARY 2025		JDR
PROJEC	T NO		CHECKED B
	1110		
68100			JLT

SHEET TITLE

GENERAL NOTES & LEGENDS

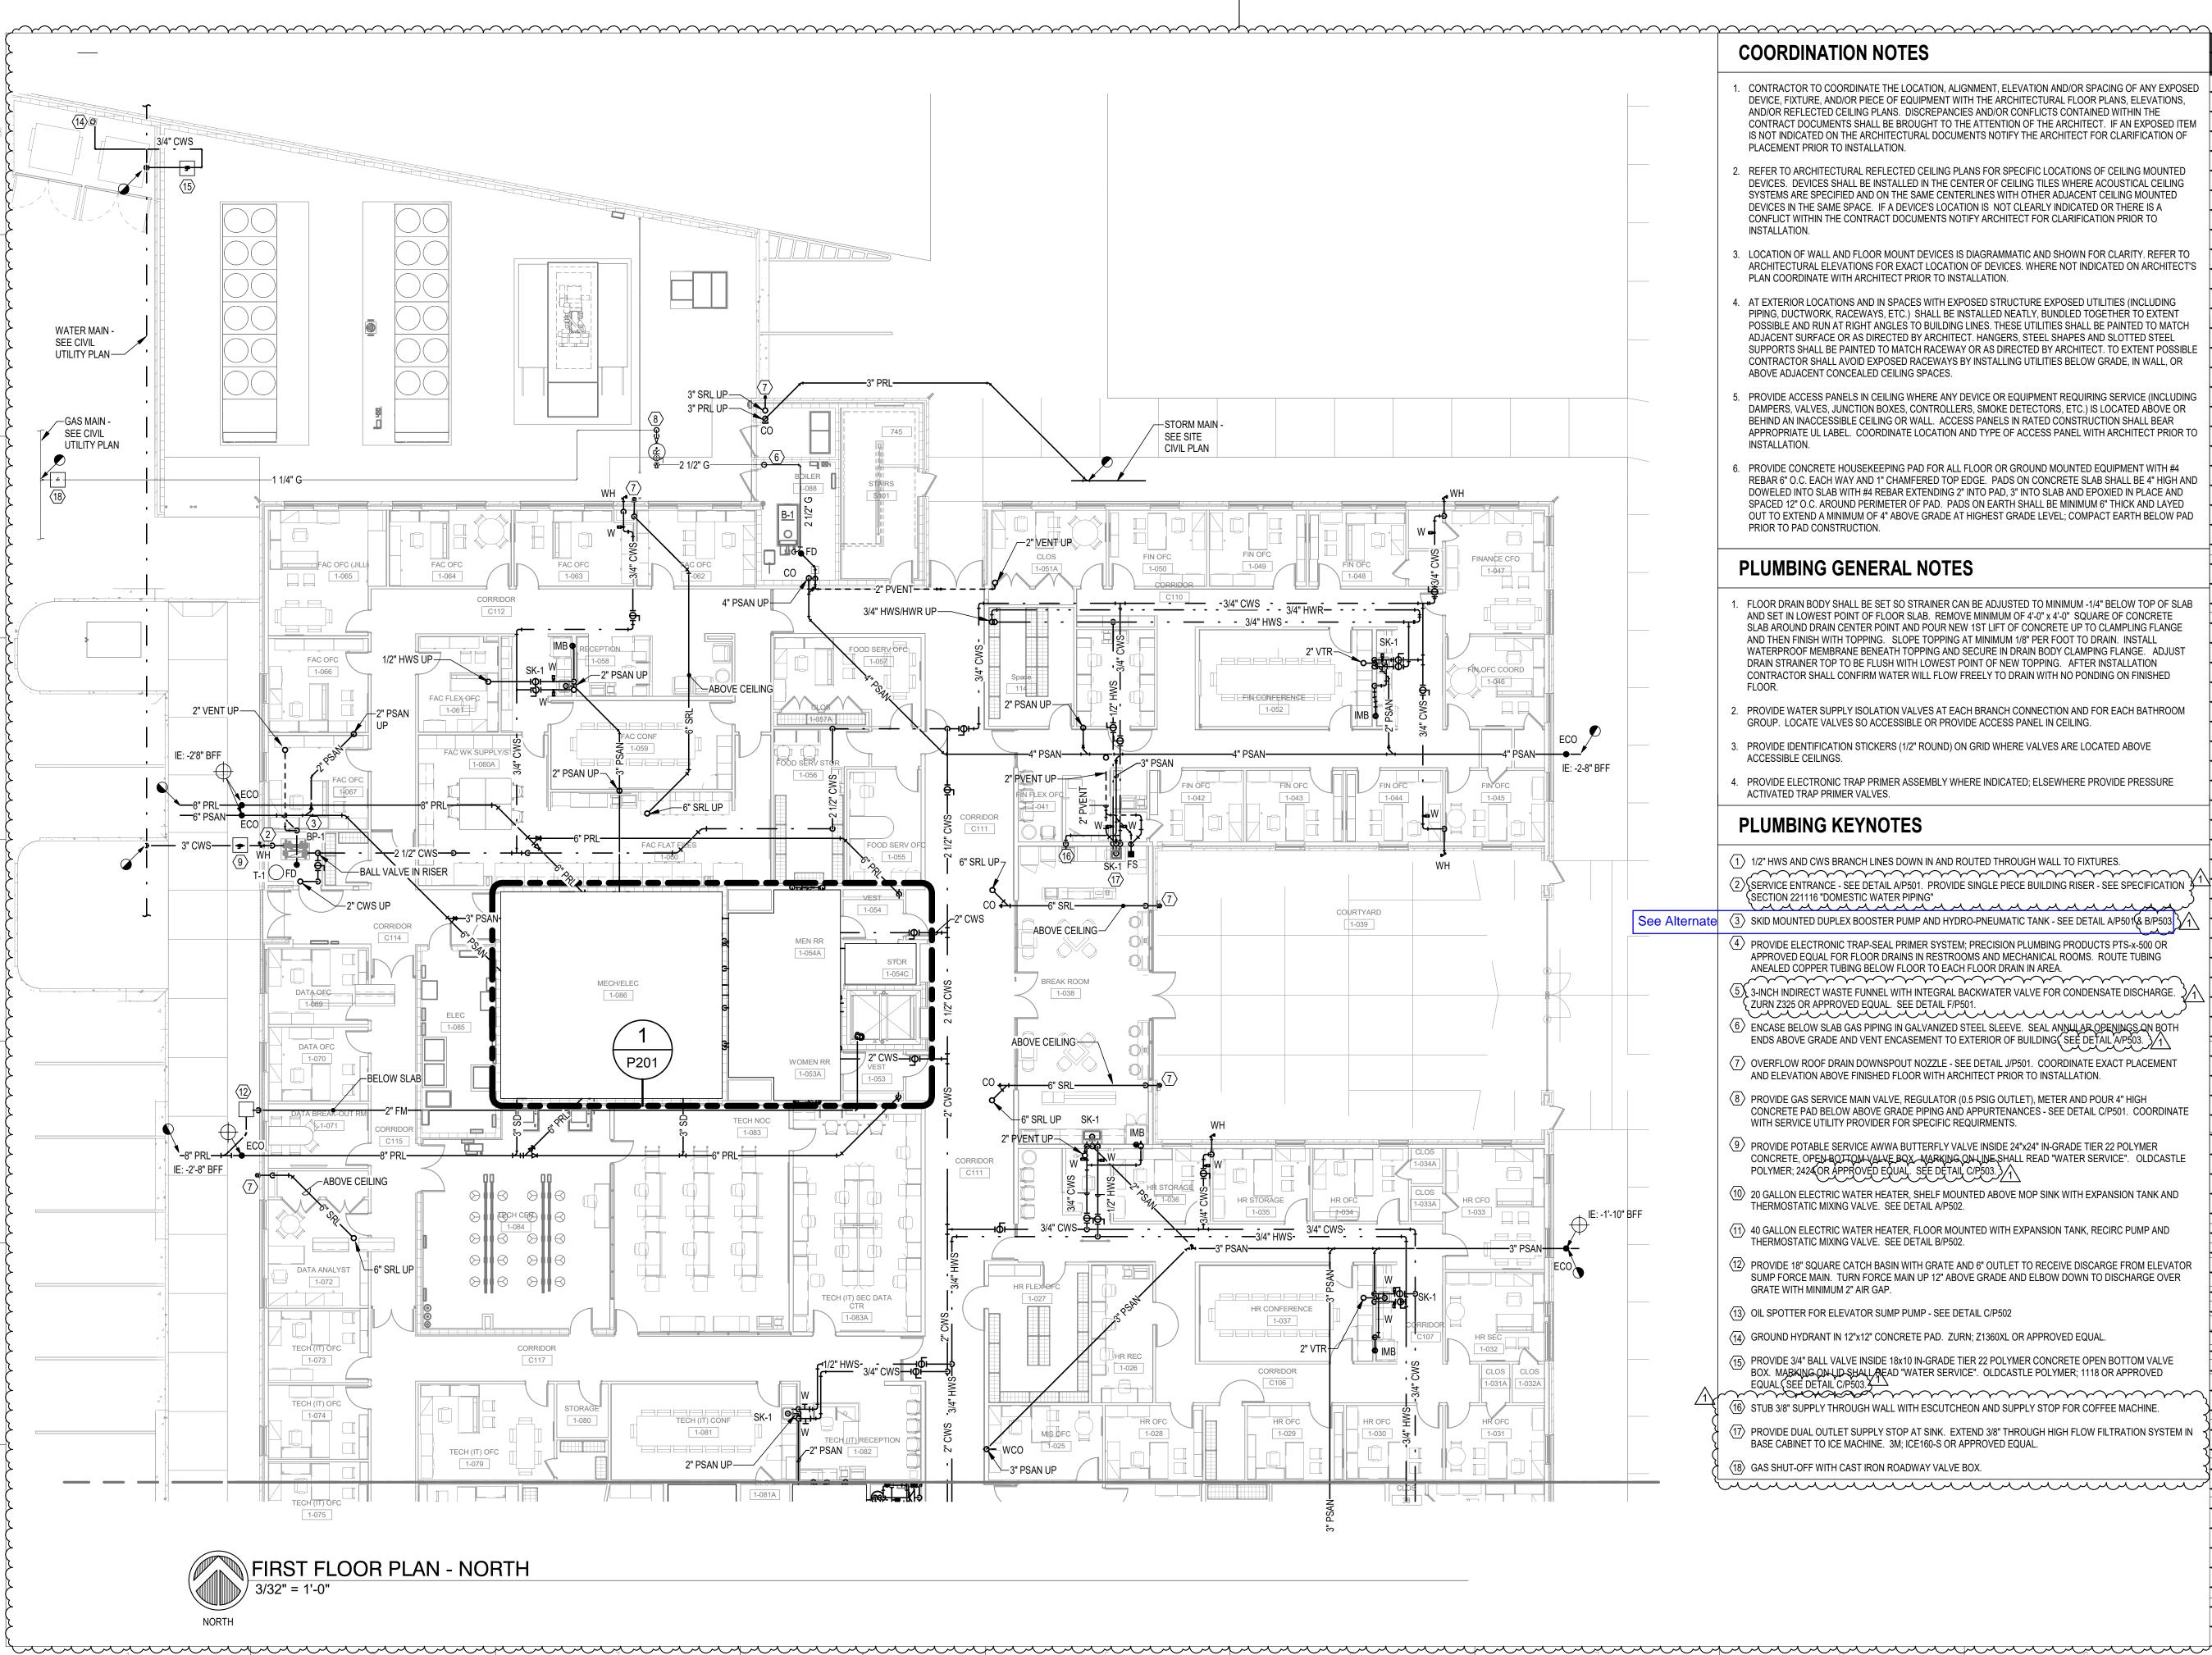

- CONTRACTOR TO COORDINATE THE LOCATION, ALIGNMENT, ELEVATION AND/OR SPACING OF ANY EXPOSED DEVICE, FIXTURE, AND/OR PIECE OF EQUIPMENT WITH THE ARCHITECTURAL FLOOR PLANS, ELEVATIONS, AND/OR REFLECTED CEILING PLANS. DISCREPANCIES AND/OR CONFLICTS CONTAINED WITHIN THE CONTRACT DOCUMENTS SHALL BE BROUGHT TO THE ATTENTION OF THE ARCHITECT. IF AN EXPOSED ITEM IS NOT INDICATED ON THE ARCHITECTURAL DOCUMENTS NOTIFY THE ARCHITECT FOR CLARIFICATION OF PLACEMENT PRIOR TO INSTALLATION.
- REFER TO ARCHITECTURAL REFLECTED CEILING PLANS FOR SPECIFIC LOCATIONS OF CEILING MOUNTED DEVICES. DEVICES SHALL BE INSTALLED IN THE CENTER OF CEILING TILES WHERE ACOUSTICAL CEILING SYSTEMS ARE SPECIFIED AND ON THE SAME CENTERLINES WITH OTHER ADJACENT CEILING MOUNTED DEVICES IN THE SAME SPACE. IF A DEVICE'S LOCATION IS NOT CLEARLY INDICATED OR THERE IS A CONFLICT WITHIN THE CONTRACT DOCUMENTS NOTIFY ARCHITECT FOR CLARIFICATION PRIOR TO INSTALLATION.
- LOCATION OF WALL AND FLOOR MOUNT DEVICES IS DIAGRAMMATIC AND SHOWN FOR CLARITY. REFER TO ARCHITECTURAL ELEVATIONS FOR EXACT LOCATION OF DEVICES. WHERE NOT INDICATED ON ARCHITECT'S PLAN COORDINATE WITH ARCHITECT PRIOR TO INSTALLATION.
- 4. AT EXTERIOR LOCATIONS AND IN SPACES WITH EXPOSED STRUCTURE EXPOSED UTILITIES (INCLUDING PIPING, DUCTWORK, RACEWAYS, ETC.) SHALL BE INSTALLED NEATLY, BUNDLED TOGETHER TO EXTENT POSSIBLE AND RUN AT RIGHT ANGLES TO BUILDING LINES. THESE UTILITIES SHALL BE PAINTED TO MATCH ADJACENT SURFACE OR AS DIRECTED BY ARCHITECT. HANGERS, STEEL SHAPES AND SLOTTED STEEL SUPPORTS SHALL BE PAINTED TO MATCH RACEWAY OR AS DIRECTED BY ARCHITECT. TO EXTENT POSSIBLE CONTRACTOR SHALL AVOID EXPOSED RACEWAYS BY INSTALLING UTILITIES BELOW GRADE, IN WALL, OR ABOVE ADJACENT CONCEALED CEILING SPACES.
- PROVIDE ACCESS PANELS IN CEILING WHERE ANY DEVICE OR EQUIPMENT REQUIRING SERVICE (INCLUDING DAMPERS, VALVES, JUNCTION BOXES, CONTROLLERS, SMOKE DETECTORS, ETC.) IS LOCATED ABOVE OR BEHIND AN INACCESSIBLE CEILING OR WALL. ACCESS PANELS IN RATED CONSTRUCTION SHALL BEAR APPROPRIATE UL LABEL. COORDINATE LOCATION AND TYPE OF ACCESS PANEL WITH ARCHITECT PRIOR TO INSTALLATION.
- PROVIDE CONCRETE HOUSEKEEPING PAD FOR ALL FLOOR OR GROUND MOUNTED EQUIPMENT WITH #4 REBAR 6" O.C. EACH WAY AND 1" CHAMFERED TOP EDGE. PADS ON CONCRETE SLAB SHALL BE 4" HIGH AND DOWELED INTO SLAB WITH #4 REBAR EXTENDING 2" INTO PAD, 3" INTO SLAB AND EPOXIED IN PLACE AND SPACED 12" O.C. AROUND PERIMETER OF PAD. PADS ON EARTH SHALL BE MINIMUM 6" THICK AND LAYED OUT TO EXTEND A MINIMUM OF 4" ABOVE GRADE AT HIGHEST GRADE LEVEL; COMPACT EARTH BELOW PAD PRIOR TO PAD CONSTRUCTION.

PLUMBING GENERAL NOTES

- FLOOR DRAIN BODY SHALL BE SET SO STRAINER CAN BE ADJUSTED TO MINIMUM -1/4" BELOW TOP OF SLAB AND SET IN LOWEST POINT OF FLOOR SLAB. REMOVE MINIMUM OF 4'-0" x 4'-0" SQUARE OF CONCRETE SLAB AROUND DRAIN CENTER POINT AND POUR NEW 1ST LIFT OF CONCRETE UP TO CLAMPLING FLANGE AND THEN FINISH WITH TOPPING. SLOPE TOPPING AT MINIMUM 1/8" PER FOOT TO DRAIN. INSTALL WATERPROOF MEMBRANE BENEATH TOPPING AND SECURE IN DRAIN BODY CLAMPING FLANGE. ADJUST DRAIN STRAINER TOP TO BE FLUSH WITH LOWEST POINT OF NEW TOPPING. AFTER INSTALLATION CONTRACTOR SHALL CONFIRM WATER WILL FLOW FREELY TO DRAIN WITH NO PONDING ON FINISHED
- PROVIDE WATER SUPPLY ISOLATION VALVES AT EACH BRANCH CONNECTION AND FOR EACH BATHROOM GROUP. LOCATE VALVES SO ACCESSIBLE OR PROVIDE ACCESS PANEL IN CEILING.
- PROVIDE IDENTIFICATION STICKERS (1/2" ROUND) ON GRID WHERE VALVES ARE LOCATED ABOVE ACCESSIBLE CEILINGS.
- 4. PROVIDE ELECTRONIC TRAP PRIMER ASSEMBLY WHERE INDICATED; ELSEWHERE PROVIDE PRESSURE ACTIVATED TRAP PRIMER VALVES.


PLUMBING KEYNOTES

- $\langle 1 \rangle$ 1/2" HWS AND CWS BRANCH LINES DOWN IN AND ROUTED THROUGH WALL TO FIXTURES.
- 〈2〉{SERVICE ENTRANCE - SEE DETAIL A/P501. PROVIDE SINGLE PIECE BUILDING RISER - SEE SPECIFICATION 🐉 🗥 SECTION 221116 "DOMESTIC WATER PIPING" ALLE CONTRACTOR CONTRA
- $\langle 4 \rangle$ PROVIDE ELECTRONIC TRAP-SEAL PRIMER SYSTEM; PRECISION PLUMBING PRODUCTS PTS-x-500 OR APPROVED EQUAL FOR FLOOR DRAINS IN RESTROOMS AND MECHANICAL ROOMS. ROUTE TUBING ANEALED COPPER TUBING BELOW FLOOR TO EACH FLOOR DRAIN IN AREA.
- \sim λ 3-INCH INDIRECT WASTE FUNNEL WITH INTEGRAL BACKWATER VALVE FOR CONDENSATE DISCHARGE. ZURN Z325 OR APPROVED EQUAL. SEE DETAIL F/P501.
- (6) ENCASE BELOW SLAB GAS PIPING IN GALVANIZED STEEL SLEEVE. SEAL ANNULAR OPENINGS ON BOTH
- ENDS ABOVE GRADE AND VENT ENCASEMENT TO EXTERIOR OF BUILDING (SEE DE TAIL A/P503.) (7) OVERFLOW ROOF DRAIN DOWNSPOUT NOZZLE - SEE DETAIL J/P501. COORDINATE EXACT PLACEMENT
- AND ELEVATION ABOVE FINISHED FLOOR WITH ARCHITECT PRIOR TO INSTALLATION.
- CONCRETE PAD BELOW ABOVE GRADE PIPING AND APPURTENANCES SEE DETAIL C/P501. COORDINATE WITH SERVICE UTILITY PROVIDER FOR SPECIFIC REQUIRMENTS. 9 PROVIDE POTABLE SERVICE AWWA BUTTERFLY VALVE INSIDE 24"x24" IN-GRADE TIER 22 POLYMER
- CONCRETE, OPEN BOTTOM VALVE BOX MARKING ON LINE SHALL READ "WATER SERVICE". OLDCASTLE POLYMER; 2424 OR APPROVED EQUAL. SEE DETAIL C/P503.
- THERMOSTATIC MIXING VALVE. SEE DETAIL A/P502.
- 40 GALLON ELECTRIC WATER HEATER, FLOOR MOUNTED WITH EXPANSION TANK, RECIRC PUMP AND THERMOSTATIC MIXING VALVE. SEE DETAIL B/P502.
- \$\langle 12 \rangle PROVIDE 18" SQUARE CATCH BASIN WITH GRATE AND 6" OUTLET TO RECEIVE DISCARGE FROM ELEVATOR SUMP FORCE MAIN. TURN FORCE MAIN UP 12" ABOVE GRADE AND ELBOW DOWN TO DISCHARGE OVER GRATE WITH MINIMUM 2" AIR GAP.
- (13) OIL SPOTTER FOR ELEVATOR SUMP PUMP SEE DETAIL C/P502
- (14) GROUND HYDRANT IN 12"x12" CONCRETE PAD. ZURN; Z1360XL OR APPROVED EQUAL.
- ⟨15⟩ PROVIDE 3/4" BALL VALVE INSIDE 18x10 IN-GRADE TIER 22 POLYMER CONCRETE OPEN BOTTOM VALVE BOX. MARKING ON LID-SHALL READ "WATER SERVICE". OLDCASTLE POLYMER; 1118 OR APPROVED EQUAL. SEE DETAIL C/P503. \sim
- (16) STUB 3/8" SUPPLY THROUGH WALL WITH ESCUTCHEON AND SUPPLY STOP FOR COFFEE MACHINE. (17) PROVIDE DUAL OUTLET SUPPLY STOP AT SINK. EXTEND 3/8" THROUGH HIGH FLOW FILTRATION SYSTEM IN
- (18) GAS SHUT-OFF WITH CAST IRON ROADWAY VALVE BOX

ARCHITECTURE PLANNING INTERIORS GRAPHICS

251 E. 7TH AVENUE TALLAHASSEE FL 32303 (850) 222 - 7442 www.emiarch.com
LICENSE #s AA C000409 IB C000153

1" x 17" SHEFTS ARE PLOTTED AT 1/2

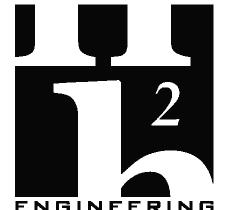

ENGINEERING H2E PROJECT No. 17-17

32303 PHONE 850.224.7922 www.H2Engineering.com THIS DOCUMENT IS THE PROPERTY OF H2Engineering AND IS PREPARED AS AN INSTRUMENT OF SERVICE. ITS

JSE, REUSE OR REPRODUCTION, EXCEPT BY WRITTEN AGREEMENT WITH H2Engineering, IS PROHIBITED. Florida Registry #2485 Jeffrey L. Tyler, P.E. #57093 Jeffrey Lee Tyler, State of Florida,

This item has been digitally signed and sealed by Jeffrey Lee Tyler, P.E. on the date

> Printed copies of this document are not considered signed and sealed, and the signature must be verified on any electronic

ofessional Engineer, License No. **57093**

Date: 02/10/2025

WCSD EDUCATIONAL ANCILLARY FACILITIES -DISTRICT OFFICE

RECEIVED **ALLSTATE CONSTRUCTION** 02-13-2025

ΈΕV	DATE	DESCRIPTION
∤ 1	2/11/2025	ADDENDUM #1
)		
}		
{		
\langle		
5		
\langle		
{		
\rangle		
$\overline{}$		

ROJECT PHASE CONSTRUCTION DOCUMENTS

DRAWN BY)15 JANUARY 2025 JDR ROJECT NO **CHECKED BY** JLT

HEET TITLE

FIRST FLOOR PLAN **NORTH**

REV NO P101-N

- CONTRACTOR TO COORDINATE THE LOCATION, ALIGNMENT, ELEVATION AND/OR SPACING OF ANY EXPOSED DEVICE, FIXTURE, AND/OR PIECE OF EQUIPMENT WITH THE ARCHITECTURAL FLOOR PLANS, ELEVATIONS, AND/OR REFLECTED CEILING PLANS. DISCREPANCIES AND/OR CONFLICTS CONTAINED WITHIN THE CONTRACT DOCUMENTS SHALL BE BROUGHT TO THE ATTENTION OF THE ARCHITECT. IF AN EXPOSED ITEM IS NOT INDICATED ON THE ARCHITECTURAL DOCUMENTS NOTIFY THE ARCHITECT FOR CLARIFICATION OF PLACEMENT PRIOR TO INSTALLATION.
- REFER TO ARCHITECTURAL REFLECTED CEILING PLANS FOR SPECIFIC LOCATIONS OF CEILING MOUNTED DEVICES. DEVICES SHALL BE INSTALLED IN THE CENTER OF CEILING TILES WHERE ACOUSTICAL CEILING SYSTEMS ARE SPECIFIED AND ON THE SAME CENTERLINES WITH OTHER ADJACENT CEILING MOUNTED DEVICES IN THE SAME SPACE. IF A DEVICE'S LOCATION IS NOT CLEARLY INDICATED OR THERE IS A CONFLICT WITHIN THE CONTRACT DOCUMENTS NOTIFY ARCHITECT FOR CLARIFICATION PRIOR TO INSTALLATION.
- LOCATION OF WALL AND FLOOR MOUNT DEVICES IS DIAGRAMMATIC AND SHOWN FOR CLARITY. REFER TO ARCHITECTURAL ELEVATIONS FOR EXACT LOCATION OF DEVICES. WHERE NOT INDICATED ON ARCHITECT'S PLAN COORDINATE WITH ARCHITECT PRIOR TO INSTALLATION.
- 4. AT EXTERIOR LOCATIONS AND IN SPACES WITH EXPOSED STRUCTURE EXPOSED UTILITIES (INCLUDING PIPING, DUCTWORK, RACEWAYS, ETC.) SHALL BE INSTALLED NEATLY, BUNDLED TOGETHER TO EXTENT POSSIBLE AND RUN AT RIGHT ANGLES TO BUILDING LINES. THESE UTILITIES SHALL BE PAINTED TO MATCH ADJACENT SURFACE OR AS DIRECTED BY ARCHITECT. HANGERS, STEEL SHAPES AND SLOTTED STEEL SUPPORTS SHALL BE PAINTED TO MATCH RACEWAY OR AS DIRECTED BY ARCHITECT. TO EXTENT POSSIBLE CONTRACTOR SHALL AVOID EXPOSED RACEWAYS BY INSTALLING UTILITIES BELOW GRADE, IN WALL, OR ABOVE ADJACENT CONCEALED CEILING SPACES.
- PROVIDE ACCESS PANELS IN CEILING WHERE ANY DEVICE OR EQUIPMENT REQUIRING SERVICE (INCLUDING DAMPERS, VALVES, JUNCTION BOXES, CONTROLLERS, SMOKE DETECTORS, ETC.) IS LOCATED ABOVE OR BEHIND AN INACCESSIBLE CEILING OR WALL. ACCESS PANELS IN RATED CONSTRUCTION SHALL BEAR APPROPRIATE UL LABEL. COORDINATE LOCATION AND TYPE OF ACCESS PANEL WITH ARCHITECT PRIOR TO INSTALLATION.
- PROVIDE CONCRETE HOUSEKEEPING PAD FOR ALL FLOOR OR GROUND MOUNTED EQUIPMENT WITH #4 REBAR 6" O.C. EACH WAY AND 1" CHAMFERED TOP EDGE. PADS ON CONCRETE SLAB SHALL BE 4" HIGH AND DOWELED INTO SLAB WITH #4 REBAR EXTENDING 2" INTO PAD. 3" INTO SLAB AND EPOXIED IN PLACE AND SPACED 12" O.C. AROUND PERIMETER OF PAD. PADS ON EARTH SHALL BE MINIMUM 6" THICK AND LAYED OUT TO EXTEND A MINIMUM OF 4" ABOVE GRADE AT HIGHEST GRADE LEVEL; COMPACT EARTH BELOW PAD PRIOR TO PAD CONSTRUCTION.

ARCHITECTURE PLANNING INTERIORS GRAPHICS

ELLIOTT MARSHALL INNES P.A. (EMI architects) 251 E. 7TH AVENUE TALLAHASSEE FL 32303 LICENSE #s AA C000409 IB C000153

PLUMBING GENERAL NOTES

- FLOOR DRAIN BODY SHALL BE SET SO STRAINER CAN BE ADJUSTED TO MINIMUM -1/4" BELOW TOP OF SLAB AND SET IN LOWEST POINT OF FLOOR SLAB. REMOVE MINIMUM OF 4'-0" x 4'-0" SQUARE OF CONCRETE SLAB AROUND DRAIN CENTER POINT AND POUR NEW 1ST LIFT OF CONCRETE UP TO CLAMPLING FLANGE AND THEN FINISH WITH TOPPING. SLOPE TOPPING AT MINIMUM 1/8" PER FOOT TO DRAIN. INSTALL WATERPROOF MEMBRANE BENEATH TOPPING AND SECURE IN DRAIN BODY CLAMPING FLANGE. ADJUST DRAIN STRAINER TOP TO BE FLUSH WITH LOWEST POINT OF NEW TOPPING. AFTER INSTALLATION CONTRACTOR SHALL CONFIRM WATER WILL FLOW FREELY TO DRAIN WITH NO PONDING ON FINISHED
- 2. PROVIDE WATER SUPPLY ISOLATION VALVES AT EACH BRANCH CONNECTION AND FOR EACH BATHROOM GROUP. LOCATE VALVES SO ACCESSIBLE OR PROVIDE ACCESS PANEL IN CEILING.
- 3. PROVIDE IDENTIFICATION STICKERS (1/2" ROUND) ON GRID WHERE VALVES ARE LOCATED ABOVE ACCESSIBLE CEILINGS.
- 4. PROVIDE ELECTRONIC TRAP PRIMER ASSEMBLY WHERE INDICATED; ELSEWHERE PROVIDE PRESSURE ACTIVATED TRAP PRIMER VALVES.

PLUMBING KEYNOTES

1-005

SECUR OFC

1-004

ECURITY OFC

1-003

SECURE LOBBY

₹3/4" CWS | -

MIS STOR

MIS FLEX

-ABOVE CEILING

1-023

MAIL RM

ROTONDA / GALLERY

1-002A

1-081A

1-019

1-008

WOMEN RR

1-009


1-020A

1-010

 \rightarrow

- 1/2" HWS AND CWS BRANCH LINES DOWN IN AND ROUTED THROUGH WALL TO FIXTURES.
- (2) SERVICE ENTRANCE SEE DETAIL A/P501. PROVIDE SINGLE PIECE BUILDING RISER SEE SPECIFICATION SECTION 221116 "DOMESTIC WATER PIPING"
- (3) SKID MOUNTED DUPLEX BOOSTER PUMP AND HYDRO-PNEUMATIC TANK SEE DETAIL A/P501 & B/P503.
- PROVIDE ELECTRONIC TRAP-SEAL PRIMER SYSTEM; PRECISION PLUMBING PRODUCTS PTS-x-500 OR APPROVED EQUAL FOR FLOOR DRAINS IN RESTROOMS AND MECHANICAL ROOMS. ROUTE TUBING ANEALED COPPER TUBING BELOW FLOOR TO EACH FLOOR DRAIN IN AREA.
- (5) 3-INCH INDIRECT WASTE FUNNEL WITH INTEGRAL BACKWATER VALVE FOR CONDENSATE DISCHARGE. ZURN Z325 OR APPROVED EQUAL. SEE DETAIL F/P501.
- 6 ENCASE BELOW SLAB GAS PIPING IN GALVANIZED STEEL SLEEVE. SEAL ANNULAR OPENINGS ON BOTH ENDS ABOVE GRADE AND VENT ENCASEMENT TO EXTERIOR OF BUILDING. SEE DETAIL A/P503.
- 〈7〉 OVERFLOW ROOF DRAIN DOWNSPOUT NOZZLE SEE DETAIL J/P501. COORDINATE EXACT PLACEMENT AND ELEVATION ABOVE FINISHED FLOOR WITH ARCHITECT PRIOR TO INSTALLATION.
- PROVIDE GAS SERVICE MAIN VALVE, REGULATOR (0.5 PSIG OUTLET), METER AND POUR 4" HIGH CONCRETE PAD BELOW ABOVE GRADE PIPING AND APPURTENANCES - SEE DETAIL C/P501. COORDINATE WITH SERVICE UTILITY PROVIDER FOR SPECIFIC REQUIRMENTS.
- 9 PROVIDE POTABLE SERVICE AWWA BUTTERFLY VALVE INSIDE 24"x24" IN-GRADE TIER 22 POLYMER CONCRETE, OPEN BOTTOM VALVE BOX. MARKING ON LINE SHALL READ "WATER SERVICE". OLDCASTLE POLYMER; 2424 OR APPROVED EQUAL. SEE DETAIL C/P503.
- (10) 20 GALLON ELECTRIC WATER HEATER, SHELF MOUNTED ABOVE MOP SINK WITH EXPANSION TANK AND THERMOSTATIC MIXING VALVE. SEE DETAIL A/P502.
- 40 GALLON ELECTRIC WATER HEATER, FLOOR MOUNTED WITH EXPANSION TANK, RECIRC PUMP AND THERMOSTATIC MIXING VALVE. SEE DETAIL B/P502.
- \$\langle 12 PROVIDE 18" SQUARE CATCH BASIN WITH GRATE AND 6" OUTLET TO RECEIVE DISCARGE FROM ELEVATOR SUMP FORCE MAIN. TURN FORCE MAIN UP 12" ABOVE GRADE AND ELBOW DOWN TO DISCHARGE OVER GRATE WITH MINIMUM 2" AIR GAP.
- (13) OIL SPOTTER FOR ELEVATOR SUMP PUMP SEE DETAIL C/P502
- (14) GROUND HYDRANT IN 12"x12" CONCRETE PAD. ZURN; Z1360XL OR APPROVED EQUAL.
- PROVIDE 3/4" BALL VALVE INSIDE 18x10 IN-GRADE TIER 22 POLYMER CONCRETE OPEN BOTTOM VALVE BOX. MARKING ON LID SHALL READ "WATER SERVICE". OLDCASTLE POLYMER; 1118 OR APPROVED EQUAL. SEE DETAIL C/P503.
- (16) STUB 3/8" SUPPLY THROUGH WALL WITH ESCUTCHEON AND SUPPLY STOP FOR COFFEE MACHINE.
- (17) PROVIDE DUAL OUTLET SUPPLY STOP AT SINK. EXTEND 3/8" THROUGH HIGH FLOW FILTRATION SYSTEM IN BASE CABINET TO ICE MACHINE. 3M; ICE160-S OR APPROVED EQUAL.
- (18) GAS SHUT-OFF WITH CAST IRON ROADWAY VALVE BOX

11" x 17" SHEETS ARE PLOTTED AT 1/2

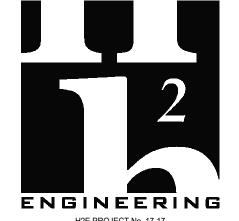

H2E PROJECT No. 17-17 114 EAST 5th AVENUE TALLAHASSEE, FL 32303 PHONE 850.224.7922 www.H2Engineering.com THIS DOCUMENT IS THE PROPERTY OF H2Engineering AND IS PREPARED AS AN INSTRUMENT OF SERVICE. ITS USE, REUSE OR REPRODUCTION, EXCEPT BY WRITTEN

AGREEMENT WITH H2Engineering, IS PROHIBITED. Florida Registry #2485

This item has been digitally signed and sealed

Jeffrey L. Tyler, P.E. #57093 Jeffrey Lee Tyler, State of Florida, Professional Engineer, License No. **57093**

by Jeffrey Lee Tyler, P.E. on the date Printed copies of this document are not considered signed and sealed, and the signature must be verified on any electronic

Date: 02/10/2025

WCSD EDUCATIONAL ANCILLARY FACILITIES -DISTRICT OFFICE

ALLSTATE CONSTRUCTION 02-13-2025


REV	DATE	DESCRIPTION
1	2/11/2025	ADDENDUM #1
PROJEC	T PHASE	
CONCT		OCUMENTO

| CONSTRUCTION DOCUMENTS

DRAWN BY 15 JANUARY 2025 JDR PROJECT NO CHECKED BY JLT SHEET TITLE

> FIRST FLOOR PLAN SOUTH

P101-S

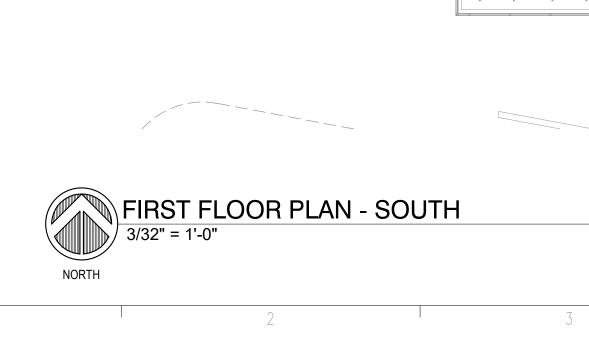

TECH RECEIVING

WCO


WCO

3/4" HWR - - - 3/4"

RD & OD

DEP SUP-STORT 3/4" CWS-

IE: -2'8" BFF

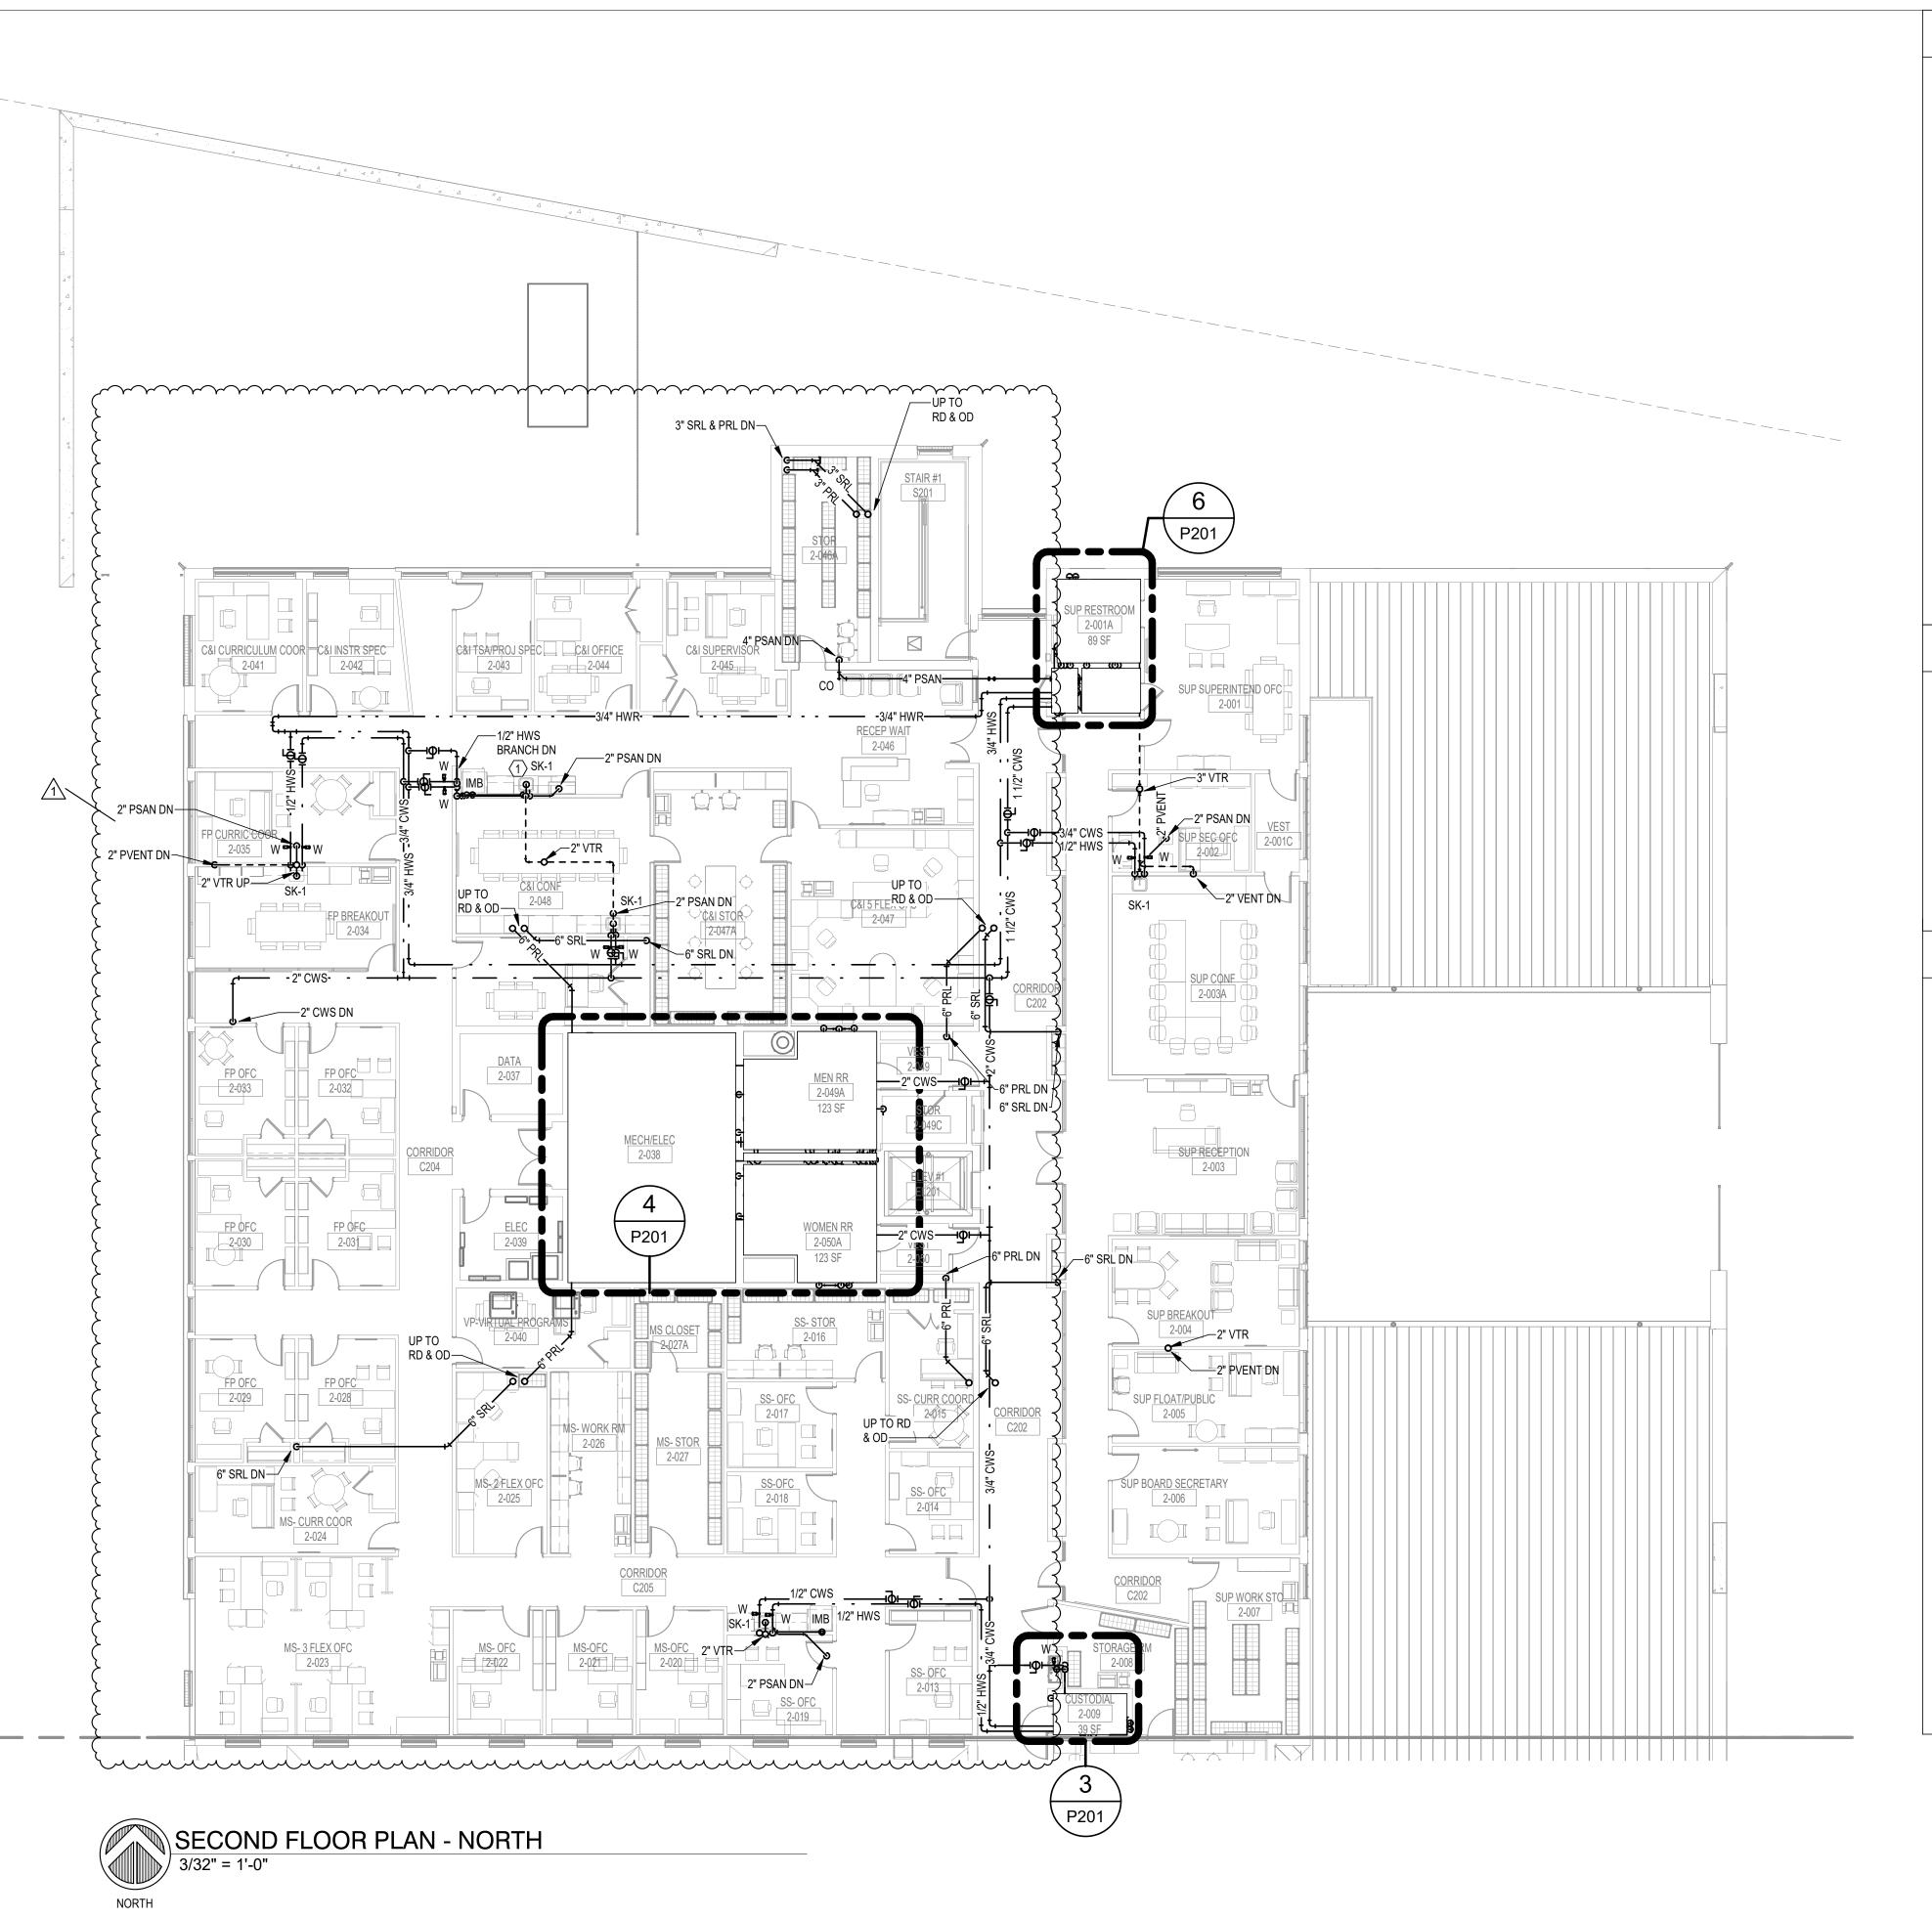

- 1. CONTRACTOR TO COORDINATE THE LOCATION, ALIGNMENT, ELEVATION AND/OR SPACING OF ANY EXPOSED DEVICE, FIXTURE, AND/OR PIECE OF EQUIPMENT WITH THE ARCHITECTURAL FLOOR PLANS, ELEVATIONS, AND/OR REFLECTED CEILING PLANS. DISCREPANCIES AND/OR CONFLICTS CONTAINED WITHIN THE CONTRACT DOCUMENTS SHALL BE BROUGHT TO THE ATTENTION OF THE ARCHITECT. IF AN EXPOSED ITEM IS NOT INDICATED ON THE ARCHITECTURAL DOCUMENTS NOTIFY THE ARCHITECT FOR CLARIFICATION OF PLACEMENT PRIOR TO INSTALLATION.
- 2. REFER TO ARCHITECTURAL REFLECTED CEILING PLANS FOR SPECIFIC LOCATIONS OF CEILING MOUNTED DEVICES. DEVICES SHALL BE INSTALLED IN THE CENTER OF CEILING TILES WHERE ACOUSTICAL CEILING SYSTEMS ARE SPECIFIED AND ON THE SAME CENTERLINES WITH OTHER ADJACENT CEILING MOUNTED DEVICES IN THE SAME SPACE. IF A DEVICE'S LOCATION IS NOT CLEARLY INDICATED OR THERE IS A CONFLICT WITHIN THE CONTRACT DOCUMENTS NOTIFY ARCHITECT FOR CLARIFICATION PRIOR TO INSTALLATION.
- LOCATION OF WALL AND FLOOR MOUNT DEVICES IS DIAGRAMMATIC AND SHOWN FOR CLARITY. REFER TO ARCHITECTURAL ELEVATIONS FOR EXACT LOCATION OF DEVICES. WHERE NOT INDICATED ON ARCHITECT'S PLAN COORDINATE WITH ARCHITECT PRIOR TO INSTALLATION.
- 4. AT EXTERIOR LOCATIONS AND IN SPACES WITH EXPOSED STRUCTURE EXPOSED UTILITIES (INCLUDING PIPING, DUCTWORK, RACEWAYS, ETC.) SHALL BE INSTALLED NEATLY, BUNDLED TOGETHER TO EXTENT POSSIBLE AND RUN AT RIGHT ANGLES TO BUILDING LINES. THESE UTILITIES SHALL BE PAINTED TO MATCH ADJACENT SURFACE OR AS DIRECTED BY ARCHITECT. HANGERS, STEEL SHAPES AND SLOTTED STEEL SUPPORTS SHALL BE PAINTED TO MATCH RACEWAY OR AS DIRECTED BY ARCHITECT. TO EXTENT POSSIBLE CONTRACTOR SHALL AVOID EXPOSED RACEWAYS BY INSTALLING UTILITIES BELOW GRADE, IN WALL, OR ABOVE ADJACENT CONCEALED CEILING SPACES.
- PROVIDE ACCESS PANELS IN CEILING WHERE ANY DEVICE OR EQUIPMENT REQUIRING SERVICE (INCLUDING DAMPERS, VALVES, JUNCTION BOXES, CONTROLLERS, SMOKE DETECTORS, ETC.) IS LOCATED ABOVE OR BEHIND AN INACCESSIBLE CEILING OR WALL. ACCESS PANELS IN RATED CONSTRUCTION SHALL BEAR APPROPRIATE UL LABEL. COORDINATE LOCATION AND TYPE OF ACCESS PANEL WITH ARCHITECT PRIOR TO INSTALLATION.
- 6. PROVIDE CONCRETE HOUSEKEEPING PAD FOR ALL FLOOR OR GROUND MOUNTED EQUIPMENT WITH #4 REBAR 6" O.C. EACH WAY AND 1" CHAMFERED TOP EDGE. PADS ON CONCRETE SLAB SHALL BE 4" HIGH AND DOWELED INTO SLAB WITH #4 REBAR EXTENDING 2" INTO PAD, 3" INTO SLAB AND EPOXIED IN PLACE AND SPACED 12" O.C. AROUND PERIMETER OF PAD. PADS ON EARTH SHALL BE MINIMUM 6" THICK AND LAYED OUT TO EXTEND A MINIMUM OF 4" ABOVE GRADE AT HIGHEST GRADE LEVEL; COMPACT EARTH BELOW PAD PRIOR TO PAD CONSTRUCTION.

PLUMBING GENERAL NOTES

- 1. FLOOR DRAIN BODY SHALL BE SET SO STRAINER CAN BE ADJUSTED TO MINIMUM -1/4" BELOW TOP OF SLAB AND SET IN LOWEST POINT OF FLOOR SLAB. REMOVE MINIMUM OF 4'-0" x 4'-0" SQUARE OF CONCRETE SLAB AROUND DRAIN CENTER POINT AND POUR NEW 1ST LIFT OF CONCRETE UP TO CLAMPLING FLANGE AND THEN FINISH WITH TOPPING. SLOPE TOPPING AT MINIMUM 1/8" PER FOOT TO DRAIN. INSTALL WATERPROOF MEMBRANE BENEATH TOPPING AND SECURE IN DRAIN BODY CLAMPING FLANGE. ADJUST DRAIN STRAINER TOP TO BE FLUSH WITH LOWEST POINT OF NEW TOPPING. AFTER INSTALLATION CONTRACTOR SHALL CONFIRM WATER WILL FLOW FREELY TO DRAIN WITH NO PONDING ON FINISHED ELOOP.
- 2. PROVIDE WATER SUPPLY ISOLATION VALVES AT EACH BRANCH CONNECTION AND FOR EACH BATHROOM GROUP. LOCATE VALVES SO ACCESSIBLE OR PROVIDE ACCESS PANEL IN CEILING.
- 3. PROVIDE IDENTIFICATION STICKERS (1/2" ROUND) ON GRID WHERE VALVES ARE LOCATED ABOVE ACCESSIBLE CEILINGS.
- 4. PROVIDE ELECTRONIC TRAP PRIMER ASSEMBLY WHERE INDICATED; ELSEWHERE PROVIDE PRESSURE ACTIVATED TRAP PRIMER VALVES.

PLUMBING KEYNOTES

- (1) 1/2" HWS AND CWS BRANCH LINES DOWN IN AND ROUTED THROUGH WALL TO FIXTURES.
- 2 SERVICE ENTRANCE SEE DETAIL A/P501. PROVIDE SINGLE PIECE BUILDING RISER SEE SPECIFICATION SECTION 221116 "DOMESTIC WATER PIPING"
- 3 SKID MOUNTED DUPLEX BOOSTER PUMP AND HYDRO-PNEUMATIC TANK SEE DETAIL A/P501 & B/P503.
- PROVIDE ELECTRONIC TRAP-SEAL PRIMER SYSTEM; PRECISION PLUMBING PRODUCTS PTS-x-500 OR APPROVED EQUAL FOR FLOOR DRAINS IN RESTROOMS AND MECHANICAL ROOMS. ROUTE TUBING ANEALED COPPER TUBING BELOW FLOOR TO EACH FLOOR DRAIN IN AREA.
- 3-INCH INDIRECT WASTE FUNNEL WITH INTEGRAL BACKWATER VALVE FOR CONDENSATE DISCHARGE. ZURN Z325 OR APPROVED EQUAL. SEE DETAIL F/P501.
- 6 ENCASE BELOW SLAB GAS PIPING IN GALVANIZED STEEL SLEEVE. SEAL ANNULAR OPENINGS ON BOTH ENDS ABOVE GRADE AND VENT ENCASEMENT TO EXTERIOR OF BUILDING. SEE DETAIL A/P503.
- (7) OVERFLOW ROOF DRAIN DOWNSPOUT NOZZLE SEE DETAIL J/P501. COORDINATE EXACT PLACEMENT AND ELEVATION ABOVE FINISHED FLOOR WITH ARCHITECT PRIOR TO INSTALLATION.
- 8 PROVIDE GAS SERVICE MAIN VALVE, REGULATOR (0.5 PSIG OUTLET), METER AND POUR 4" HIGH CONCRETE PAD BELOW ABOVE GRADE PIPING AND APPURTENANCES SEE DETAIL C/P501. COORDINATE WITH SERVICE UTILITY PROVIDER FOR SPECIFIC REQUIRMENTS.
- 9 PROVIDE POTABLE SERVICE AWWA BUTTERFLY VALVE INSIDE 24"x24" IN-GRADE TIER 22 POLYMER CONCRETE, OPEN BOTTOM VALVE BOX. MARKING ON LINE SHALL READ "WATER SERVICE". OLDCASTLE POLYMER; 2424 OR APPROVED EQUAL. SEE DETAIL C/P503.
- 20 GALLON ELECTRIC WATER HEATER, SHELF MOUNTED ABOVE MOP SINK WITH EXPANSION TANK AND THERMOSTATIC MIXING VALVE. SEE DETAIL A/P502.
- 40 GALLON ELECTRIC WATER HEATER, FLOOR MOUNTED WITH EXPANSION TANK, RECIRC PUMP AND THERMOSTATIC MIXING VALVE. SEE DETAIL B/P502.
- PROVIDE 18" SQUARE CATCH BASIN WITH GRATE AND 6" OUTLET TO RECEIVE DISCARGE FROM ELEVATOR SUMP FORCE MAIN. TURN FORCE MAIN UP 12" ABOVE GRADE AND ELBOW DOWN TO DISCHARGE OVER GRATE WITH MINIMUM 2" AIR GAP.
- (13) OIL SPOTTER FOR ELEVATOR SUMP PUMP SEE DETAIL C/P502
- (14) GROUND HYDRANT IN 12"x12" CONCRETE PAD. ZURN; Z1360XL OR APPROVED EQUAL.
- PROVIDE 3/4" BALL VALVE INSIDE 18x10 IN-GRADE TIER 22 POLYMER CONCRETE OPEN BOTTOM VALVE BOX. MARKING ON LID SHALL READ "WATER SERVICE". OLDCASTLE POLYMER; 1118 OR APPROVED EQUAL. SEE DETAIL C/P503.
- (16) STUB 3/8" SUPPLY THROUGH WALL WITH ESCUTCHEON AND SUPPLY STOP FOR COFFEE MACHINE.
- PROVIDE DUAL OUTLET SUPPLY STOP AT SINK. EXTEND 3/8" THROUGH HIGH FLOW FILTRATION SYSTEM IN BASE CABINET TO ICE MACHINE. 3M; ICE160-S OR APPROVED EQUAL.
- (18) GAS SHUT-OFF WITH CAST IRON ROADWAY VALVE BOX




ARCHITECTURE
PLANNING INTERIORS
GRAPHICS

ELLIOTT MARSHALL INNES P.A. (EMI architects)
251 E. 7TH AVENUE TALLAHASSEE FL 32303
(850) 222 - 7442
www.emiarch.com
LICENSE #s AA C000409 IB C000153

NOIE:

11" x 17" SHEETS ARE PLOTTED AT 1/2

THE SCALE NOTED ON THESE DRAWINGS

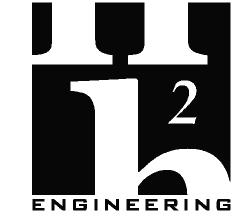

H2E PROJECT No. 17-17
114 EAST 5th AVENUE TALLAHASSEE, FL
32303 PHONE 850.224.7922
www.H2Engineering.com
THIS DOCUMENT IS THE PROPERTY OF H2Engineering.ND IS PREPARED AS AN INSTRUMENT OF SERVICE. I

AND IS PREPARED AS AN INSTRUMENT OF SERVICE. ITS USE, REUSE OR REPRODUCTION, EXCEPT BY WRITTEN AGREEMENT WITH H2Engineering, IS PROHIBITED. Florida Registry #2485

Jeffrey L. Tyler, P.E. #57093
Jeffrey Lee Tyler, State of Florida,

Professional Engineer, License No. 57093

This item has been digitally signed and sealed

indicated here.

Printed copies of this document are not considered signed and sealed, and the

signature must be verified on any electronic

by Jeffrey Lee Tyler, P.E. on the date

copies.

Date: 02/10/2025

WCSD EDUCATIONAL ANCILLARY FACILITIES -DISTRICT OFFICE

RECEIVED
ALLSTATE CONSTRUCTION
02-13-2025

DATE DESCRIPTION

1 2/11/2025 ADDENDUM #1

ROJEC	T PHASE			
CONSTRUCTION DOCUMENTS				
ATE DRAWN BY				+
ID JANU	JARY 2025		JDR	

CHECKED BY


JLT

SECOND FLOOR PLAN NORTH

PROJECT NO

SHEET TITLE

P102-N

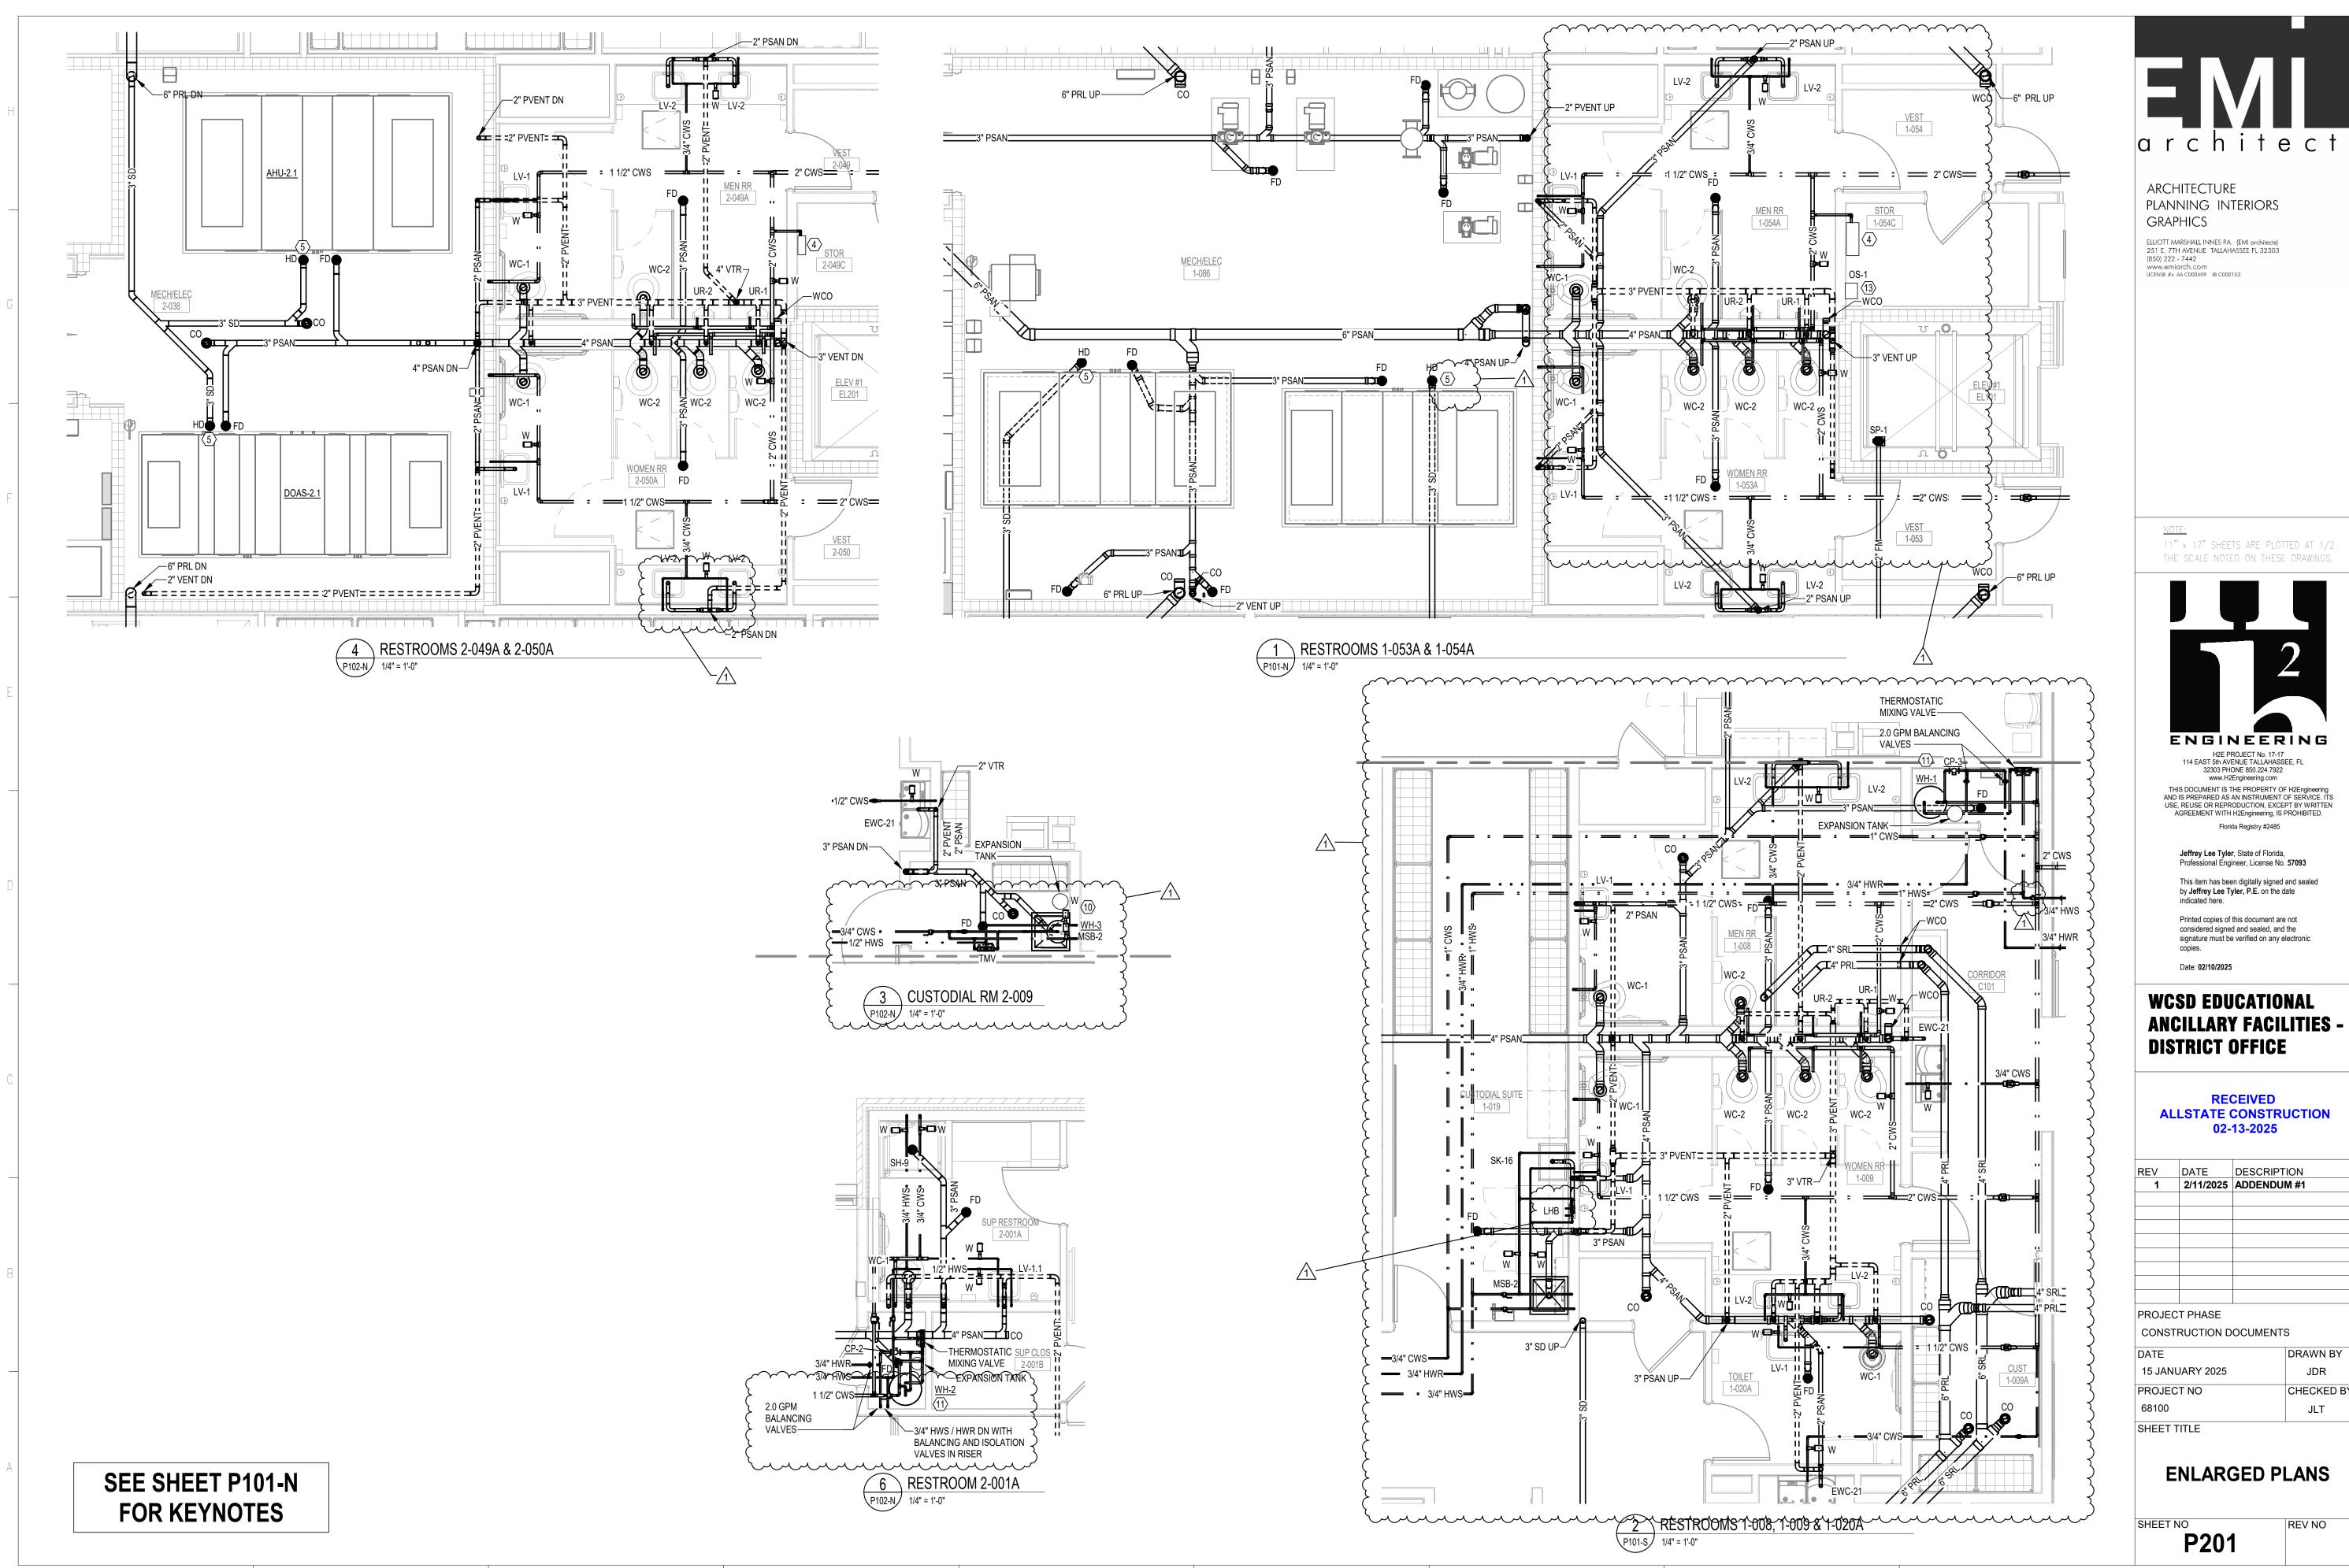

DRAWN BY

JDR

CHECKED BY

JLT


GAS PIPE SCHEDULE

0, 10 1 1	001100								
PIPE SECTION	FUEL GAS TYPE	PIPE MATERIAL	CAPACITY (MBH)	DESIGN PRESSURE	EQUIPMENT	PIPE LENGTH (FT)	EQUIV. LENGTH FOR FITTINGS (FT)	TOTAL LENGTH (FT)	PIPE SIZE (IN)
1	NATURAL GAS	STEEL (SCH 40)	3,000	3 PSI		400	41	441	2
1.1	NATURAL GAS	STEEL (SCH 40)	1,500	3 PSI		100	17	117	1 1/4
2	NATURAL GAS	STEEL (SCH 40)	1,500	7 IN WC	Boiler	40	45	85	2 1/2
NOTEC:						-	-		

GAS PIPING SIZED USING LONGEST LENGTH METHOD FROM POINT OF DELIVERY TO EITHER REGULATOR OR APPLIANCE.

SEE FLORIDA BUILDING CODE - FUEL GAS TABLES: 402.4(6), 402.4(2)

MAIN GAS SHUT-OFF VALVE-MINIMUM 6" DIRT LEG-1ST STAGE REGULATOR 1500 MBH; .5 PSIG OUTLET PRESSURE-UTILITY METER-

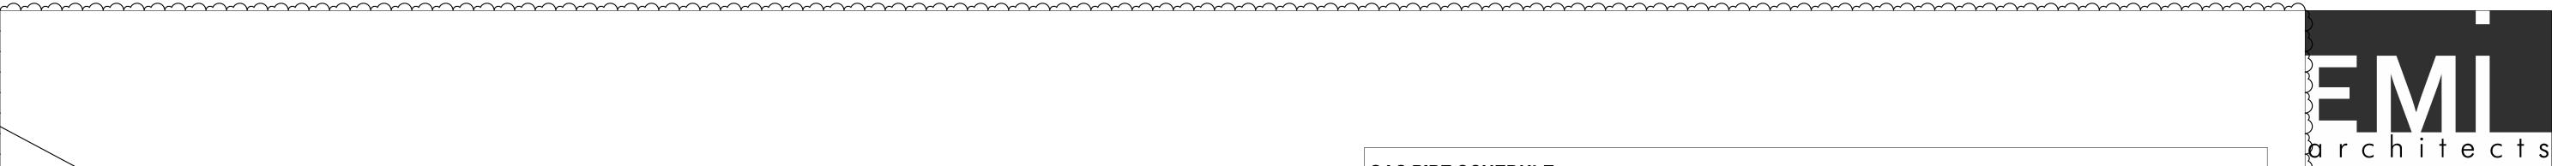

ARCHITECTURE PLANNING INTERIORS

GRAPHICS ELLIOTT MARSHALL INNES P.A. (EMI architects)
251 E. 7TH AVENUE TALLAHASSEE FL 32303
(850) 222 - 7442
www.emiarch.com
LICENSE #s AA C000409 IB C000153

> 11" x 17" SHEETS ARE PLOTTED AT 1/2 THE SCALE NOTED ON THESE DRAWINGS.



www.H2Engineering.com THIS DOCUMENT IS THE PROPERTY OF H2Engineering
AND IS PREPARED AS AN INSTRUMENT OF SERVICE. ITS
USE, REUSE OR REPRODUCTION, EXCEPT BY WRITTEN
AGREEMENT WITH H2Engineering, IS PROHIBITED.

Florida Registry #2485

Jeffrey L. Tyler, P.E. #57093 Jeffrey Lee Tyler, State of Florida, Professional Engineer, License No. 57093

This item has been digitally signed and sealed by Jeffrey Lee Tyler, P.E. on the date

Printed copies of this document are not considered signed and sealed, and the signature must be verified on any electronic

Date: 02/10/2025

WCSD EDUCATIONAL SANCILLARY FACILITIES -DISTRICT OFFICE

RECEIVED
ALLSTATE CONSTRUCTION
02-13-2025


ζ		
REV	DATE	DESCRIPTION
1	2/11/2025	ADDENDUM #1
)		
(
<i>)</i>		
}		
		
<u> </u>		
ROJEC	T PHASE	
CONSTI	RUCTION D	OCUMENTS

DRAWN BY)15 JANUARY 2025 JDR PROJECT NO CHECKED BY JLT SHEET TITLE

GAS SUPPLY RISER

REV NO P300

-SERVICE LINE

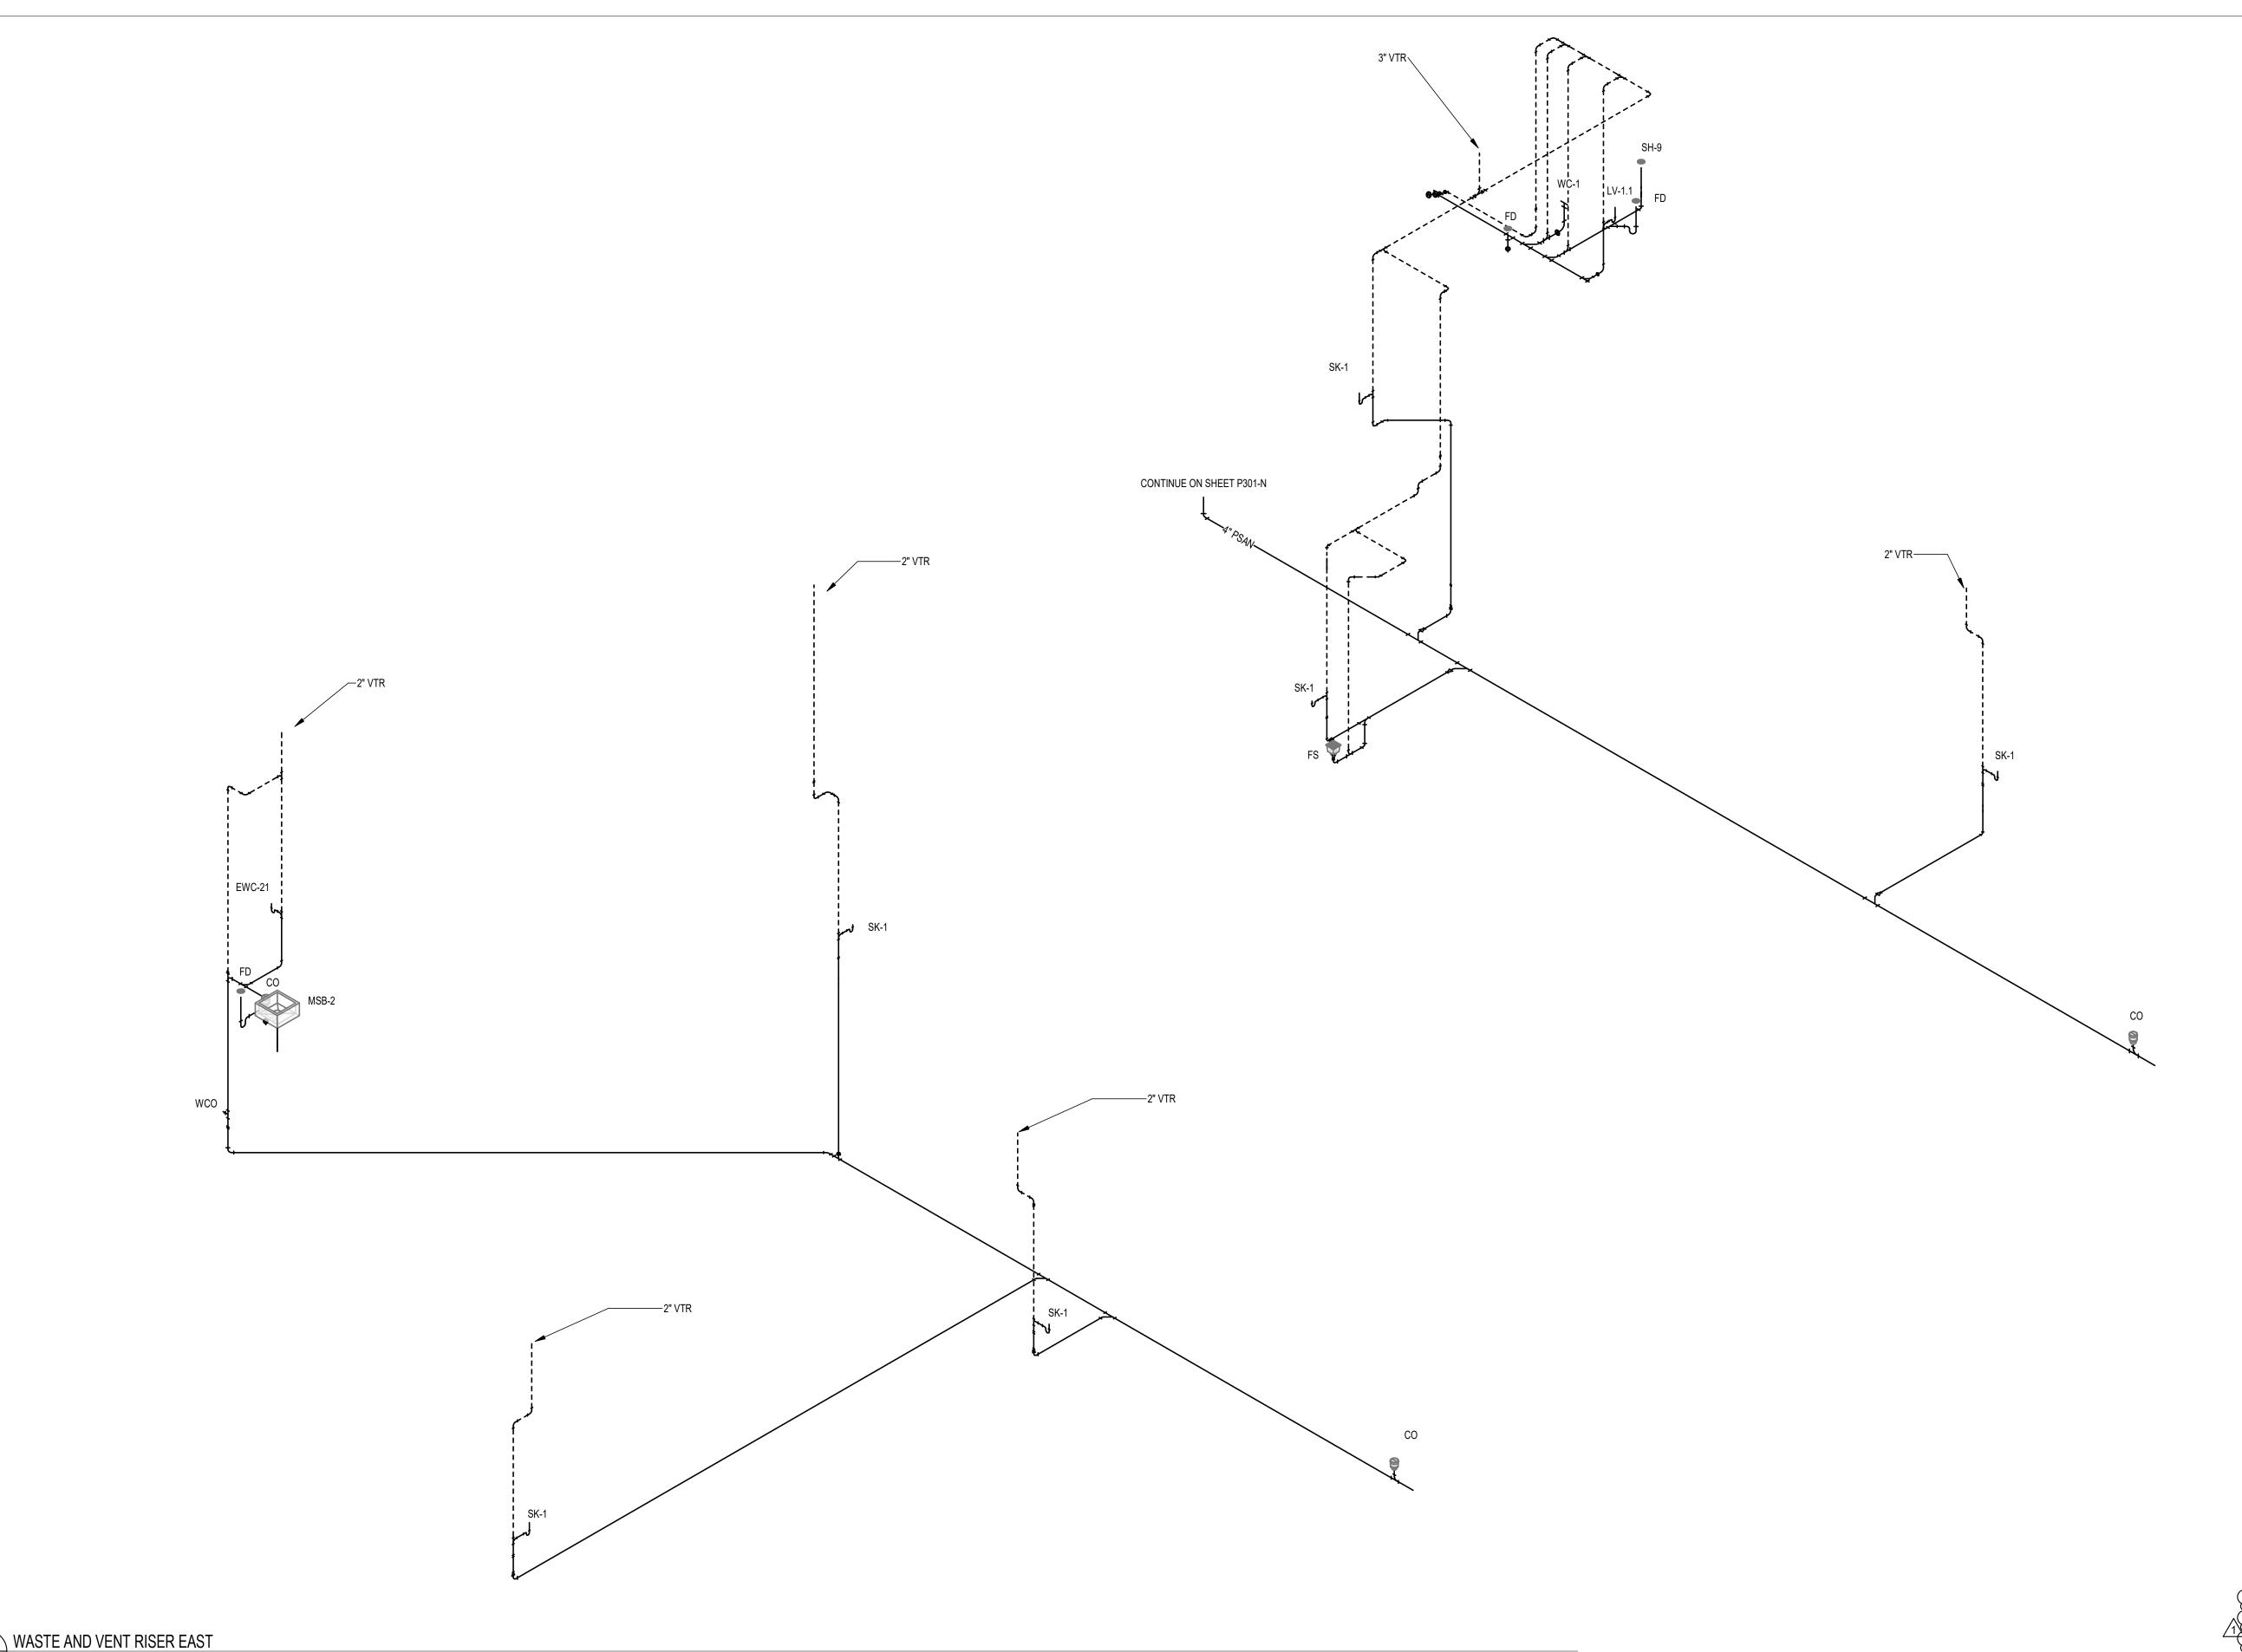



ELLIOTT MARSHALL INNES P.A. (EMI architects)
251 E. 7TH AVENUE TALLAHASSEE FL 32303
(850) 222 - 7442
www.emiarch.com
LICENSE #s AA C000409 IB C000153

NOTE: 11" x 17" Sheets are plotted at 1/2 THE SCALE NOTED ON THESE DRAWINGS.



THIS DOCUMENT IS THE PROPERTY OF H2Engineering
AND IS PREPARED AS AN INSTRUMENT OF SERVICE. ITS
USE, REUSE OR REPRODUCTION, EXCEPT BY WRITTEN
AGREEMENT WITH H2Engineering, IS PROHIBITED.

Florida Registry #2485 Jeffrey L. Tyler, P.E. #57093

Jeffrey Lee Tyler, State of Florida, Professional Engineer, License No. **57093**

This item has been digitally signed and sealed by **Jeffrey Lee Tyler**, **P.E.** on the date

Printed copies of this document are not considered signed and sealed, and the signature must be verified on any electronic

Date: 02/10/2025


WCSD EDUCATIONAL ANCILLARY FACILITIES -DISTRICT OFFICE

RECEIVED
ALLSTATE CONSTRUCTION
02-13-2025

REV	DATE	DESCRIPTION
1	2/11/2025	ADDENDUM #1
PROJE	CT PHASE	
CONC	TOLICTION D	COLIMENTO

CONSTRUCTION DOCUMENTS DRAWN BY 15 JANUARY 2025 JDR PROJECT NO CHECKED BY JLT SHEET TITLE

WASTE AND VENT RISER

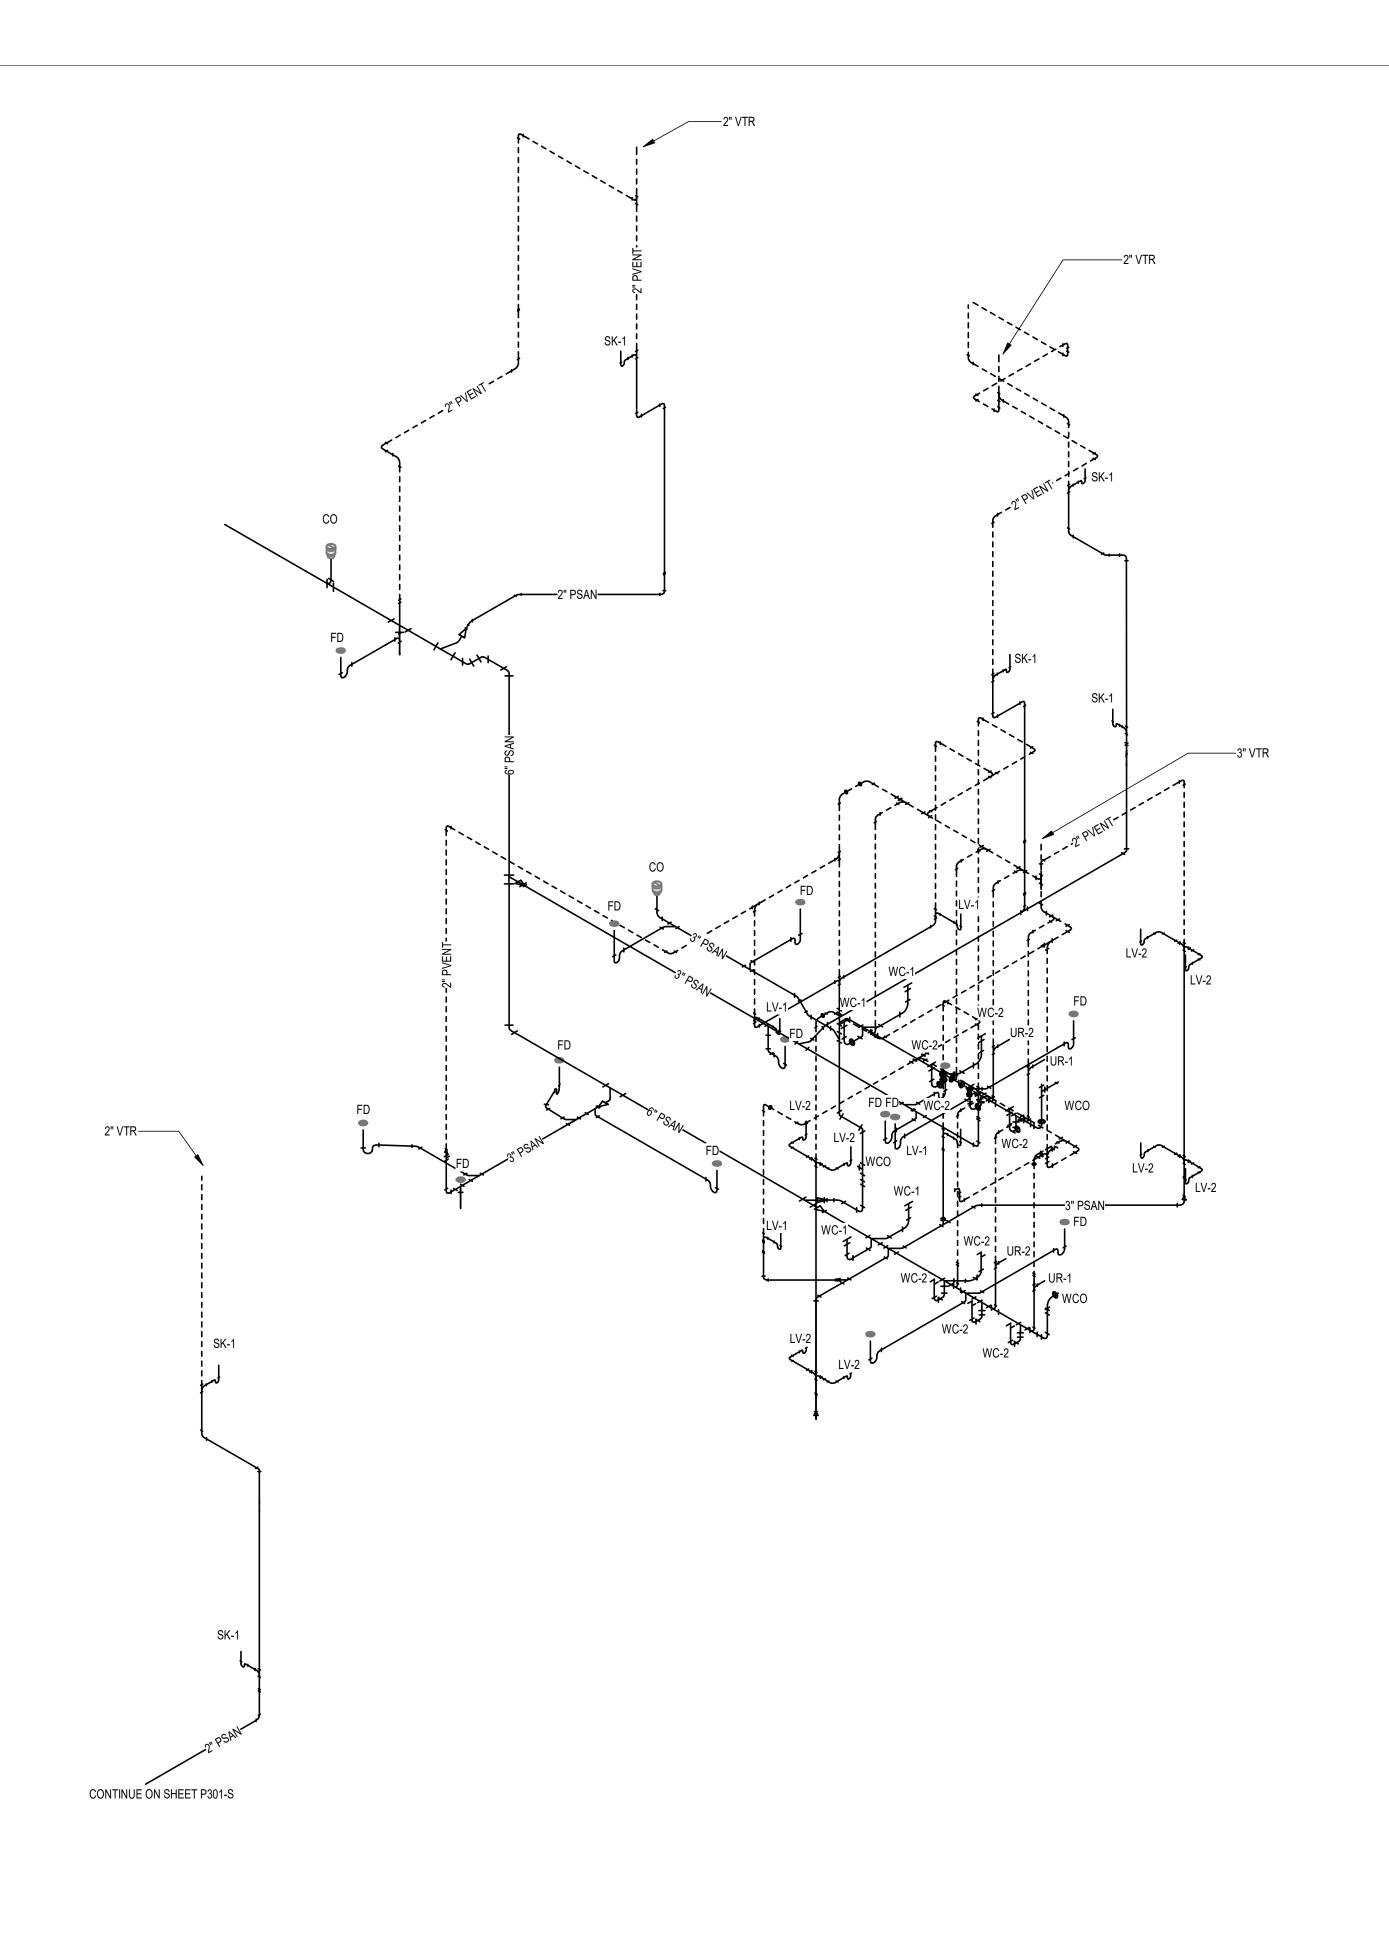



ELLIOTT MARSHALL INNES P.A. (EMI architects)
251 E. 7TH AVENUE TALLAHASSEE FL 32303
(850) 222 - 7442
www.emiarch.com
LICENSE #s AA C000409 IB C000153

NOTE:
11" x 17" SHEETS ARE PLOTTED AT 1/2 THE SCALE NOTED ON THESE DRAWINGS.



THIS DOCUMENT IS THE PROPERTY OF H2Engineering
AND IS PREPARED AS AN INSTRUMENT OF SERVICE. ITS
USE, REUSE OR REPRODUCTION, EXCEPT BY WRITTEN
AGREEMENT WITH H2Engineering, IS PROHIBITED. Florida Registry #2485

Jeffrey L. Tyler, P.E. #57093

Jeffrey Lee Tyler, State of Florida, Professional Engineer, License No. **57093**

This item has been digitally signed and sealed by **Jeffrey Lee Tyler**, **P.E.** on the date

Printed copies of this document are not considered signed and sealed, and the signature must be verified on any electronic

Date: 02/10/2025

CONTINUE ON SHEET P301-E

WCSD EDUCATIONAL ANCILLARY FACILITIES -DISTRICT OFFICE

RECEIVED
ALLSTATE CONSTRUCTION
02-13-2025

REV	DATE	DESCRIPTION
1	2/11/2025	ADDENDUM #1
PROJE	CT PHASE	
	•	
CONS	TRUCTION D	OCUMENTS

DRAWN BY 15 JANUARY 2025 JDR PROJECT NO CHECKED BY JLT SHEET TITLE


WASTE AND VENT RISER

1 WASTE AND VENT RISER NORTH



ELLIOTT MARSHALL INNES P.A. (EMI architects)
251 E. 7TH AVENUE TALLAHASSEE FL 32303
(850) 222 - 7442
www.emiarch.com
UCENSE #s AA C000409 IB C000153

NOTE: 11" x 17" SHEETS ARE PLOTTED AT 1/2 THE SCALE NOTED ON THESE DRAWINGS.

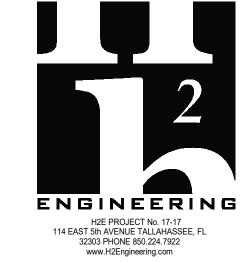

THIS DOCUMENT IS THE PROPERTY OF H2Engineering
AND IS PREPARED AS AN INSTRUMENT OF SERVICE. ITS
USE, REUSE OR REPRODUCTION, EXCEPT BY WRITTEN
AGREEMENT WITH H2Engineering, IS PROHIBITED.

Florida Registry #2485

Jeffrey L. Tyler, P.E. #57093 **Jeffrey Lee Tyler**, State of Florida, Professional Engineer, License No. **57093**

This item has been digitally signed and sealed by **Jeffrey Lee Tyler**, **P.E.** on the date indicated here.

Printed copies of this document are not considered signed and sealed, and the signature must be verified on any electronic

Date: 02/10/2025

WCSD EDUCATIONAL ANCILLARY FACILITIES -DISTRICT OFFICE

RECEIVED
ALLSTATE CONSTRUCTION
02-13-2025

REV	DATE	DESCRIPTION
1	2/11/2025	ADDENDUM #1
PROJEC	T PHASE	

CONSTRUCTION DOCUMENTS

CONSTRUCTION DOCUMENTS	5
DATE	DRAWN BY
15 JANUARY 2025	JDR
PROJECT NO	CHECKED
68100	JLT
SHEET TITLE	

WASTE AND VENT RISER

P301-S

1 WASTE AND VENT RISER SOUTH

SK-1



ELLIOTT MARSHALL INNES P.A. (EMI architects)
251 E. 7TH AVENUE TALLAHASSEE FL 32303
(850) 222 - 7442
www.emiarch.com
LICENSE #s AA C000409 IB C000153

NOTE: 11" x 17" SHEETS ARE PLOTTED AT 1/2 THE SCALE NOTED ON THESE DRAWINGS.



THIS DOCUMENT IS THE PROPERTY OF H2Engineering
AND IS PREPARED AS AN INSTRUMENT OF SERVICE. ITS
USE, REUSE OR REPRODUCTION, EXCEPT BY WRITTEN
AGREEMENT WITH H2Engineering, IS PROHIBITED. Florida Registry #2485 **Jeffrey L. Tyler, P.E. #57093**

Jeffrey Lee Tyler, State of Florida, Professional Engineer, License No. **57093** This item has been digitally signed and sealed by **Jeffrey Lee Tyler**, **P.E.** on the date

Printed copies of this document are not considered signed and sealed, and the signature must be verified on any electronic

Date: 02/10/2025

WCSD EDUCATIONAL ANCILLARY FACILITIES -DISTRICT OFFICE

RECEIVED
ALLSTATE CONSTRUCTION
02-13-2025

REV	DATE	DESCRIPTION
1	2/11/2025	ADDENDUM #1

CONSTRUCTION DOCUMENTS DRAWN BY JDR 15 JANUARY 2025

PROJECT NO

CHECKED BY

P302-N

1 SUPPLY RISER NORTH



ELLIOTT MARSHALL INNES P.A. (EMI architects)
251 E. 7TH AVENUE TALLAHASSEE FL 32303
(850) 222 - 7442
www.emiarch.com
UCENSE #s AA C000409 IB C000153

NOTE: 11" x 17" SHEETS ARE PLOTTED AT 1/2 THE SCALE NOTED ON THESE DRAWINGS.



THIS DOCUMENT IS THE PROPERTY OF H2Engineering
AND IS PREPARED AS AN INSTRUMENT OF SERVICE. ITS
USE, REUSE OR REPRODUCTION, EXCEPT BY WRITTEN
AGREEMENT WITH H2Engineering, IS PROHIBITED. Florida Registry #2485

Jeffrey L. Tyler, P.E. #57093

Jeffrey Lee Tyler, State of Florida, Professional Engineer, License No. **57093**

This item has been digitally signed and sealed by **Jeffrey Lee Tyler**, **P.E.** on the date

Printed copies of this document are not considered signed and sealed, and the signature must be verified on any electronic

Date: 02/10/2025

WCSD EDUCATIONAL ANCILLARY FACILITIES -DISTRICT OFFICE

RECEIVED
ALLSTATE CONSTRUCTION
02-13-2025


REV	DATE	DESCRIPTION
1	2/11/2025	ADDENDUM #1
PROJEC	T PHASE	

CONSTRUCTION DOCUMENTS DRAWN BY 15 JANUARY 2025 JDR PROJECT NO CHECKED BY

SHEET TITLE

SUPPLY RISER

P302-S

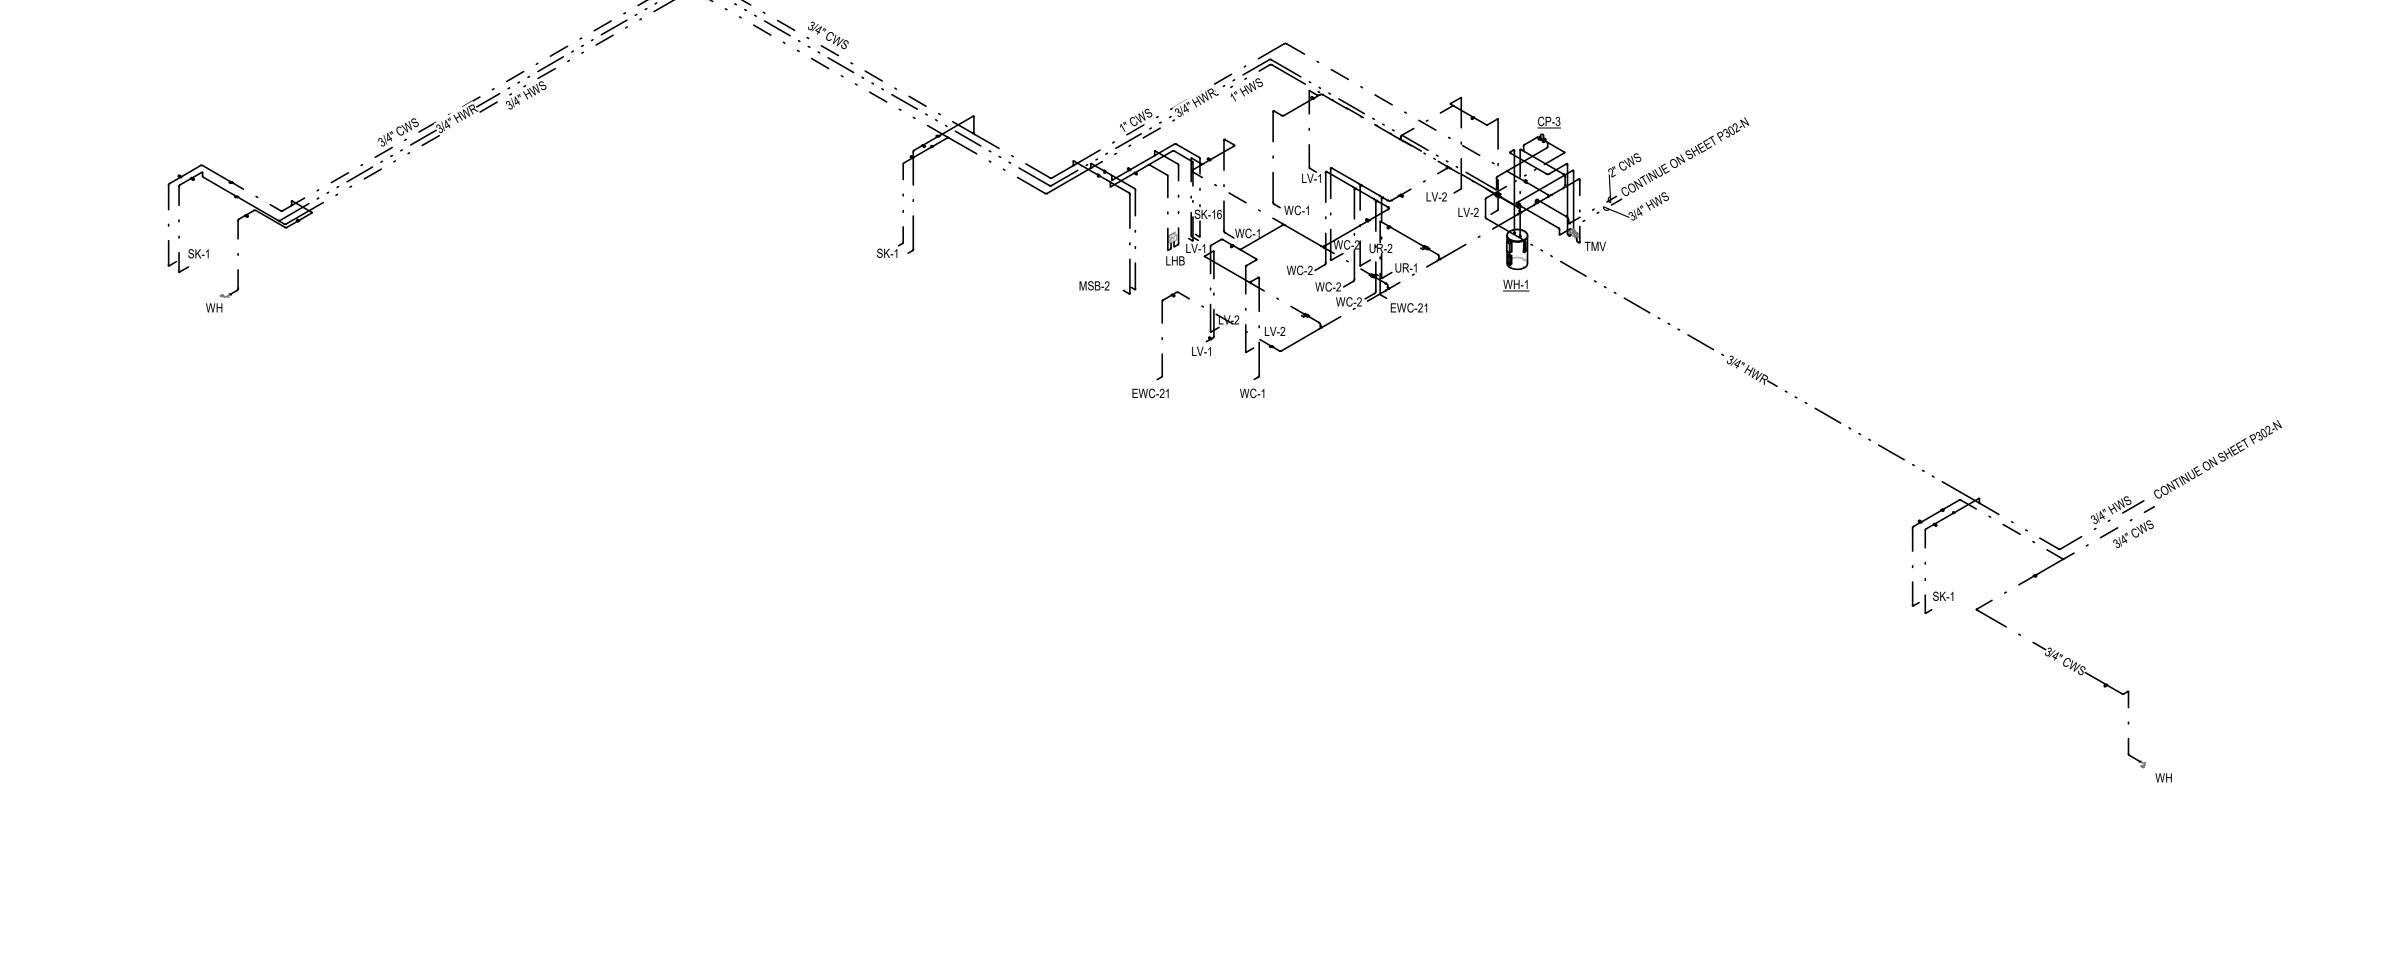



ELLIOTT MARSHALL INNES P.A. (EMI architects)
251 E. 7TH AVENUE TALLAHASSEE FL 32303
(850) 222 - 7442
www.emiarch.com
UCENSE #s AA C000409 IB C000153

NOTE:
11" x 17" SHEETS ARE PLOTTED AT 1/2 THE SCALE NOTED ON THESE DRAWINGS.



THIS DOCUMENT IS THE PROPERTY OF H2Engineering
AND IS PREPARED AS AN INSTRUMENT OF SERVICE. ITS
USE, REUSE OR REPRODUCTION, EXCEPT BY WRITTEN
AGREEMENT WITH H2Engineering, IS PROHIBITED. Florida Registry #2485

Jeffrey L. Tyler, P.E. #57093

Jeffrey Lee Tyler, State of Florida, Professional Engineer, License No. **57093**

This item has been digitally signed and sealed by **Jeffrey Lee Tyler**, **P.E.** on the date

Printed copies of this document are not considered signed and sealed, and the signature must be verified on any electronic

Date: 02/10/2025


WCSD EDUCATIONAL ANCILLARY FACILITIES -DISTRICT OFFICE

RECEIVED
ALLSTATE CONSTRUCTION
02-13-2025

REV	DATE	DESCRIPTION
1	2/11/2025	ADDENDUM #1

CONSTRUCTION DOCUMENTS DRAWN BY 15 JANUARY 2025 JDR PROJECT NO CHECKED BY JLT

SHEET TITLE STORM AND **CONDENSATE RISER**

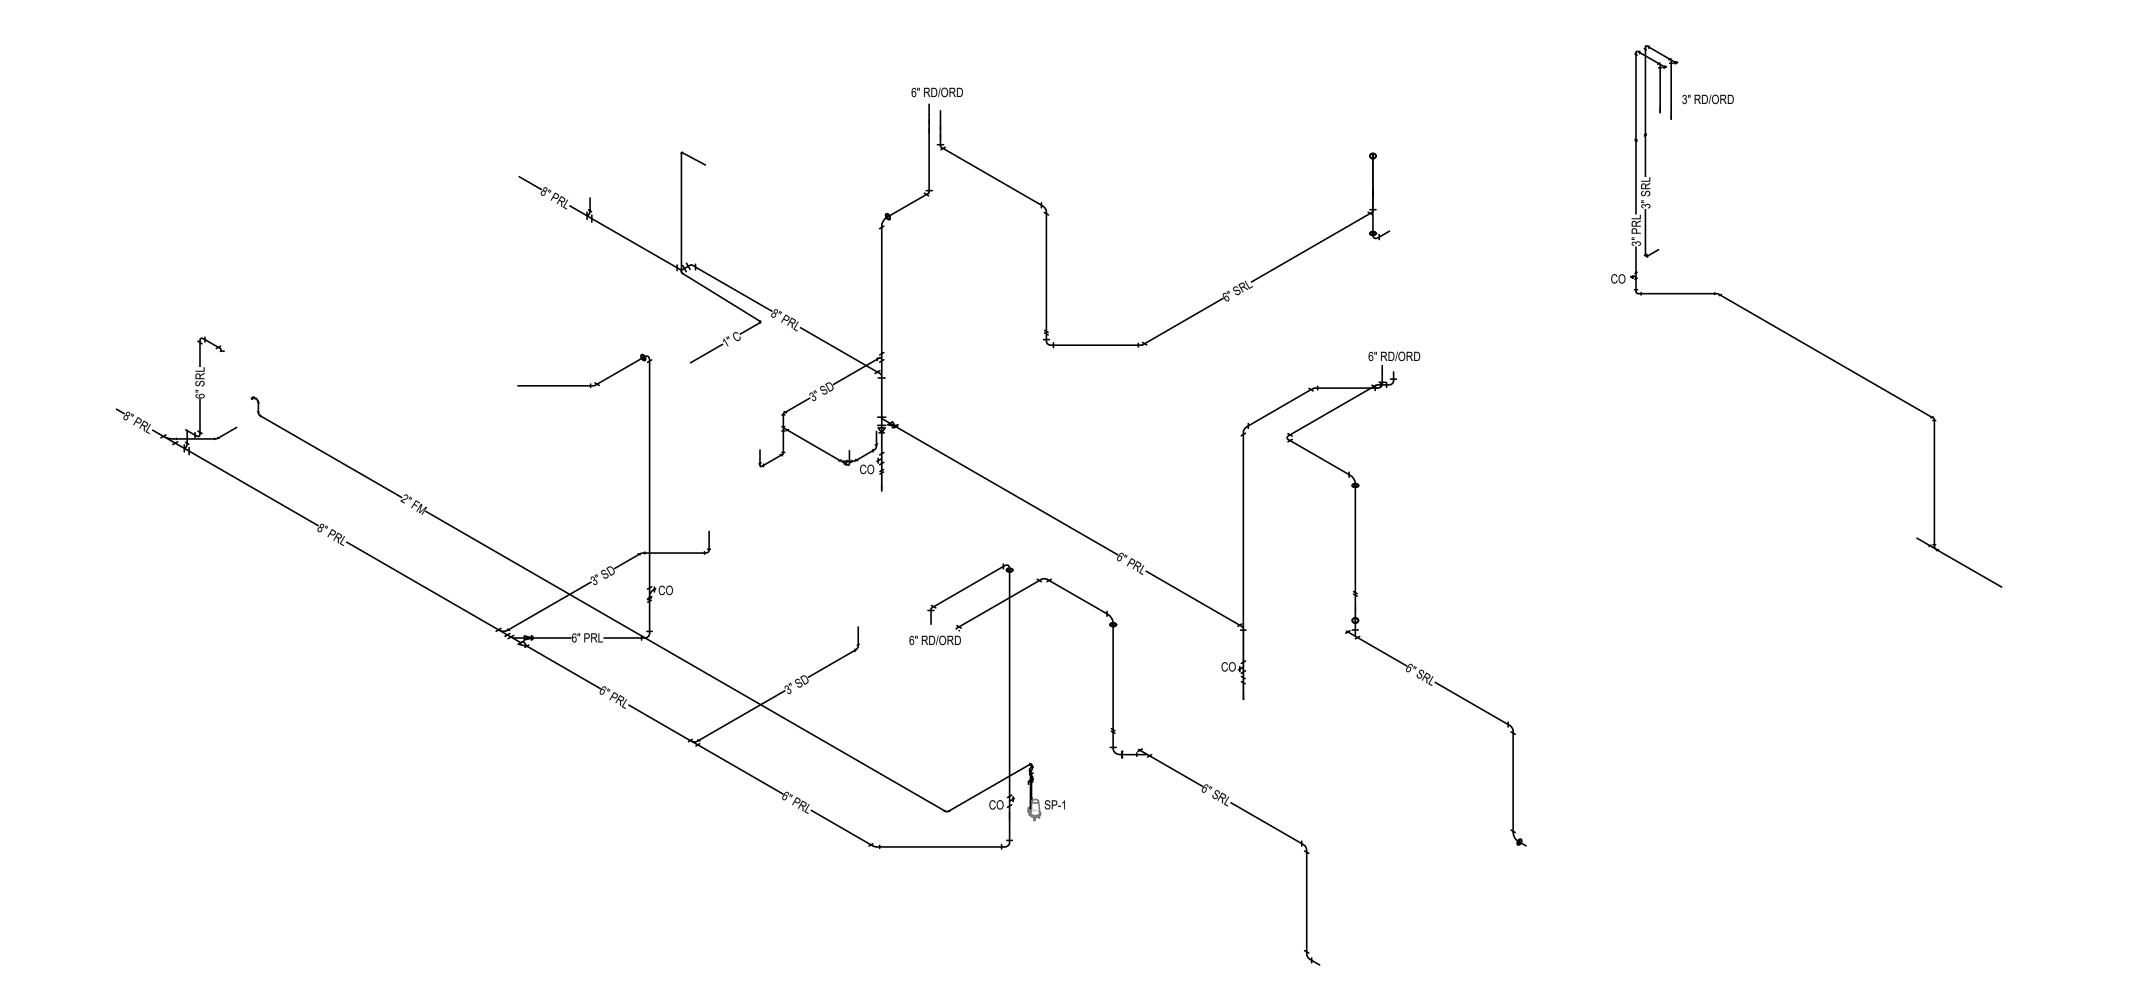



ELLIOTT MARSHALL INNES P.A. (EMI architects)
251 E. 7TH AVENUE TALLAHASSEE FL 32303
(850) 222 - 7442
www.emiarch.com
LICENSE #s AA C000409 IB C000153

NOTE: 11" x 17" SHEETS ARE PLOTTED AT 1/2 THE SCALE NOTED ON THESE DRAWINGS.

ENGINEERING

H2E PROJECT No. 17-17
114 EAST 5th AVENUE TALLAHASSEE, FL
32303 PHONE 850.224.7922
www.H2Engineering.com THIS DOCUMENT IS THE PROPERTY OF H2Engineering
AND IS PREPARED AS AN INSTRUMENT OF SERVICE. ITS
USE, REUSE OR REPRODUCTION, EXCEPT BY WRITTEN
AGREEMENT WITH H2Engineering, IS PROHIBITED.

Florida Registry #2485 Jeffrey L. Tyler, P.E. #57093

Jeffrey Lee Tyler, State of Florida, Professional Engineer, License No. **57093**

This item has been digitally signed and sealed by **Jeffrey Lee Tyler**, **P.E.** on the date

Printed copies of this document are not considered signed and sealed, and the signature must be verified on any electronic

Date: 02/10/2025

WCSD EDUCATIONAL ANCILLARY FACILITIES -DISTRICT OFFICE

RECEIVED
ALLSTATE CONSTRUCTION
02-13-2025


REV	DATE	DESCRIPTION
1	2/11/2025	ADDENDUM #1
PROJEC	T PHASE	

CONSTRUCTION DOCUMENTS DRAWN BY 15 JANUARY 2025 JDR PROJECT NO CHECKED BY JLT

> STORM AND **CONDENSATE RISER**

SHEET TITLE

P303-S

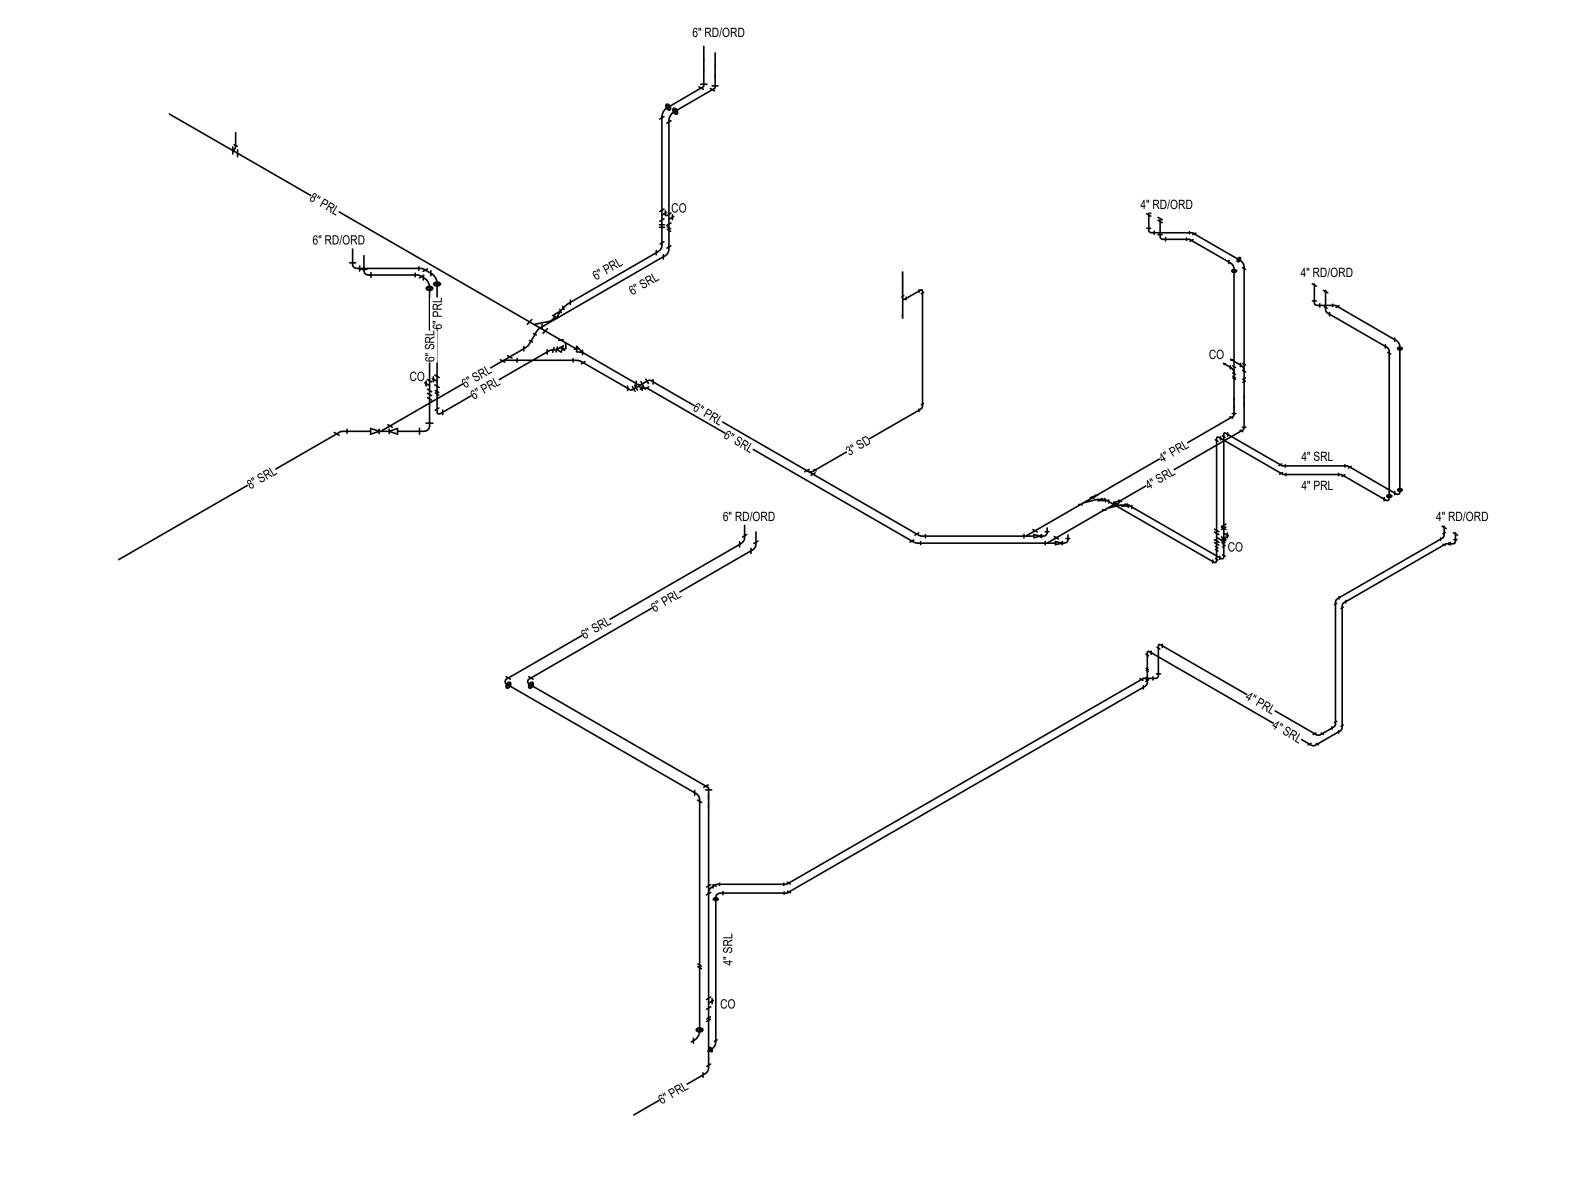

1 STORM AND CONDENSATE RISER SOUTH

PLUMBING FIXTURE SCHEDULE

FIXTURE	FIXTURE DESCRIPTION	A.D.A.	MOUNTING	HEIGHT (A.F.F.)		T	PIPE SIZES	T	MANUFACTURER AND MODEL NUMBER	ACCESSORIES
DESIGNATION	FIXTURE DESCRIPTION	COMPLIANT	METHOD	neigni (A.F.F.)	COLD WATER SUPPLY	HOT WATER SUPPLY	FIXTURE TRAP	FIXTURE DRAIN	MANUFACTURER AND MODEL NUMBER	(SEE SCHEDULE)
WC-1	FLUSH VALVE WATER CLOSET, HIGH EFFICIENCY (1.28 - 1.6 GPF), VITREOUS CHINA, SIPHON JET FLUSHING ACTION, ELONGATED RIM, 1-1/2" TOP SPUD, MIN. 2" BALLPASS TRAPWAY. COLOR: WHITE.	YES	FLOOR	RIM: 16-1/2"	1"	N/A	4"	4"	AMERICAN STANDARD: 3043.001 OR APPROVED EQUAL	SEAT-OPN-FRT FV-1.28-MAN
WC-2	FLUSH VALVE WATER CLOSET, HIGH EFFICIENCY (1.28 - 1.6 GPF), VITREOUS CHINA, SIPHON JET FLUSHING ACTION, ELONGATED RIM, 1-1/2" TOP SPUD, MIN. 2" BALLPASS TRAPWAY. COLOR: WHITE.	NO	FLOOR	RIM: 15"	1"	N/A	4"	4"	AMERICAN STANDARD: 2234.001 OR APPROVED EQUAL	SEAT-OPN-FRT FV-1.28-MAN
UR-1	FLUSH VALVE URINAL, ULTRA HIGH EFFICIENCY (0.125 - 1.0 GPF), VITREOUS CHINA, WASHOUT FLUSHING ACTION, 3/4" TOP SPUD. COLOR: WHITE.	YES	WALL	RIM: 17"	3/4"	N/A	2"	2"	AMERICAN STANDARD: 6590.001 OR APPROVED EQUAL	FV-0.125-MAN
UR-2	FLUSH VALVE URINAL, ULTRA HIGH EFFICIENCY (0.125 - 1.0 GPF), VITREOUS CHINA, WASHOUT FLUSHING ACTION, 3/4" TOP SPUD. COLOR: WHITE.	NO	WALL	RIM: 24"	3/4"	N/A	2"	2"	AMERICAN STANDARD: 6590.001 OR APPROVED EQUAL	FV-0.125-MAN
LV-1	LAVATORY, 20"x18", VITREOUS CHINA,3 FAUCET HOLES (ONE CENTERED, TWO 4" OFF CENTER), ANTI-SPLASH RIM AND HIGH BACK. COLOR: WHITE.	YES	WALL	RIM: 34"	1/2"	N/A	1-1/4"	2"	AMERICAN STANDARD: 0355.012 OR APPROVED EQUAL	FCT-LV-0.5-MTR DR-LV-C TR-LV
LV-2	LAVATORY, 19"x15"x7.5" VITREOUS CHINA, UNDER COUNTER WITH GLAZED UNDERSIDE. COLOR: WHITE.	NO	UNDER COUNTER	RIM: 31"	1/2"	N/A	1-1/4"	2"	AMERICAN STANDARD: 0497300.020 OR APPROVED EQUAL	FCT-LV-0.5-MTR DR-LV-C TR-LV
LV-1.1	LAVATORY, 20"x18", VITREOUS CHINA,3 FAUCET HOLES (ONE CENTERED, TWO 4" OFF CENTER), ANTI-SPLASH RIM AND HIGH BACK. COLOR: WHITE.	YES	WALL	RIM: 34"	1/2"	1/2"	1-1/4"	2"	AMERICAN STANDARD: 0355.012 OR APPROVED EQUAL	FCT-LV-0.5-MAN-C DR-LV-C TR-LV
SH-9	36"x36" ONE-PIECE, MOLDED REINFORCED FIBERGLASS CONSTRUCTION, SOLID SURFACE FINISH, SHOWER BASE WITH ANTI-SKID FLOOR TREATMENT, RECESSED RECEIVER FLANGES, 1" THRESHOLD. COLOR: WHITE.	YES	FLOOR	VALVE: 38" TO 48" (OPTIONAL)	1/2"	1/2"	2"	2"	COMFORT DESIGNS: SSB 3838BF OR APPROVED EQUAL	SH-TMV-FCT-HND FD-SH
SK-1	SINGLE COMPARTMENT SINK, SELF-RIMMING, 22"x19-1/2", 18"x14"x5-1/2" DEEP BOWL, 18 GAUGE TYPE 304 STAINLESS STEEL, 4 FAUCET HOLES (ONE CENTERED, TWO 4" FROM CENTER, ONE 8" FROM CENTER), SOUND DEADENING COATING ON BOTTOM OF SINK.	YES	COUNTER TOP	SEE ARCH. PLANS	1/2"	1/2"	1-1/2"	2"	ELKAY: LRAD221955-4 OR APPROVED EQUAL	FCT-SK-1.5-GEN DR-SK-STD TR-SK-STD
SK-2	SINGLE COMPARTMENT SINK, SELF-RIMMING, 22"x19-1/2", 18"x14"x10-1/8" DEEP BOWL, 18 GAUGE TYPE 304 STAINLESS STEEL, 4 FAUCET HOLES (ONE CENTERED, TWO 4" FROM CENTER, ONE 8" FROM CENTER), SOUND DEADENING COATING ON BOTTOM OF SINK.	NO	COUNTER TOP	SEE ARCH. PLANS	1/2"	1/2"	1-1/2"	2"	ELKAY: DLR221910-4 OR APPROVED EQUAL	FCT-SK-1.5-GEN DR-SK-STD TR-SK-STD
LHB	LAUNDRY HOOK-UP BOX, 20 GAUGE STEEL, WHITE POWDER-COATED, ALL WELDED WATER TIGHT CONSTRUCTION, TOP MOUNT HOT AND COLD WATER SUPPLY VALVES WITH 5/8" COPPER SWEAT INLETS AND 3/4" COMPRESSION OUTLETS. 2" DRAIN AND WATER HAMMER ARRESTERS.	N/A	WALL RECESSED	-	1/2"	1/2"	2"	2"	GUY GRAY: T200TPPVCCHA OR APPROVED EQUAL	uuuuu
SK-16	SINGLE COMPARTMENT LAUNDRY SINK, 23"x22", 20-1/4"x 17-1/4" X 13" DEEP BOWL, PLASTIC, 2 FAUCET HOLES 4" OFF CENTER, BAKED ENAMEL ANGLE LEGS.	NO	FLOOR	RIM: 33-1/2"	1/2"	1/2"	1-1/2"	2"	FIAT: FL-1 OR APPROVED EQUAL	FCT-SK-2.0-LAB DR-SK-STD TR-SK-STD
MSB-2	MOP SERVICE SINK BASIN, 24"L x 24"W x 12"H, WITH 2" WIDE SHOULDERS, 1/4" PITCH TOWARD INSIDE, PRECAST TERRAZZO (MINIMUM 3,000 PSI @ 7 DAYS), SURFACE GROUND AND POLISHED WITH ALL HOLES AND PITS GROUTED AND WITH EXCESS REMOVED. COLOR: BLACK & WHITE MARBLE CHIPS IN GRAY PORTLAND CEMENT.	NO	FLOOR		1/2"	1/2"	3"	3"	FIAT: TSB-200 OR APPROVED EQUAL	FCT-MSB RMGD-MSB HOSE-MSB HGR-MSB
EWC-21	ELECTRIC WATER COOLER WITH BOTTLE FILLING STATION, FILTERED, BARRIER-FREE, TYPE 304 STAINLESS STEEL BASIN, BRUSHED FINISH, VANDAL-RESISTANT BUBBLER, STAINLESS STEEL CABINET AND CANE APRON, LEAD-FREE WATERWAYS, SELF CONTAINED SYSTEM (R-134A REFRIGERANT) DELIVERS MIN. 8 GPH OF 50°F WATER @ 80°F. INLET WATER AND 90°F AMBIENT AIR, 120V/1PH. BOTTLE FILLING STATION: ELECTRONIC SENSOR ACTIVATED WITH AUTOMATIC 20-SECOND SHUT-OFF TIMER AND BOTTLE COUNTER. DELIVERS MIN. 1 GPM FLOW RATE WITH LAMINAR FLOW. ANTI-MICROBIAL PLASTIC COMPONENTS.	YES	WALL SURFACE	SPOUT: 38" / 32"	1/2"	N/A	1-1/4"	2"	ELKAY: LZSTLG8WSSK / LKAPREZL OR APPROVED EQUAL	
WH	EXTERIOR WALL HYDRANT, NON-FREEZE, ANTI-SIPHON, AUTOMATIC DRAINING, WITH INTEGRAL BACKFLOW PREVENTER, ALL BRONZE INTERIOR PARTS, 3/4" INLET, 3/4" HOSE THREAD OUTLET, INLET ELBOW, WALL CLAMP, POLISHED BRONZE FACE AND OPERATING KEY.	N/A	EXPOSED		3/4"	N/A	N/A	N/A	ZURN; Z1310-PB-WC-34UN OR APPROVED EQUAL	
IMB	ICE MAKER HOOK-UP BOX, 20 GAUGE STEEL, WHITE POWDER-COATED, ALL WELDED WATER TIGHT CONSTRUCTION, COLD WATER SUPPLY VALVE WITH 1/2" COPPER SWEAT INLET AND 1/4" COMPRESSION OUTLET AND WATER HAMMER ARRESTER.	N/A	WALL RECESSED	-	1/2"	N/A	N/A	N/A	GUY GRAY: MIB1HAAB OR APPROVED EQUAL	


DOMES	TIC WATER BOOSTER PUMP	See A	Alternate		
DESIGNATION			BP - 1		
	CAPACITY	GPM	128		
	MINIMUM SUCTION PRESSURE	PSIG	33		
	DISCHARGE PRESSURE	PSIG	53		
	MAXIMUM BOOSTER SYSTEM LOSS	PSI	5		
	SURPLUS PRESSURE	PSI	5		
	ELECTRICAL CHARACTERISTICS	V / PH	208 / 3		
	MCA / MOCP	AMPS - AMPS	19 - 30		
	MANUFACTURER		VC SYSTEMS		
	MODEL		PMC		
PUMPS					
	QUANTITY		2		
	CAPACITY SPLIT	LEAD / LAG	65 / 65		
	PUMP DIFFERENTIAL PRESSURE	FT	57		
	EFFICIENCY	%	65		
	SHUT-OFF PRESSURE	FT	62		
	SPEED	RPM	3,500		
	MOTOR HORSEPOWER	HP	2		
	IMPELLER DIAMATER	IN.	5.0		
	VFD		YES		
	PUMP SEAL		CERAMIC		
	MANUFACTURER		VC SYSTEMS		
	MODEL		2VC-PMC-V-2-320-20		
HYDRO-PNEUMA	ATIC TANK				
	DESIGNATION		T-1		
	VOLUME	GAL	79		
	MANUFACTURER		WESSELS		
	MODEL		FXA-300		
DETAIL REFERE	NCE	1	B / P503		



ARCHITECTURE PLANNING INTERIORS **GRAPHICS**

ELLIOTT MARSHALL INNES P.A. (EMI architects)
251 E. 7TH AVENUE TALLAHASSEE FL 32303
(850) 222 - 7442
www.emiarch.com
UCENSE #s AA C000409 IB C000153

11" x 17" SHEETS ARE PLOTTED AT 1/2 THE SCALE NOTED ON THESE DRAWINGS.

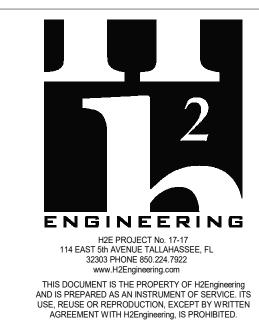

Florida Registry #2485 Jeffrey L. Tyler, P.E. #57093

Professional Engineer, License No. 57093 This item has been digitally signed and sealed by Jeffrey Lee Tyler, P.E. on the date

Jeffrey Lee Tyler, State of Florida,

Printed copies of this document are not considered signed and sealed, and the signature must be verified on any electronic

Date: 02/10/2025

WCSD EDUCATIONAL ANCILLARY FACILITIES -DISTRICT OFFICE

ALLSTATE CONSTRUCTION 02-13-2025

DATE	DESCRIPTION
2/11/2025	ADDENDUM #1
T PHASE	

CONSTRUCTION DOCUMENTS

DRAWN BY 15 JANUARY 2025 JDR PROJECT NO CHECKED BY JLT SHEET TITLE

SCHEDULES

REV NO P401

SUPPLY STOPS: CHROME-PLATED-BRASS, ONE-QUARTER TURN, BALL-TYPE OR COMPRESSION VALVE WITH INLET MATCHING SUPPLY PIPING.

FLEXIBLE CONNECTIONS: ASME A112.18.6 BRAIDED- OR CORRUGATED-STAINLESS STEEL, FLEXIBLE HOSE RISER.

SUPPORT CARRIERS: ASME A112.6.1M TYPE 1 (URINALS) OR TYPE 2 (CONCEALED ARM FOR LAVATORIES) WITH RECTANGULAR STEEL UPRIGHTS, COUPLING, SEAL, AND MOUNTING HARDWARE.

A.D.A. LAVATORIES & SINKS: PROTECT DRAIN AND SUPPLY LINES WITH "TRAP WRAP" OR APPROVED EQUAL.

EXTRA MAINTENANCE MATERIALS: FURNISH TWO (2) FLUSHOMETER-VALVE REPAIR KITS FOR EACH TYPE OF FLUSHOMETER VALVE INSTALLED.

ROOF DRAINAGE SCHEDULE PRIMARY DRAIN SECONDARY DRAIN COMBINED HORIZONTAL VERTICAL WALL TOTAL ROOF DRAIN CAPACITY ZONE NO. FLOW FROM AREA AREA AREA (GPM) ZONE(S) (SF) VERTICAL DRAIN HORIZONTAL DRAIN SLOPE (SF) (SF) SLOPE VERTICAL DRAIN HORIZONTAL DRAIN (INCH) (INCH) (INCH / FT) (INCH) (INCH) (INCH / FT) 1 4,125 160 4,205 218 5 1/8 1/8 2 4,125 104 4,177 216 5 1/8 1/8 6 3 4,125 250 4,250 220 5 1/8 5 6 1/8 4,125 135 4,193 217 1/8 1/8 5 1,810 287 1,954 101 4 1/8 1/8 1,600 210 1/8 1,705 4 1/8 4 4 7 3,695 405 3,898 202 5 1/8 6 1/8 2,525 1,406 3,228 167 1/16 1/16 8 4 6 9 2,610 745 2,983 4 1/16 1/16 620 10 1,126 1,183 1/16 1/16 11 275 125 338 1/16 1/16 NOTES:

			WACTE		SUPPLY						
FIXTURE TYPE		QUANTITY		451E	COLD		НОТ		TOTAL		
			UNIT	TOTAL	UNIT	TOTAL	UNIT	TOTAL	UNIT	TOTAL	
	DRINKING FOUNTAIN	3	0.5	1.5	0.25	0.75			0.25	0.75	
	LAVATORY (COLD WATER)	18	1	18	2	36			2	36	
	LAVATORY (HOT WATER)	1	1	1	1.5	1.5	1.5	1.5	2	2	
	SINK	14	2	28	2	28	2	28	3	42	
	MOP SERVICE BASIN	2	2	4	2.25	4.5	2.25	4.5	3	6	
	URINAL (3/4" VALVE)	6	4	24	5	30			5	30	
	WATER CLOSET (FLUSH VALVE)	20	6	120	10	200			10	200	
	HOSE BIBB / WALL HYDRANT	8			4	32			4	32	
	FLOOR DRAIN	23	2	46							
	REFRIGERATOR / ICE MAKER	1			1				1	1	
	SHOWER (PER HEAD)	1	2	2	2	2	2	2	2	2	
	PREP SINK	1	4	4	2.5	2.5	2.5	2.5	3	3	
	WASHING MACHINE (15 LB)	1	15	15	10	10	10	10	15	15	
TOTAL FIXTURE	E UNITS			263.5		348.25		48.5		369.75	
DOMESTIC WA	TER DEMAND (GPM)					117.2		11.9		121.3	

 \cdots

RAIN FALL RATE = 5.0 INCH / HR

TOTAL ROOF AREA INCLUDES HORIZONTAL AREA AND 50% OF VERTICAL WALL AREA. ZONES MARKED WITH ASTERISK (*) HAVE COMBINED FLOWS FROM HIGH ROOF.

DESIGNATI	ON	WH-1,2	WH-3	
	STORAGE	GAL	40	20
	HEATING ELEMENT INPUT (EACH)	kW	4.5	3.0
	NUMBER OF ELEMENTS	#	2	1
	SIMULTANEOUS OPERATION OF ELEMENTS		YES	NO
	TOTAL HEATING INPUT	kW	9.0	3.0
	ENTERING WATER TEMPERATURE	°F	60	60
	LEAVING WATER TEMPERATURE	°F	140	140
	TEMPERATURE RISE	°F	80	80
	RECOVERY RATE	GPH	46	15
	ELECTRICAL CHARACTERISTICS	V/PH	208 / 1	208 / 1
MANUFACT	TURER	1	A.O. SMITH	A.O. SMITH
MODEL NUI	MBER		DEN-40	DEL-20
DETAIL REF	FERENCE		B/P502	A/P502

DESIGNATION		}	CP-1,2 } —	
	SERVICE		DHW	
	CAPACITY	GPM	4	
	TOTAL DYNAMIC HEAD	FT.	27	
	SHUT-OFF HEAD	FT.	35	
	PUMP SEAL		MECHANICAL	
	MOTOR SPEED	RPM	3,250	
	MOTOR HORSEPOWER	HP	1/8	
	MOTOR WINDING		FULL	
	ELECTRICAL CHARACTERISTICS	V / PH	120 / 1	
	NOTES		1	
MANUFACTURER			TACO	
MODEL NUMBE	MODEL NUMBER		009-SF5	
DETAIL REFERENCE		(H/P501	
NOTES:				
1	PROVIDE TACO 00 TIMER/AQUASTAT WITH 7 DAY DIGITAL PROGRAMMABLE TIMER. SET TIMER FOR ALLOWABLE OPERATION DURING OCCUPIED HOURS AND AQUASTAT TO CYCLE PUMP.			
2	PLUMBING CONTRACTOR TO COORDINATE INSTALLATION OF TIMER AND AQUASTAT WITH ELECTRICAL CONTRACTOR AND INSTALL PER MANUFACTURER INSTRUCTIONS.			

DESIGNATION			SP - 1
	CAPACITY	GPM	50
	TOTAL HEAD	FT.	15
	MOTOR HORSEPOWER	HP	1/2
	ELECTRICAL CHARACTERISTICS	V / PH	120 / 1
MANUFACTURER			LITTLE GIANT
MODEL			10ECH-CIA-RF
DETAIL RE	PÉRENCE	~~~~~~~~~~~~~~~~~~~~~~~~~~~~~~~~~~~~~~	~~~C P502~~~


www.www.www.www.ww



ARCHITECTURE
PLANNING INTERIORS
GRAPHICS

ELLIOTT MARSHALL INNES P.A. (EMI architects)
251 E. 7TH AVENUE TALLAHASSEE FL 32303
(850) 222 - 7442
www.emiarch.com
ucense #s Aa C000409 IB C000153

NOTE: 11" x 17" SHEETS ARE PLOTTED AT 1/2 THE SCALE NOTED ON THESE DRAWINGS.

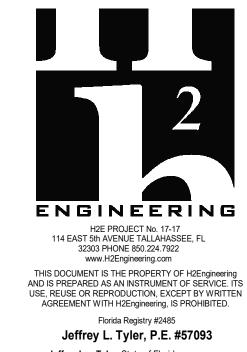

Jeffrey Lee Tyler, State of Florida, Professional Engineer, License No. 57093 This item has been digitally signed and sealed by Jeffrey Lee Tyler, P.E. on the date

Printed copies of this document are not considered signed and sealed, and the signature must be verified on any electronic copies.

Date: 02/10/2025

WCSD EDUCATIONAL ANCILLARY FACILITIES -DISTRICT OFFICE

RECEIVED
ALLSTATE CONSTRUCTION
02-13-2025

REV	DATE	DESCRIPTION
1	2/11/2025	ADDENDUM #1
חחס ובי	CT DUACE	

PROJECT PHASE

CONSTRUCTION DOCUMENTS

SHEET TITLE

DATE
15 JANUARY 2025


PROJECT NO
68100


DRAWN BY


CHECKED BY

SCHEDULES

SHEET NO REV NO

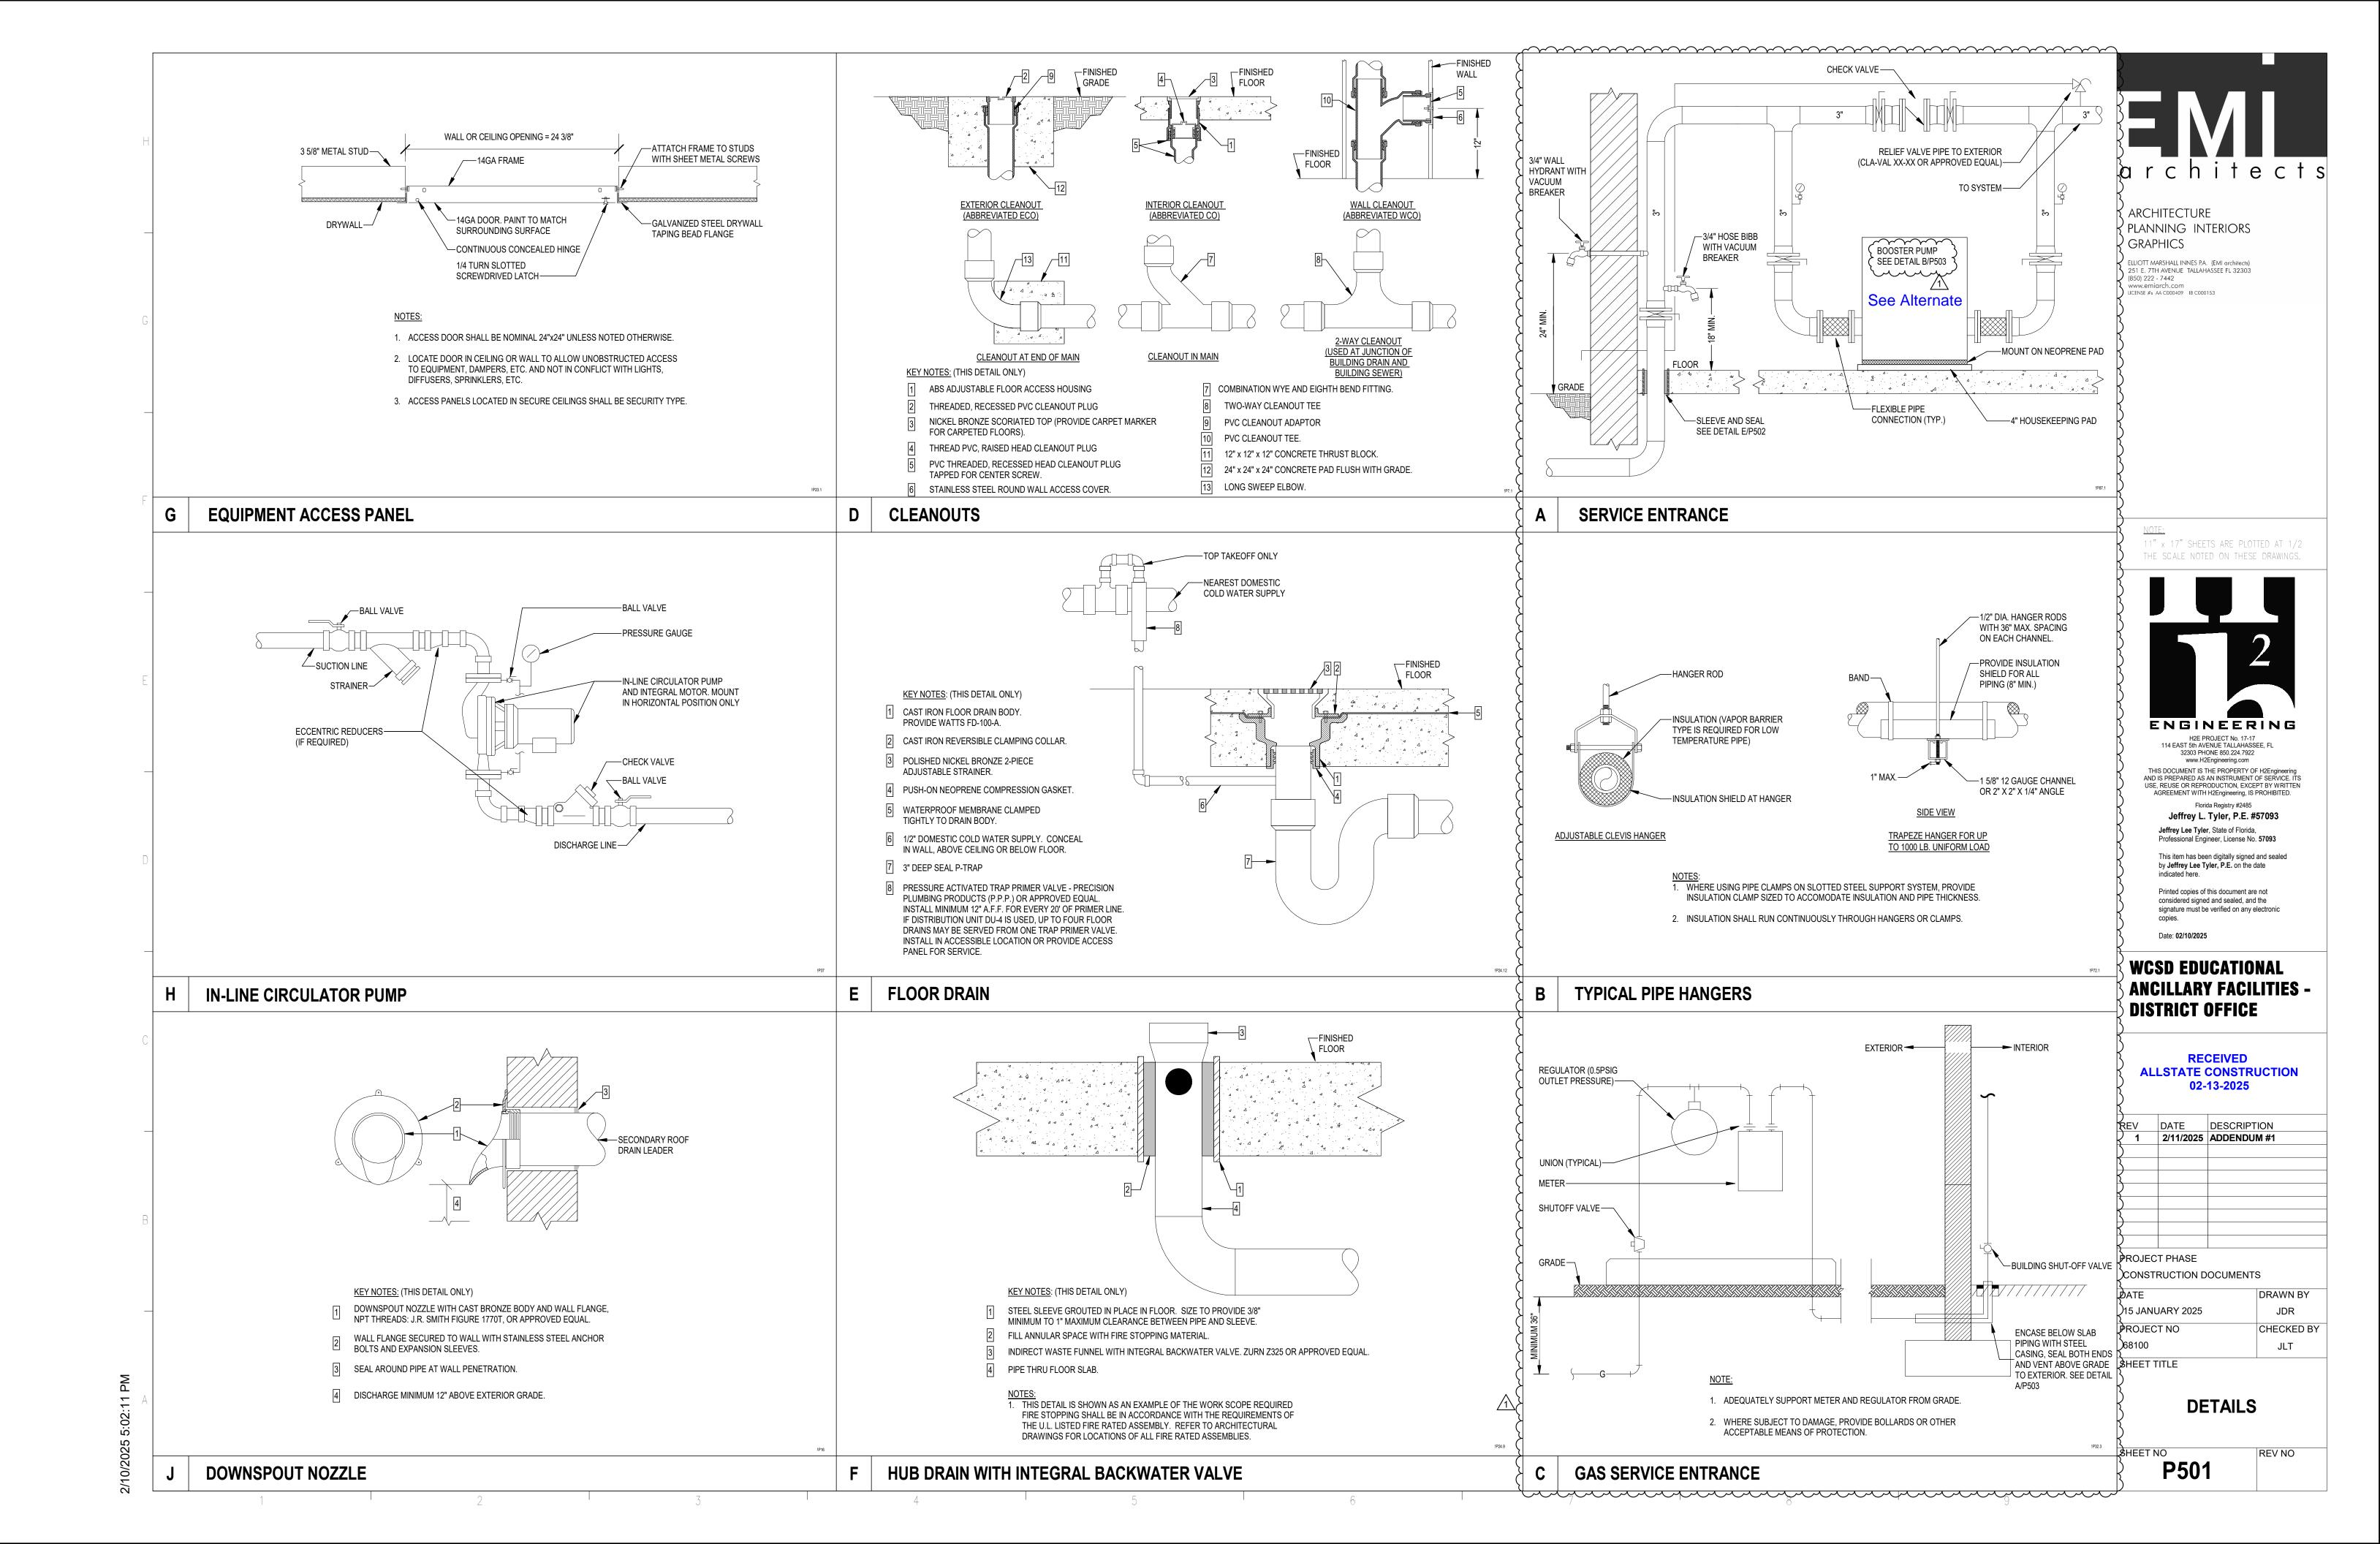

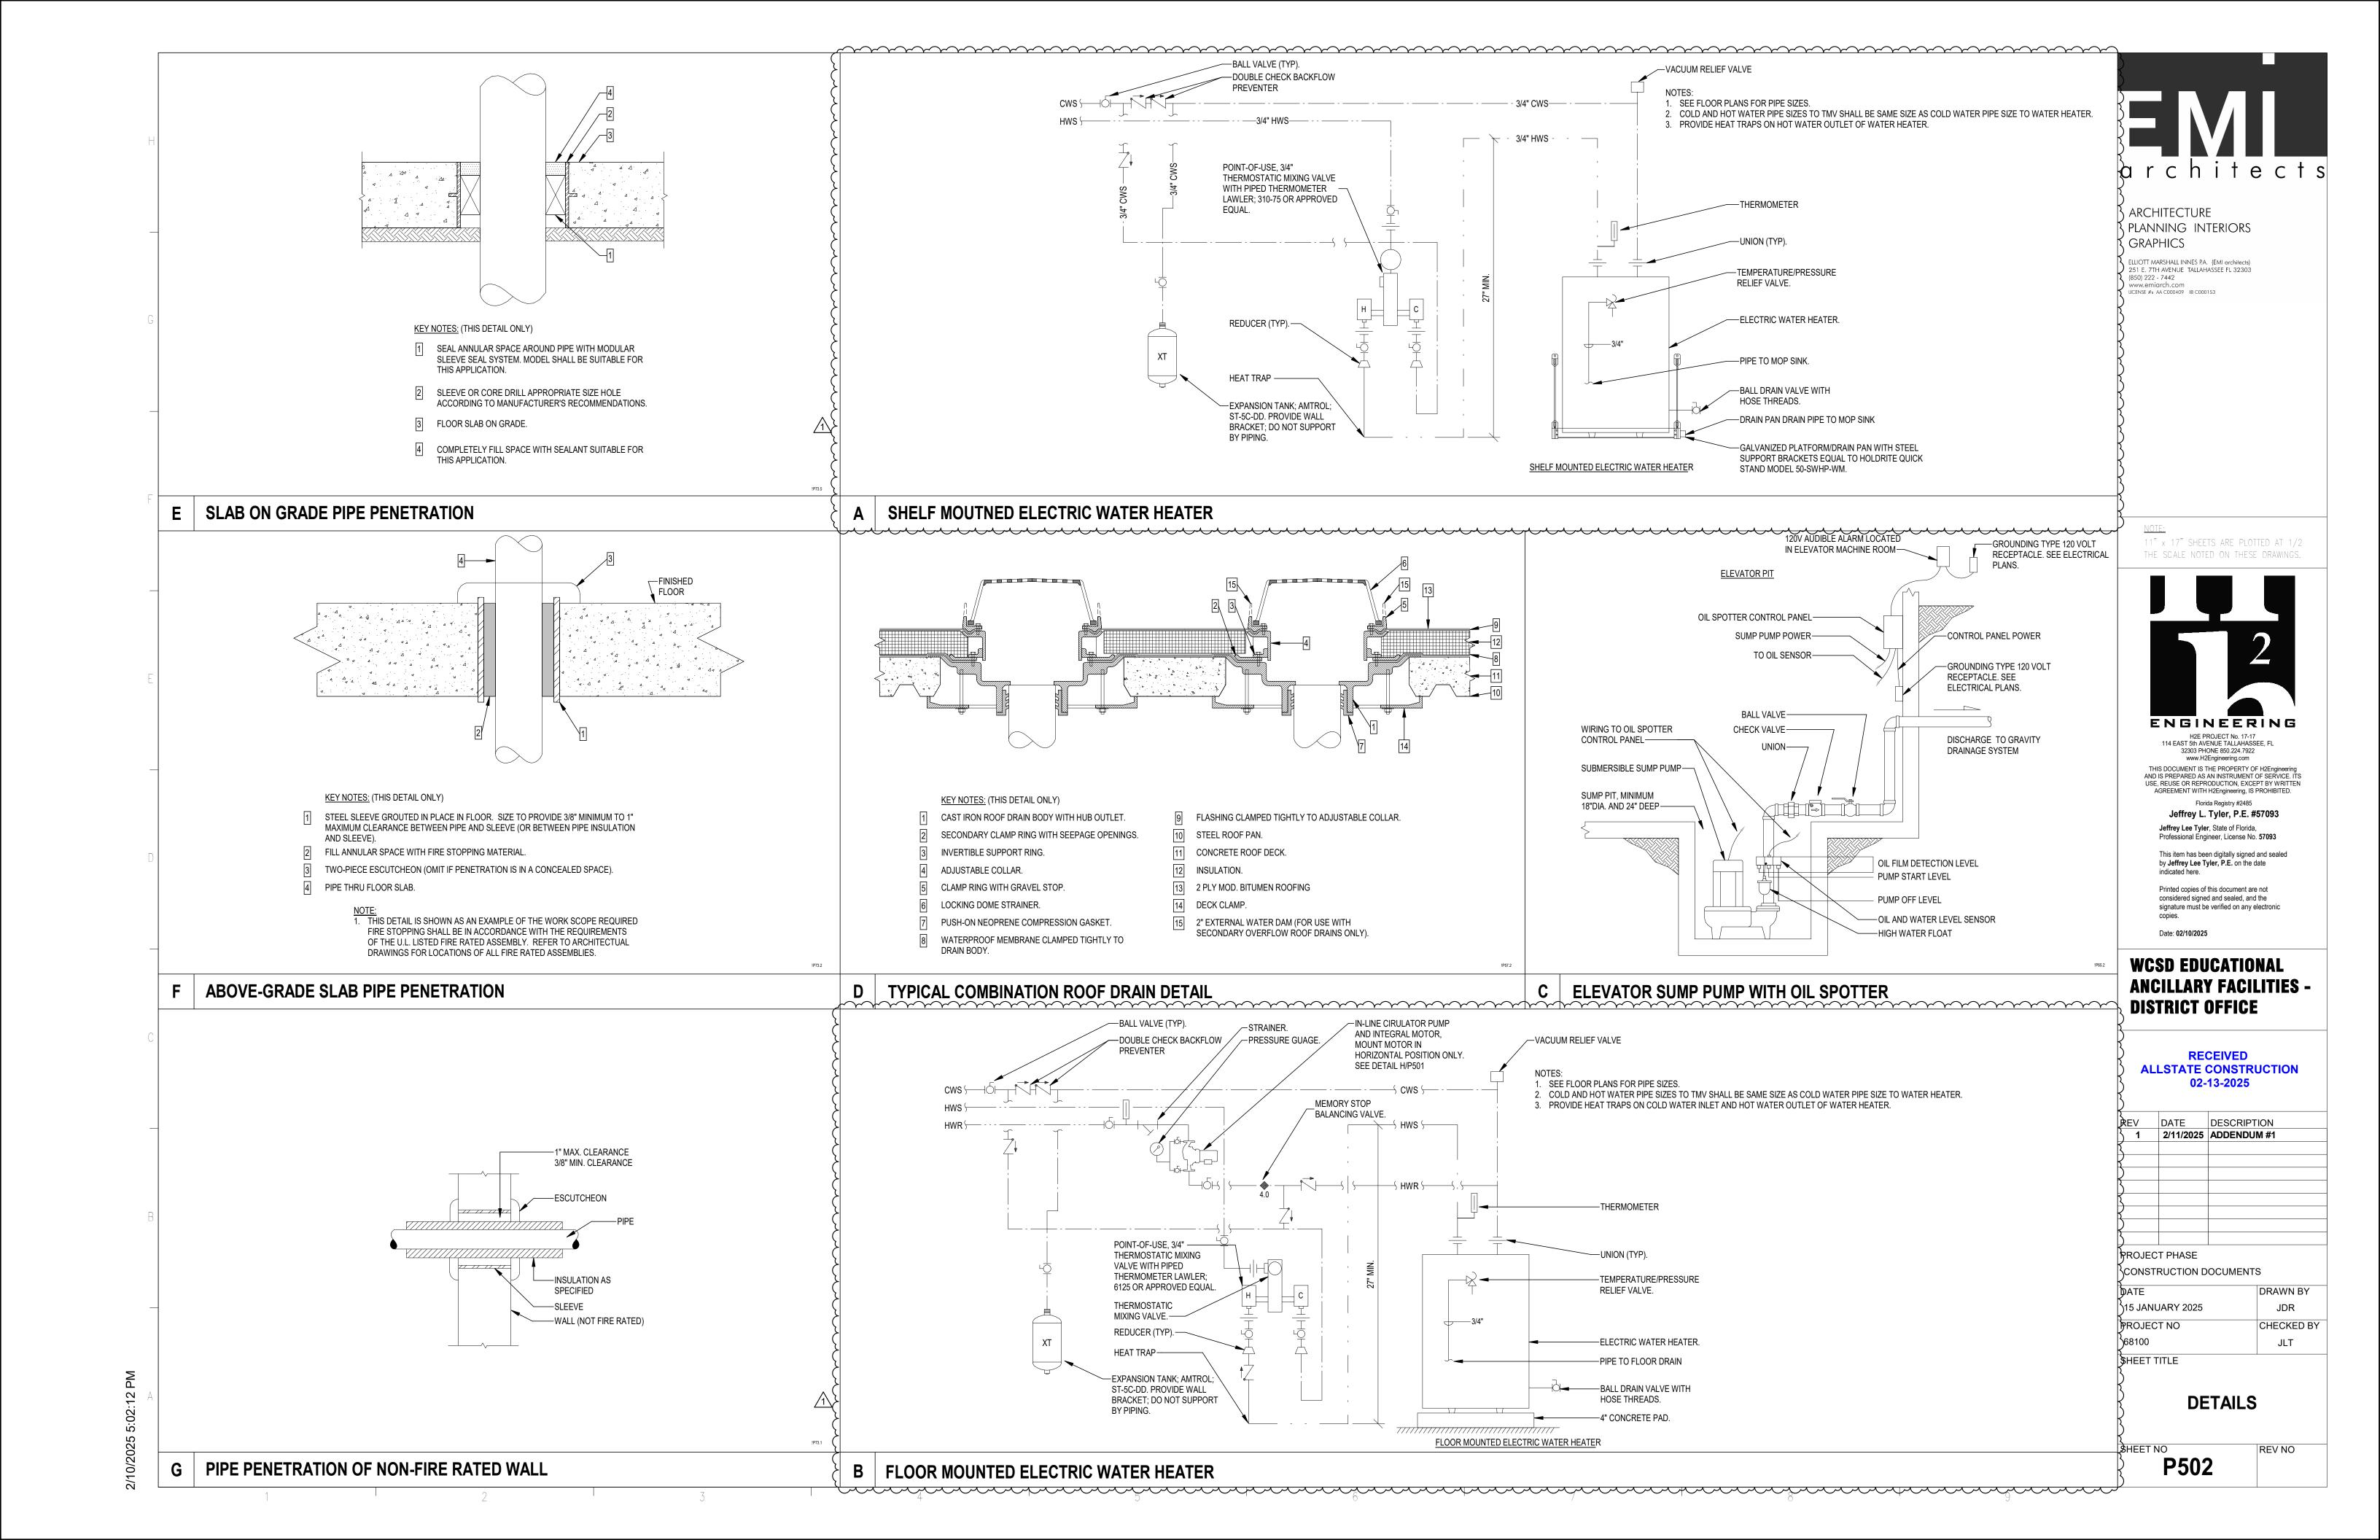

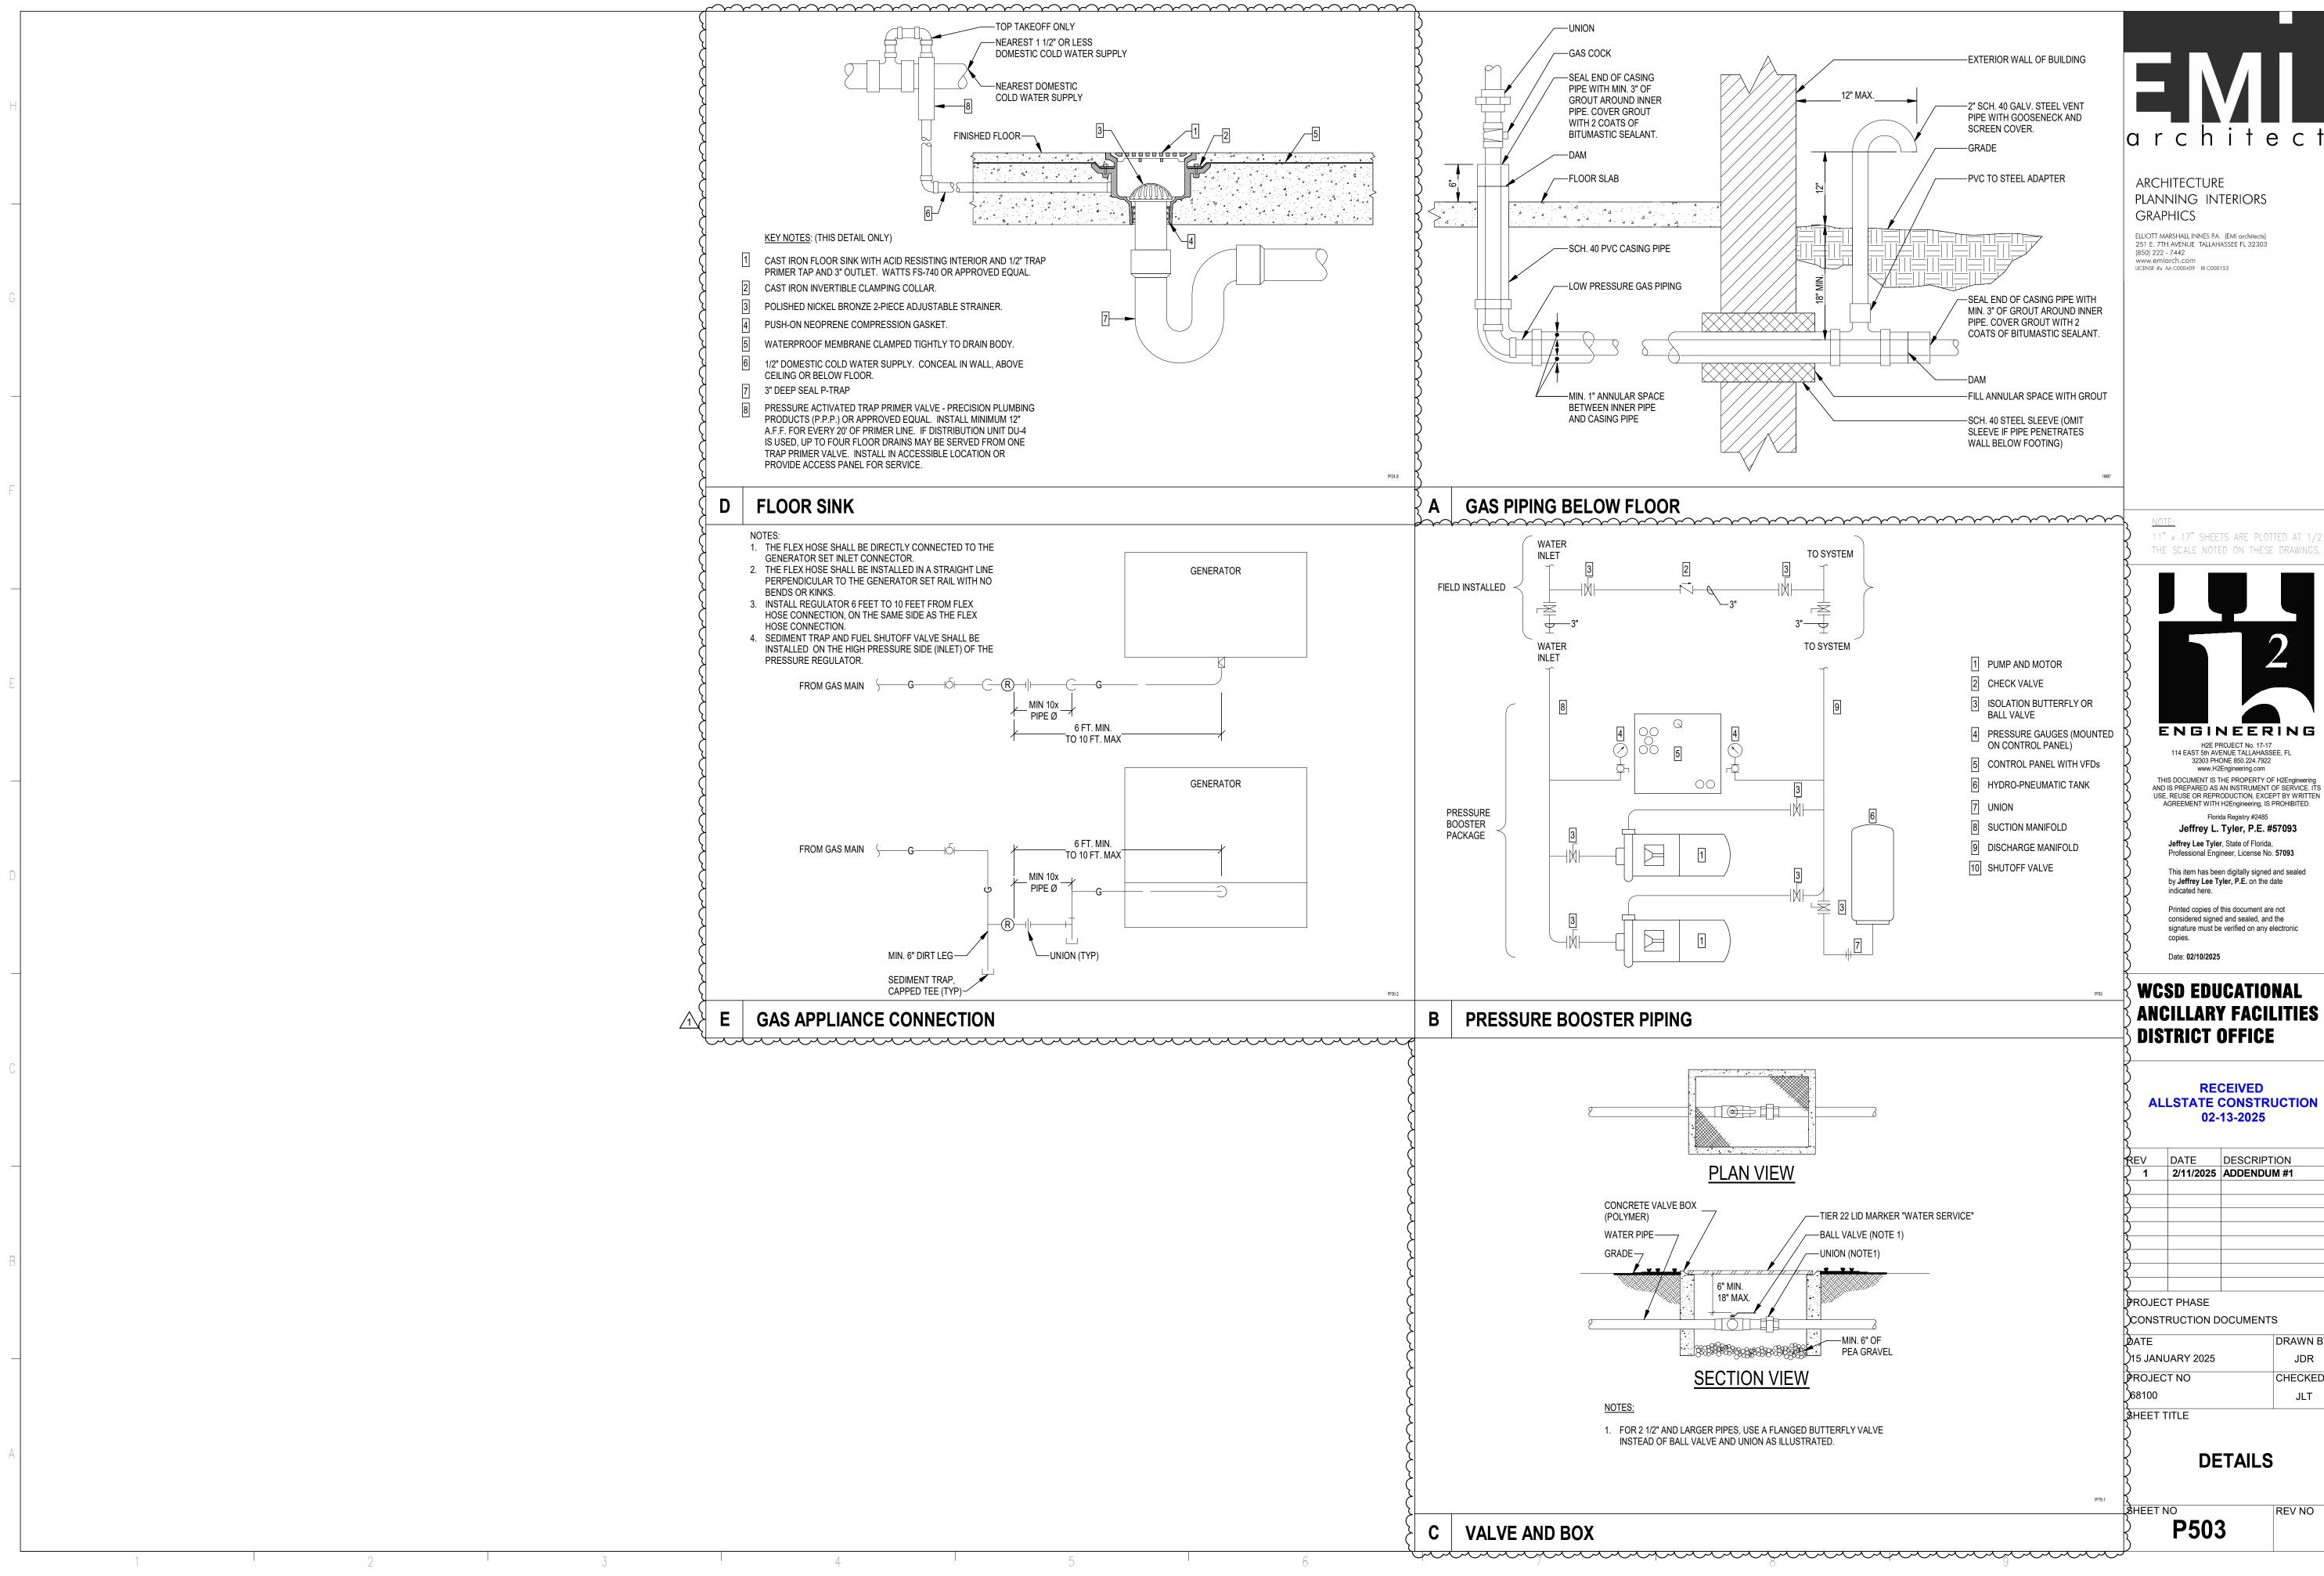

architects

11" x 17" SHEETS ARE PLOTTED AT 1/2

ENGINEERING H2E PROJECT No. 17-17 114 EAST 5th AVENUE TALLAHASSEE, FL 32303 PHONE 850.224.7922

Jeffrey Lee Tyler, State of Florida, Professional Engineer, License No. 57093

This item has been digitally signed and sealed by Jeffrey Lee Tyler, P.E. on the date

Printed copies of this document are not considered signed and sealed, and the signature must be verified on any electronic

WCSD EDUCATIONAL ANCILLARY FACILITIES -

ALLSTATE CONSTRUCTION

DATE DESCRIPTION 2/11/2025 ADDENDUM #1 DRAWN BY JDR CHECKED BY

JLT